




260+00

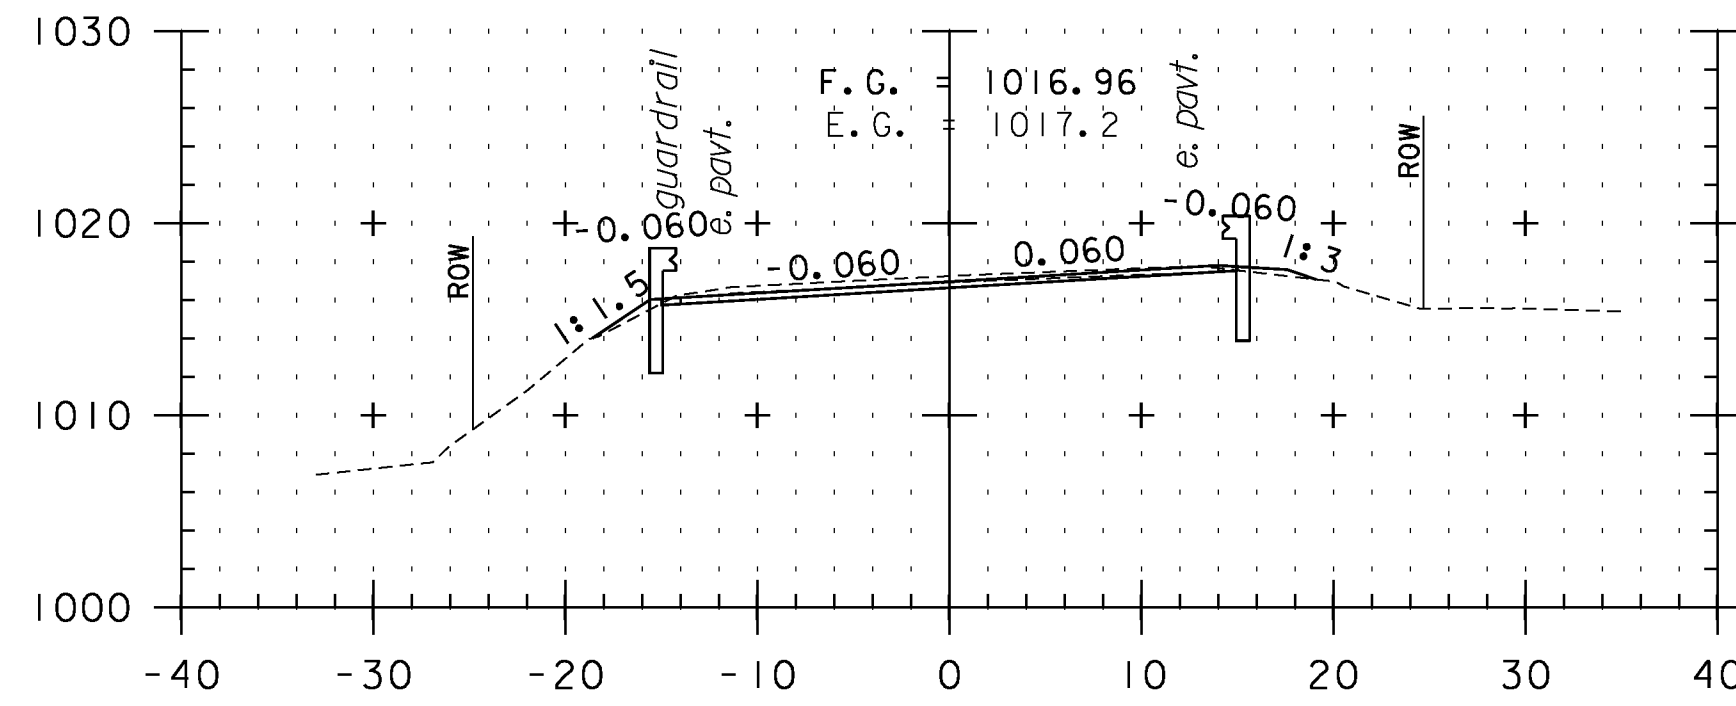


261+00

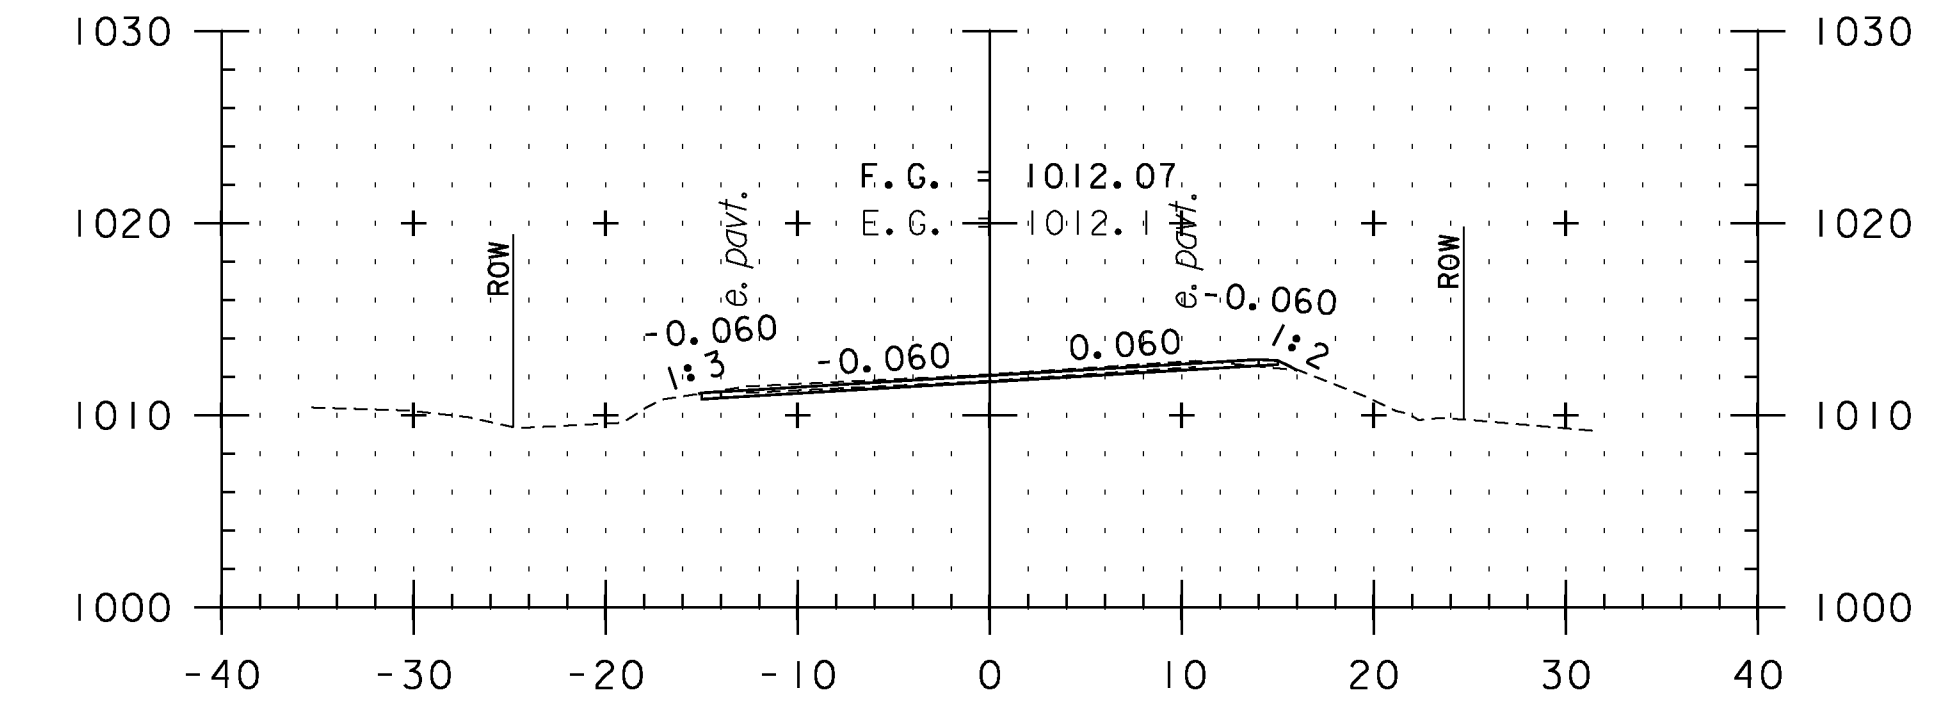


262+50

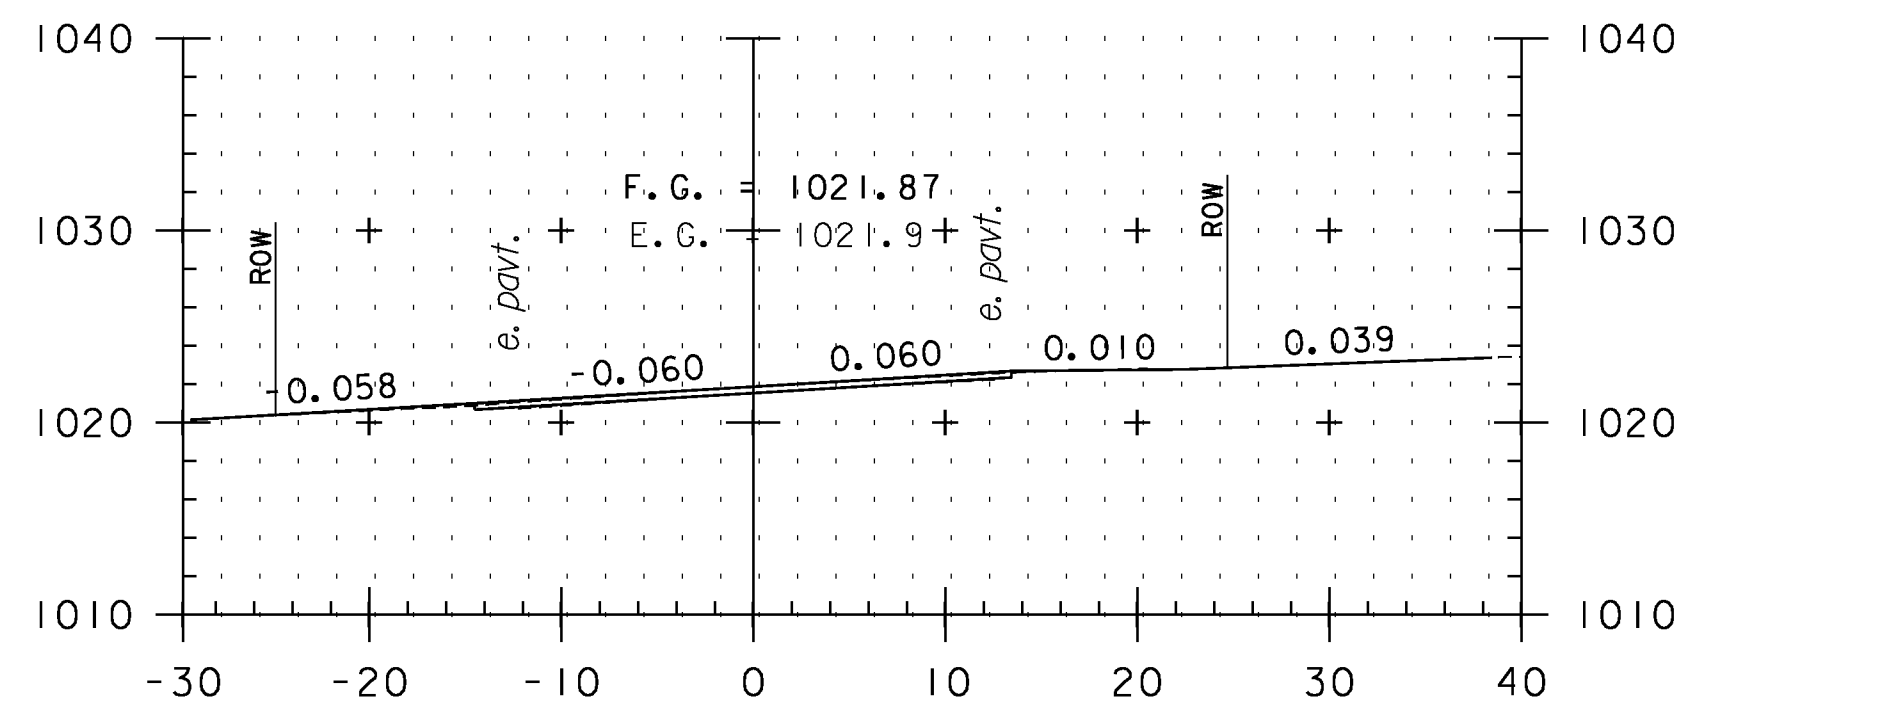


259+59
TH 45 / TH 4

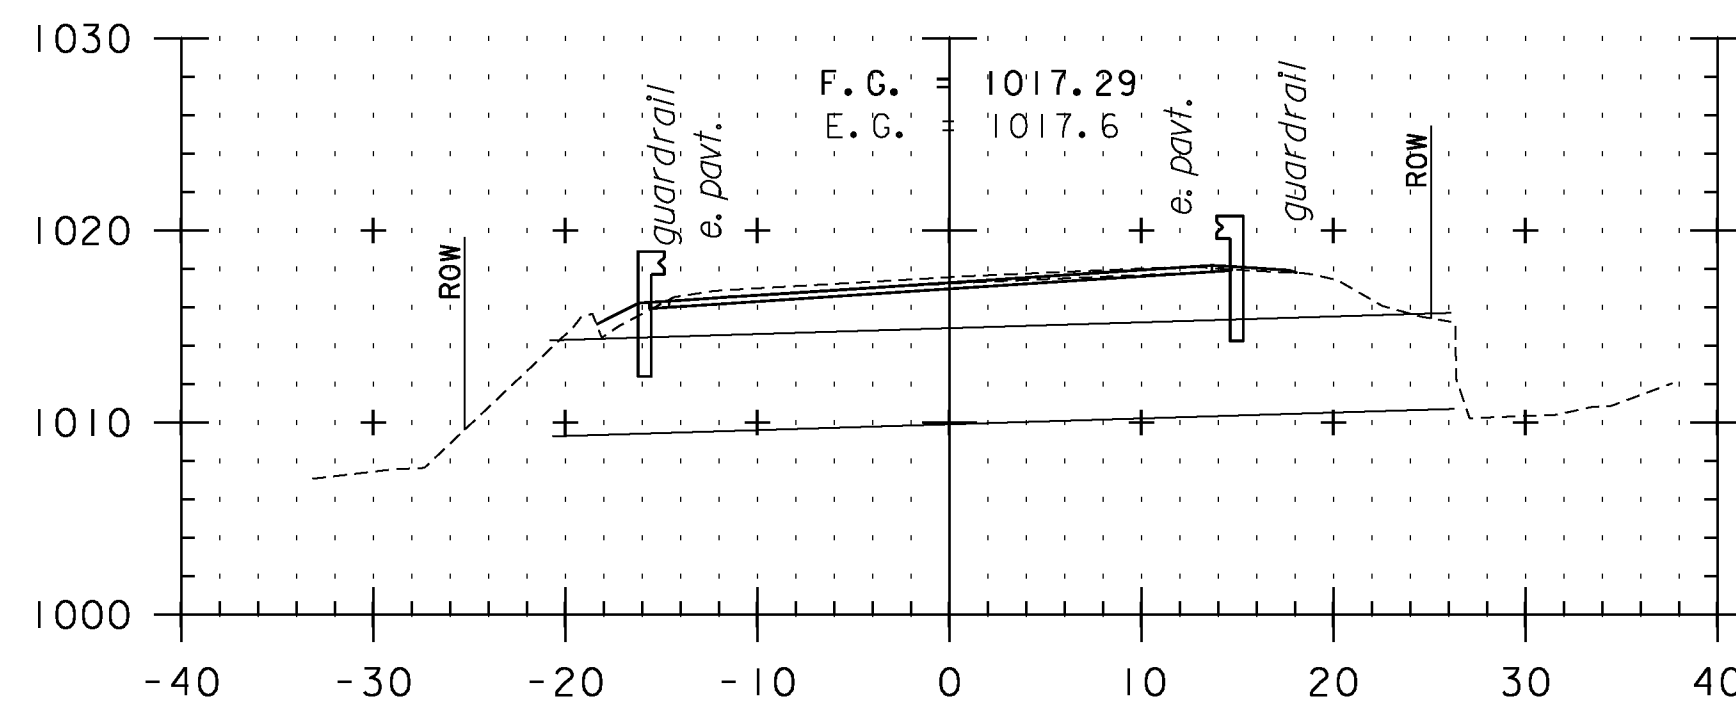


260+91
BRIDGE 16

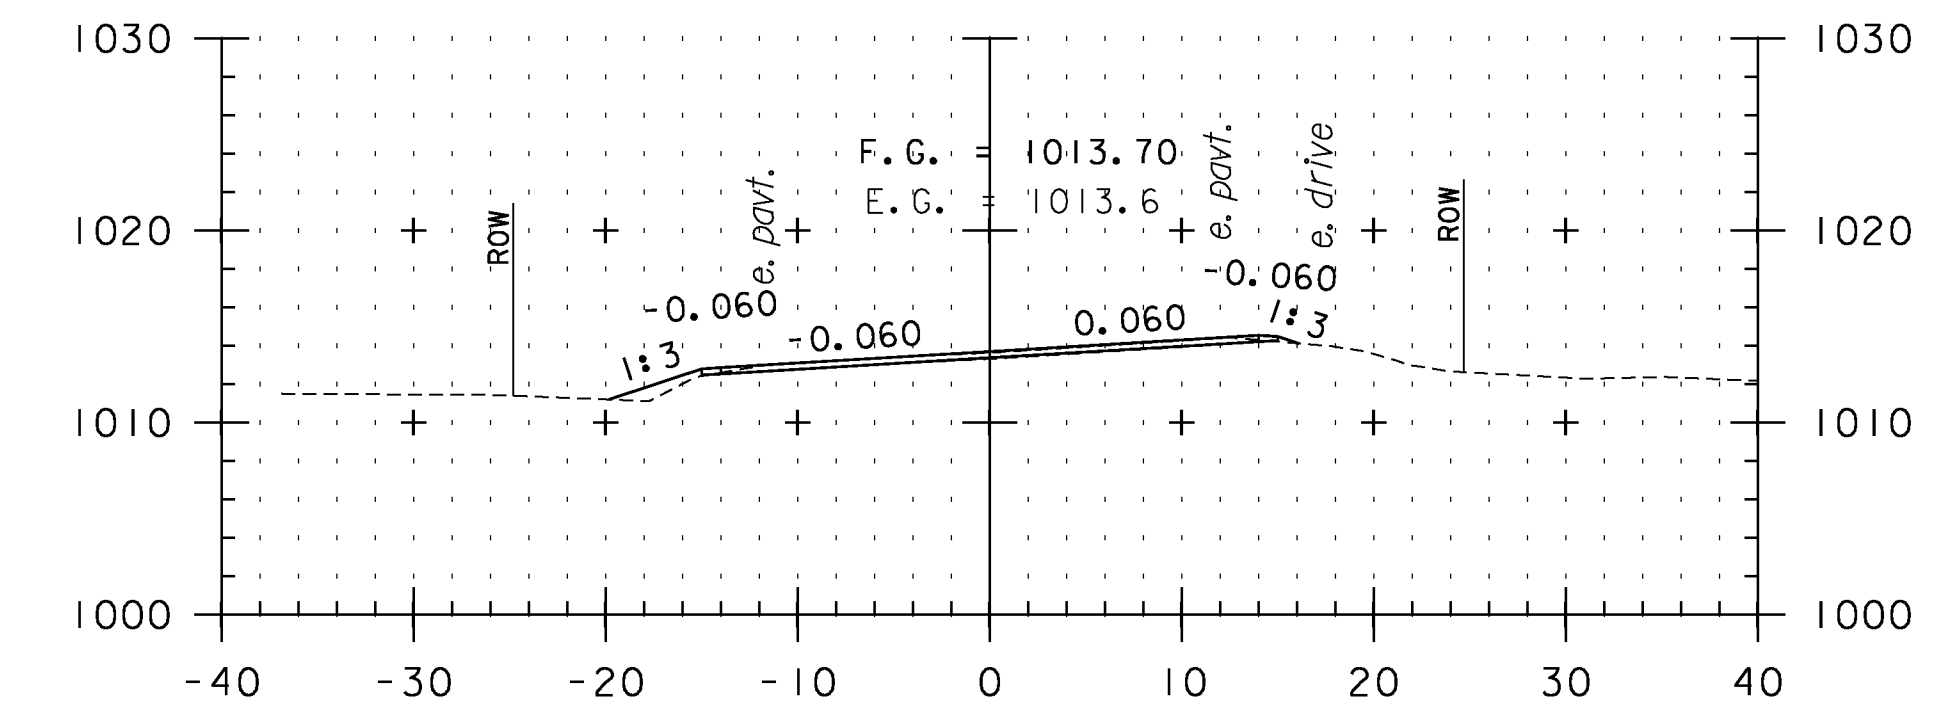


262+00

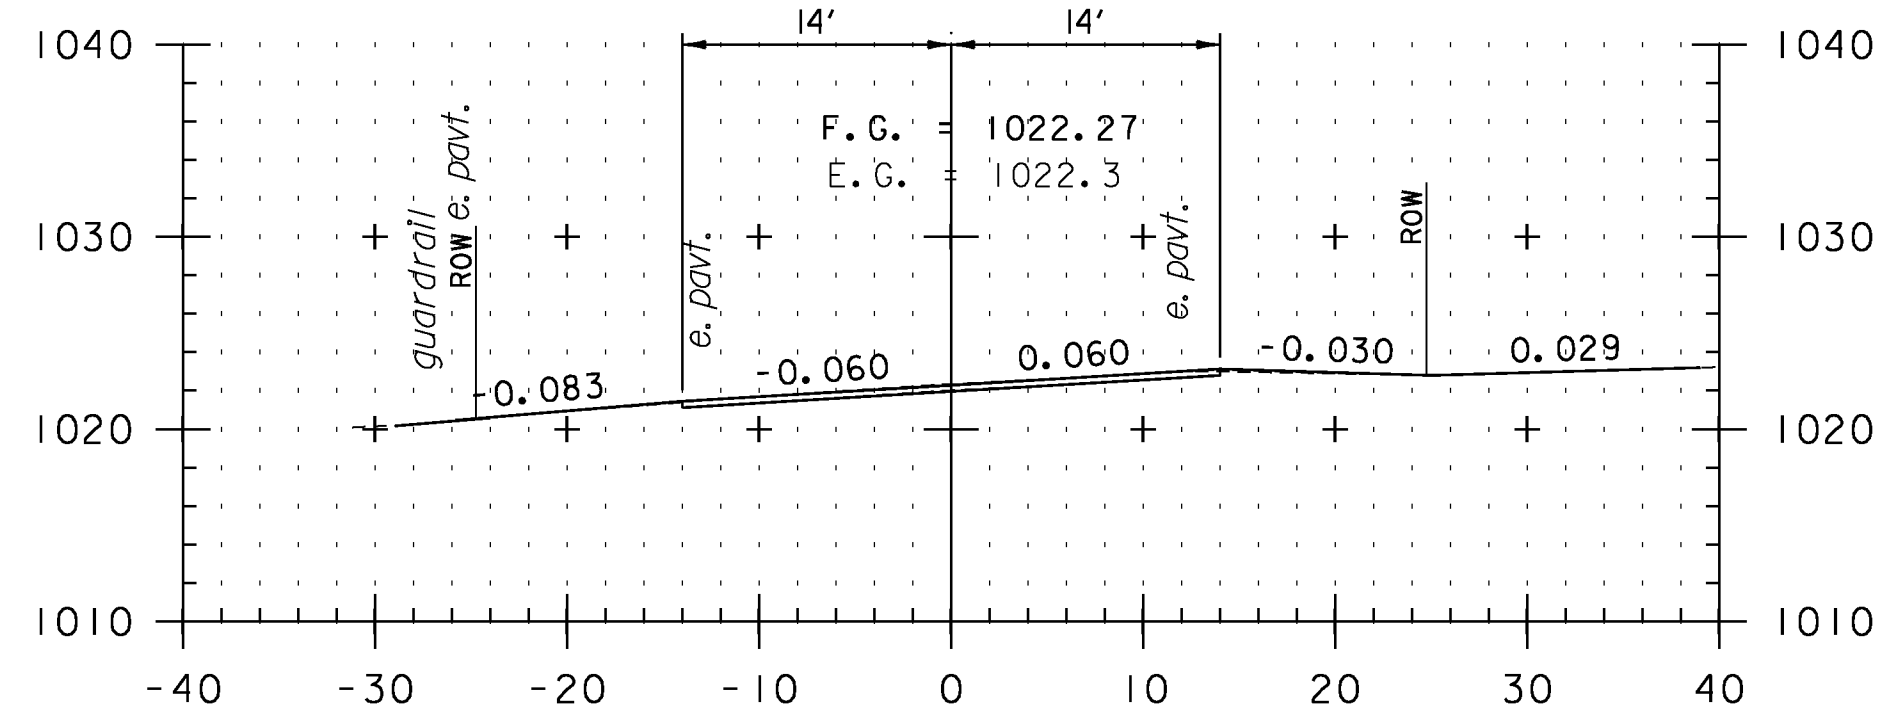

259+50

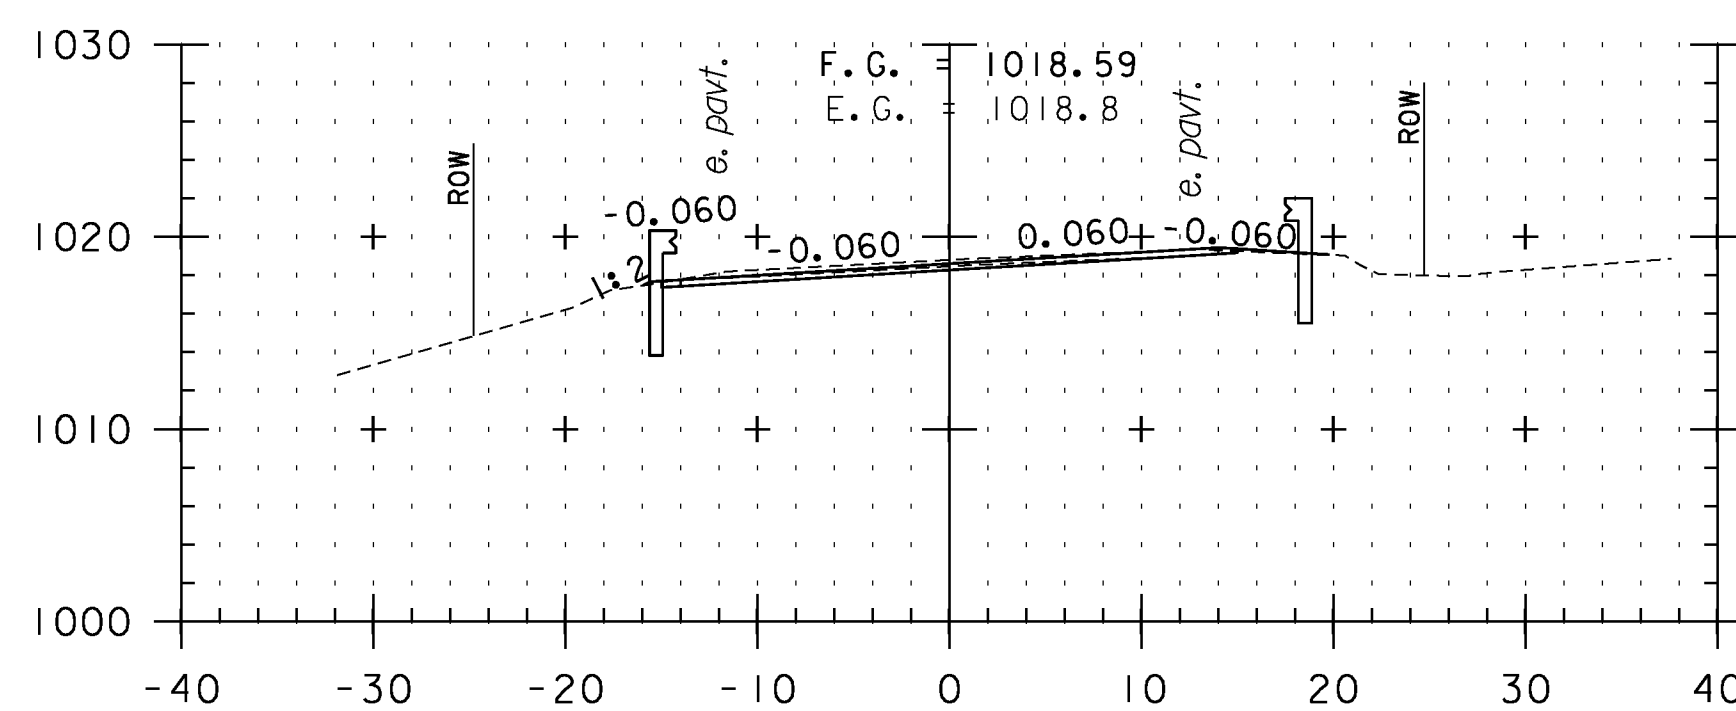


260+50

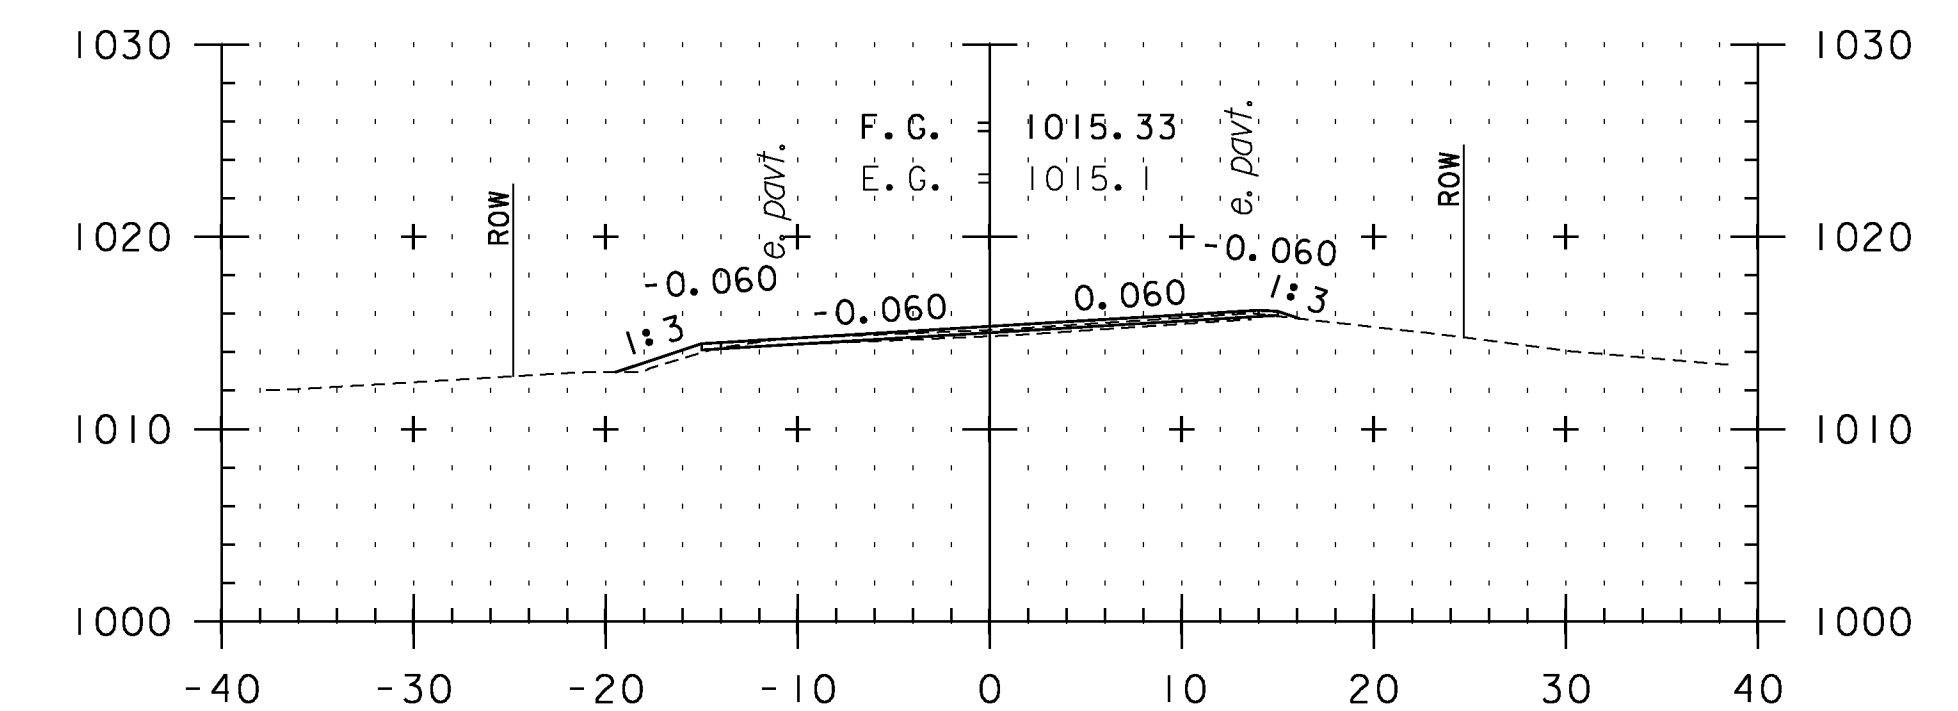

261+50

CROSS SECTION SHEET 18

STA. 259+50 TO STA. 262+50

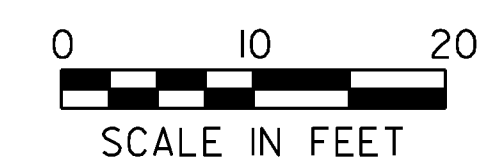

PROJECT NAME: VERSHIRE-THETFORD	PLOT DATE: 1/29/2013
PROJECT NUMBER: STP 2911(I)	DRAWN BY: SNG
FILE NAME: pl0c224.dgn	CHECKED BY: PTS
PROJECT LEADER: PTS	SHEET 126 OF 232
DESIGNED BY: NULL	
IPARM FILE NAME: IOC224_126	