




264+00

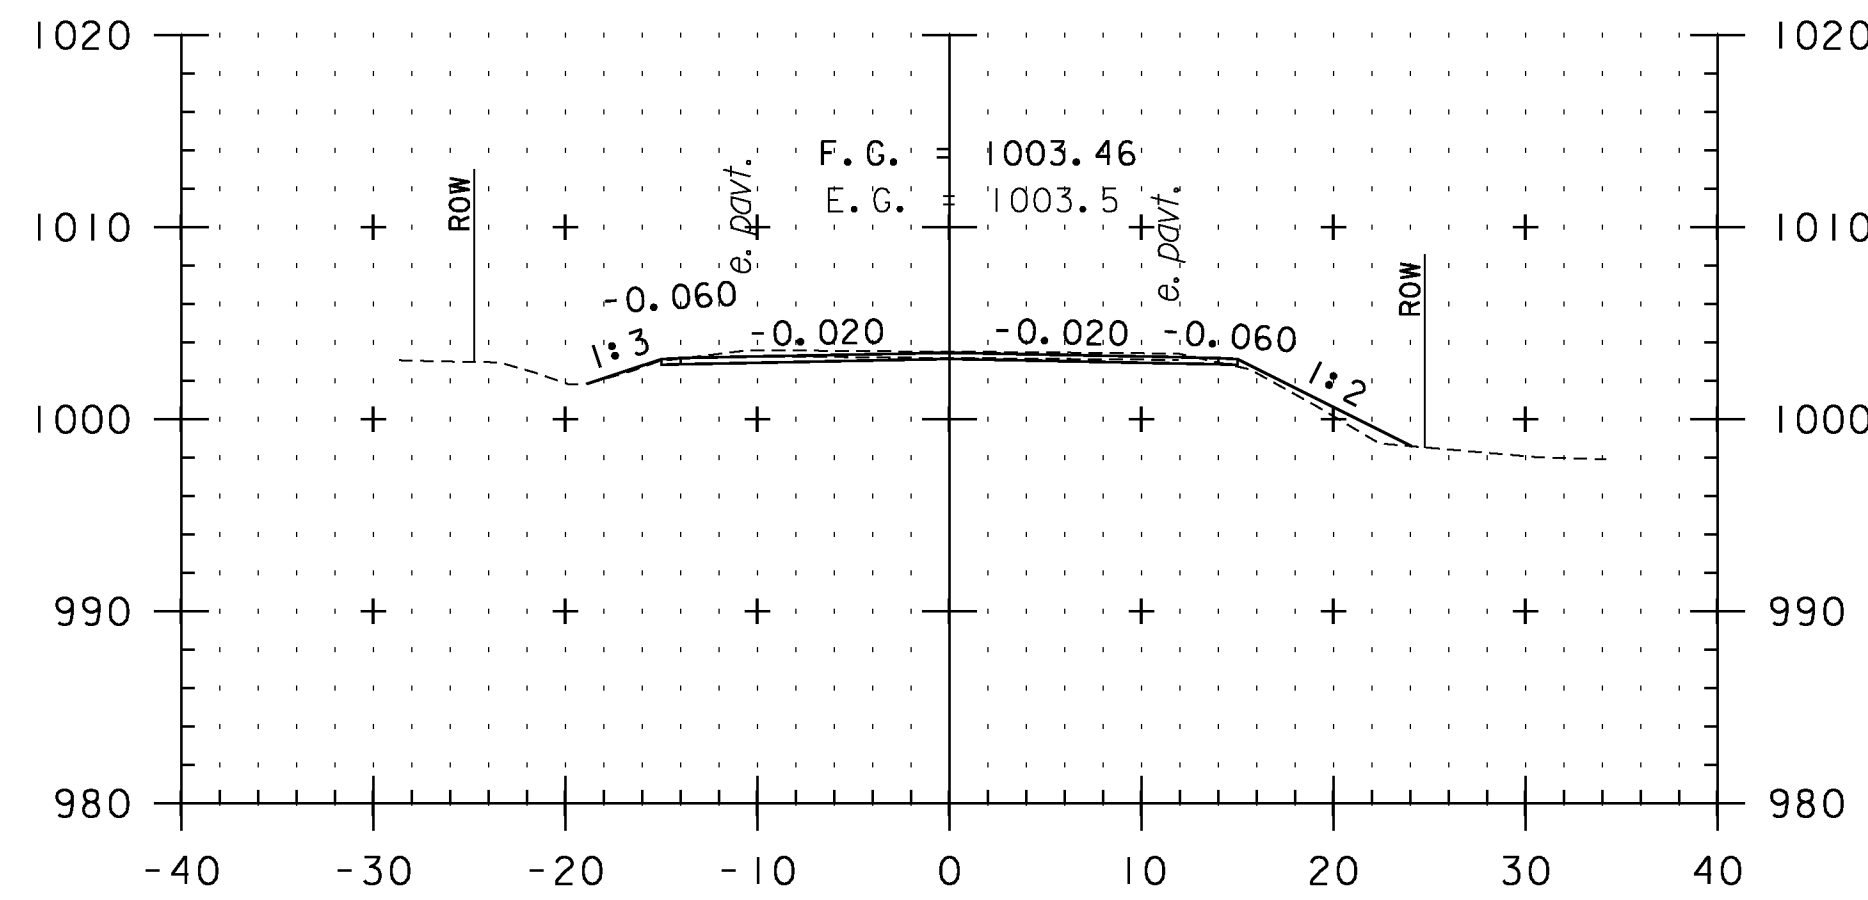


265+50

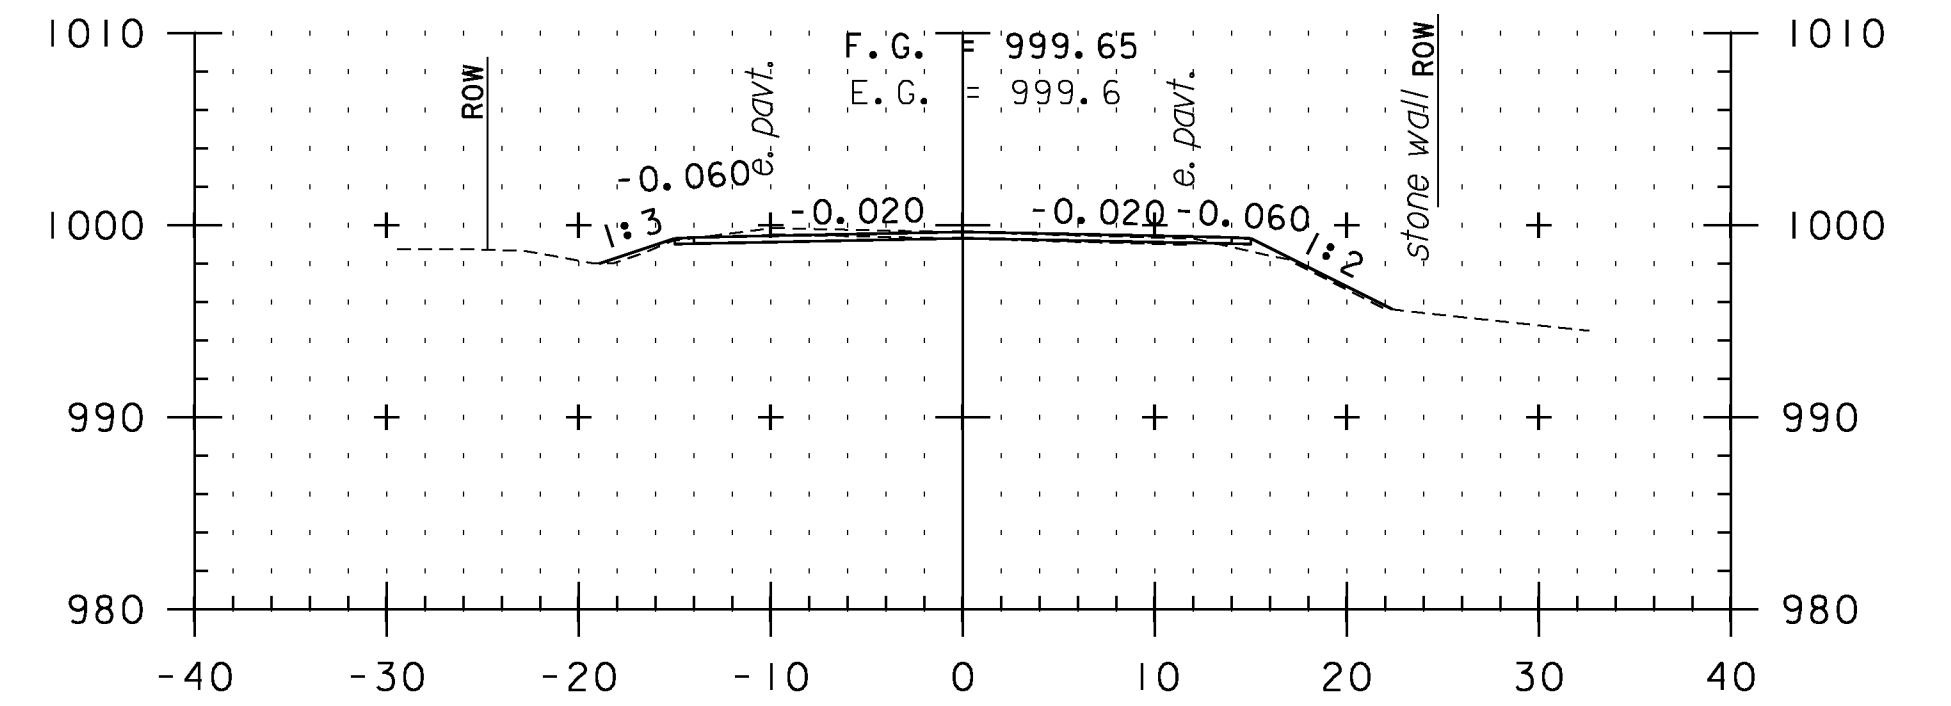


267+00

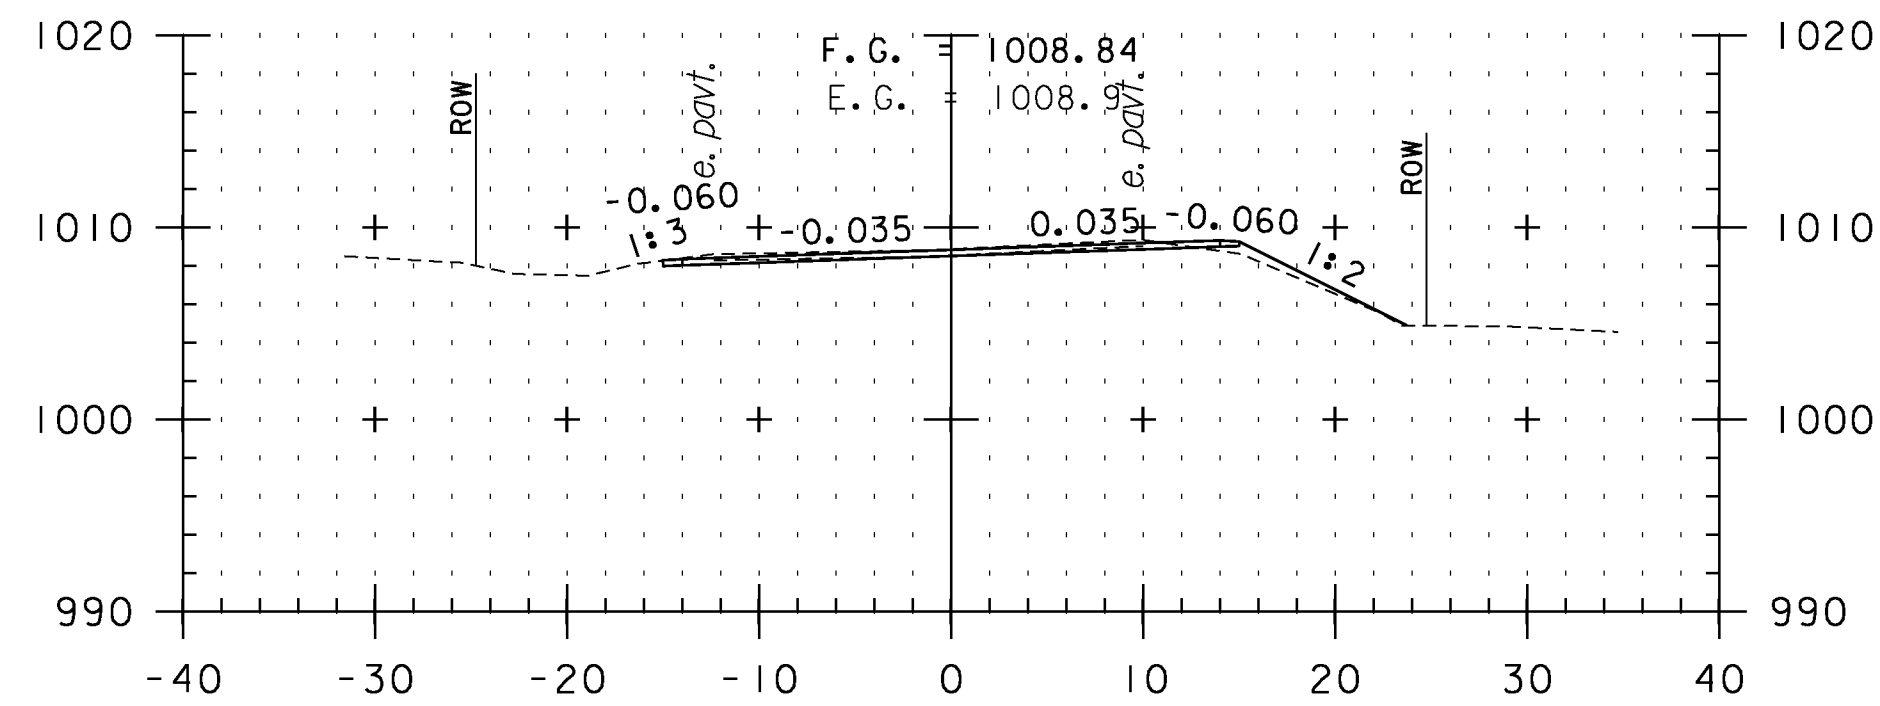


263+50

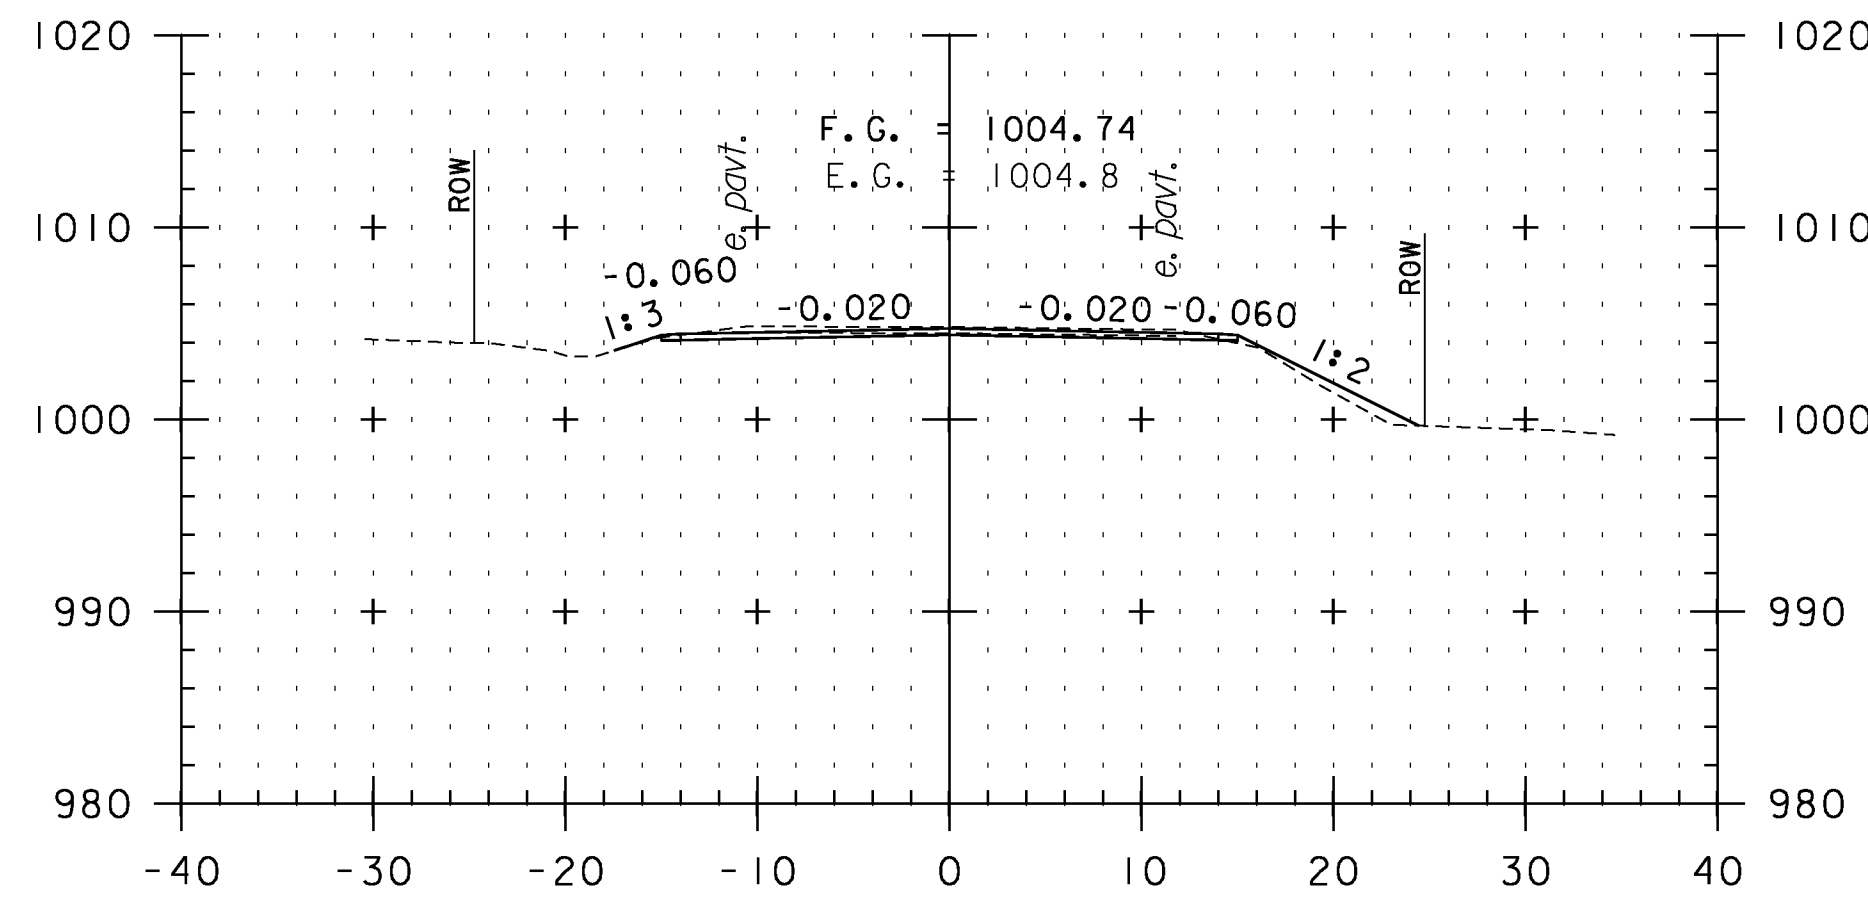


265+00

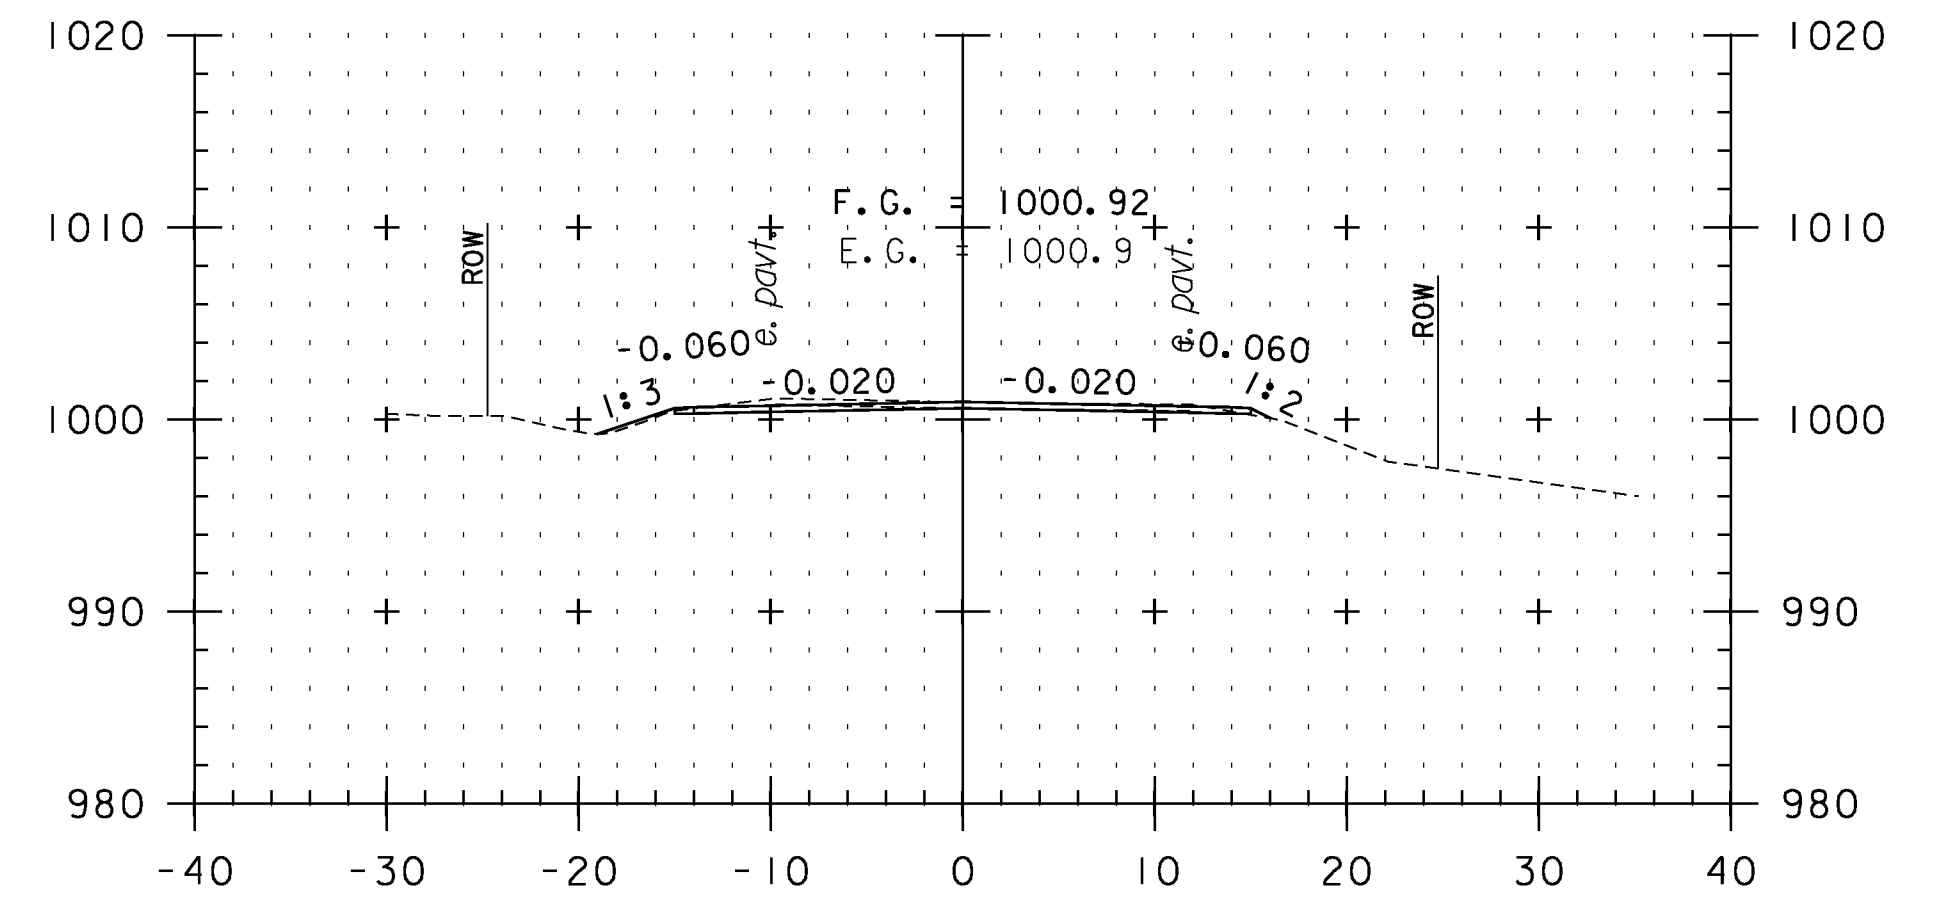


266+50

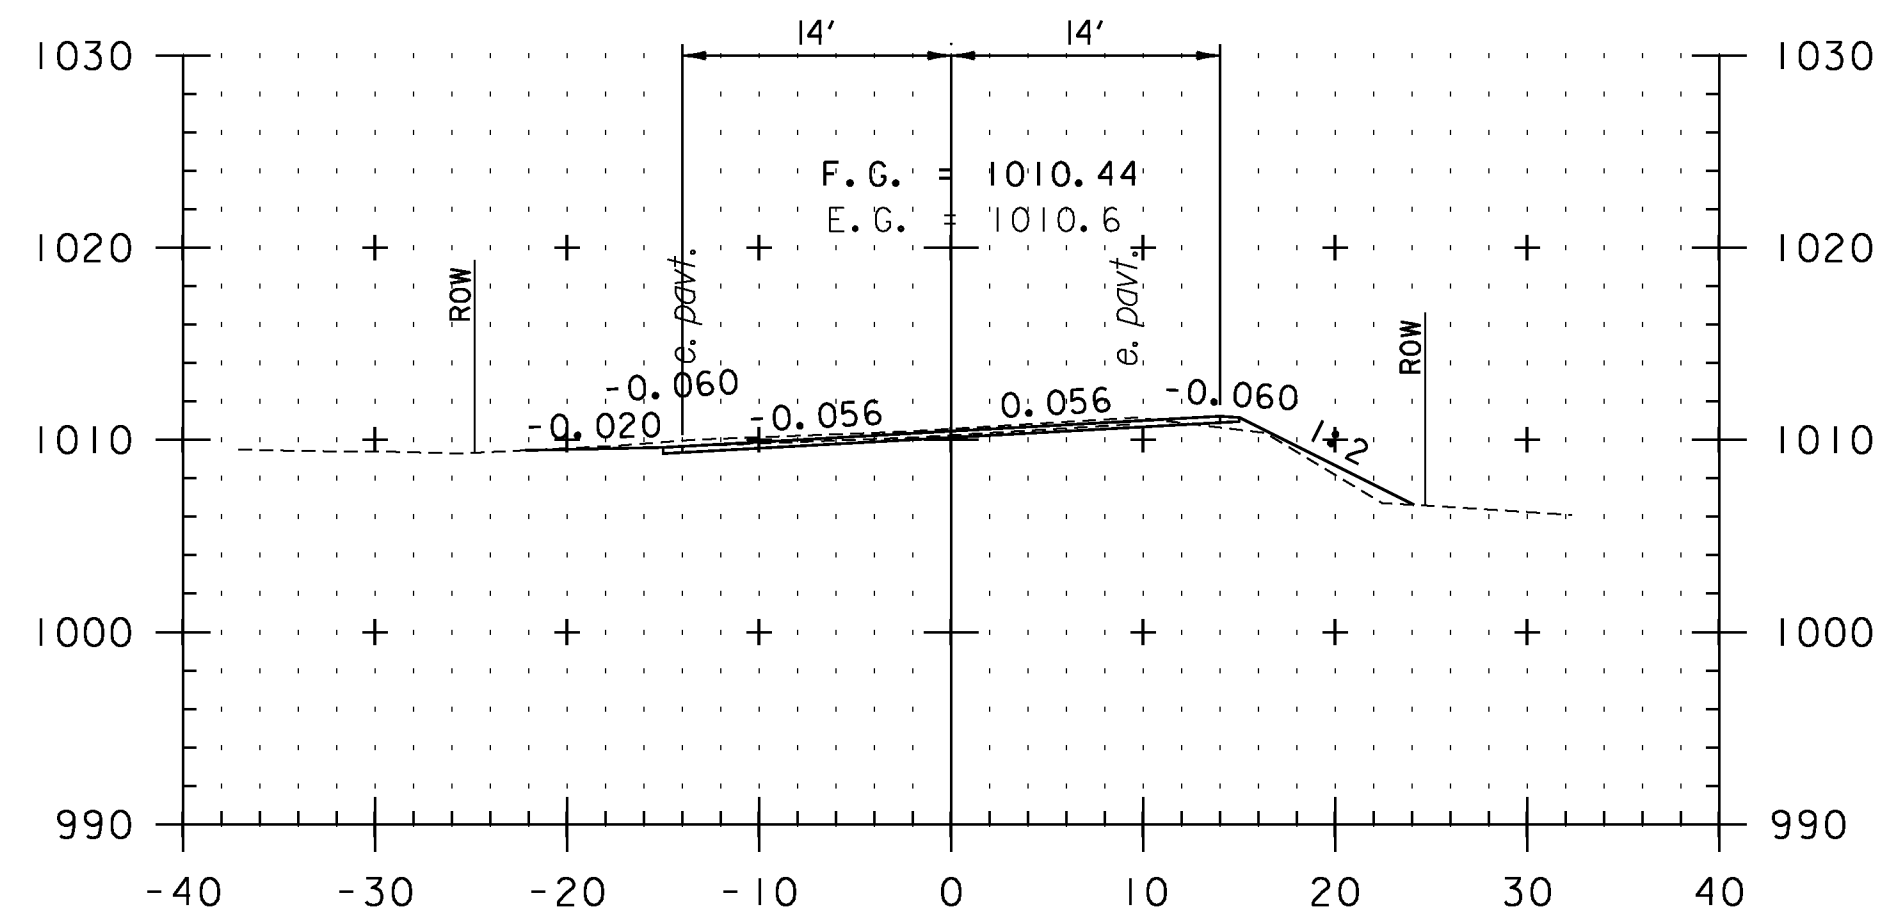

263+00

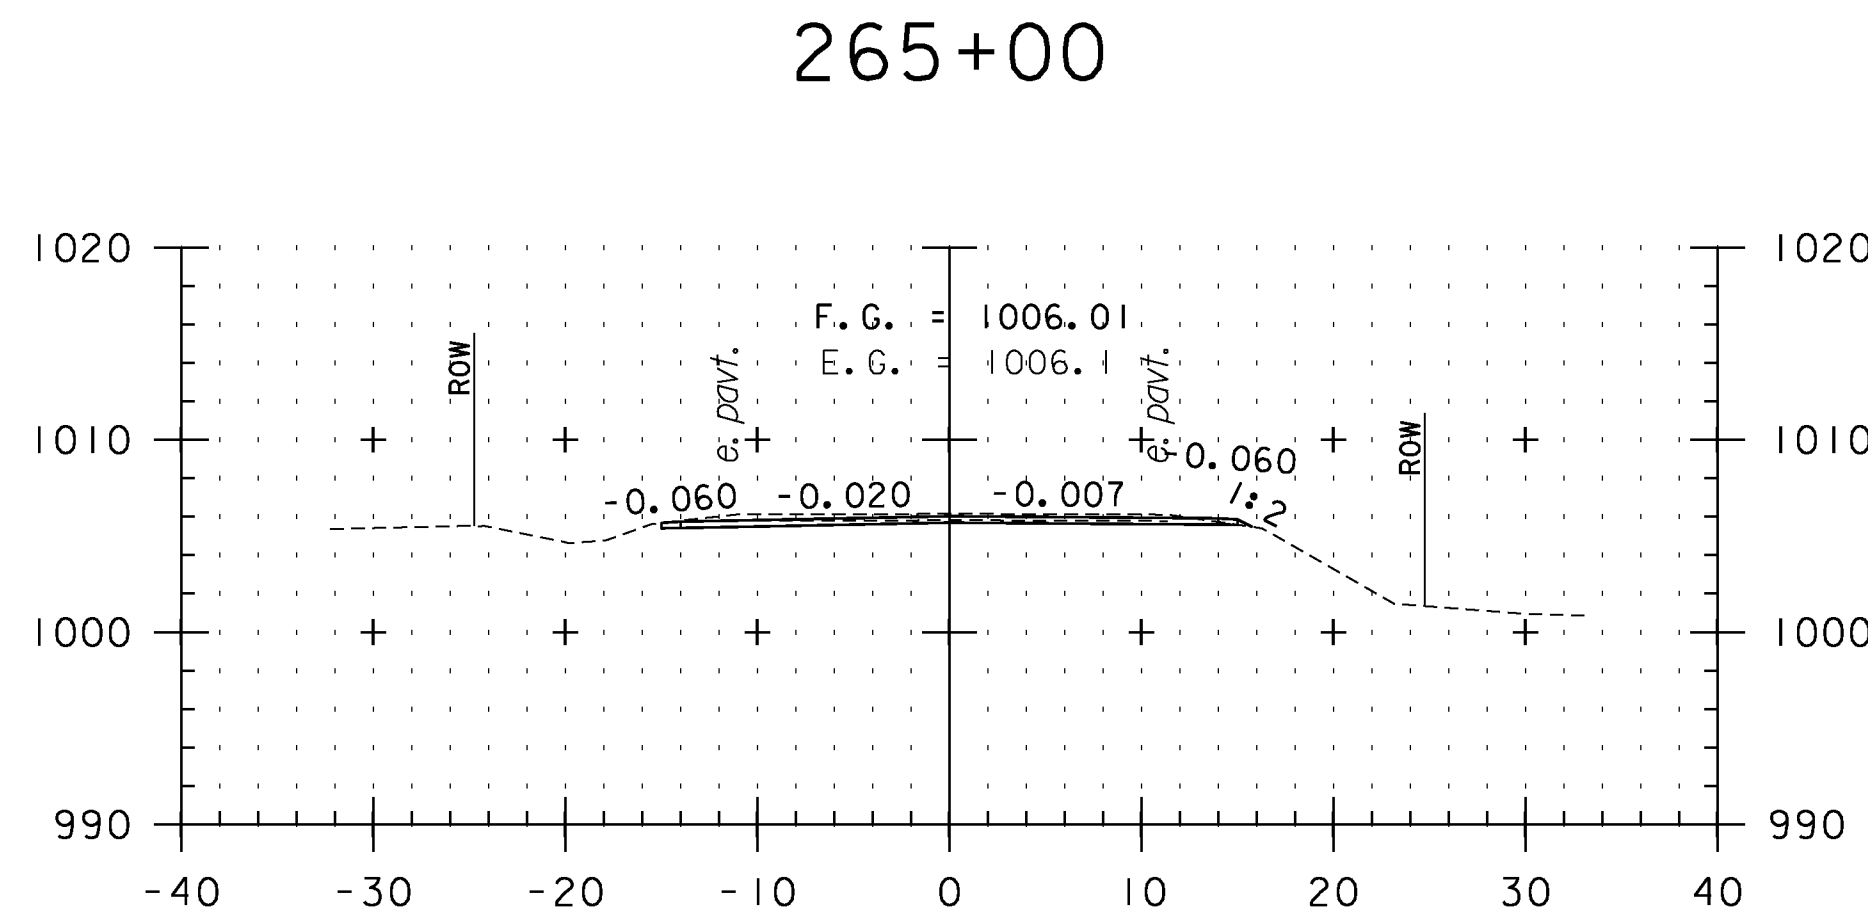


264+50

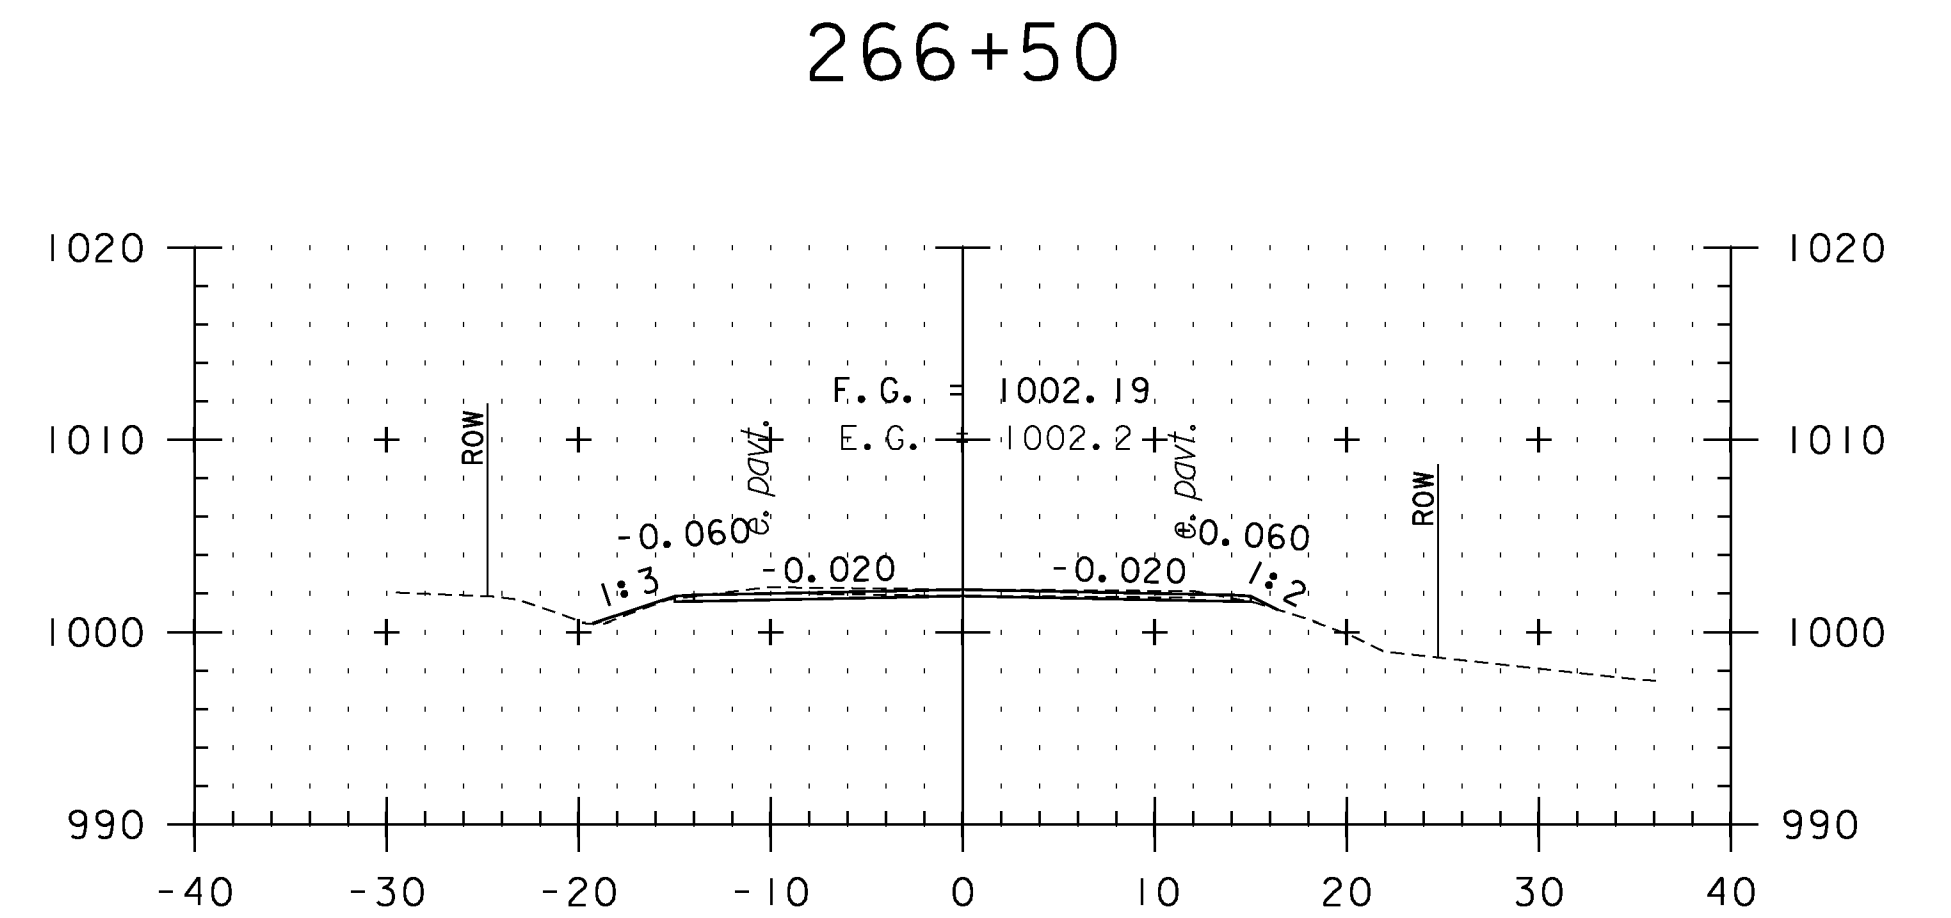

266+00

**CROSS SECTION SHEET 19**

STA. 263+00 TO STA. 267+00

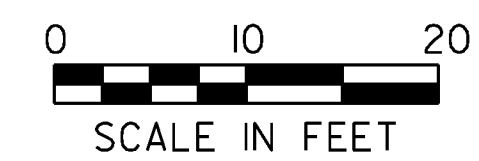

PROJECT NAME: VERSHIRE-THETFORD	PLOT DATE: 1/29/2013
PROJECT NUMBER: STP 2911(I)	DRAWN BY: SNG
FILE NAME: pl0c224.dgn	CHECKED BY: PTS
PROJECT LEADER: PTS	SHEET 127 OF 232
DESIGNED BY: NLL	
IPARM FILE NAME: IOC224_I27	