


CROSS SECTION SHEET 21

STA. 272+00 TO STA. 275+00

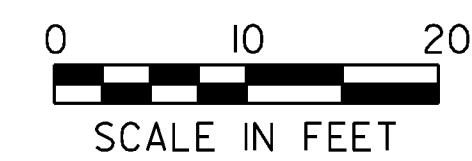

| | |
|---------------------------------|----------------------|
| PROJECT NAME: VERSHIRE-THETFORD | PLOT DATE: 1/29/2013 |
| PROJECT NUMBER: STP 2911(I) | DRAWN BY: SNG |
| FILE NAME: pl0c224.dgn | CHECKED BY: PTS |
| PROJECT LEADER: PTS | SHEET 129 OF 232 |
| DESIGNED BY: NLL | |
| IPARM FILE NAME: IOC224_129 | |