




281+00

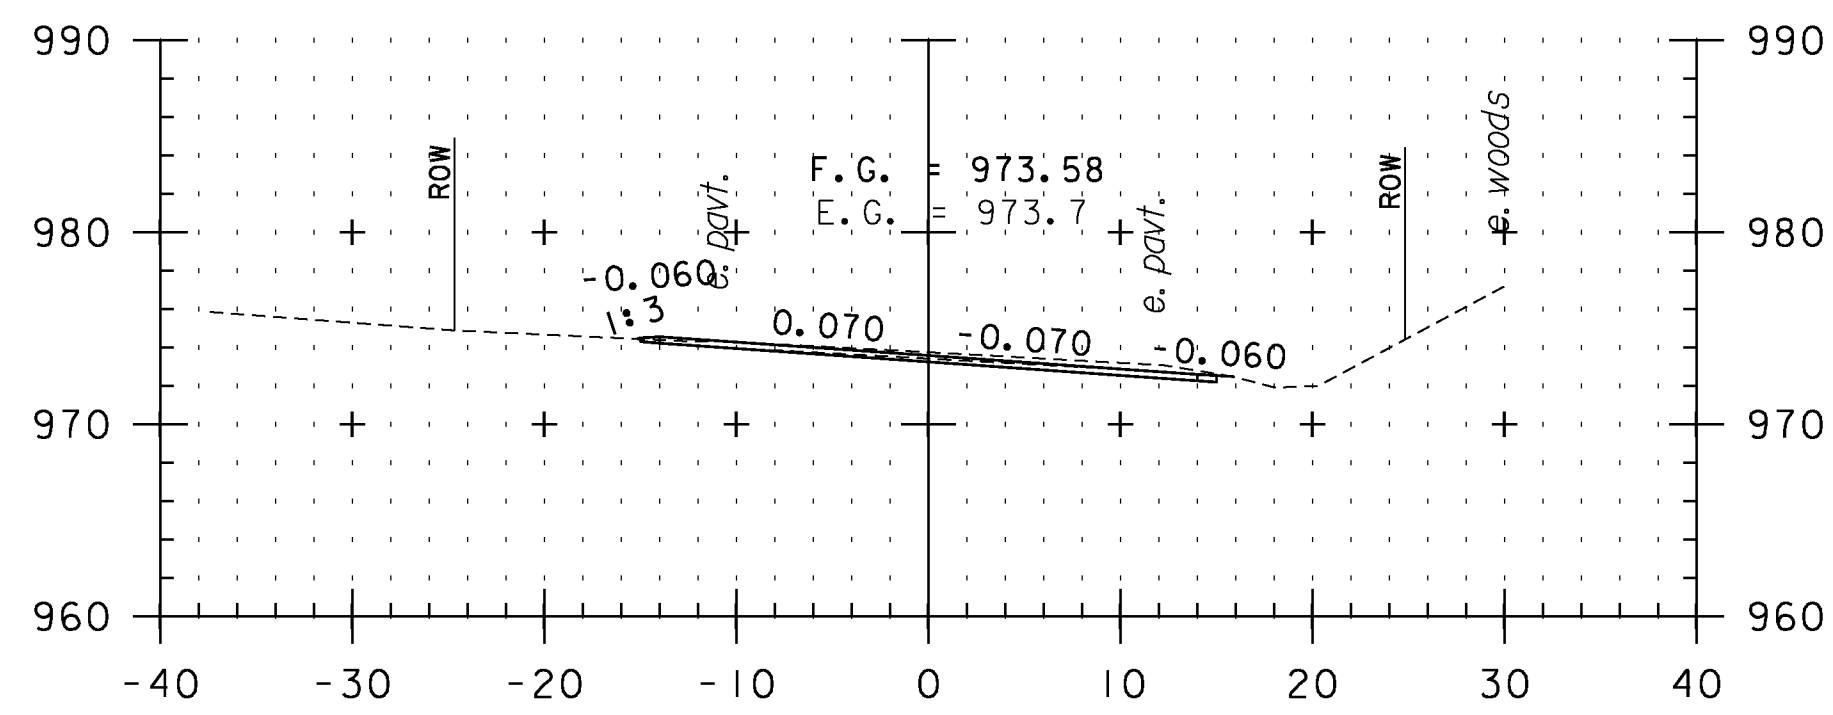


282+00

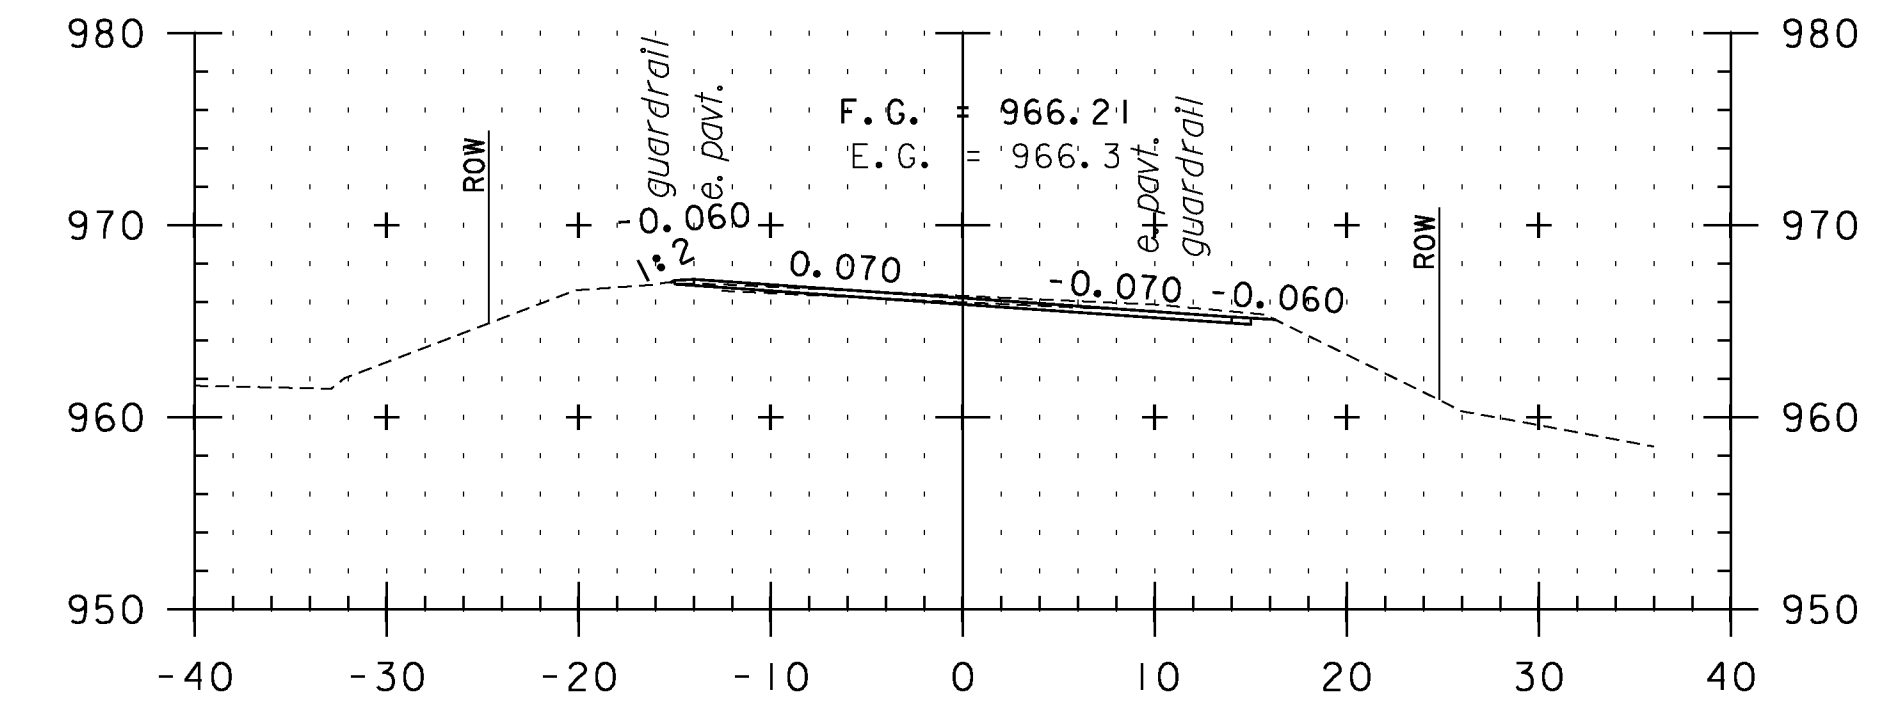


283+50

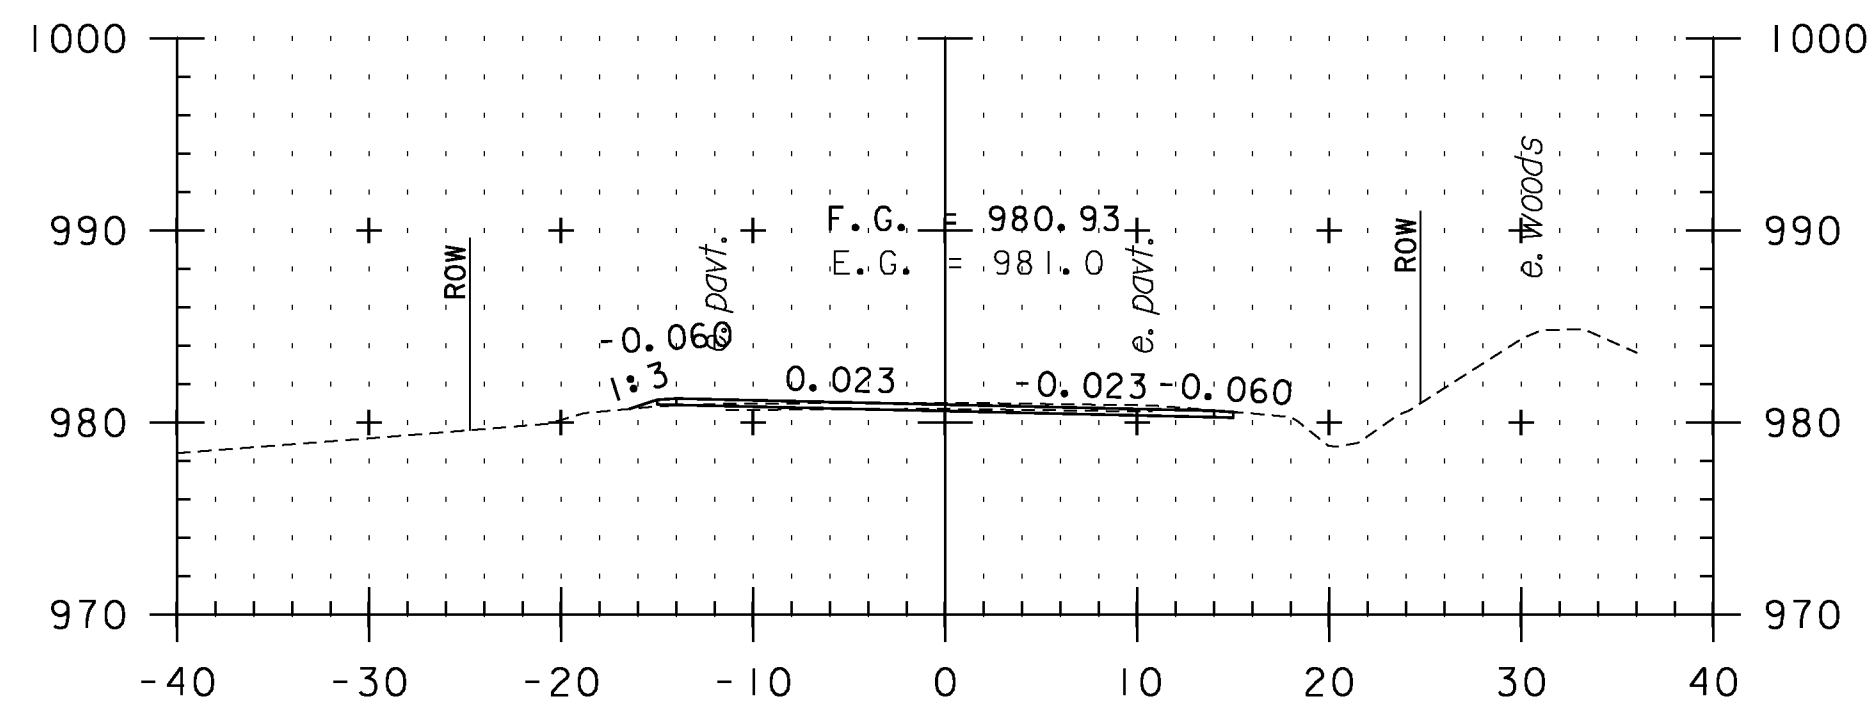


280+50

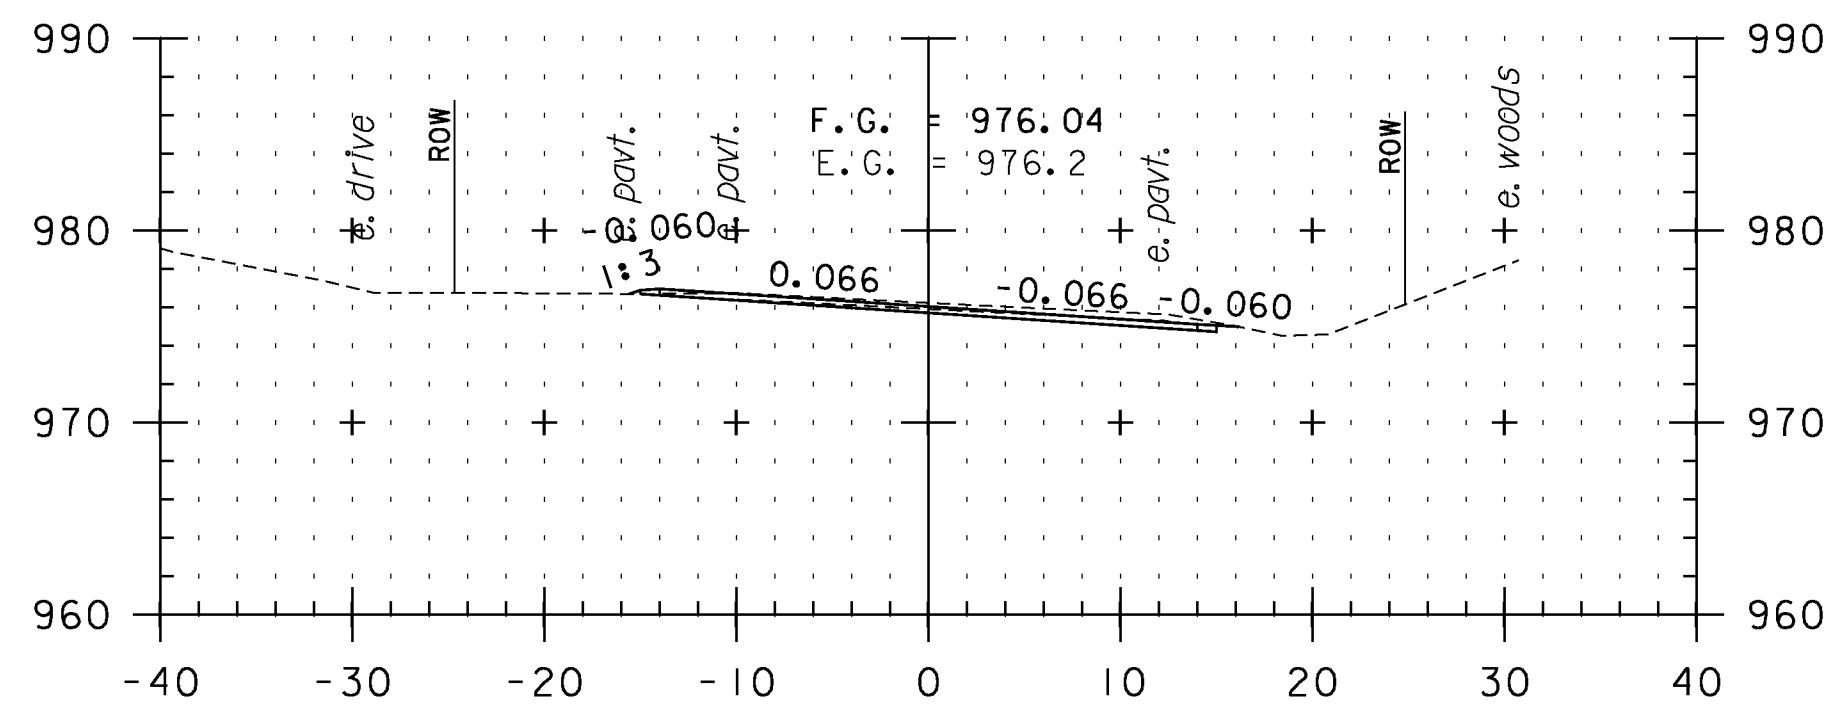


281+50

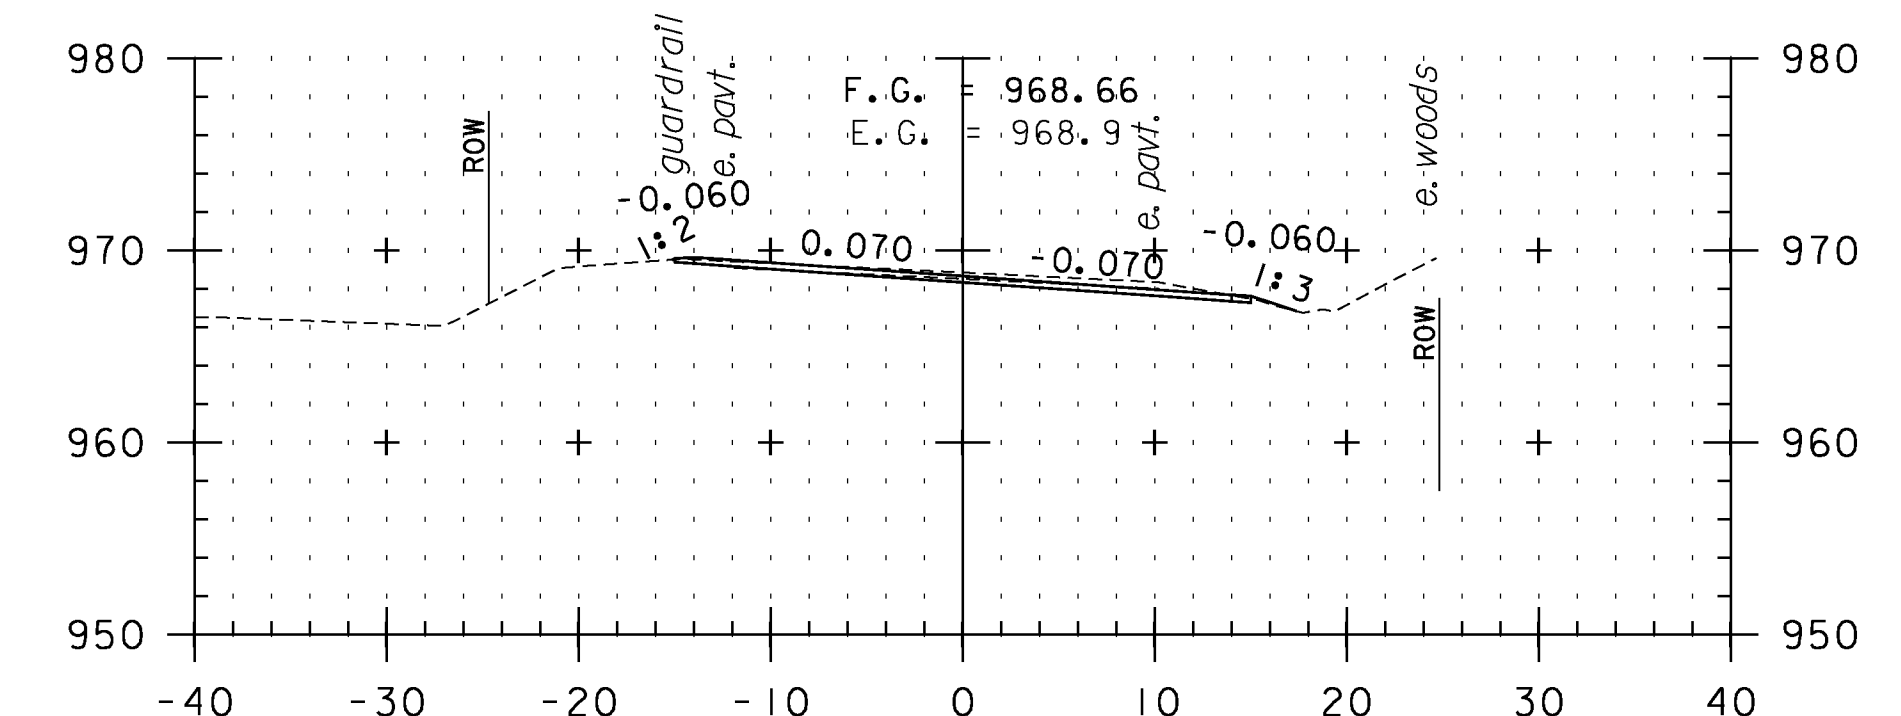


283+00

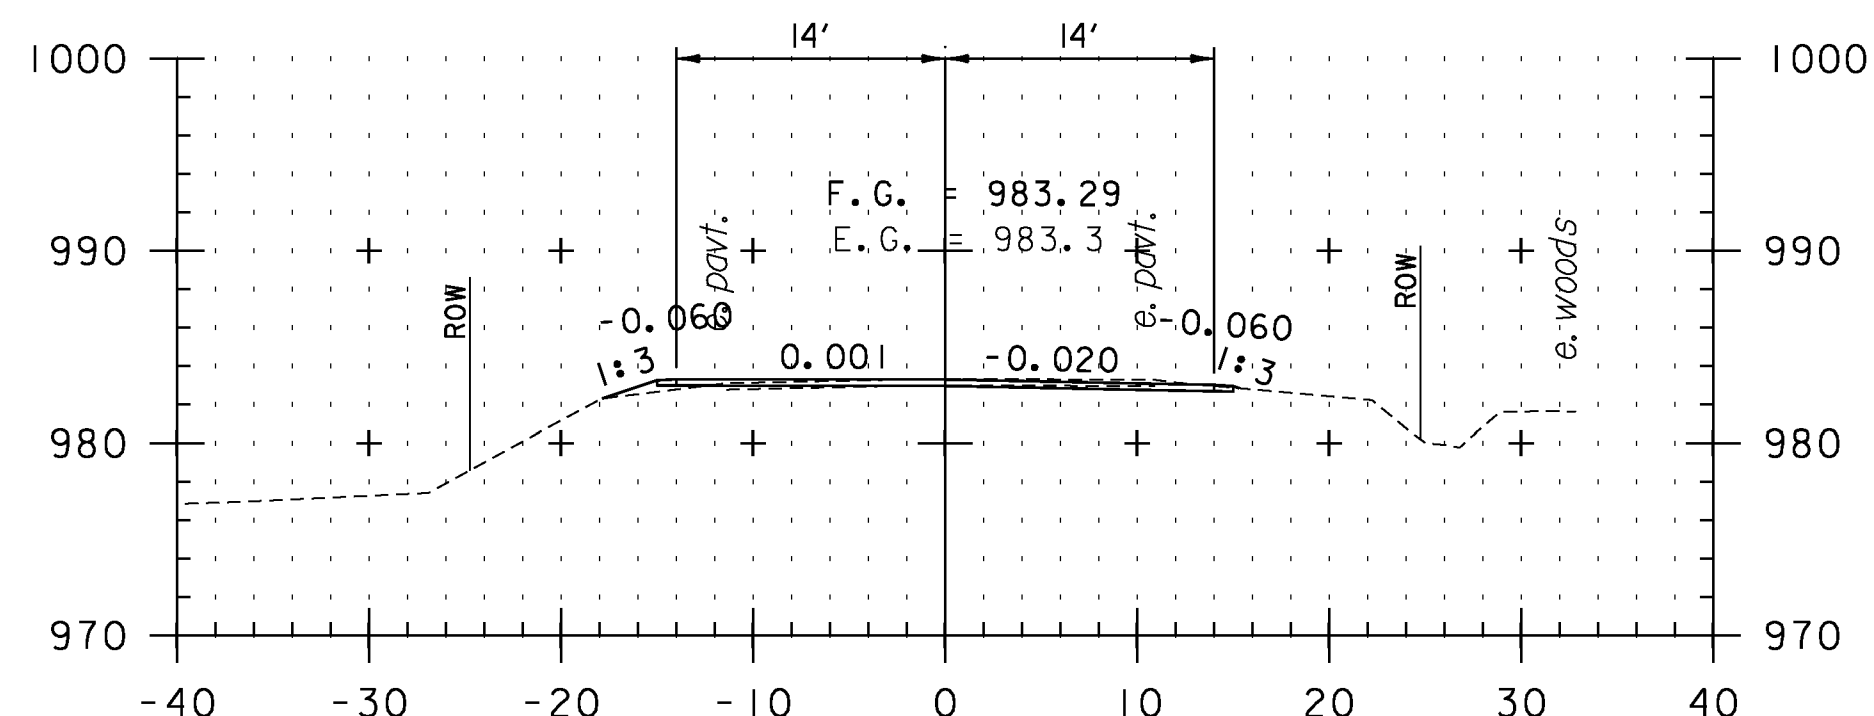

280+00

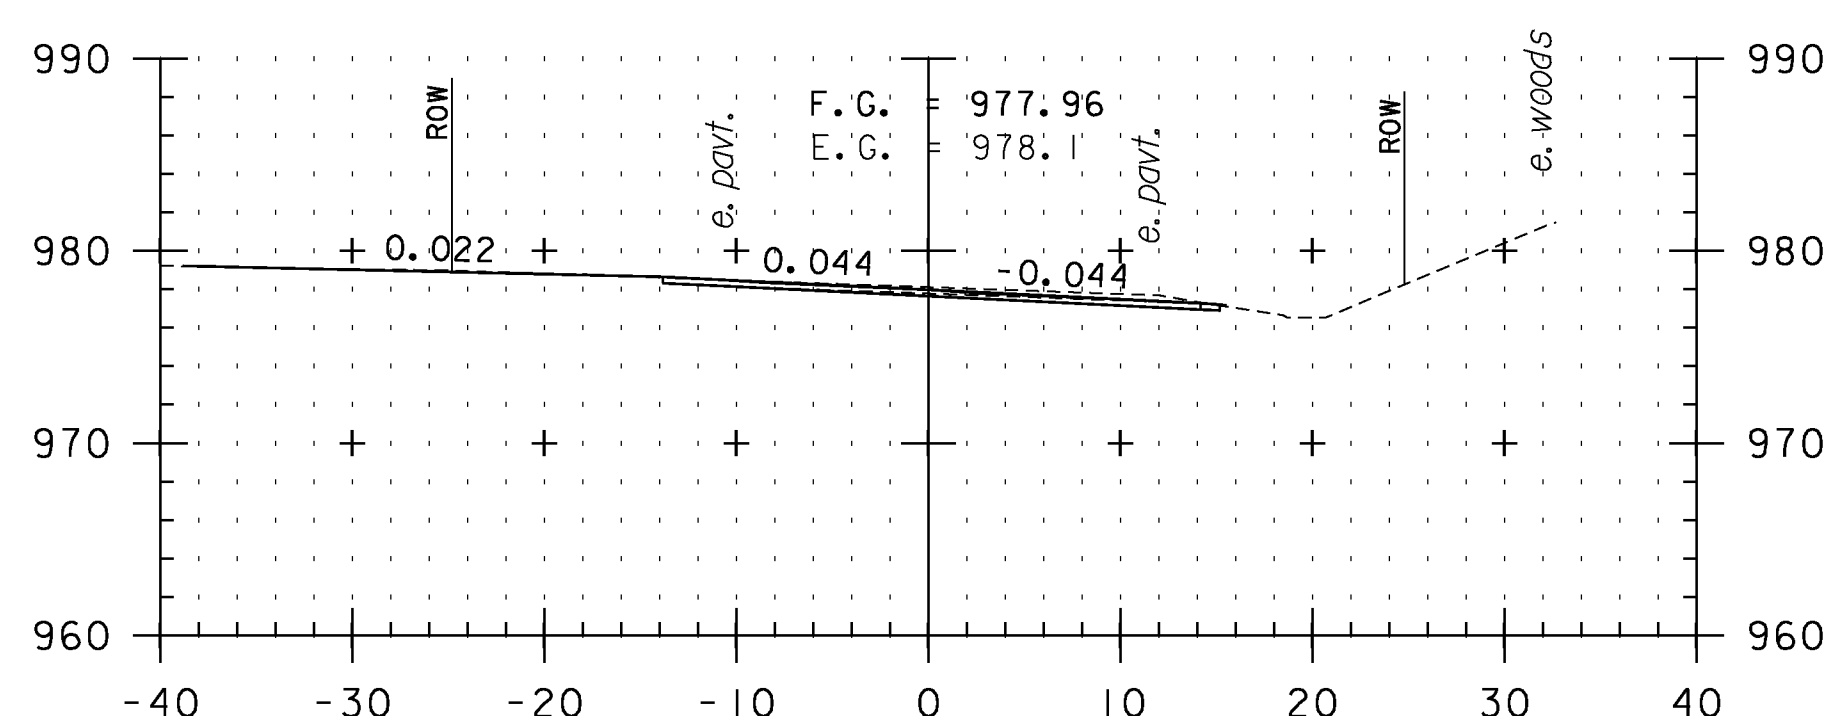

281+11
TH 3

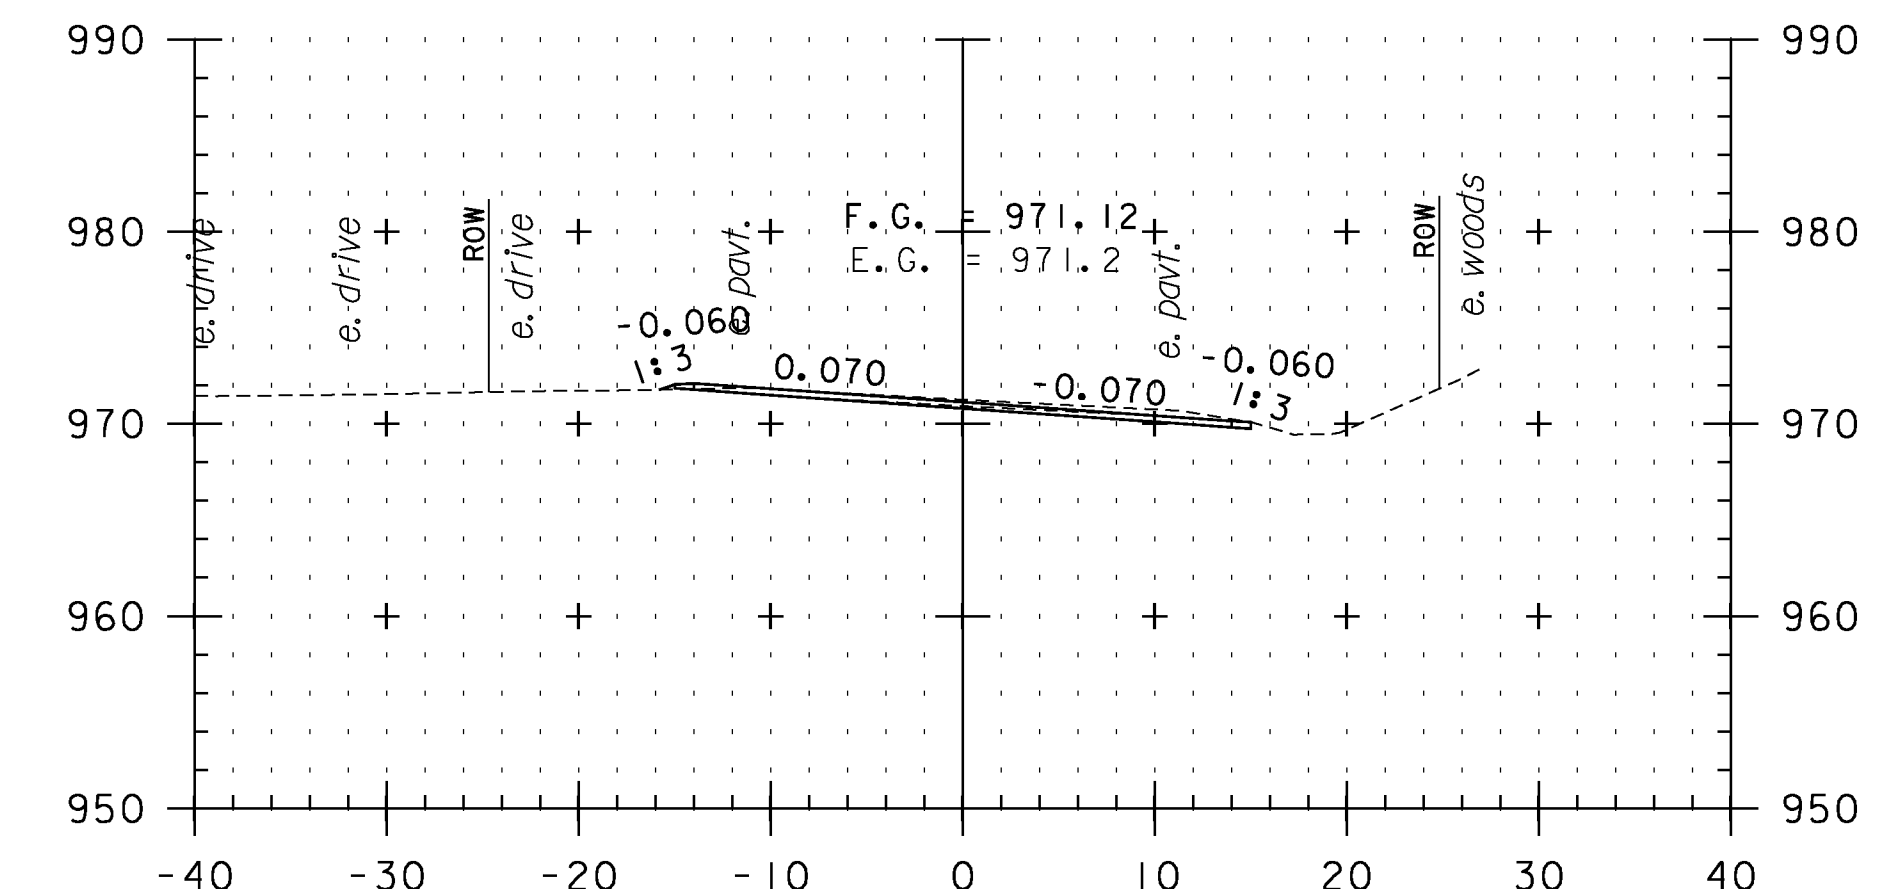

282+50

CROSS SECTION SHEET 23

STA. 280+00 TO STA. 283+50



PROJECT NAME: VERSHIRE-THETFORD	PLOT DATE: 1/29/2013
PROJECT NUMBER: STP 2911(I)	DRAWN BY: SNG
FILE NAME: pl0c224.dgn	CHECKED BY: PTS
PROJECT LEADER: PTS	SHEET 131 OF 232
DESIGNED BY: NLL	
IPARM FILE NAME: IOC224_I31	