




285+00

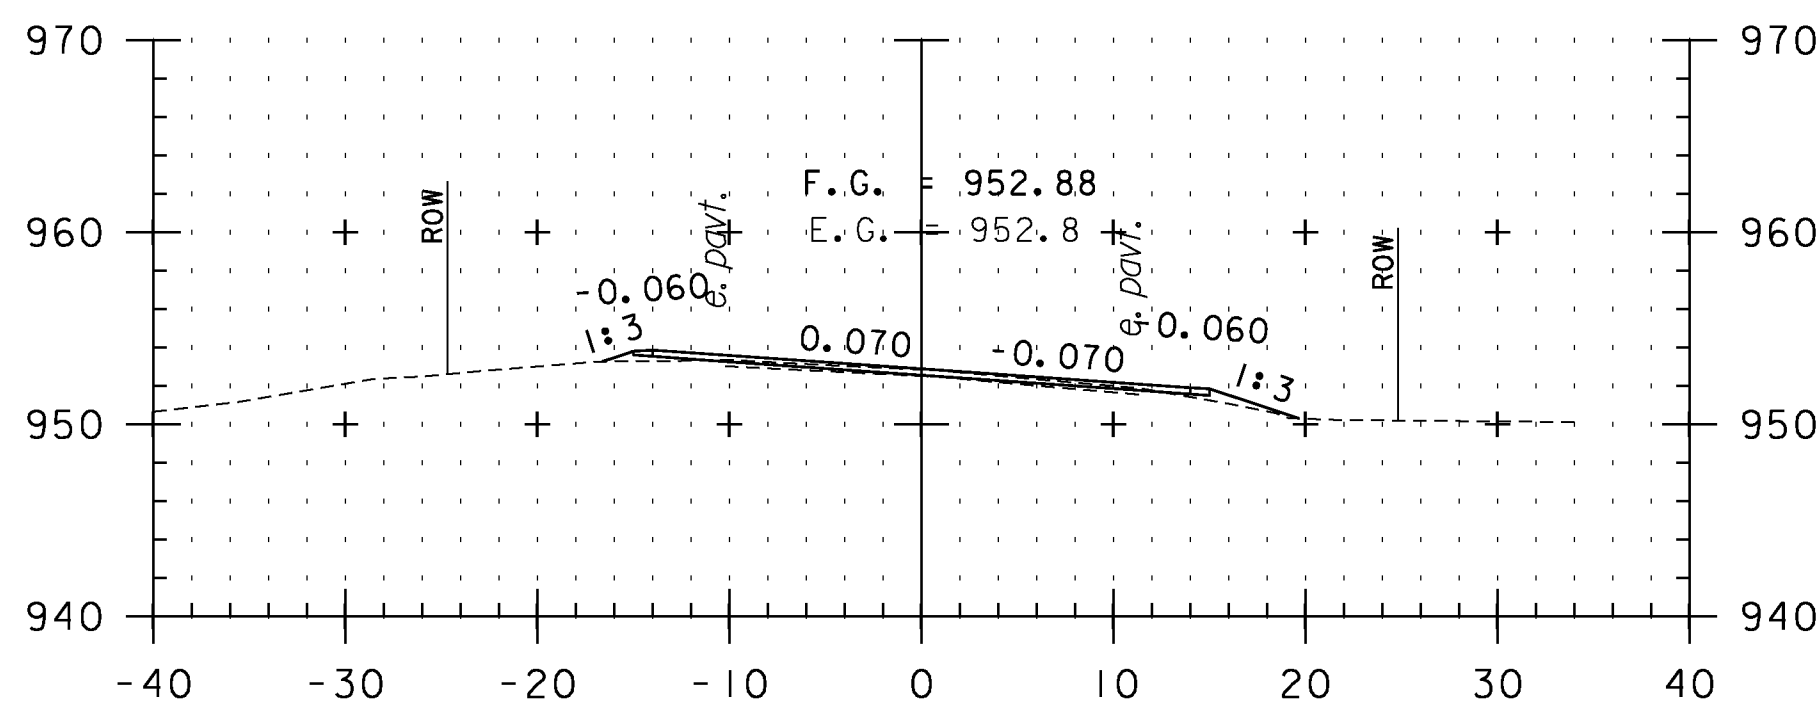


286+50

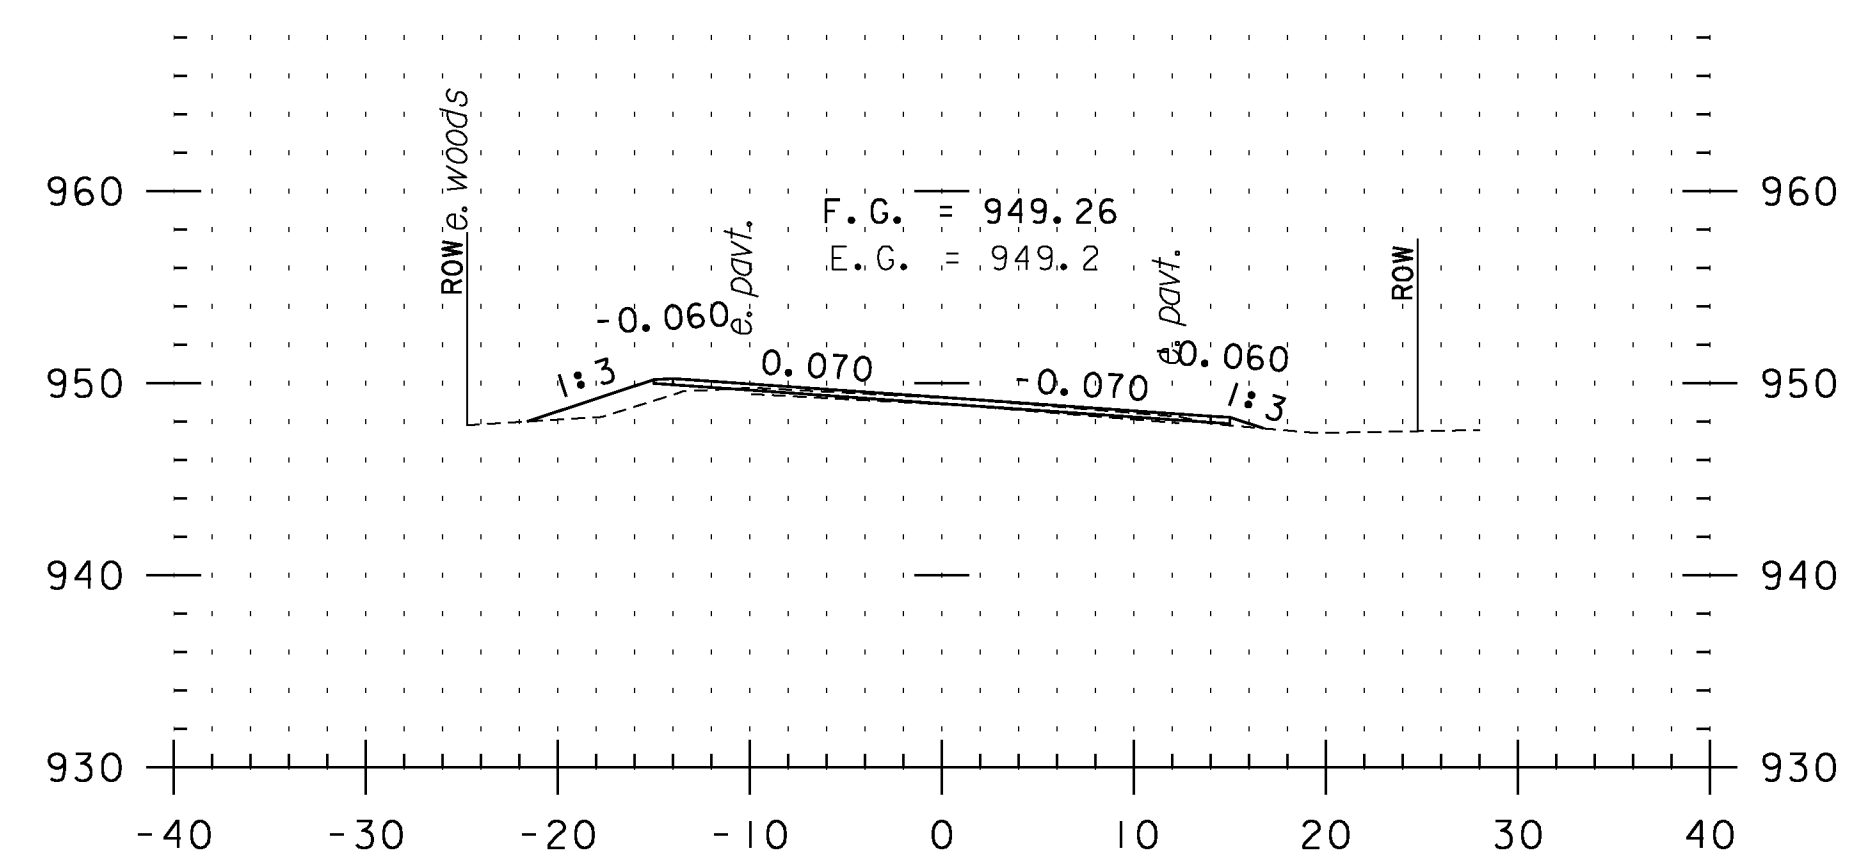


288+00

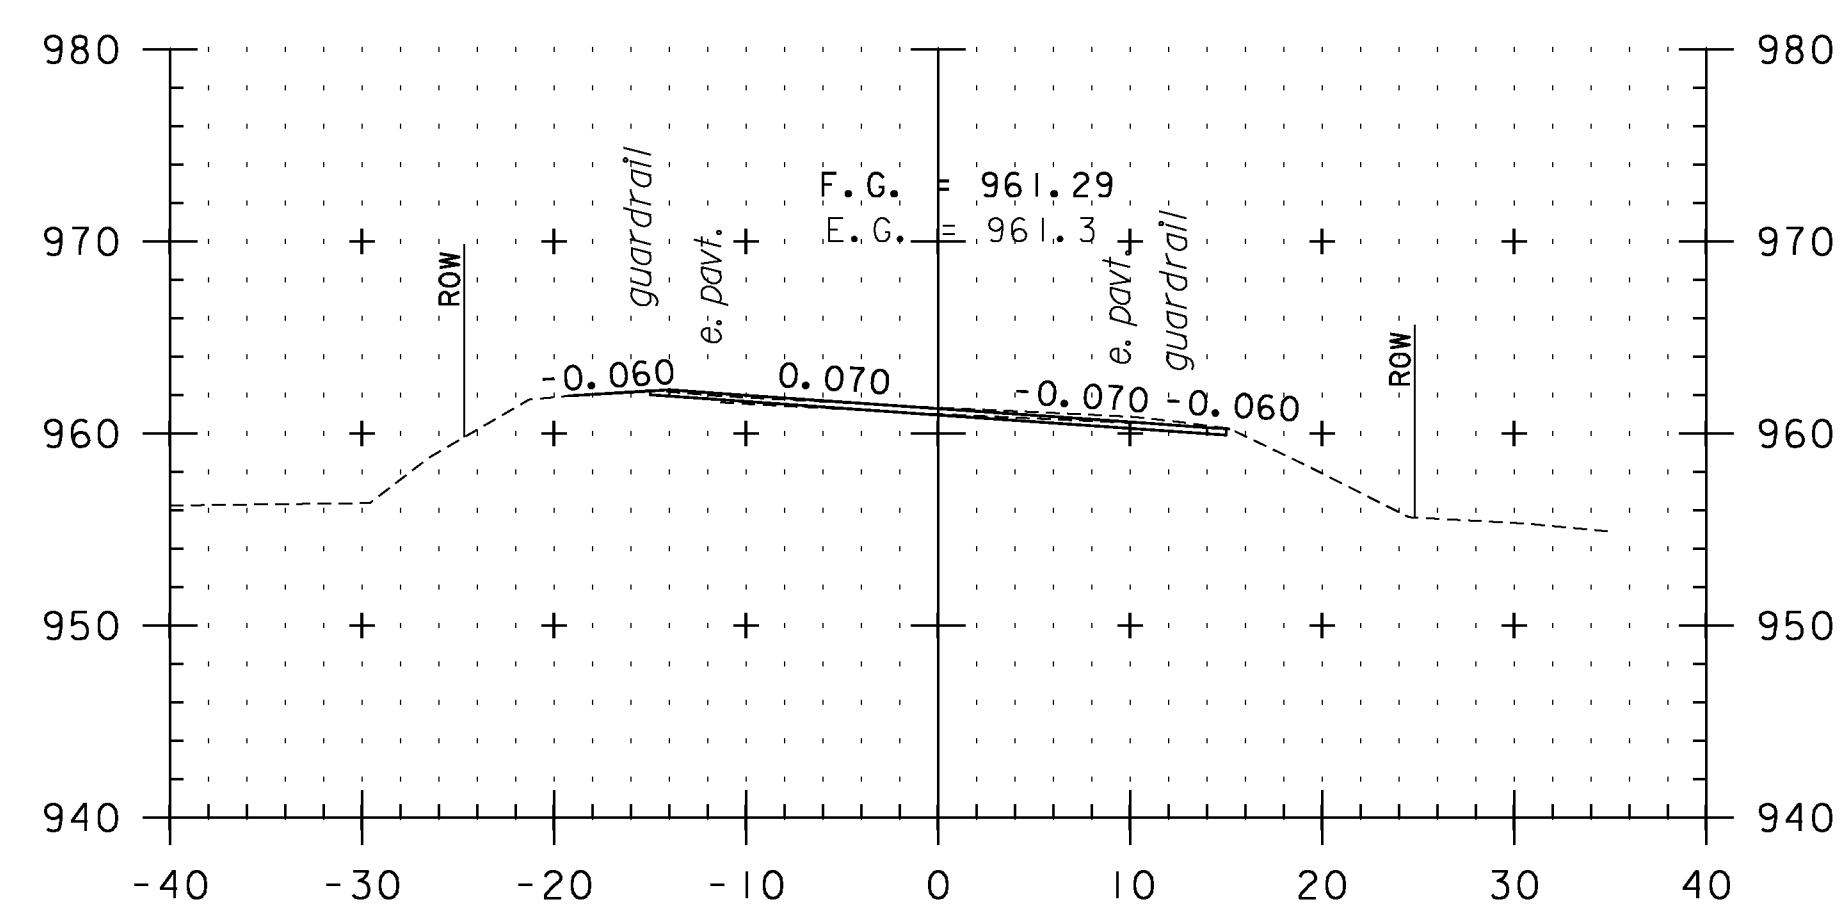


284+50

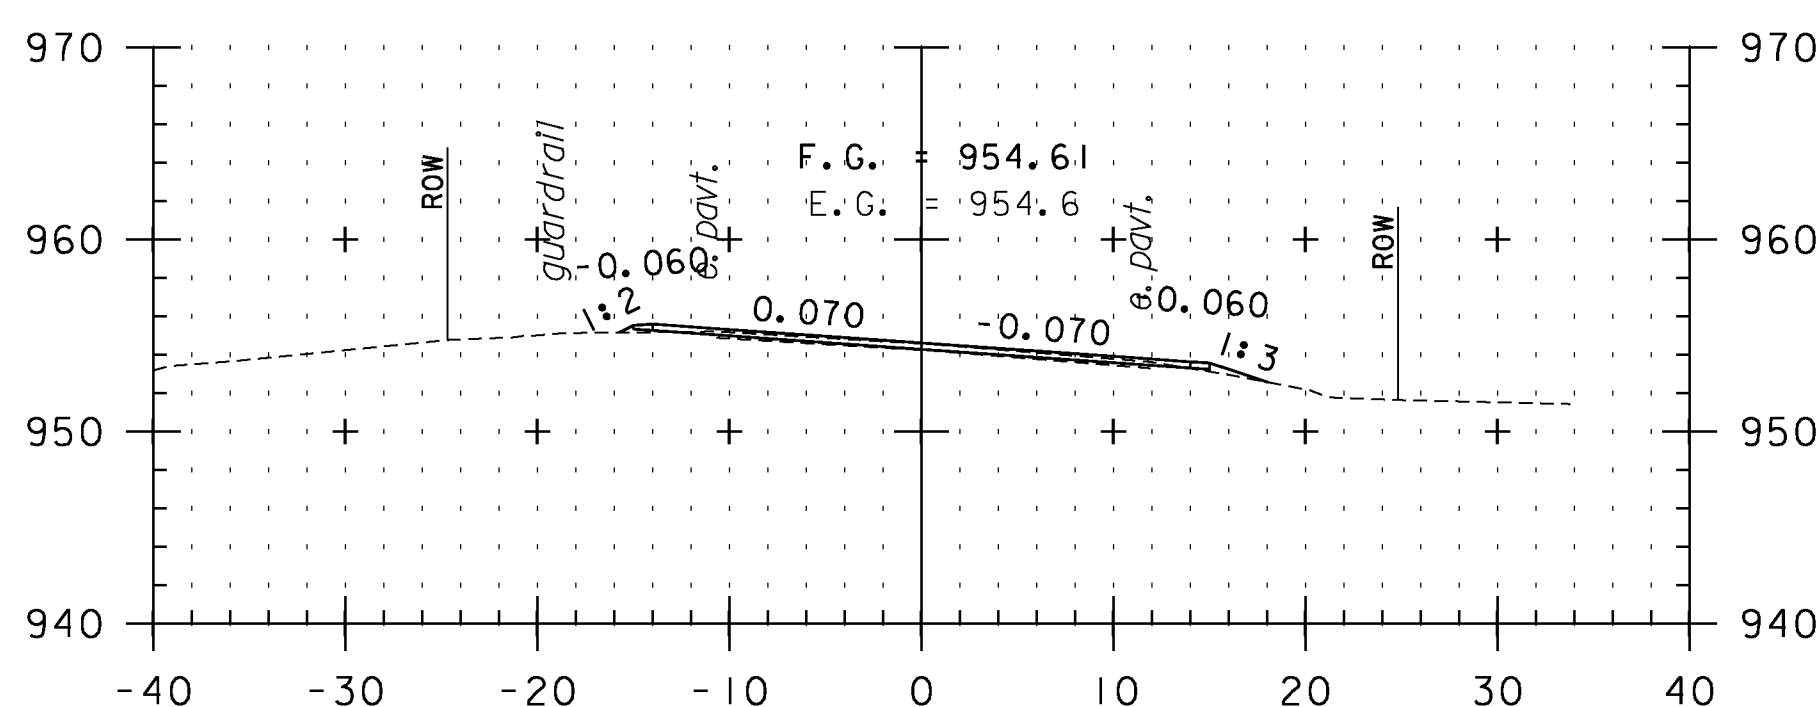


286+00

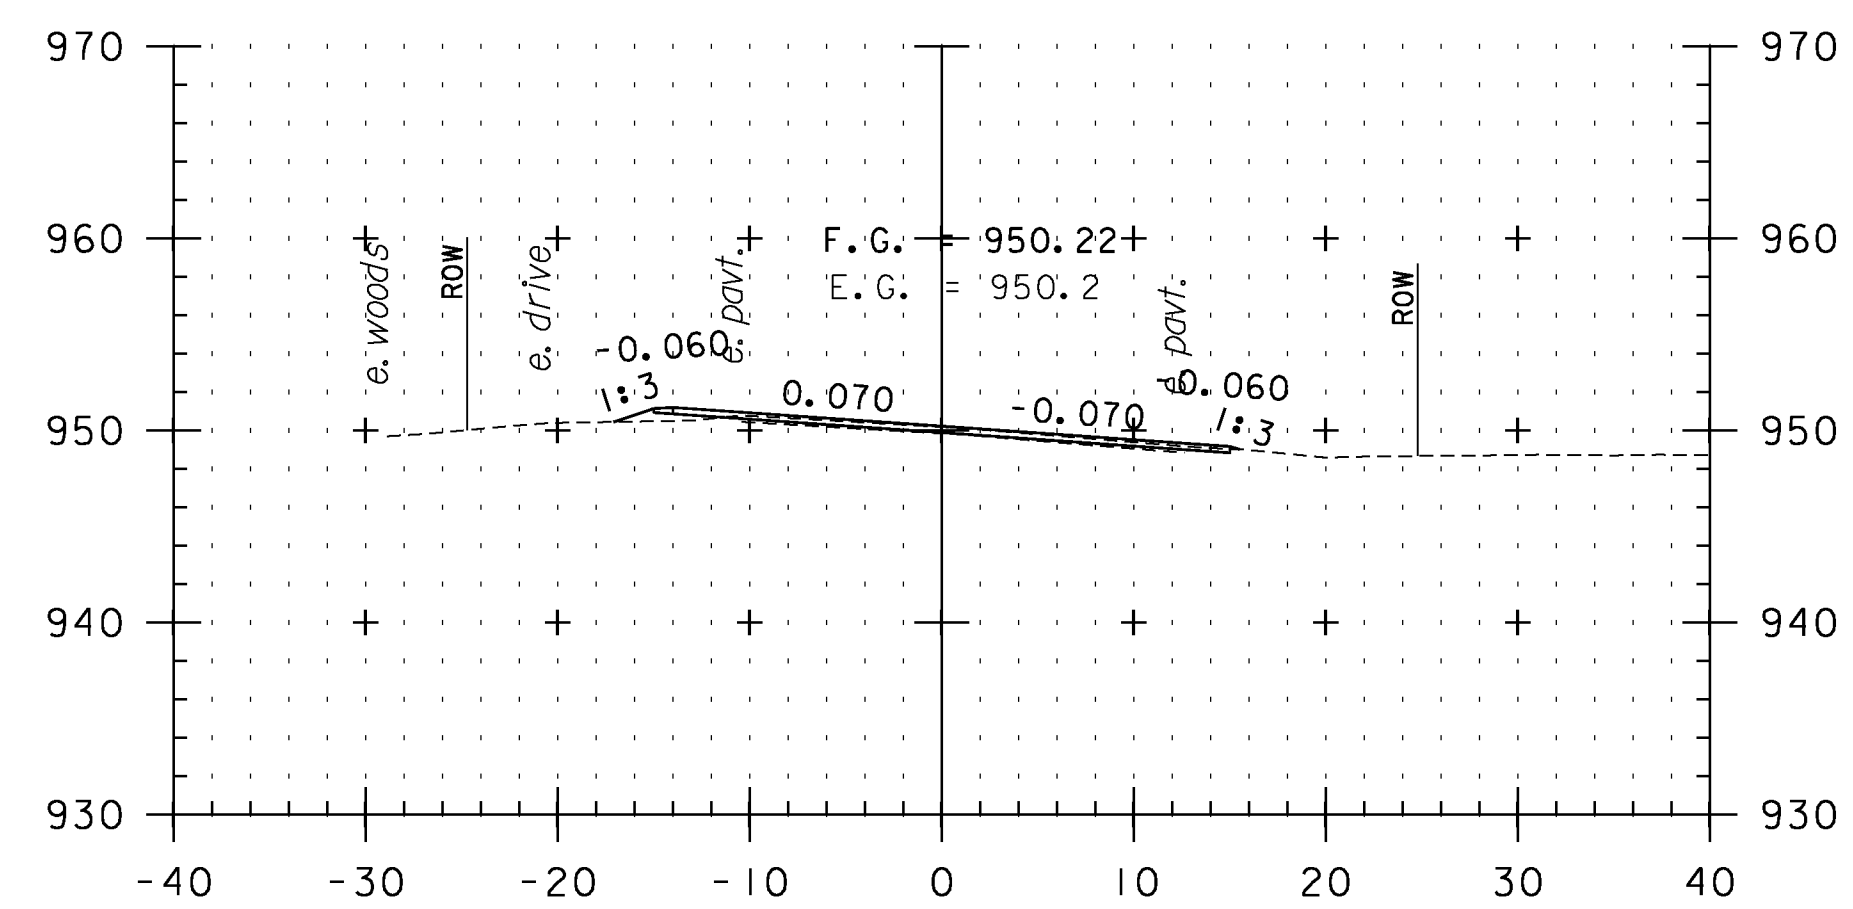


287+50

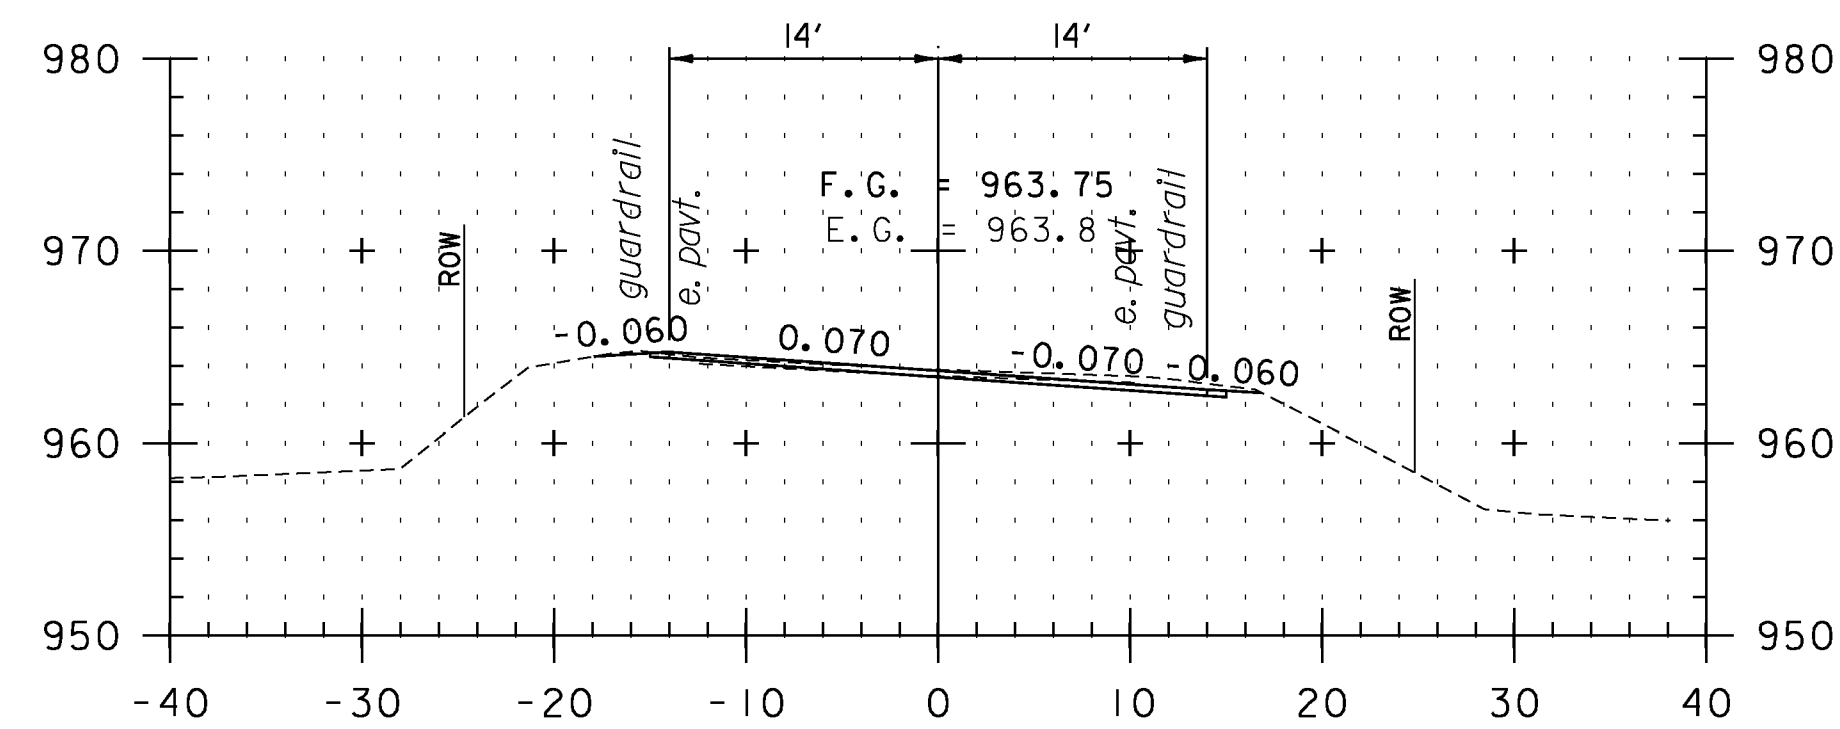

284+00

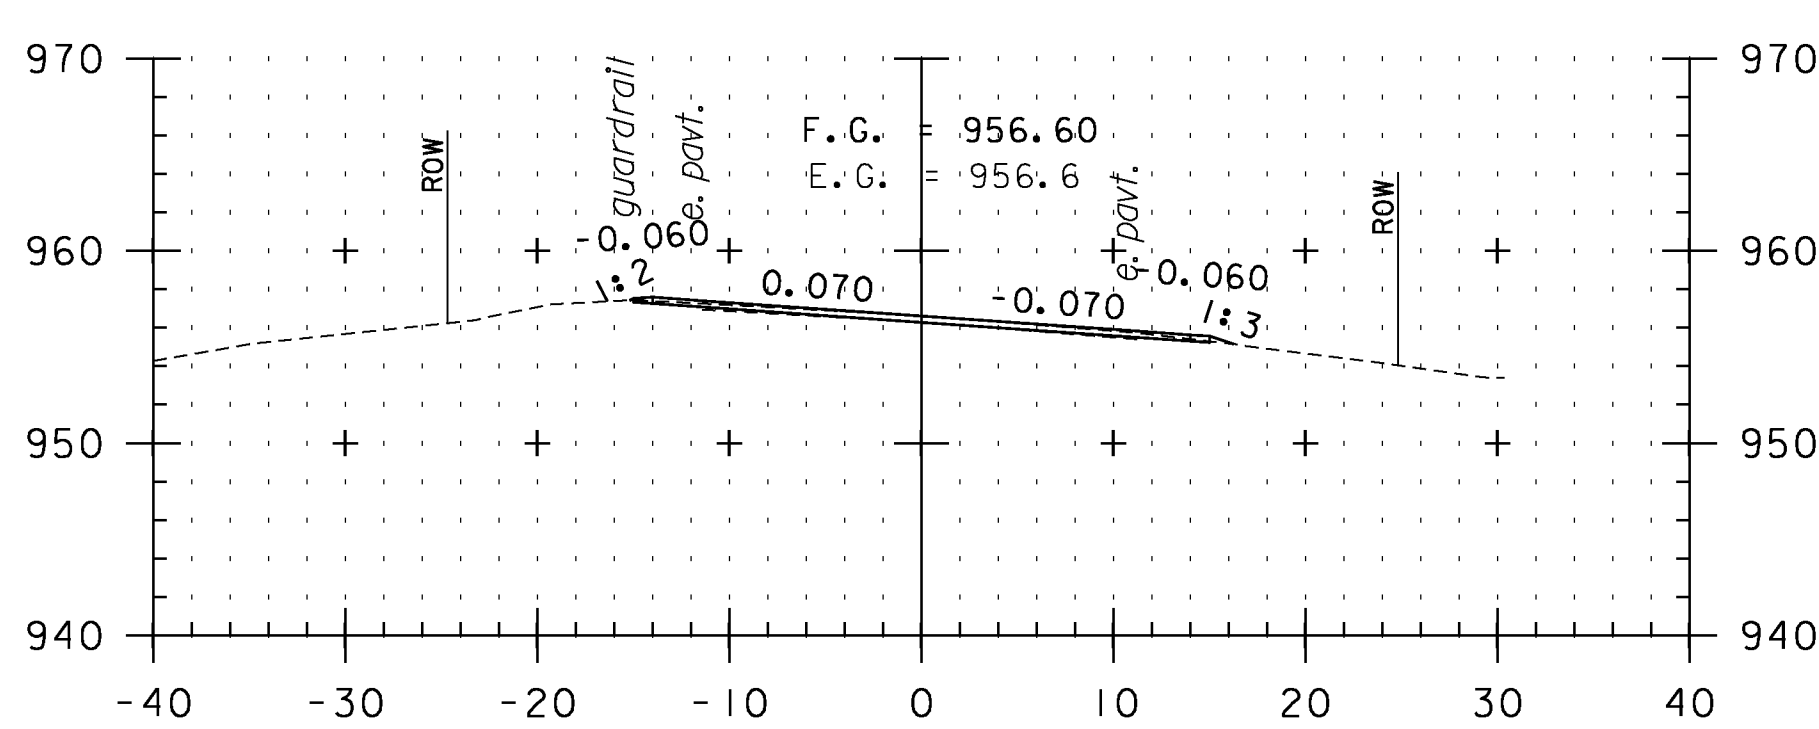


285+50

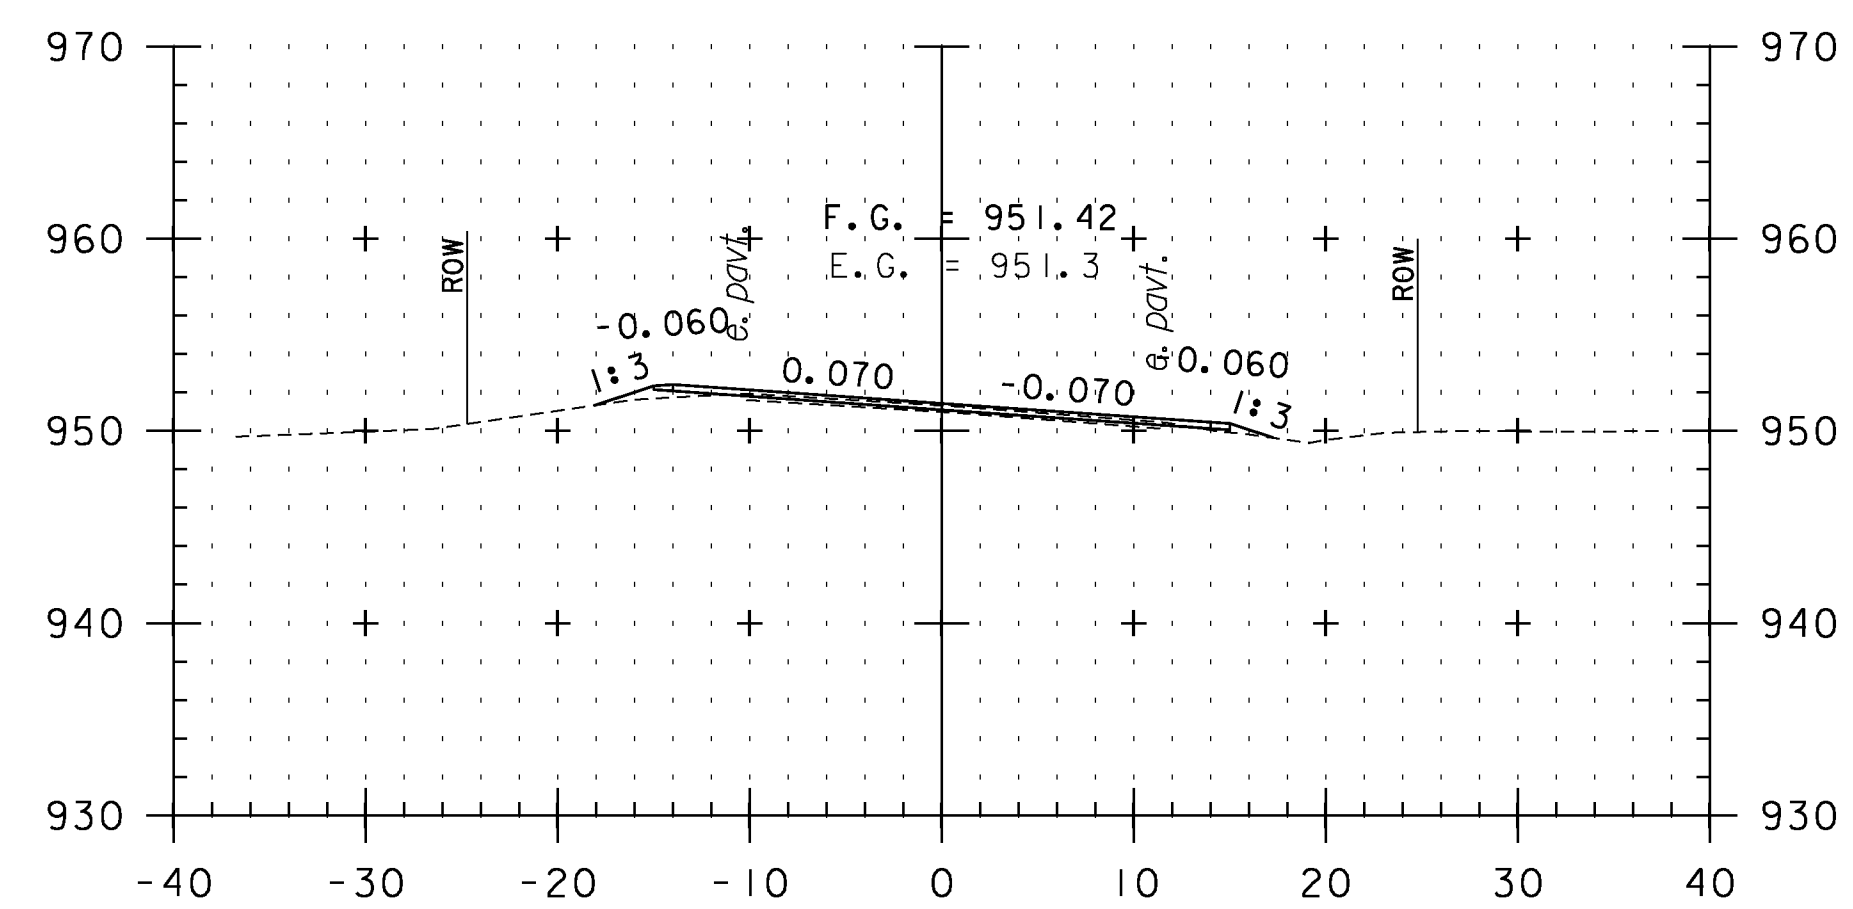

287+00

CROSS SECTION SHEET 24

STA. 284+00 TO STA. 288+00

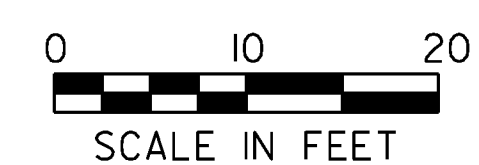

PROJECT NAME: VERSHIRE-THETFORD	PLOT DATE: 1/29/2013
PROJECT NUMBER: STP 2911(I)	DRAWN BY: SNG
FILE NAME: pl0c224.dgn	CHECKED BY: PTS
PROJECT LEADER: PTS	SHEET 132 OF 232
DESIGNED BY: NULL	
IPARM FILE NAME: IOC224_132	