




289+50

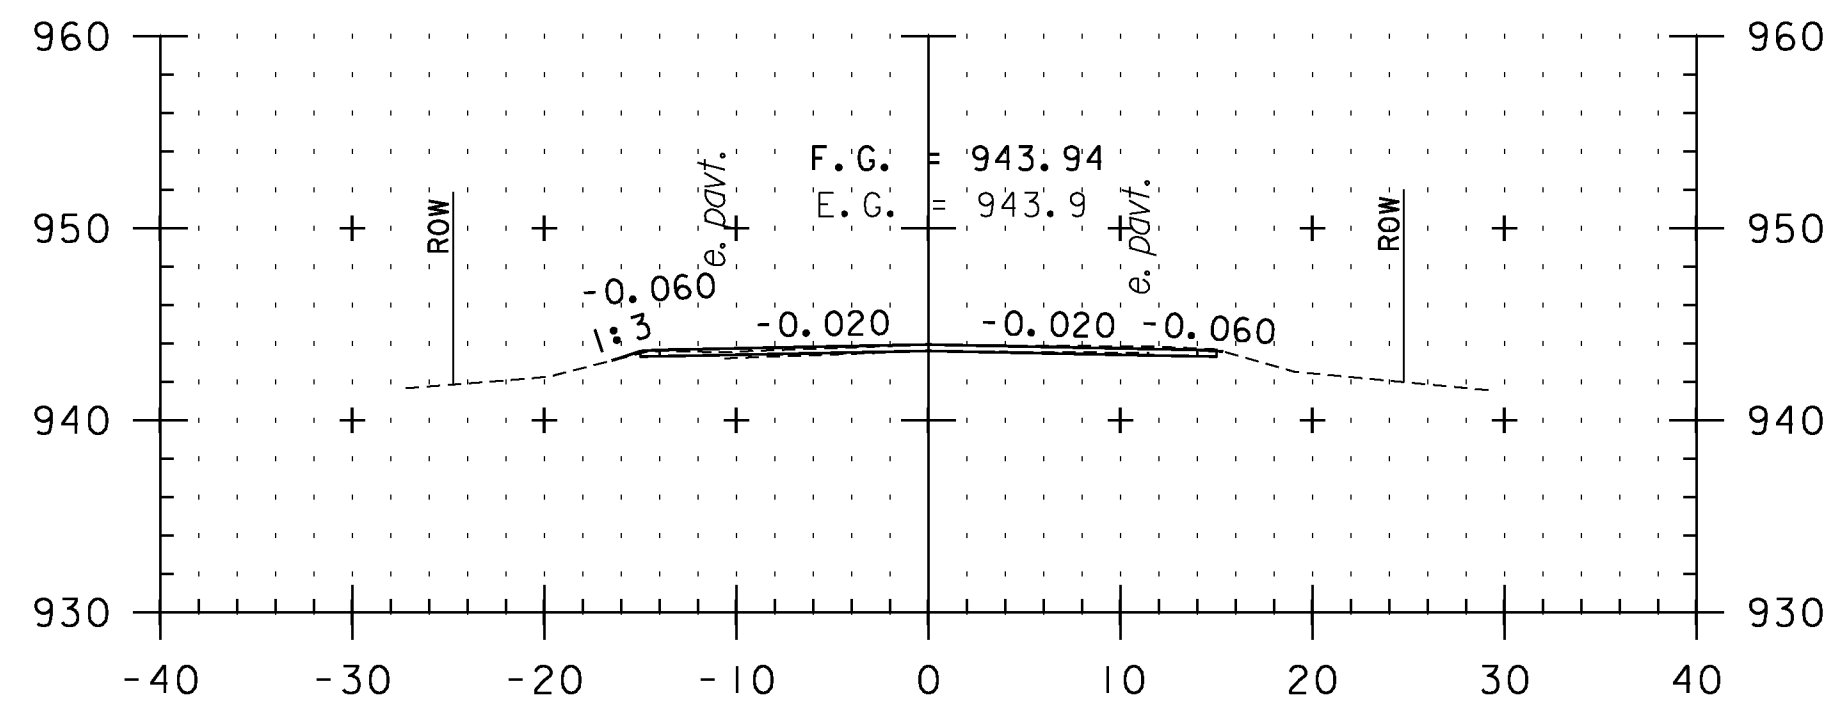


291+00

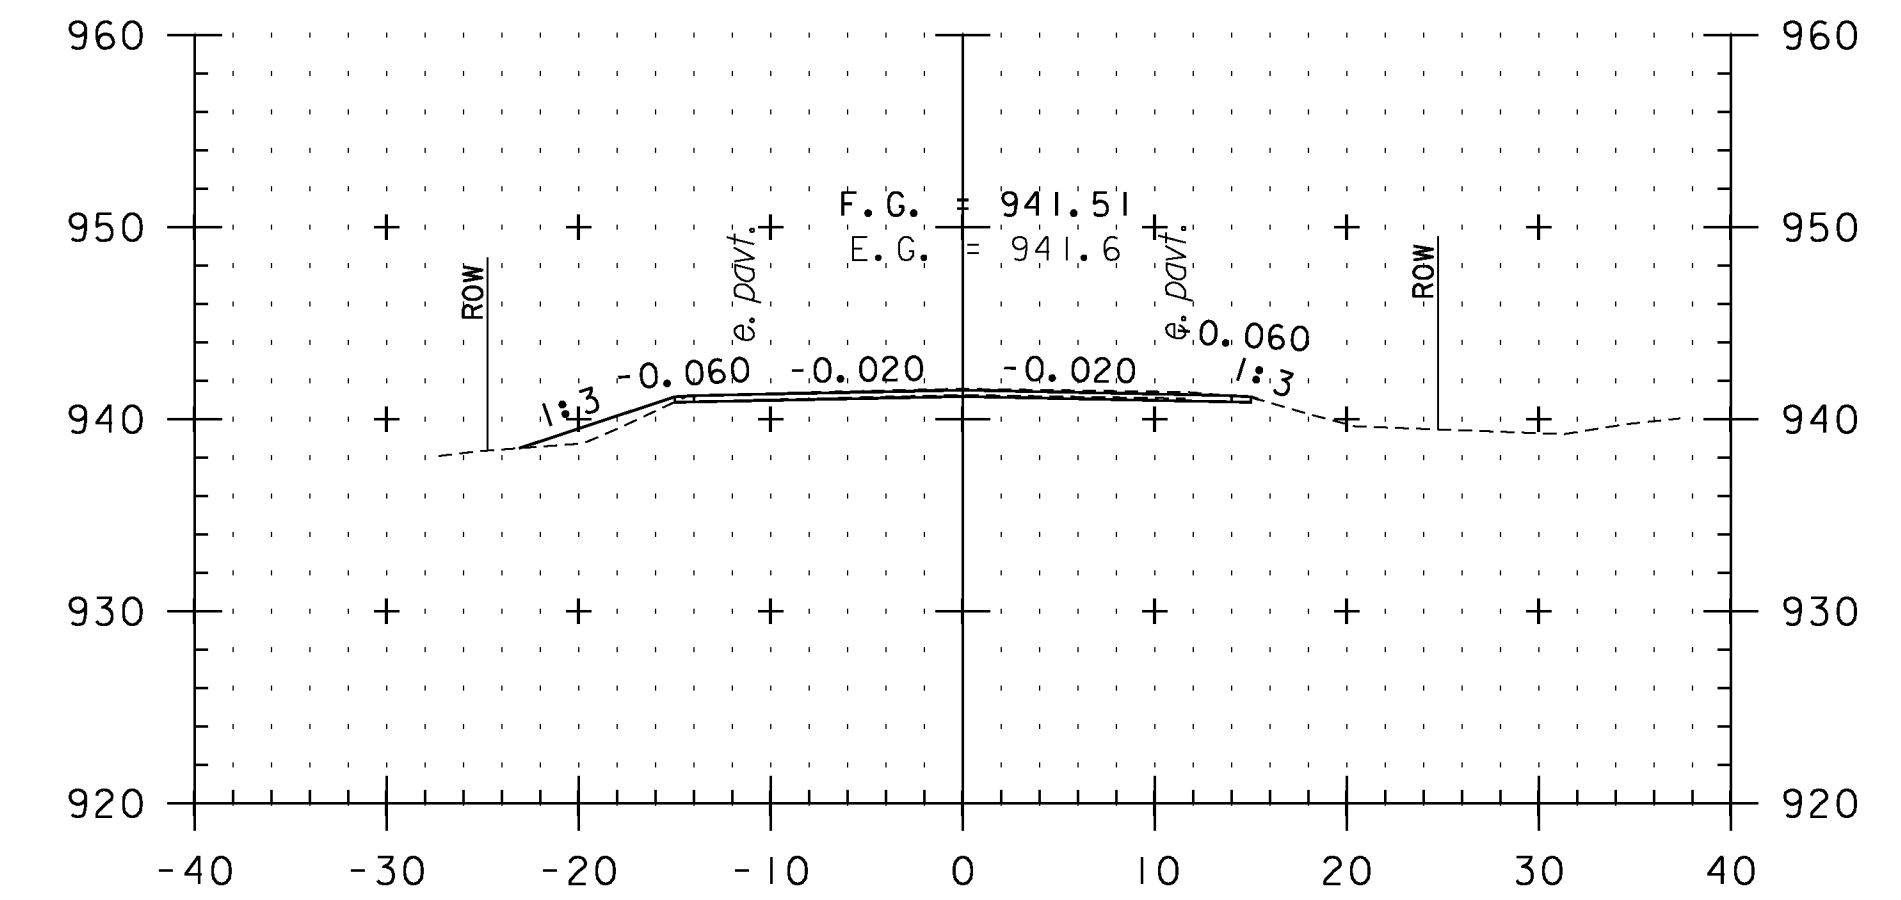


292+50

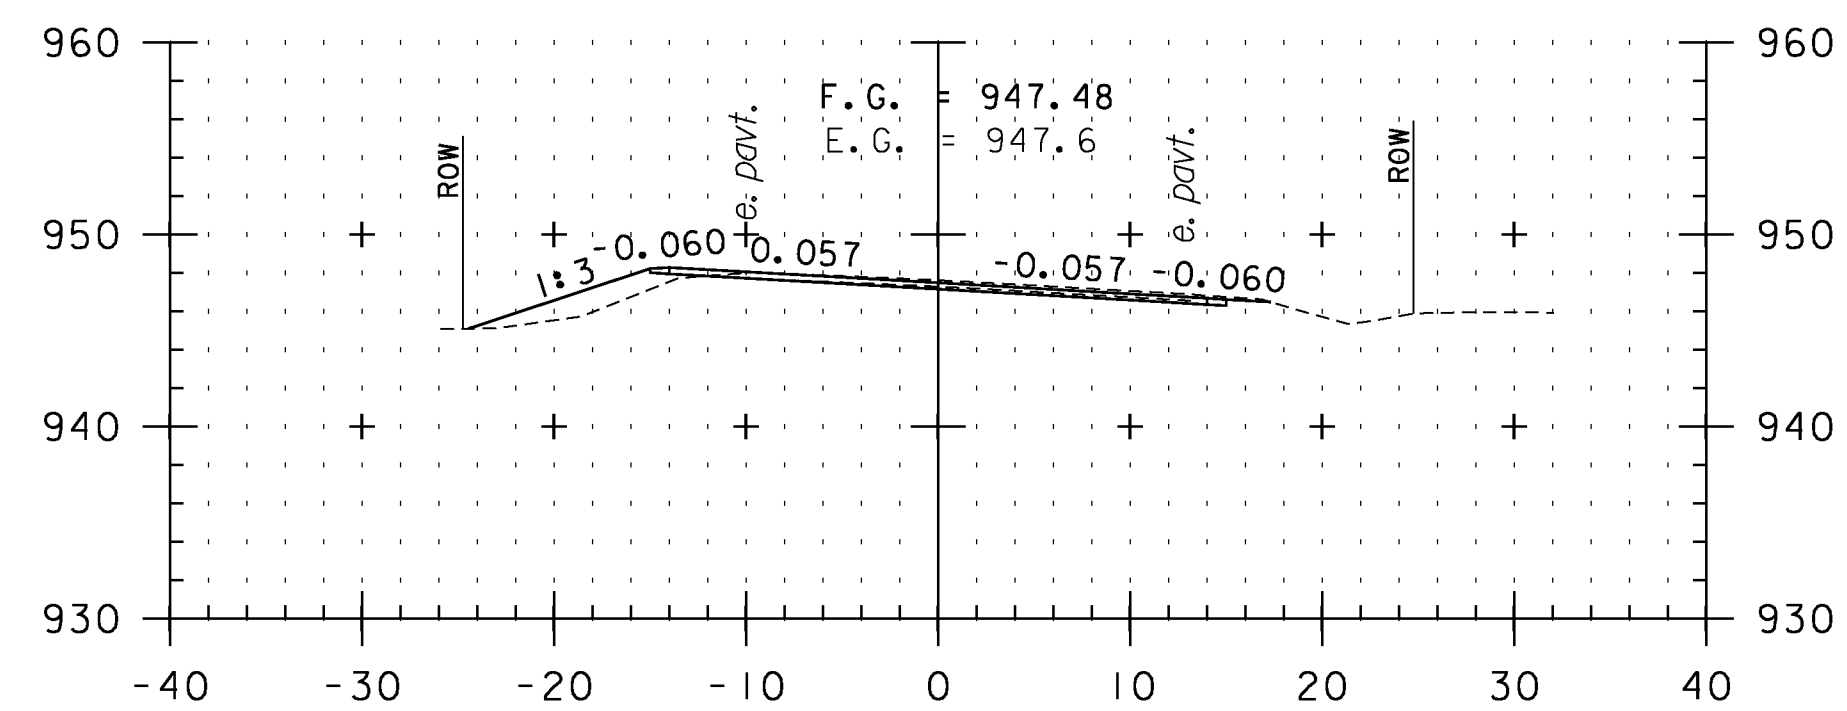


289+00

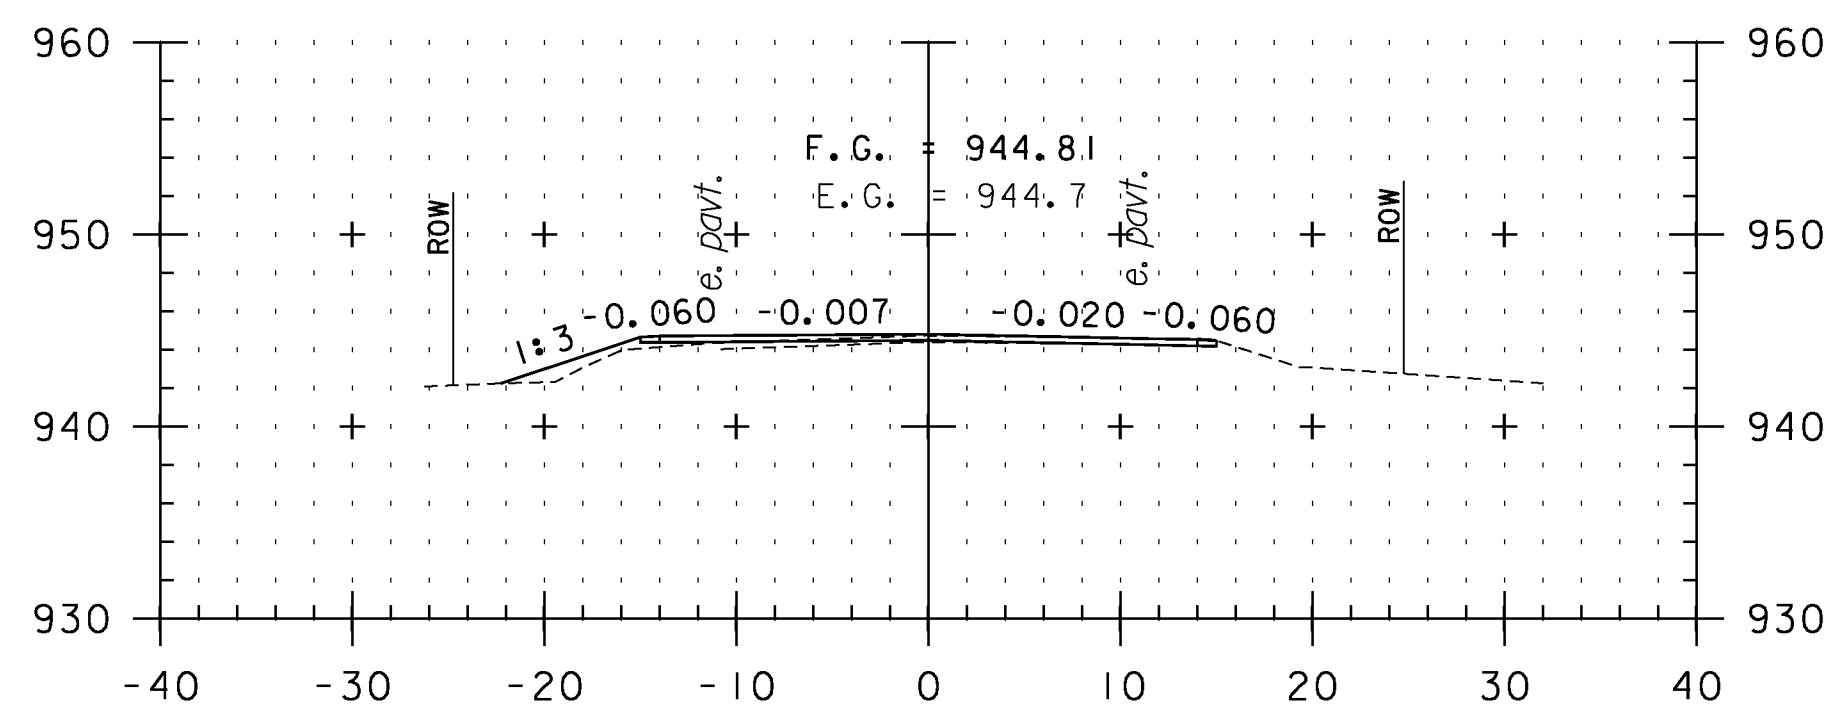


290+50

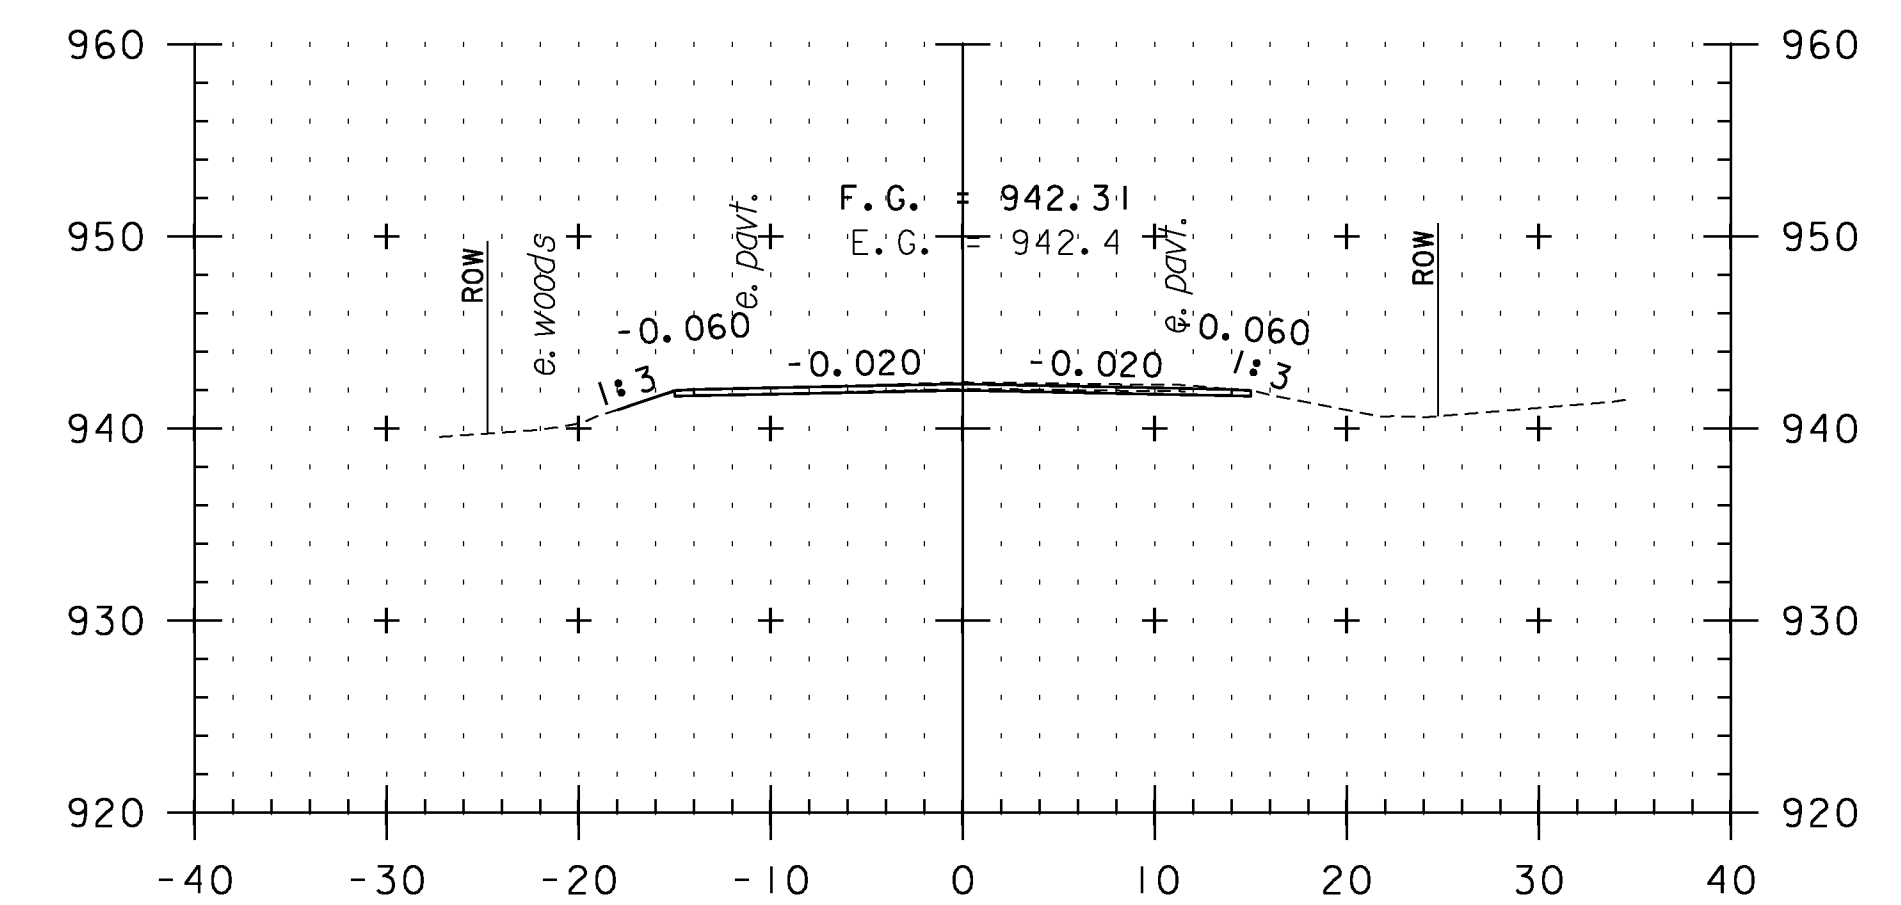


292+00

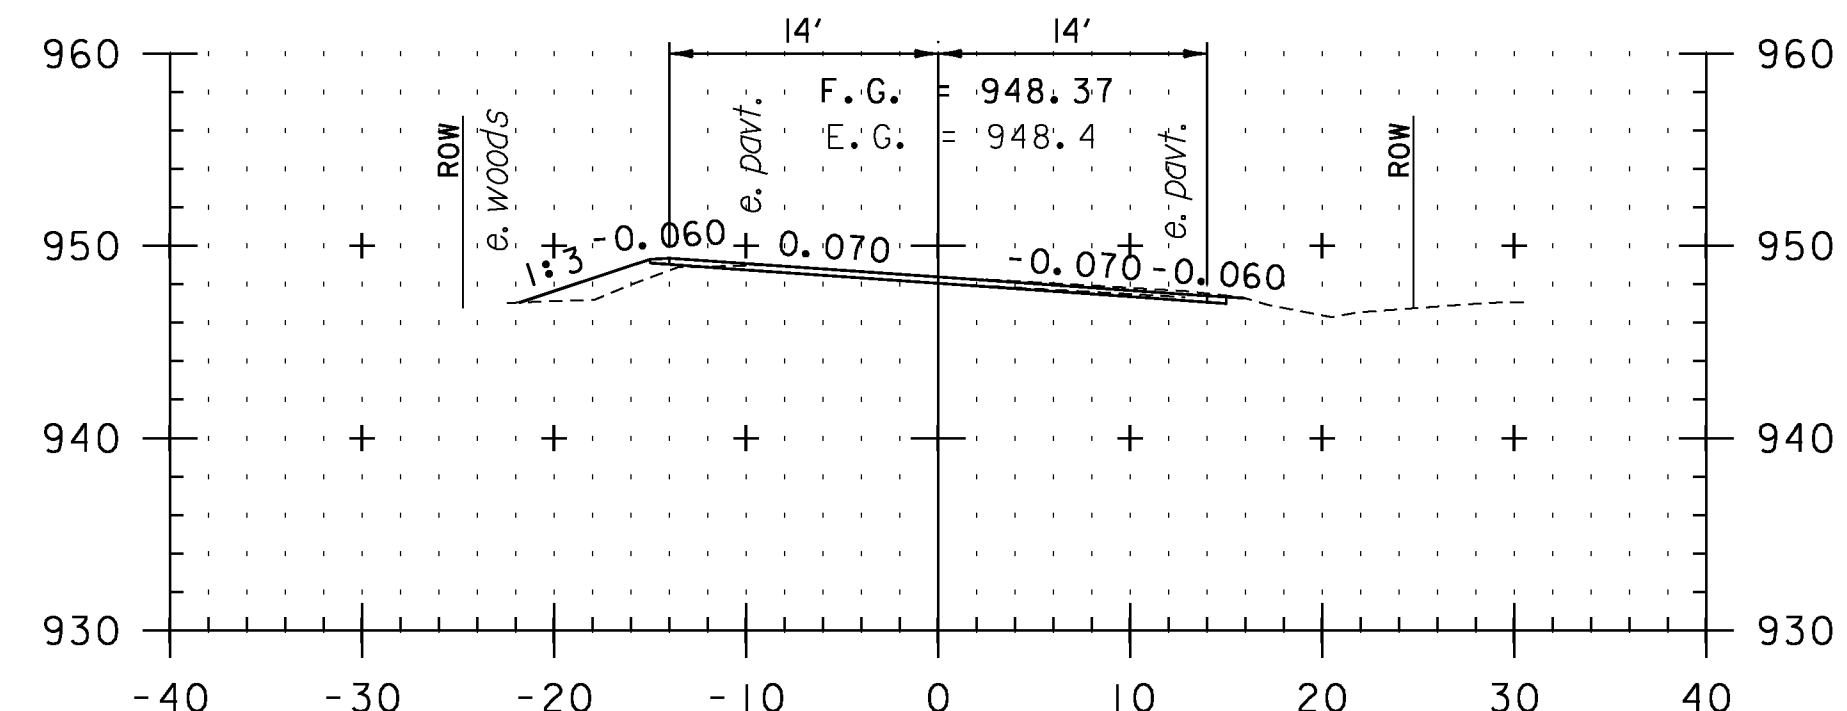

288+50

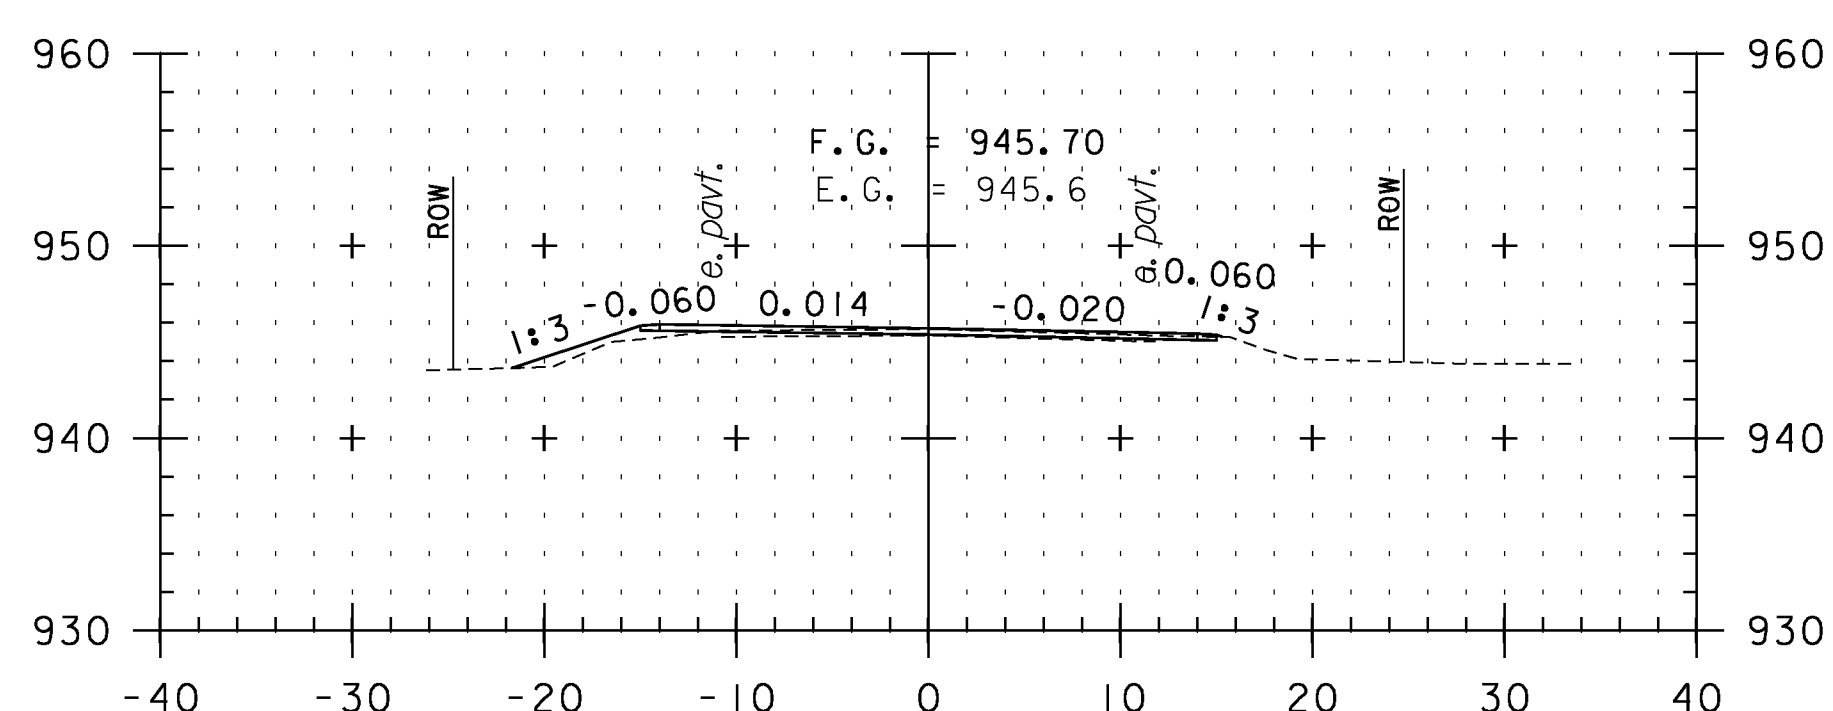

290+00

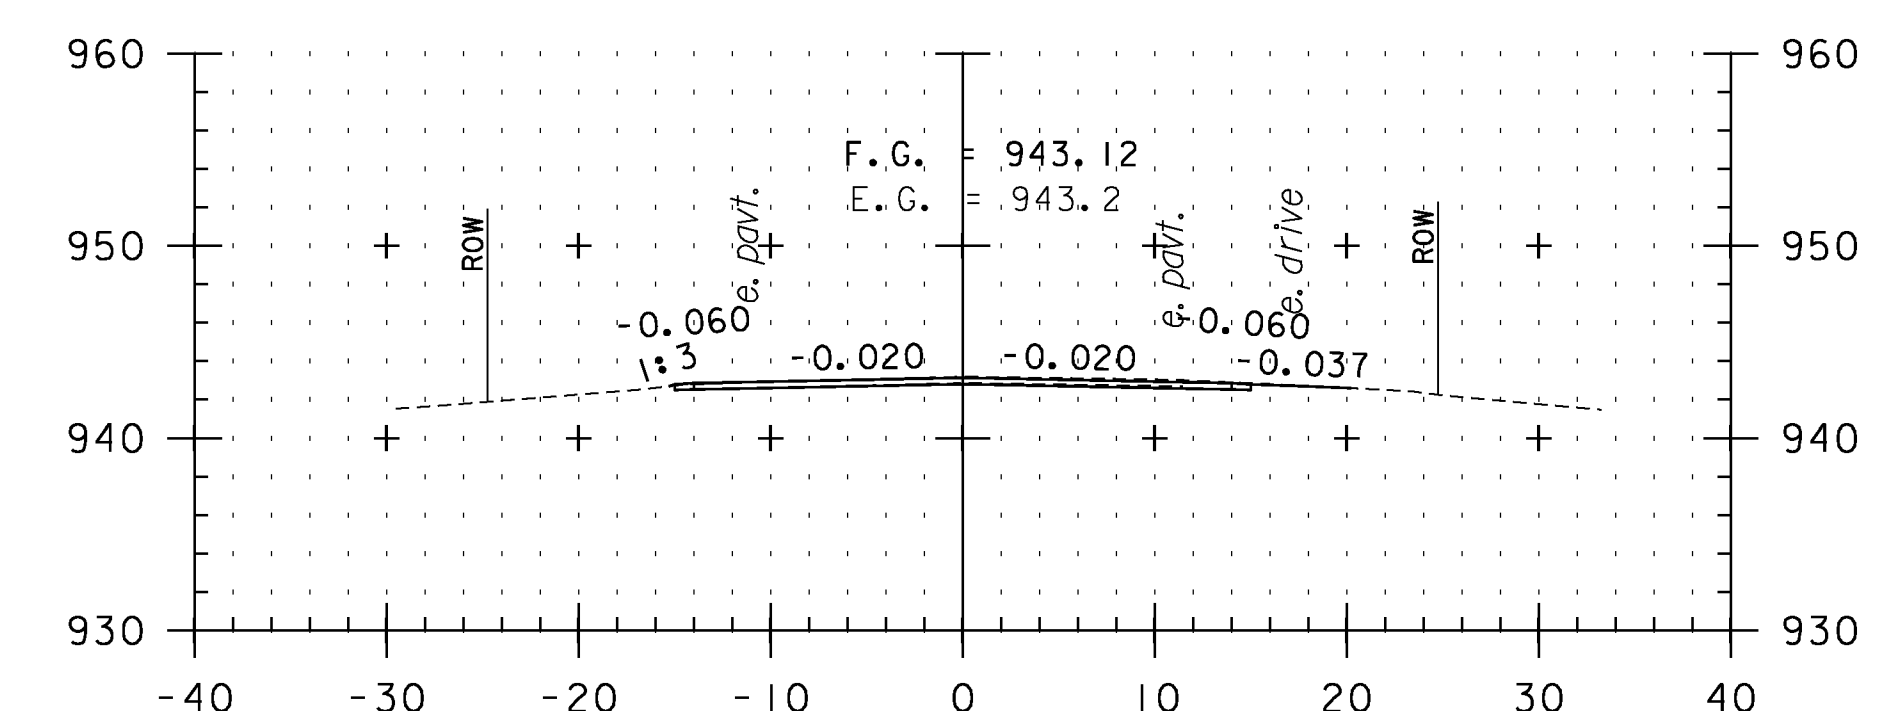

291+50

**CROSS SECTION SHEET 25**

PROJECT NAME: VERSHIRE-THETFORD

PROJECT NUMBER: STP 291(I)

FILE NAME: pl0c224.dgn

PLOT DATE: 1/29/2013

PROJECT LEADER: PTS

DRAWN BY: SNG

DESIGNED BY: NLL

CHECKED BY: PTS

IPARM FILE NAME: IOC224\_I33

SHEET 133 OF 232

STA. 288+50 TO STA. 292+50

