




294+00

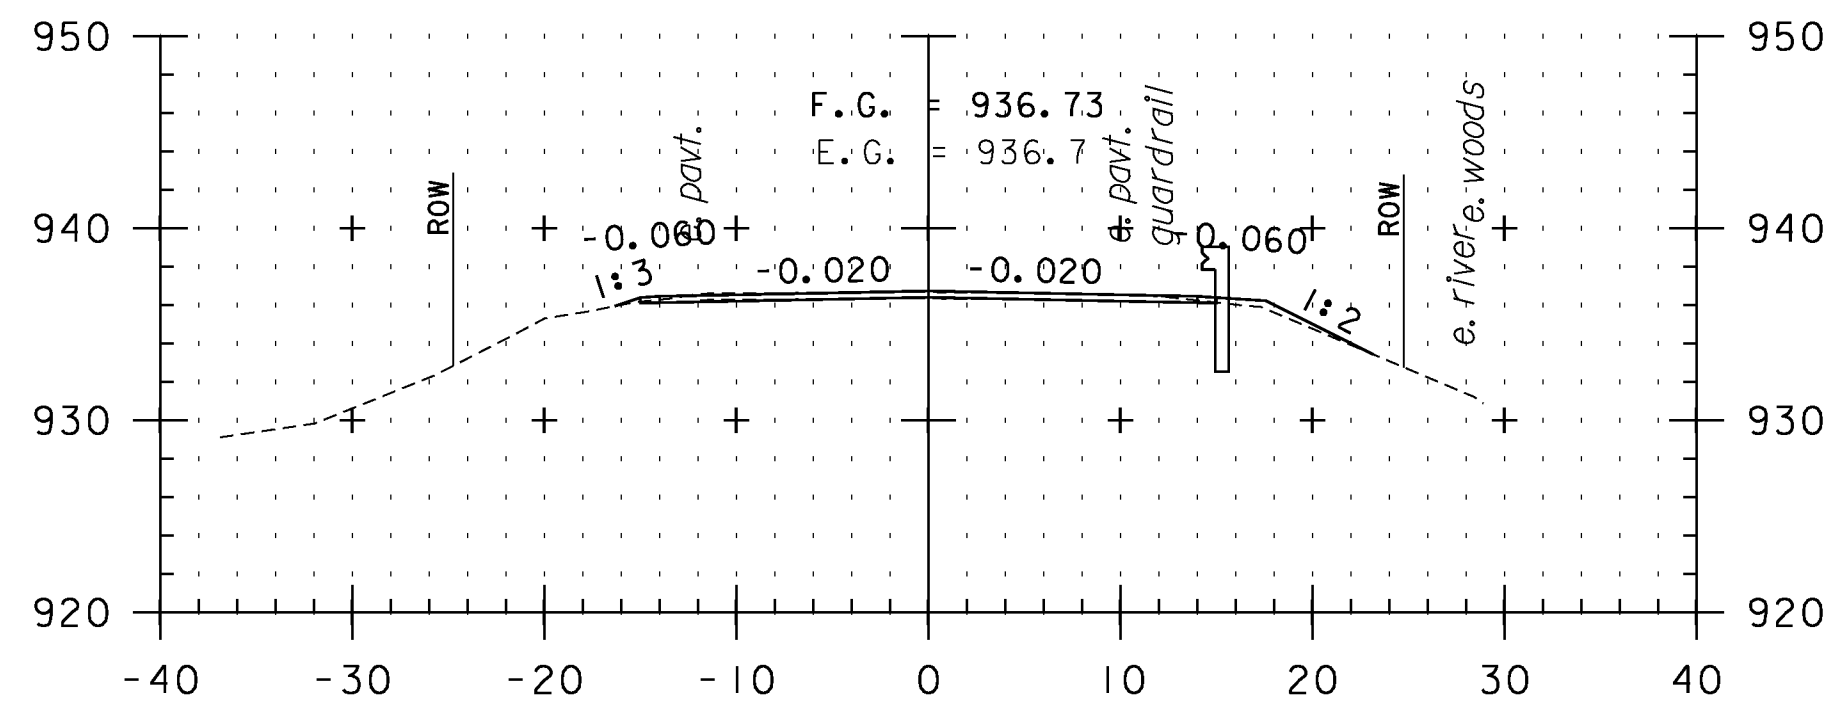


295+50

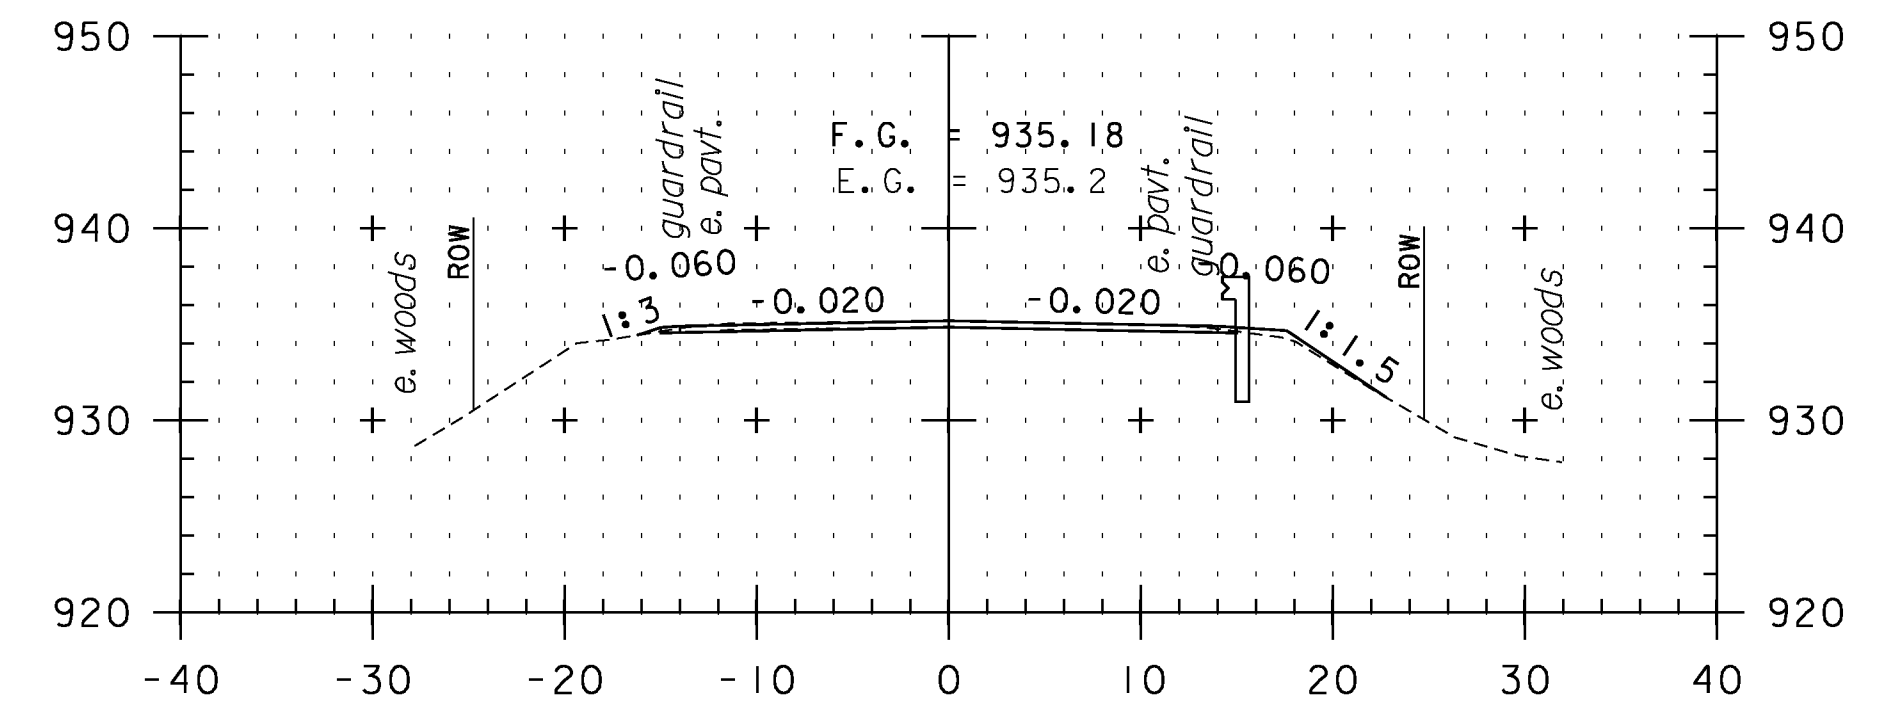


297+00

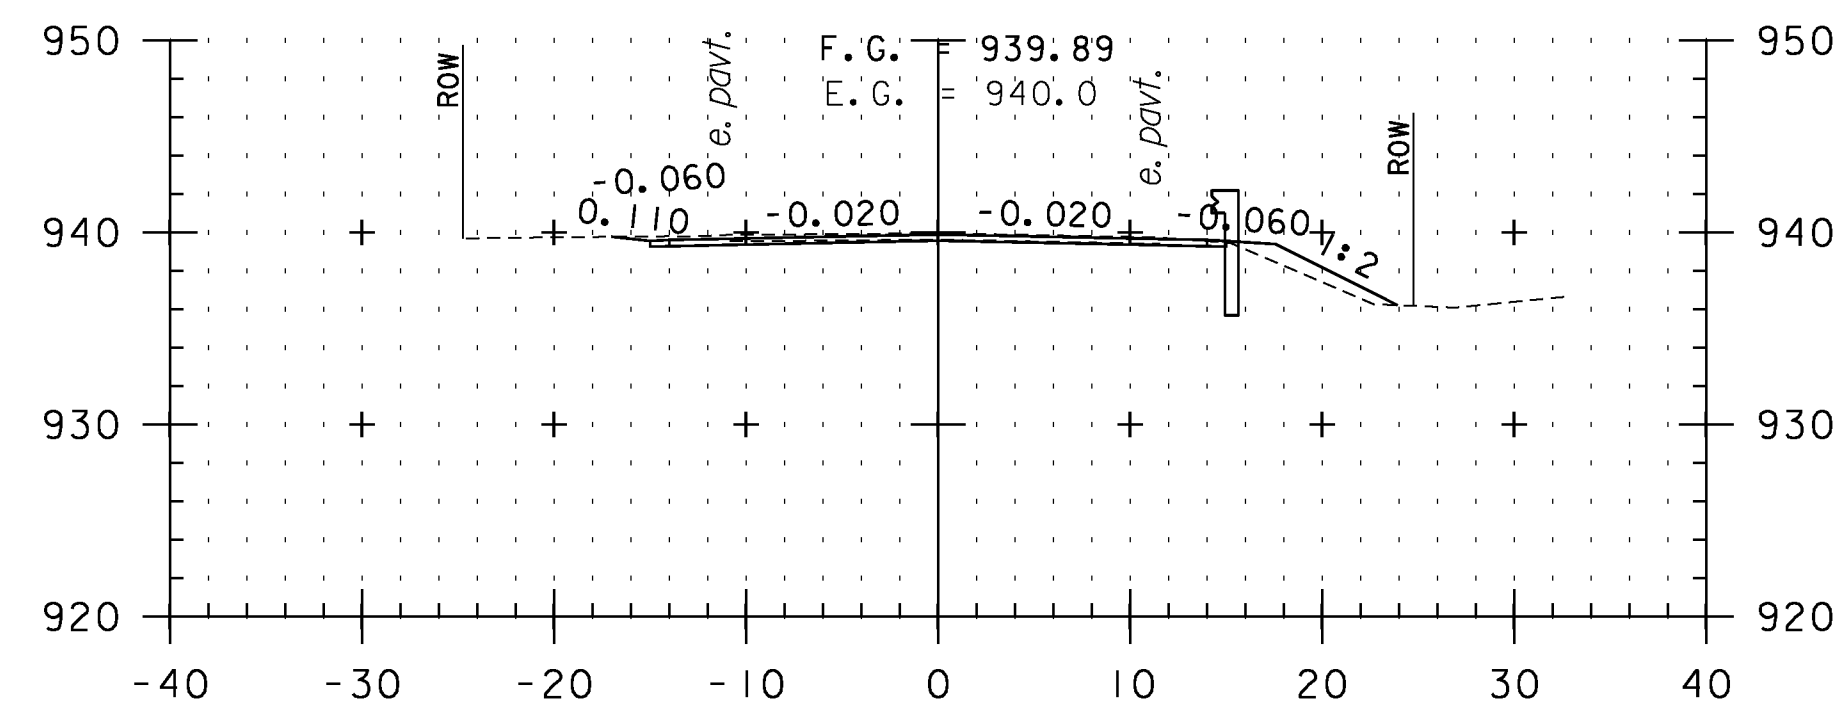


293+50

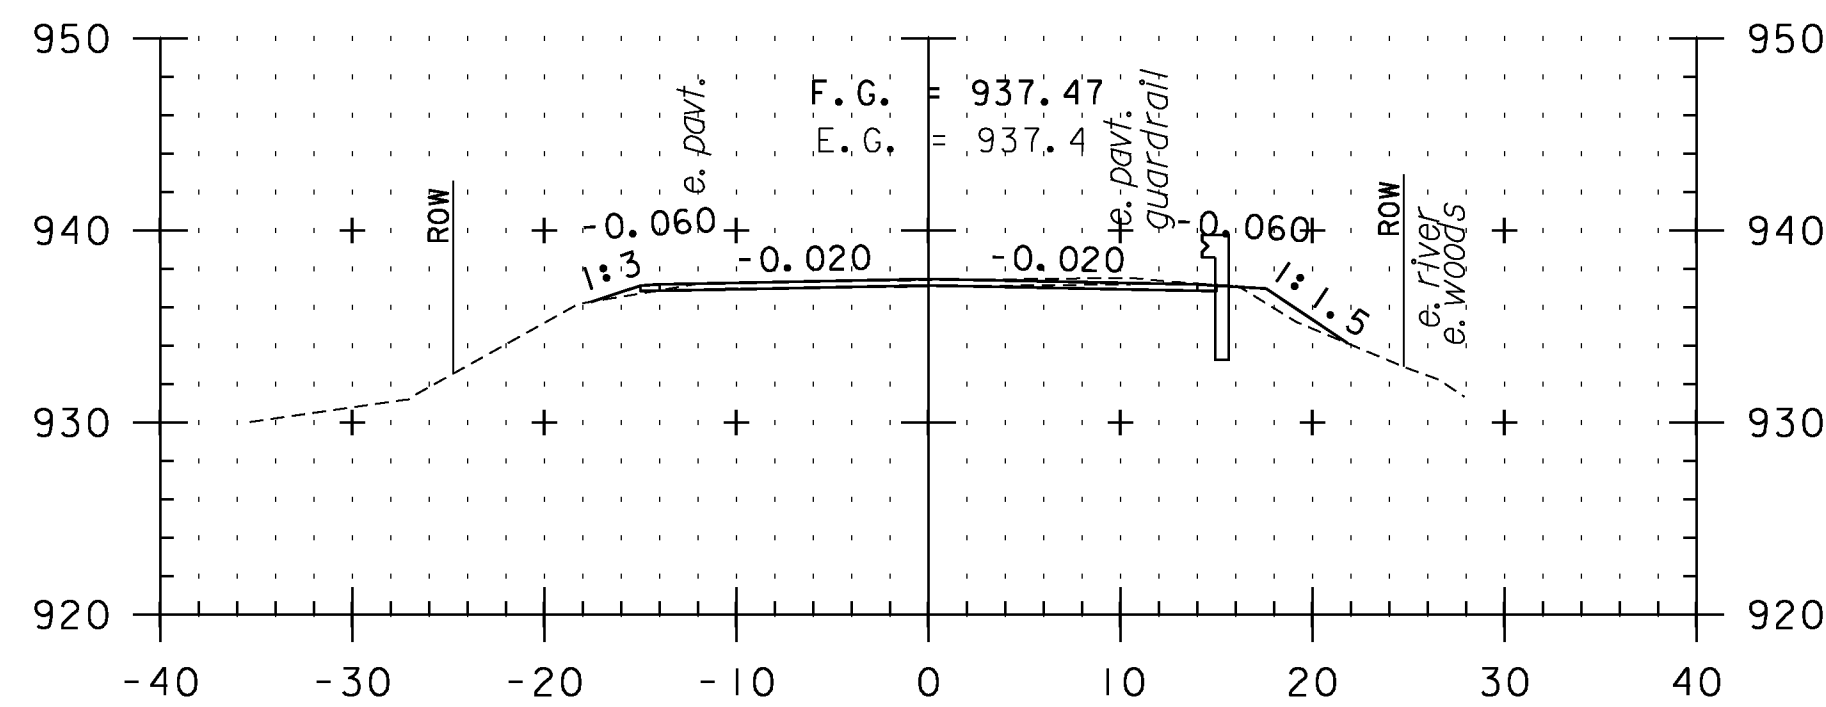


295+00

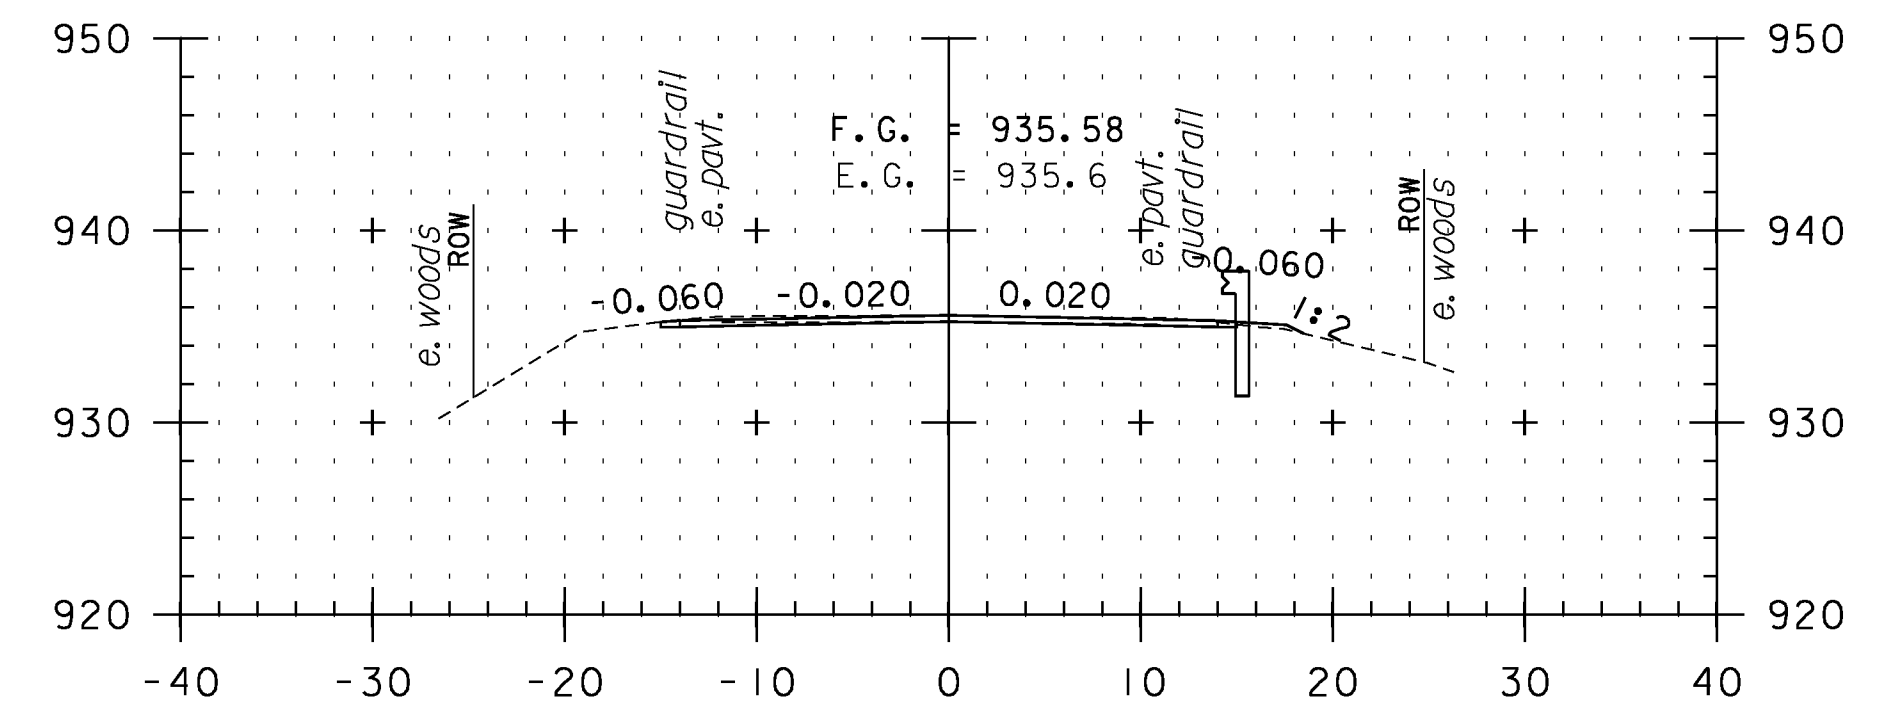


296+50

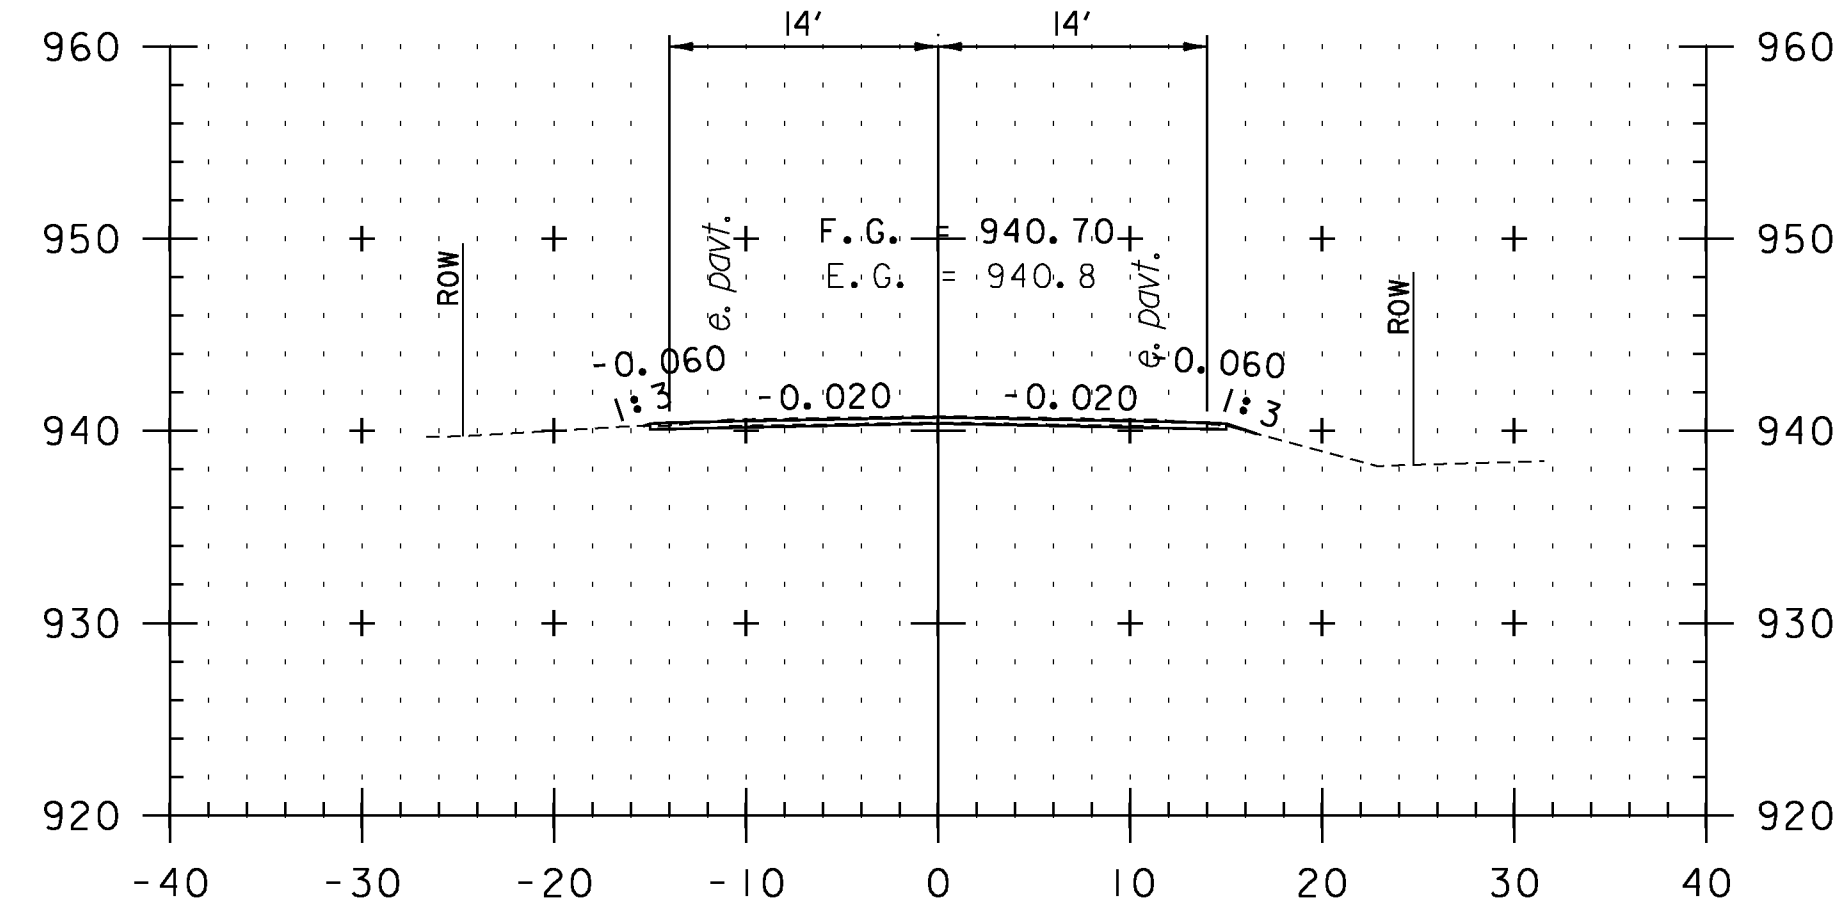

293+00

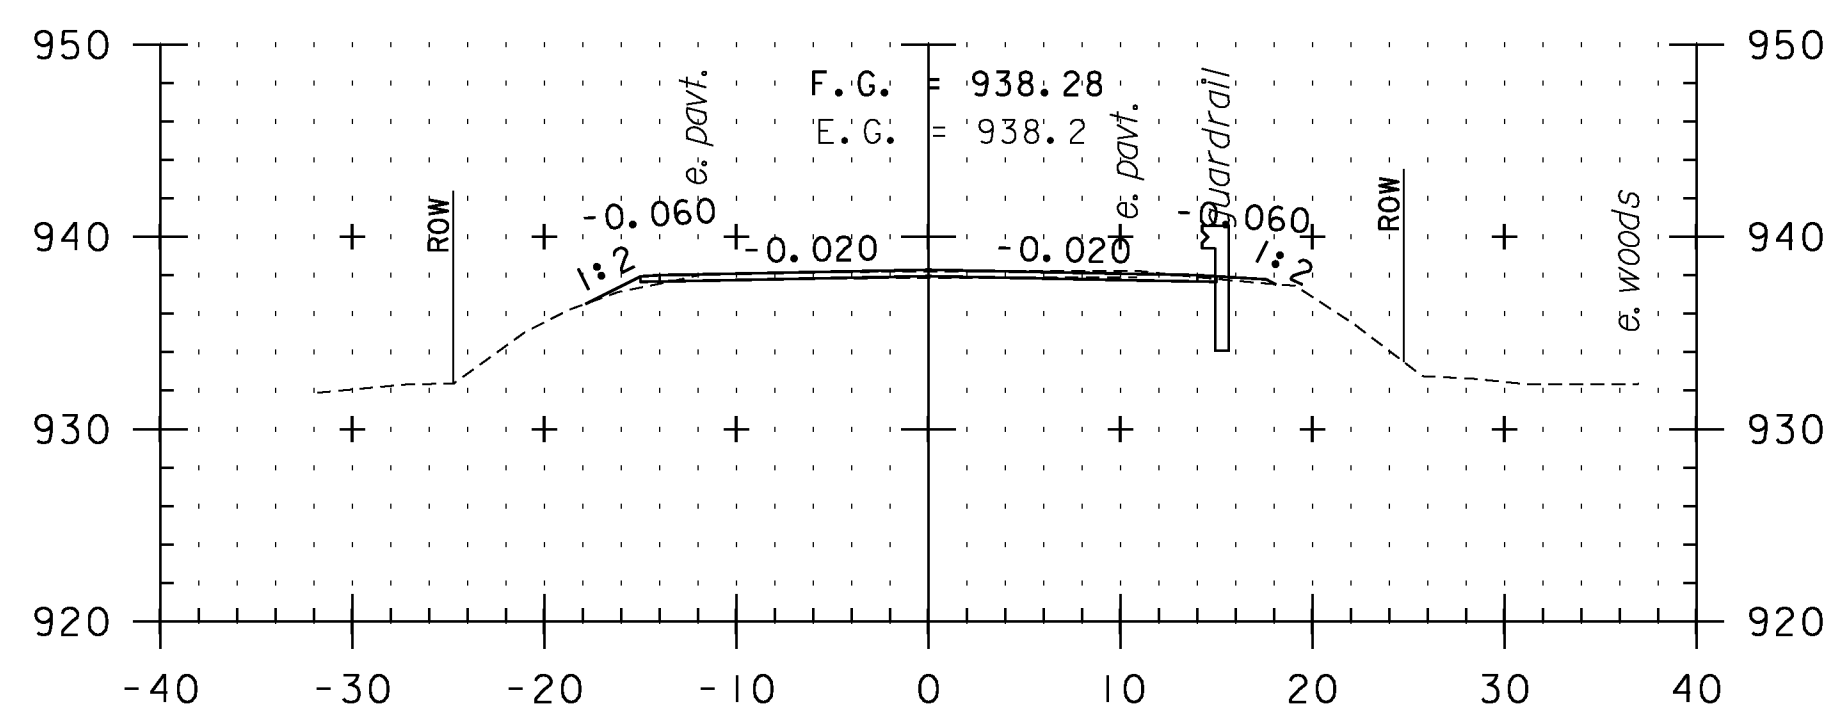


294+50

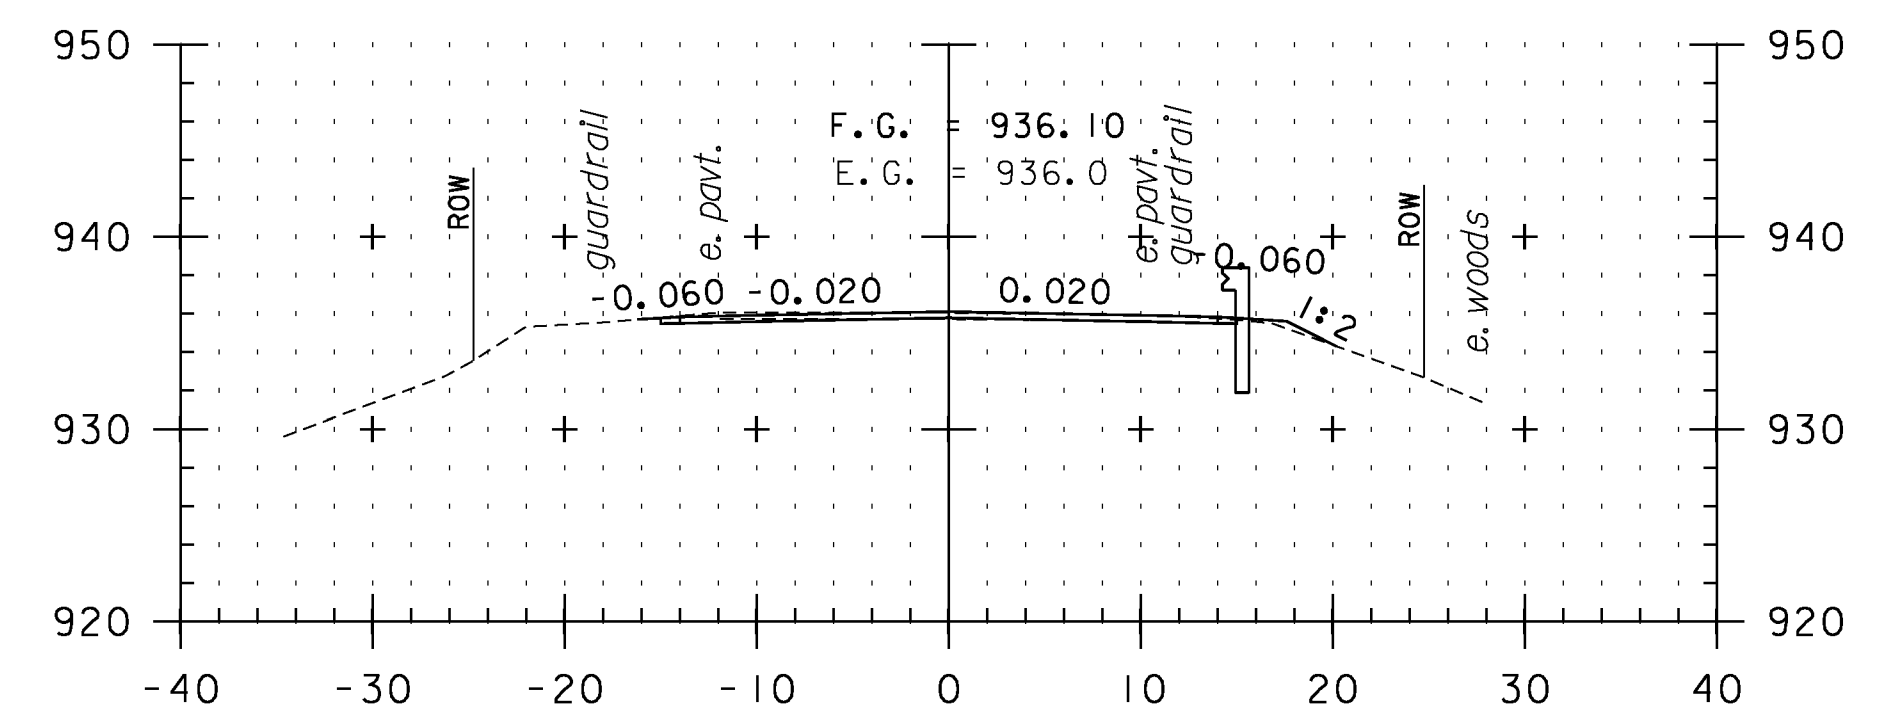

296+00

CROSS SECTION SHEET 26

STA. 293+00 TO STA. 297+00

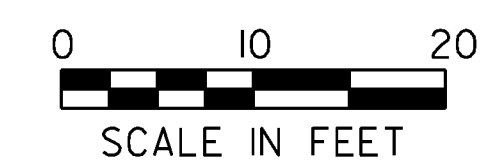

PROJECT NAME: VERSHIRE-THETFORD	PLOT DATE: 1/29/2013
PROJECT NUMBER: STP 2911(I)	DRAWN BY: SNG
FILE NAME: pl0c224.dgn	CHECKED BY: PTS
PROJECT LEADER: PTS	SHEET 134 OF 232
DESIGNED BY: NLL	
IPARM FILE NAME: IOC224_134	