




298+00

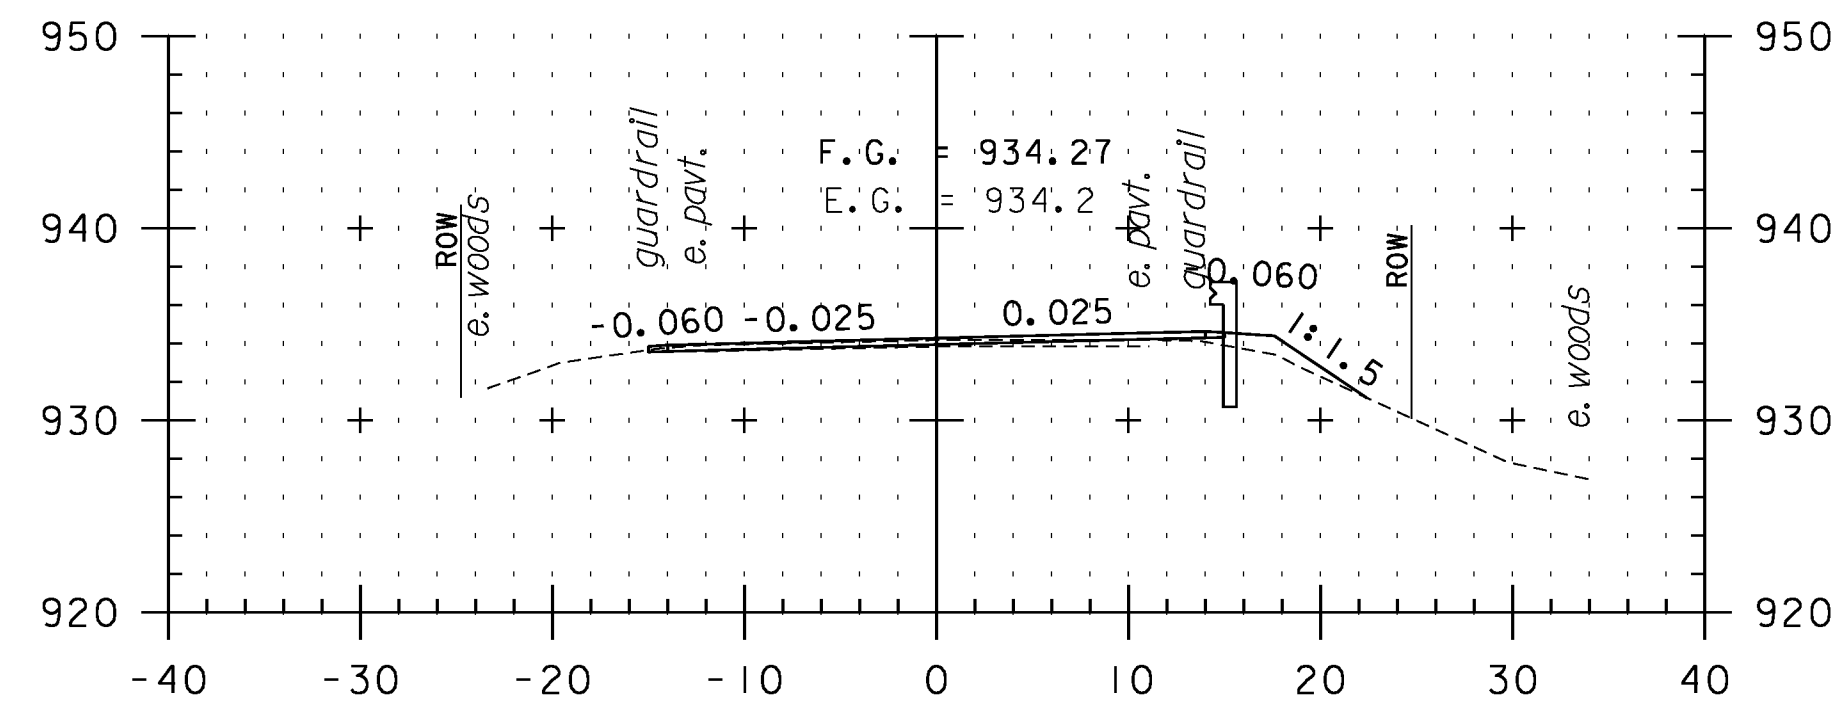


299+50

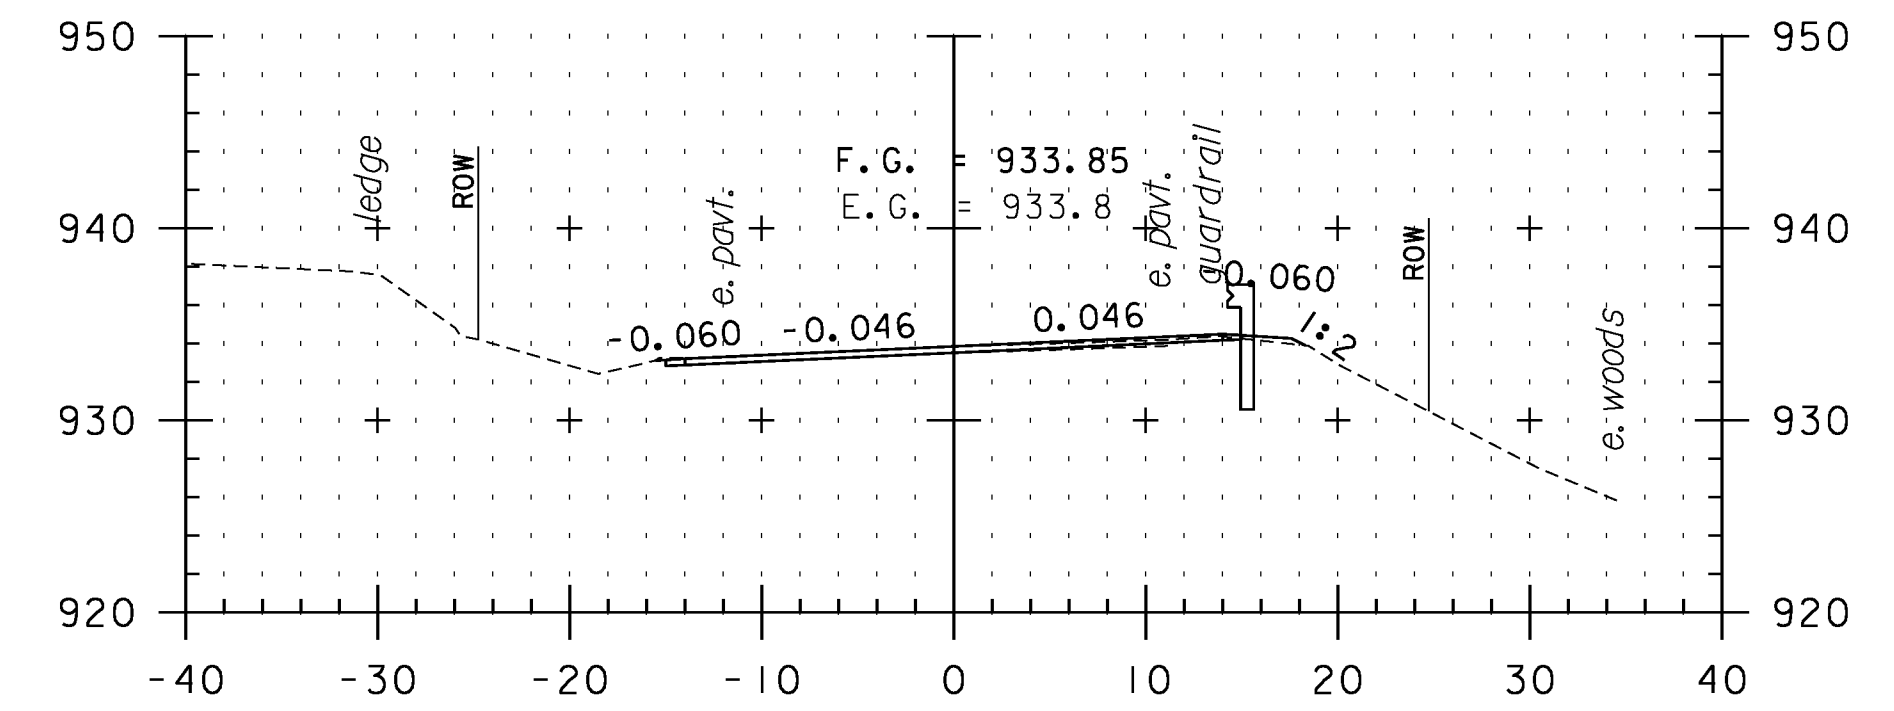


301+00

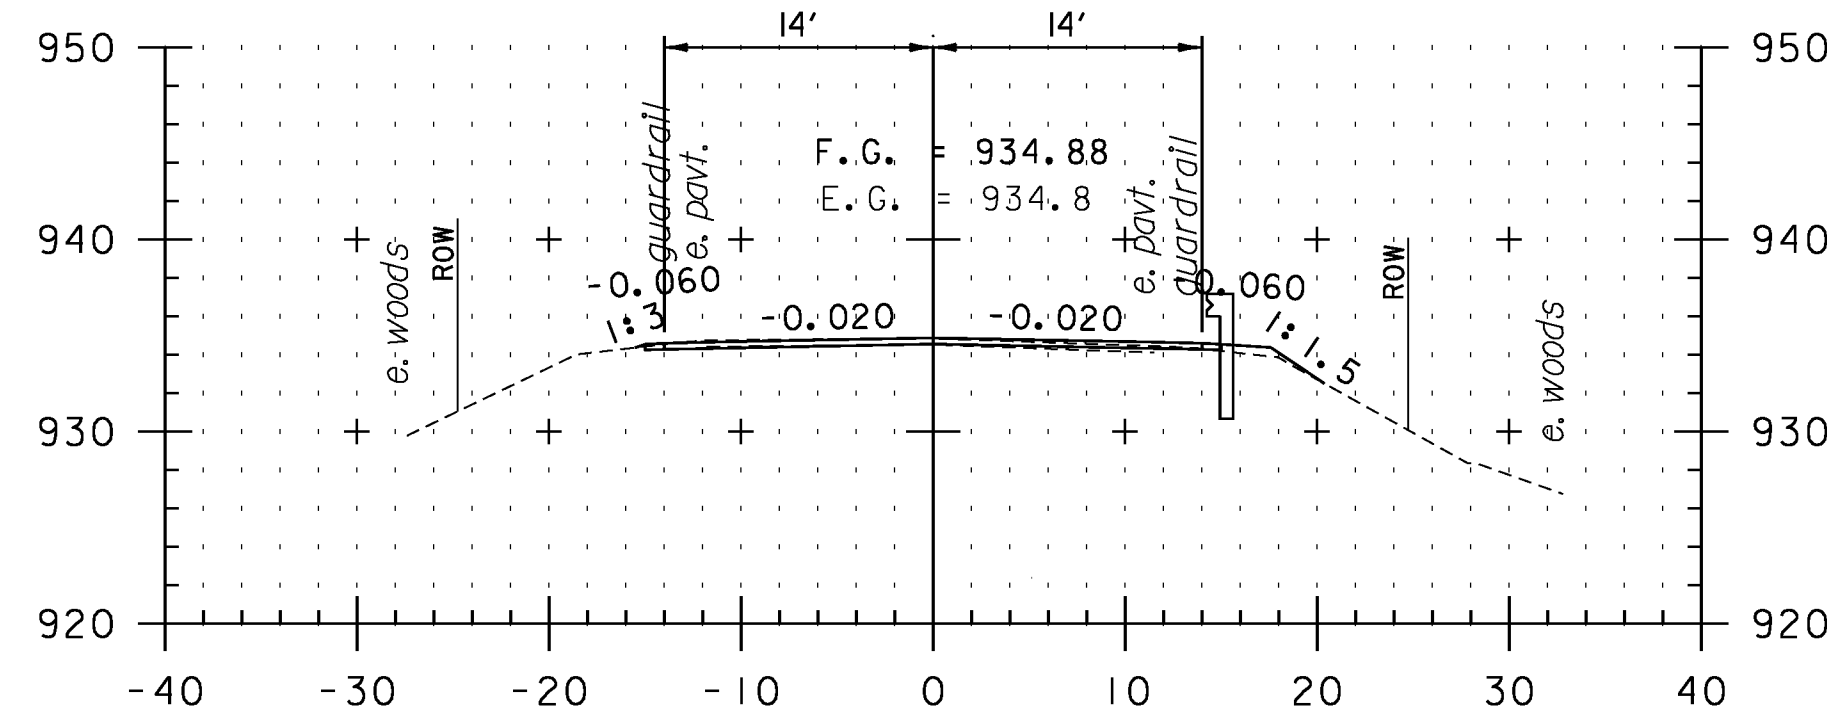


297+50

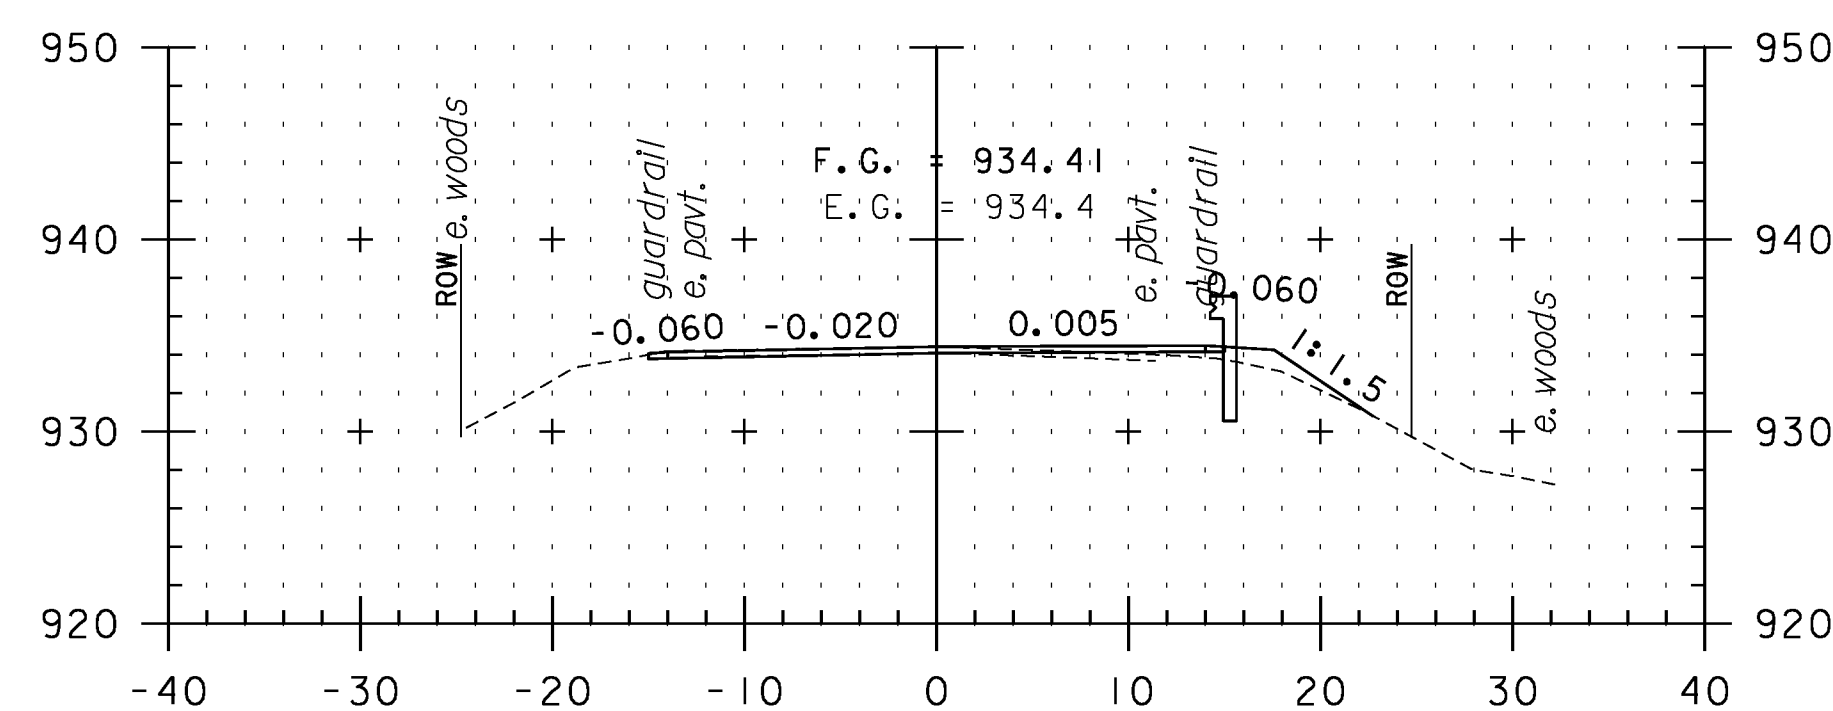


299+00

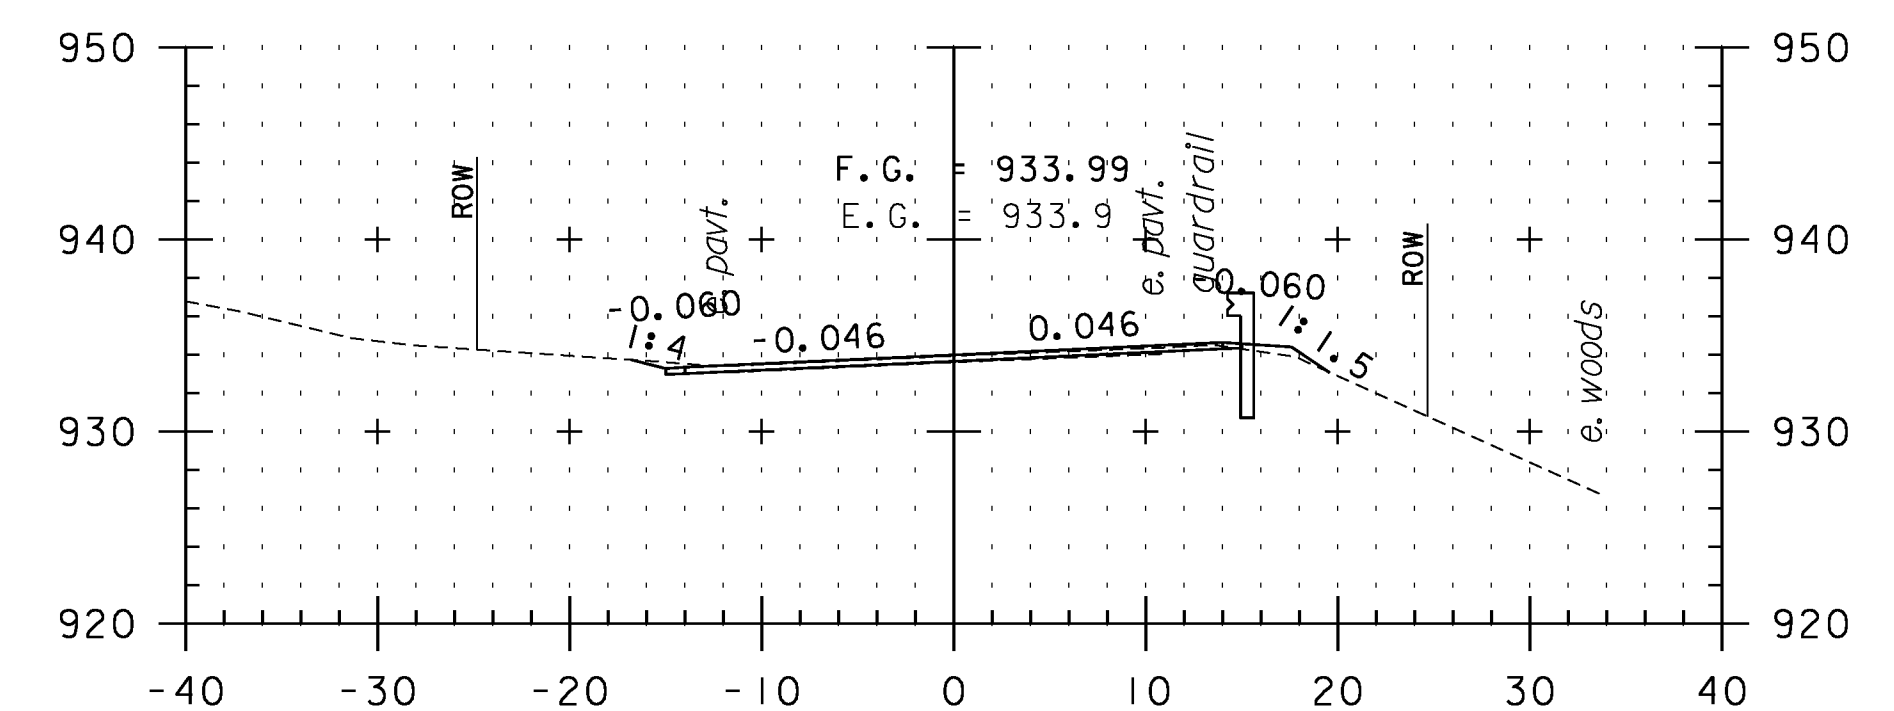


300+50

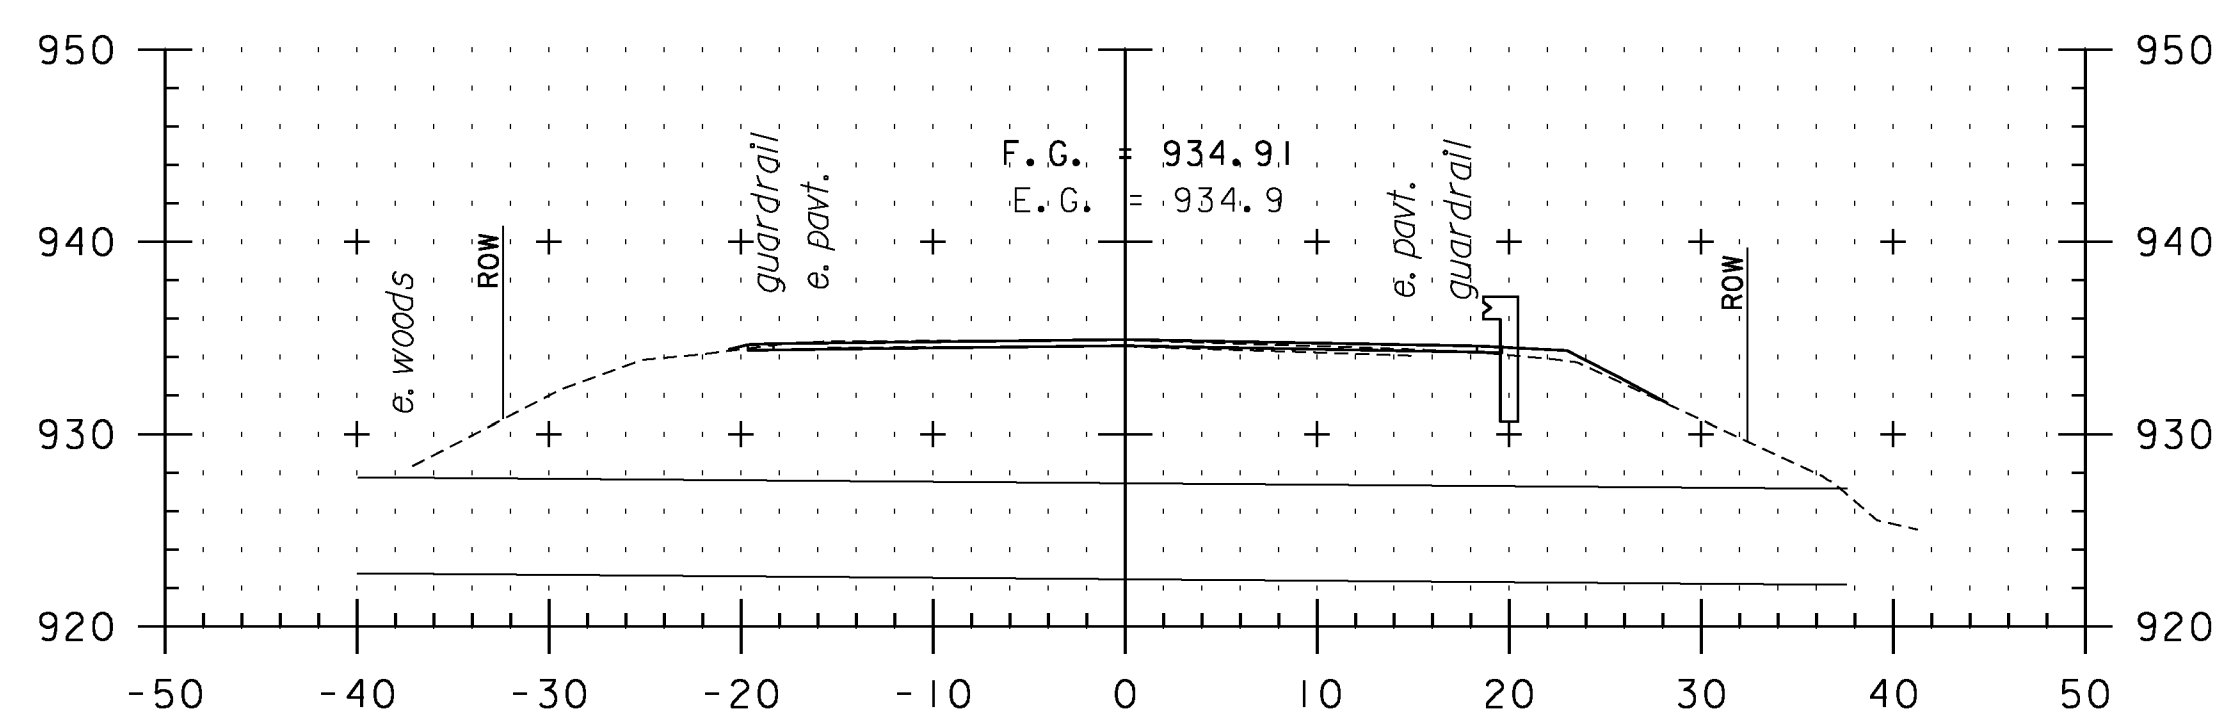

297+46  
BRIDGE 18

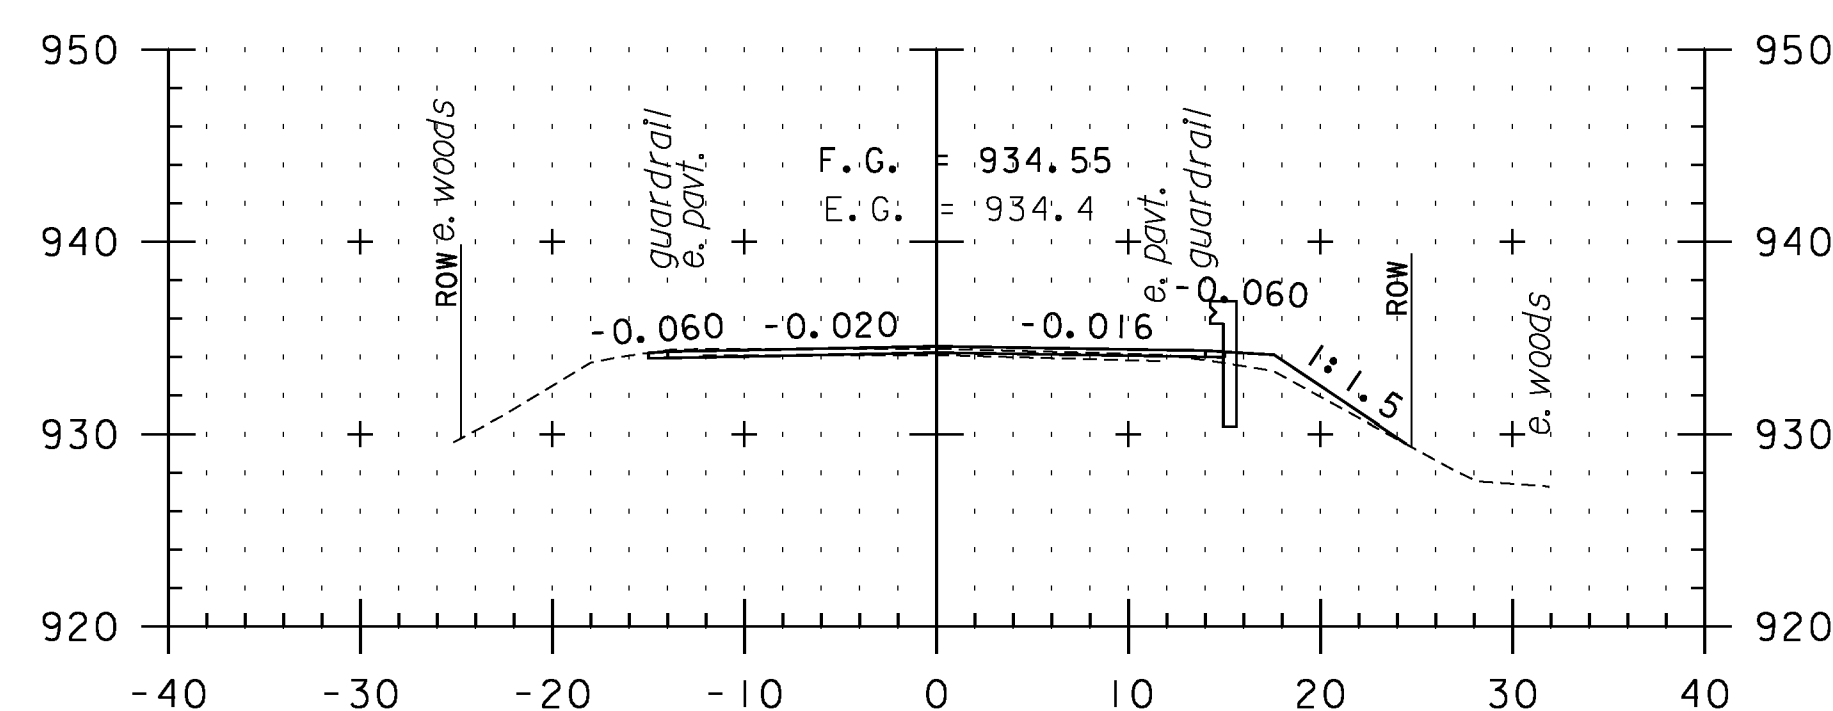


298+50

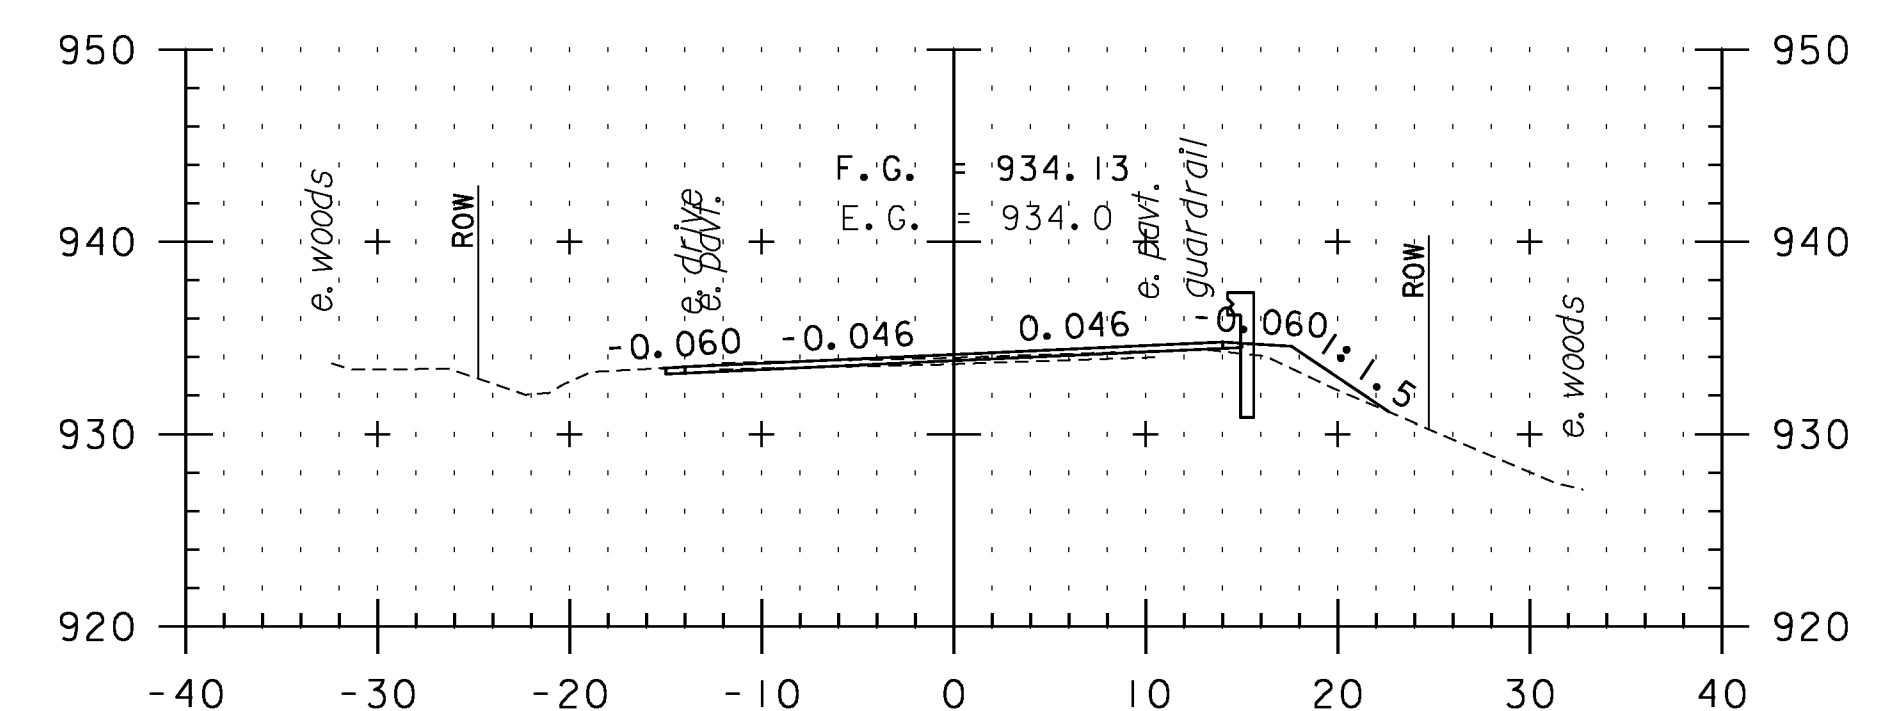

300+00

**CROSS SECTION SHEET 27**

STA. 297+46 TO STA. 301+00

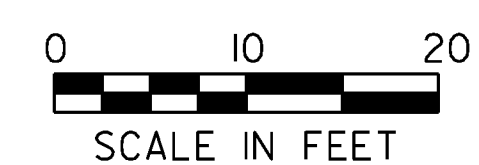

PROJECT NAME: VERSHIRE-THETFORD	PLOT DATE: 1/29/2013
PROJECT NUMBER: STP 2911(I)	DRAWN BY: SNG
FILE NAME: pl0c224.dgn	CHECKED BY: PTS
PROJECT LEADER: PTS	SHEET 135 OF 232
DESIGNED BY: NLL	
IPARM FILE NAME: IOC224_135	