




311+00

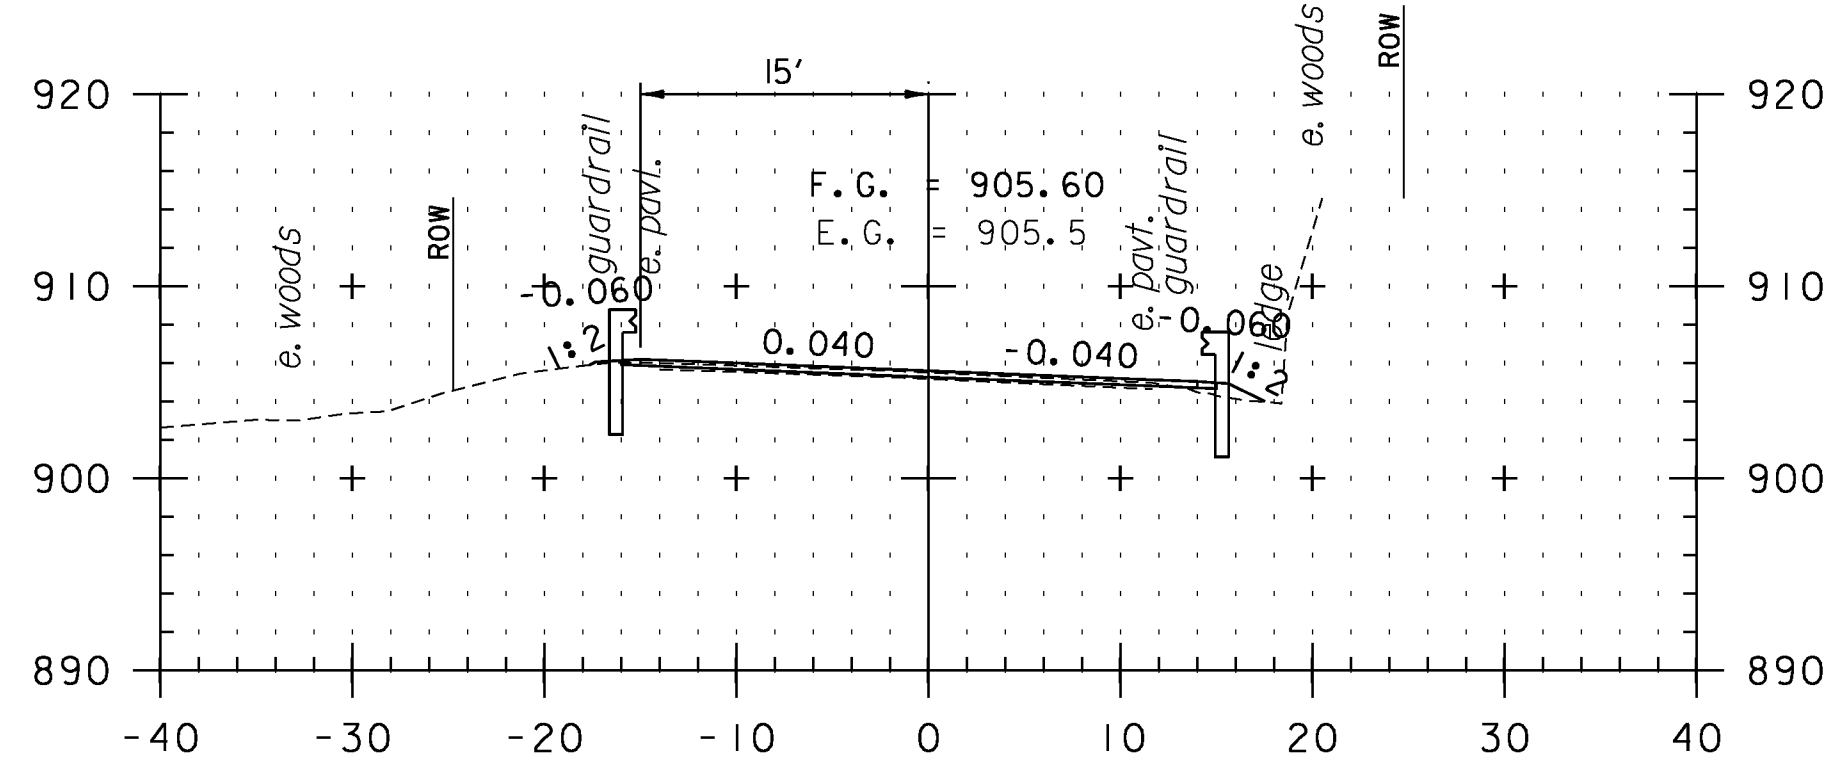


312+00

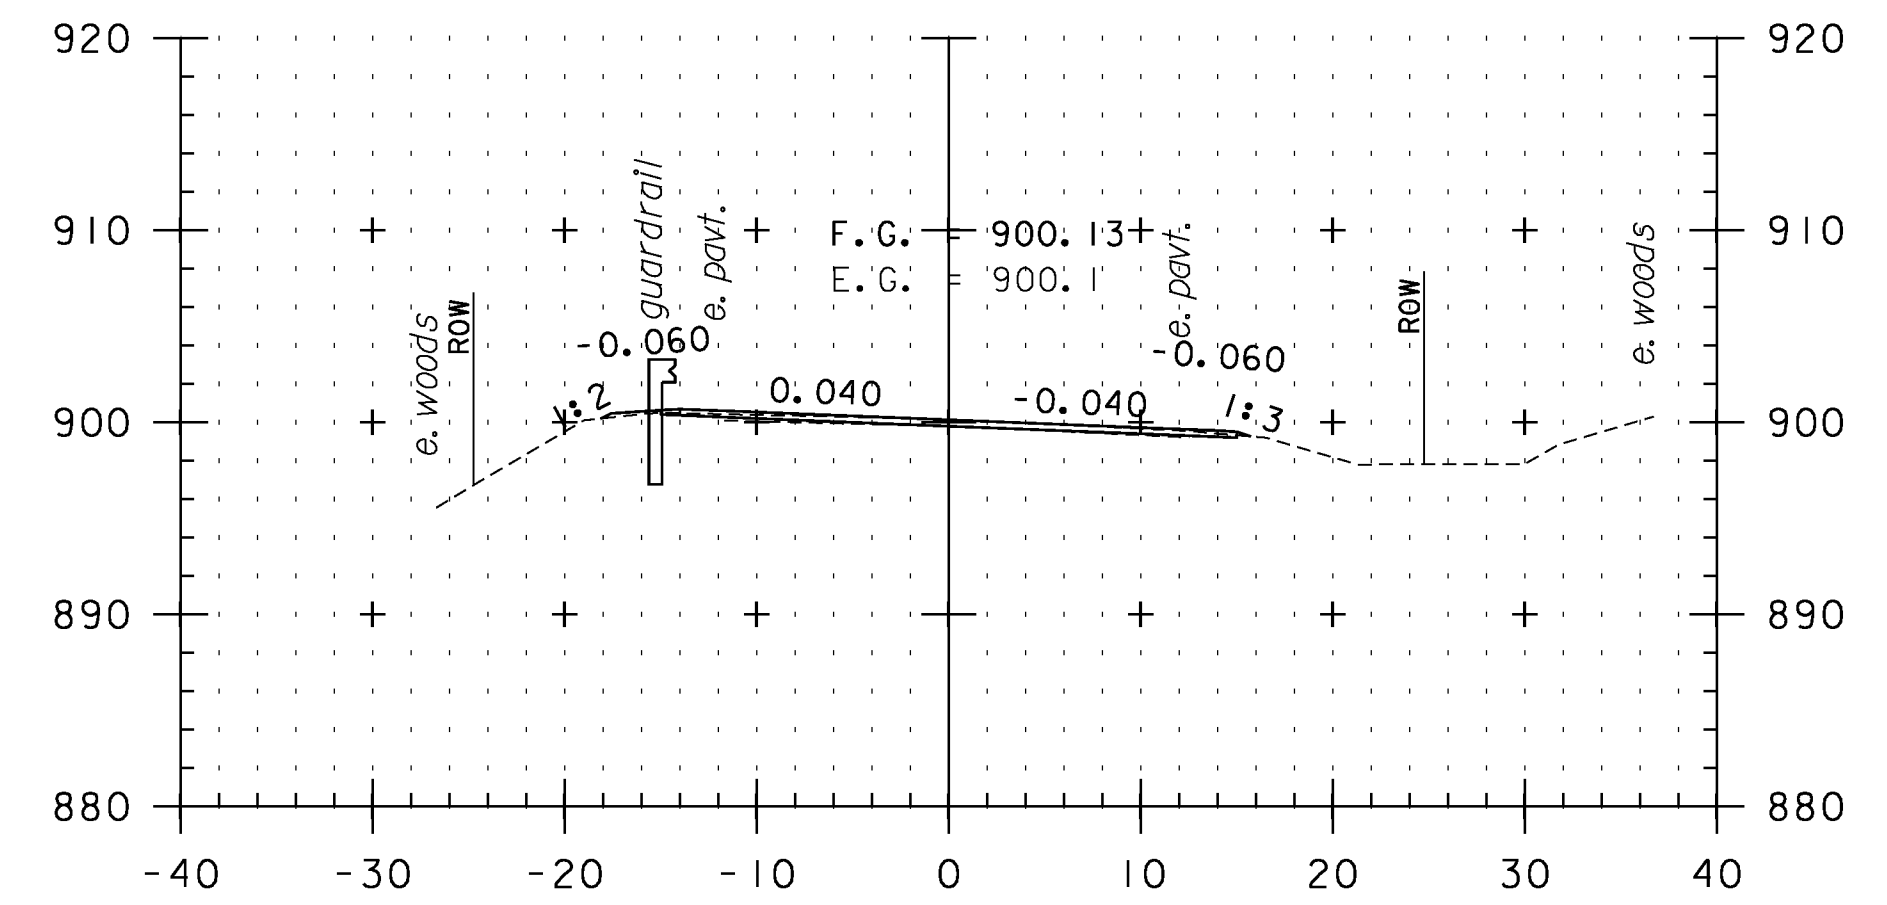


313+50

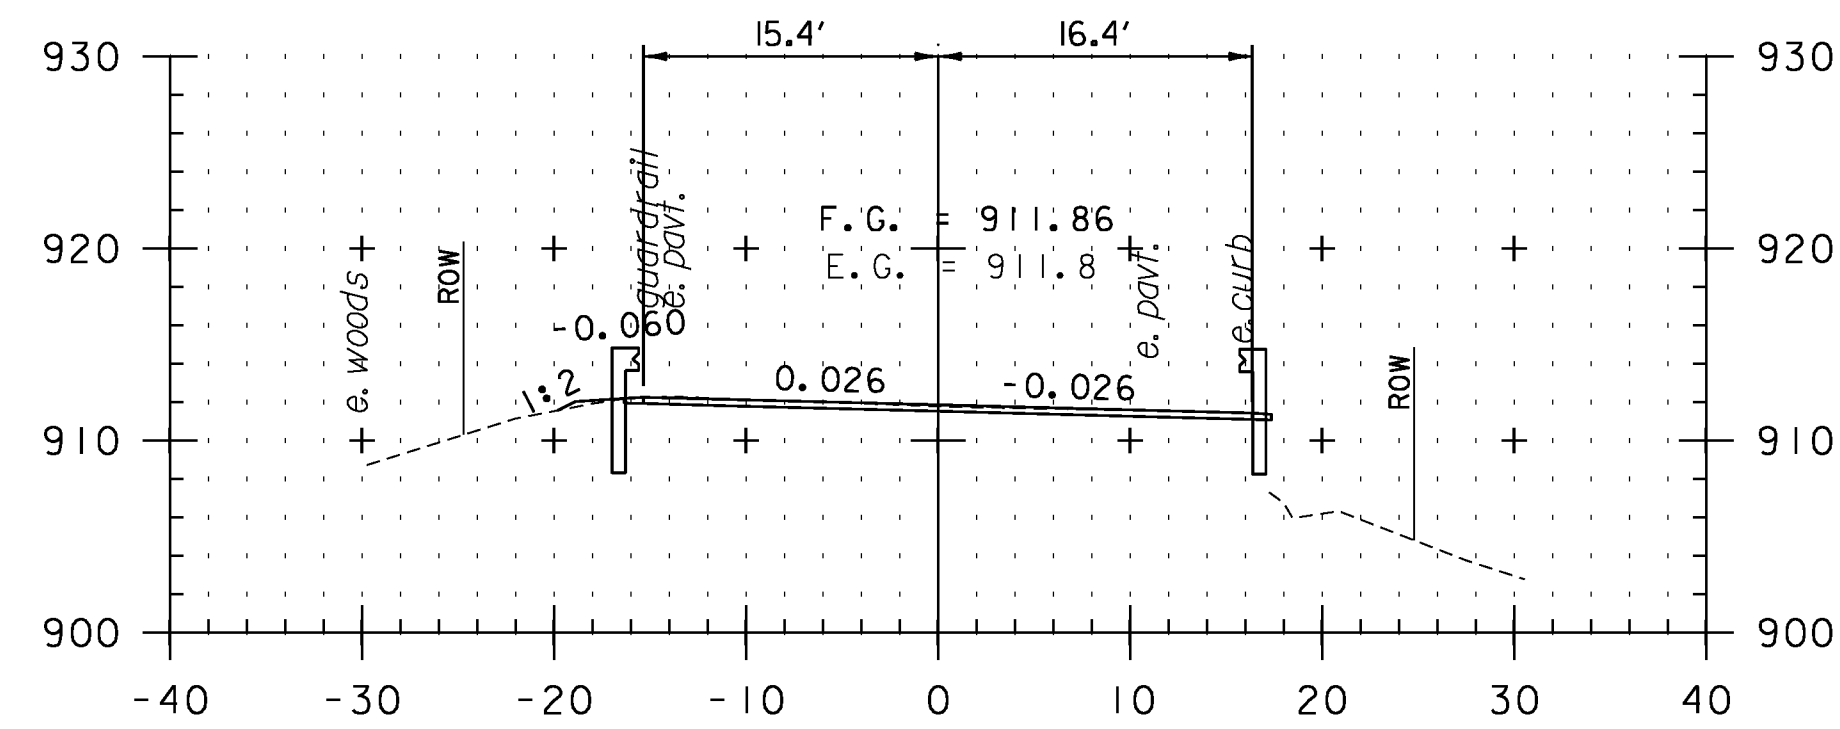


310+50

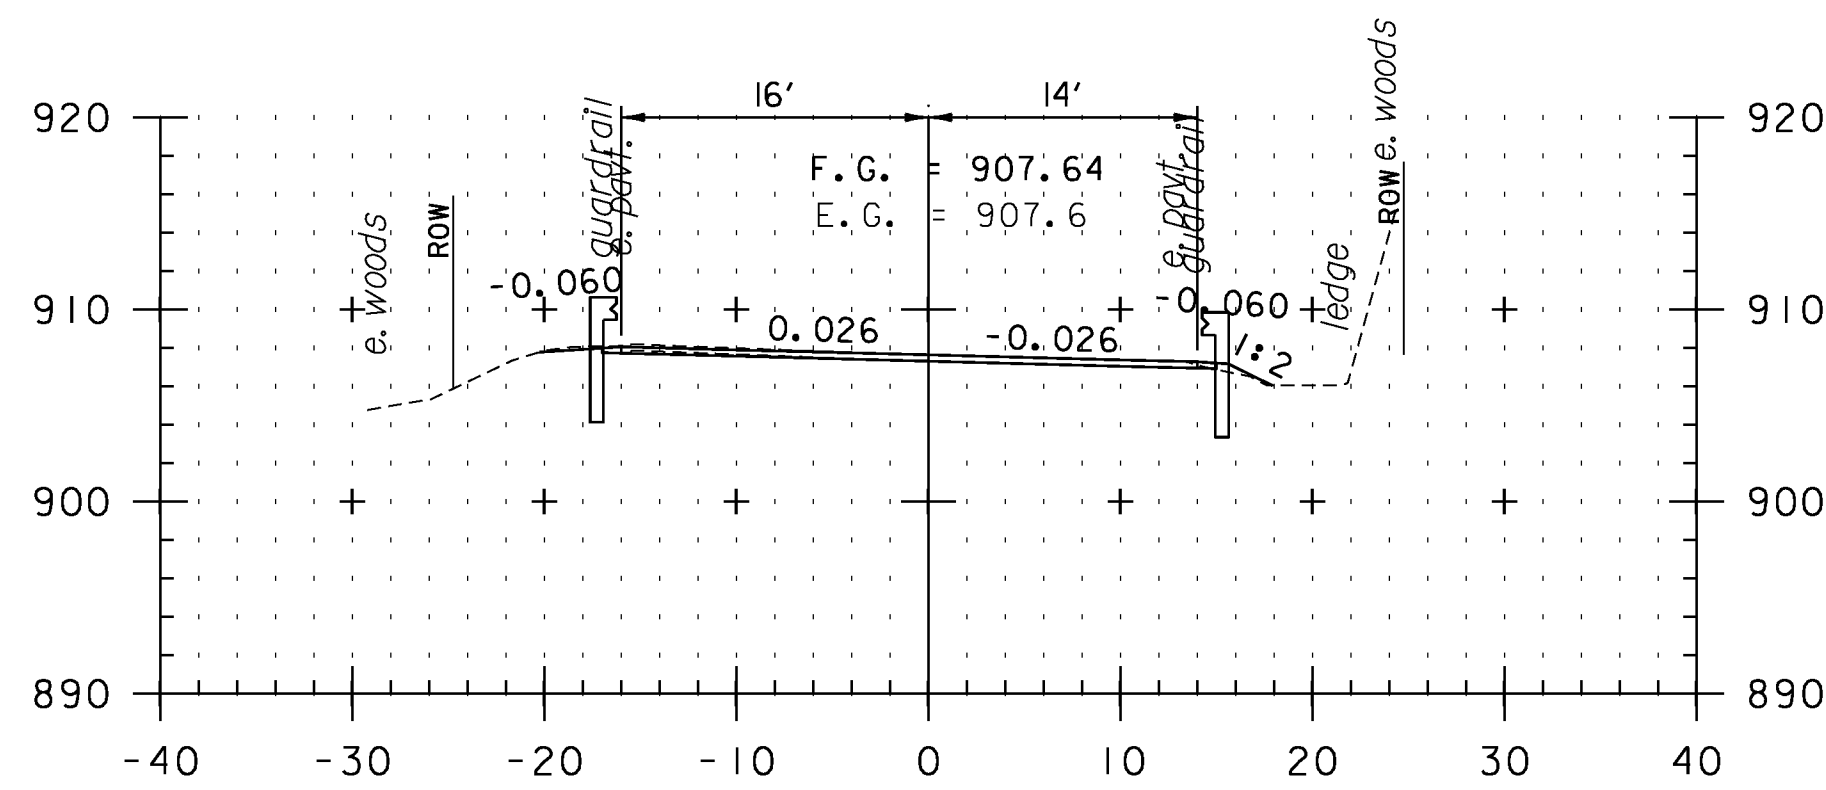


311+50

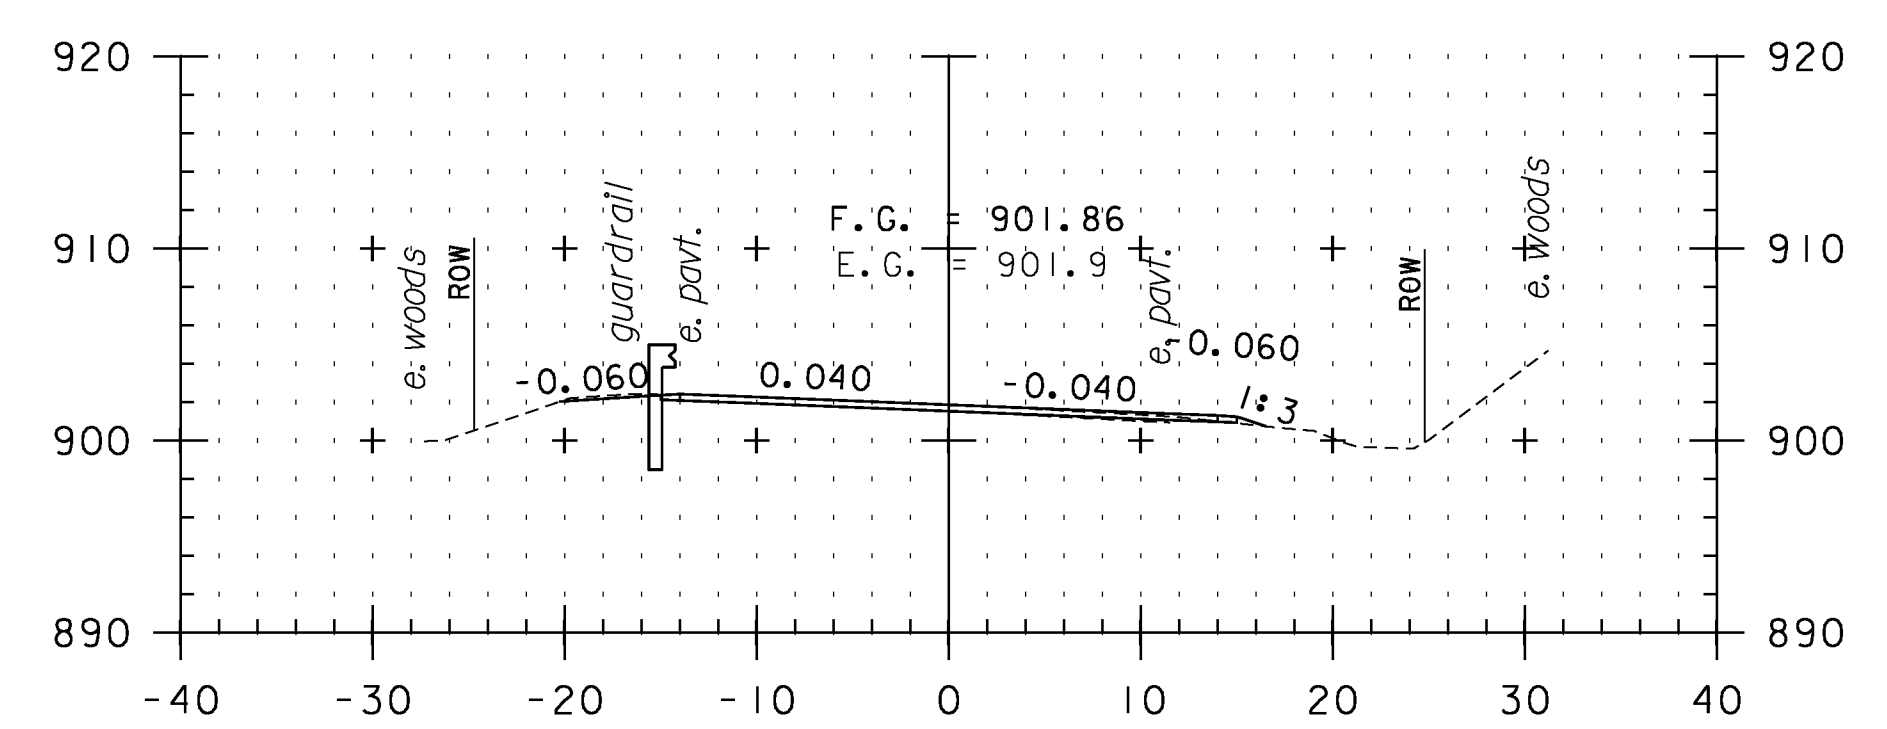


313+00

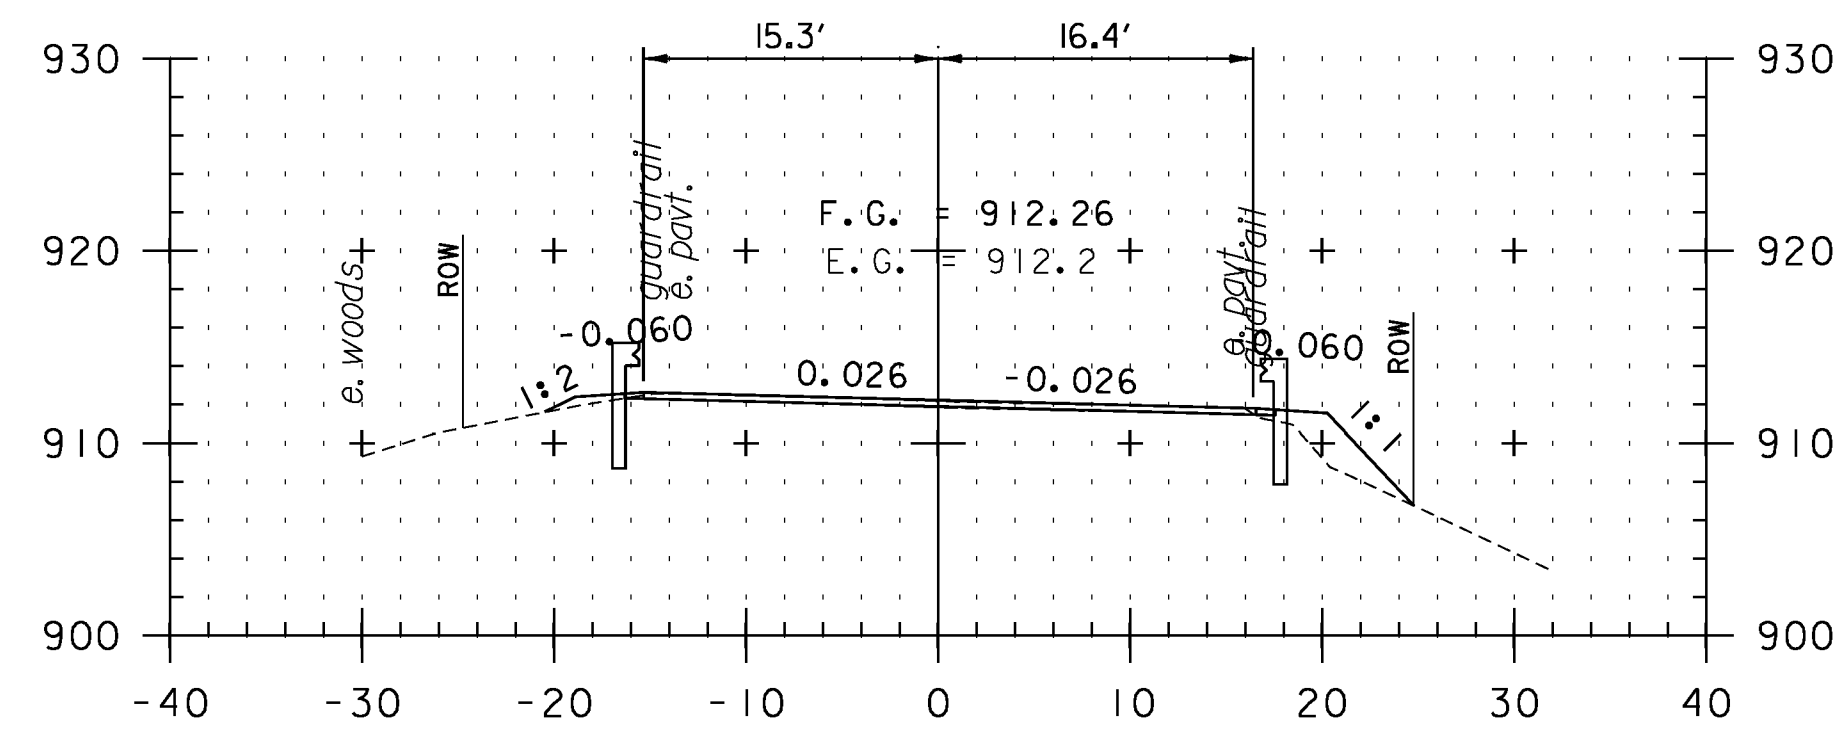

310+43
BEGIN BRIDGE 19 APPROACH

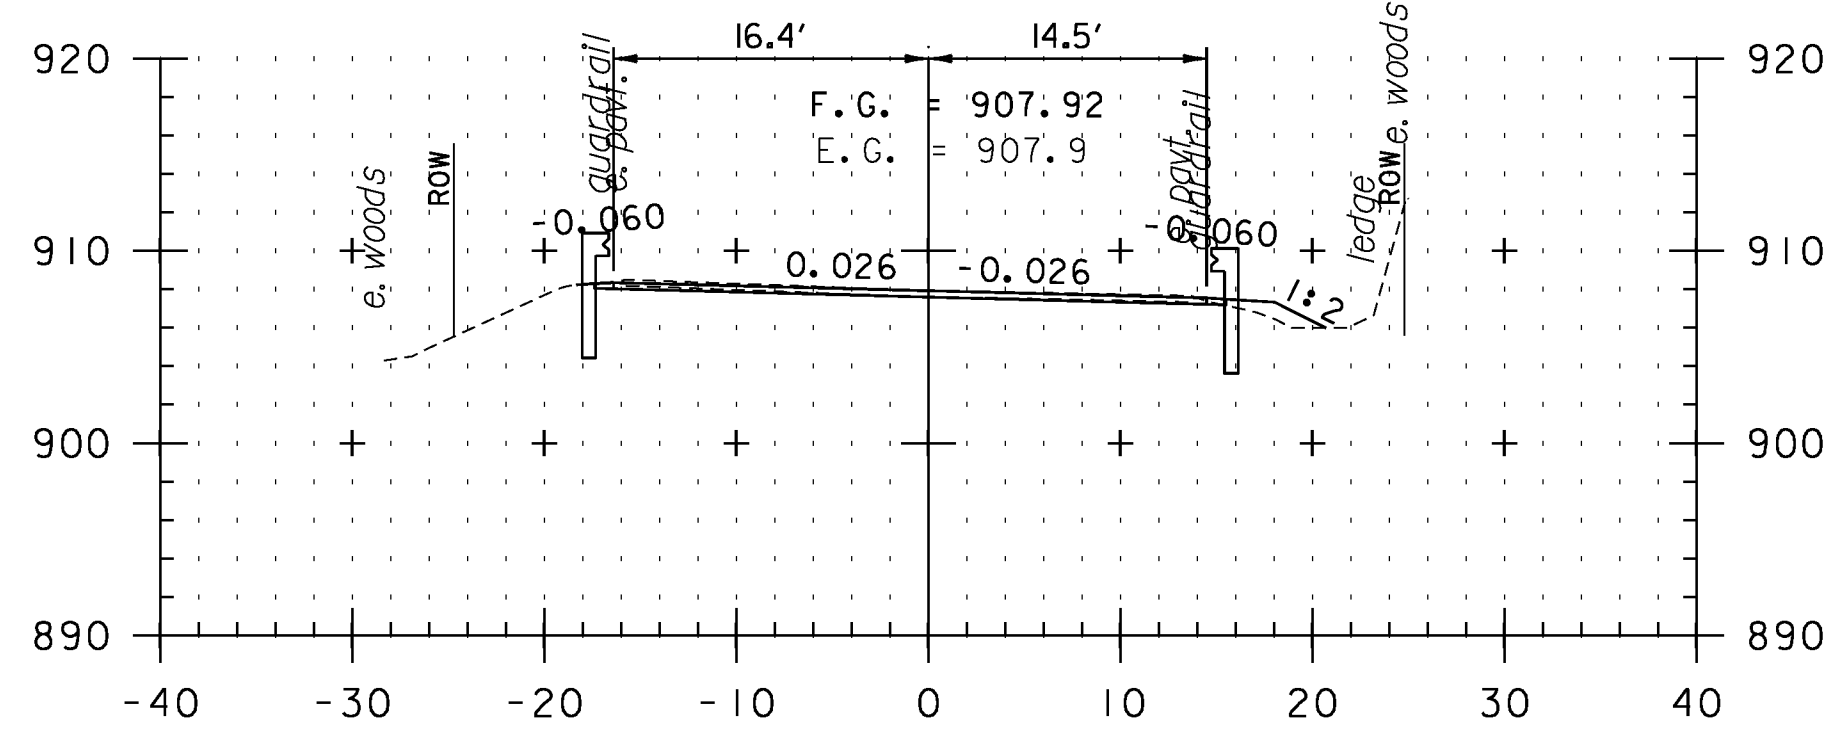


311+43
END BRIDGE 19 APPROACH

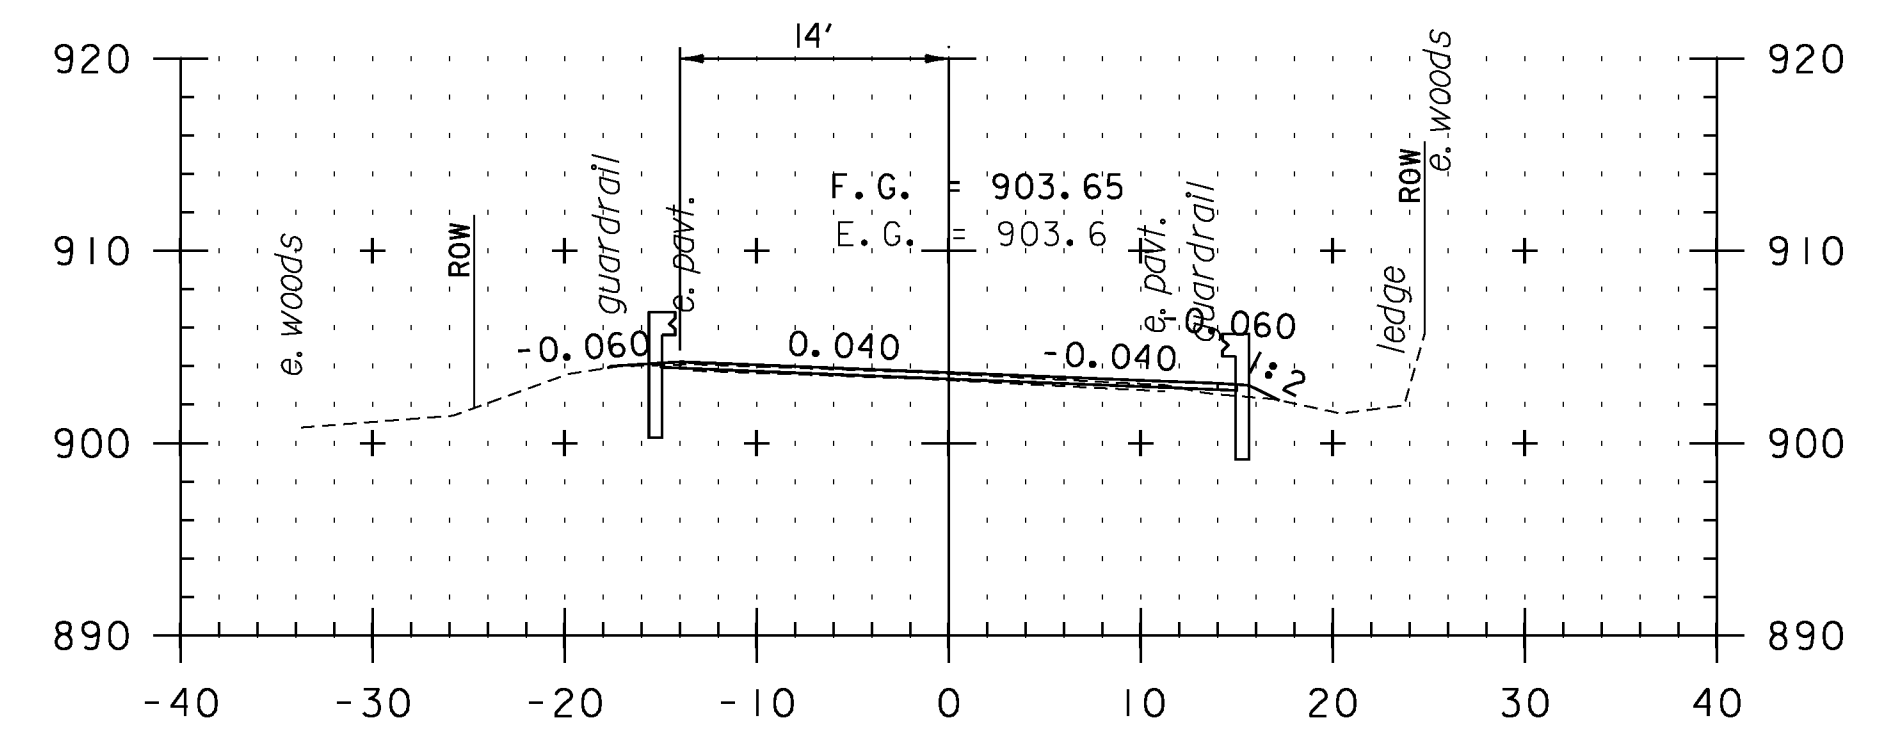

312+50

CROSS SECTION SHEET 30

STA. 310+43 TO STA. 313+50

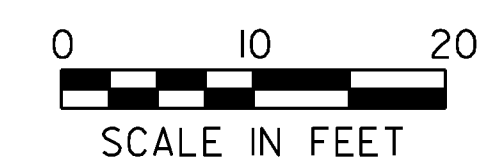

PROJECT NAME: VERSHIRE-THETFORD	PLOT DATE: 1/29/2013
PROJECT NUMBER: STP 2911(I)	DRAWN BY: SNG
FILE NAME: pl0c224.dgn	CHECKED BY: PTS
PROJECT LEADER: PTS	SHEET 138 OF 232
DESIGNED BY: NLL	
IPARM FILE NAME: IOC224_138	