




315+00

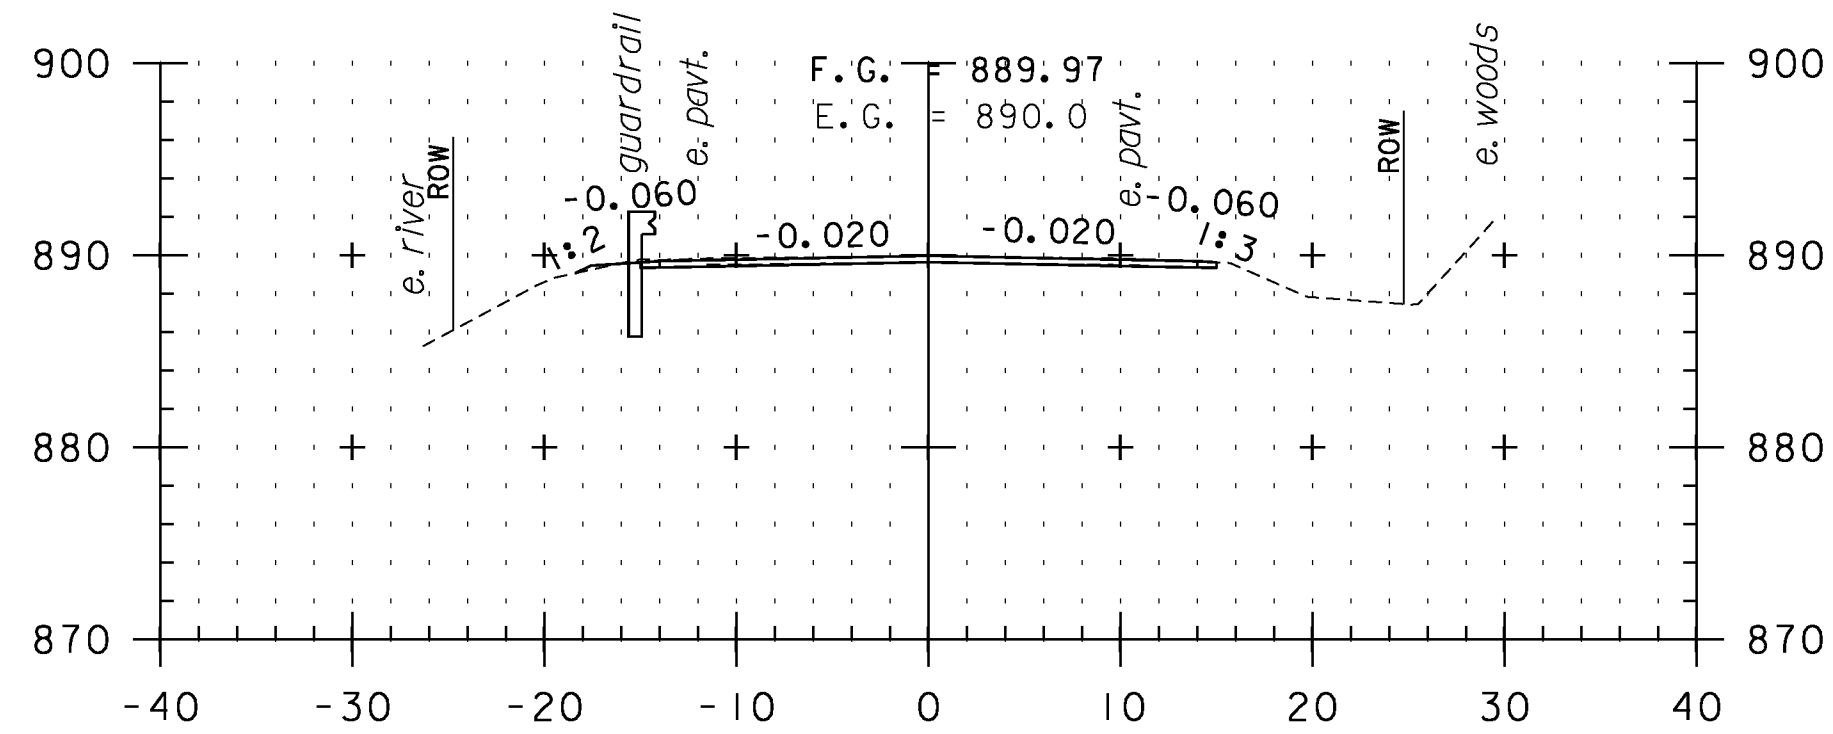


316+50

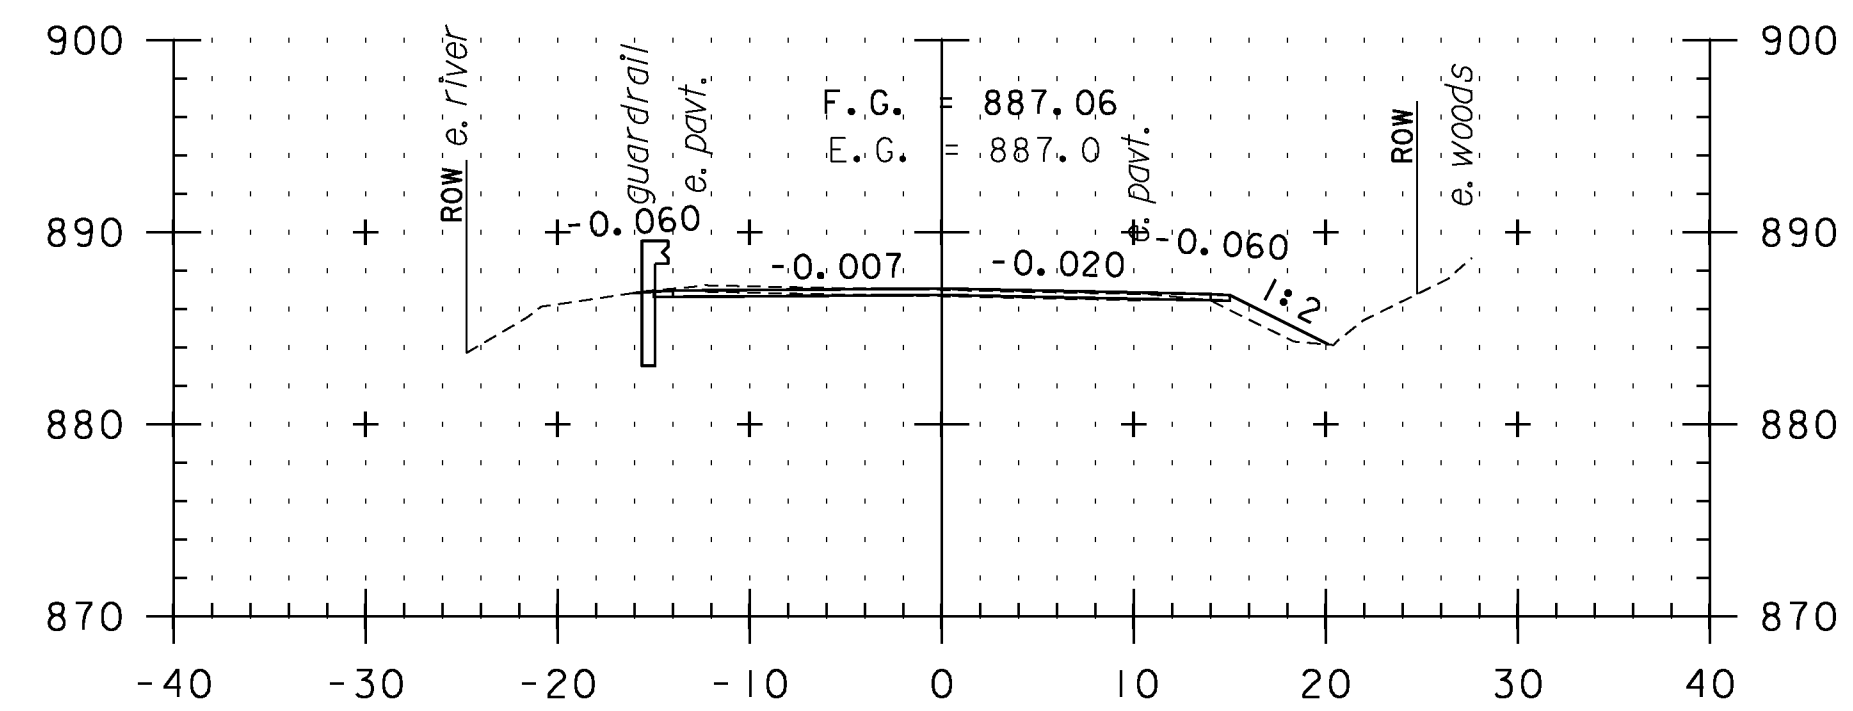


318+00

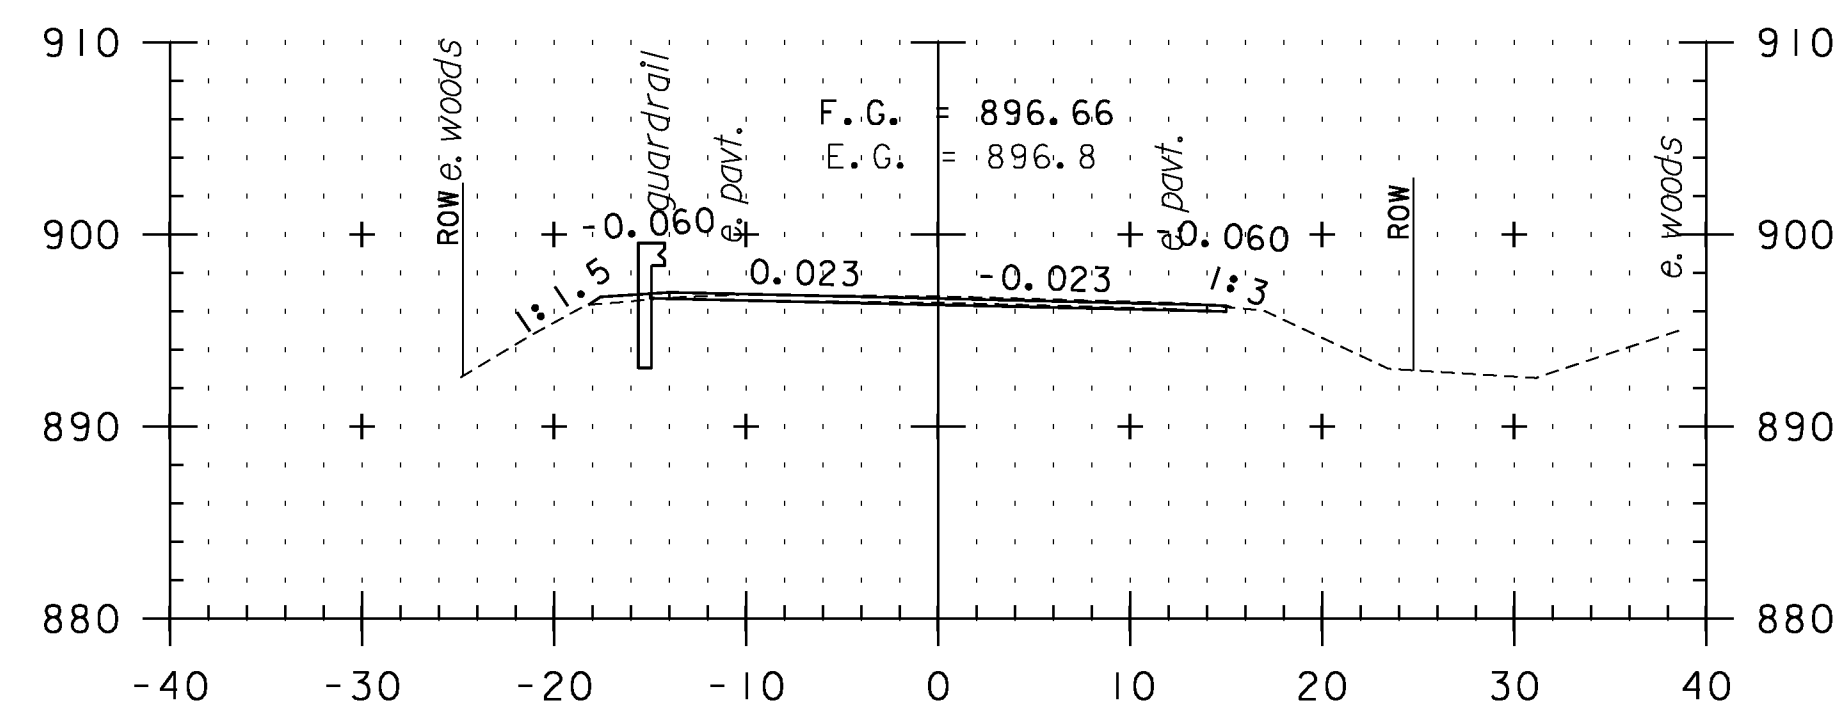


314+50

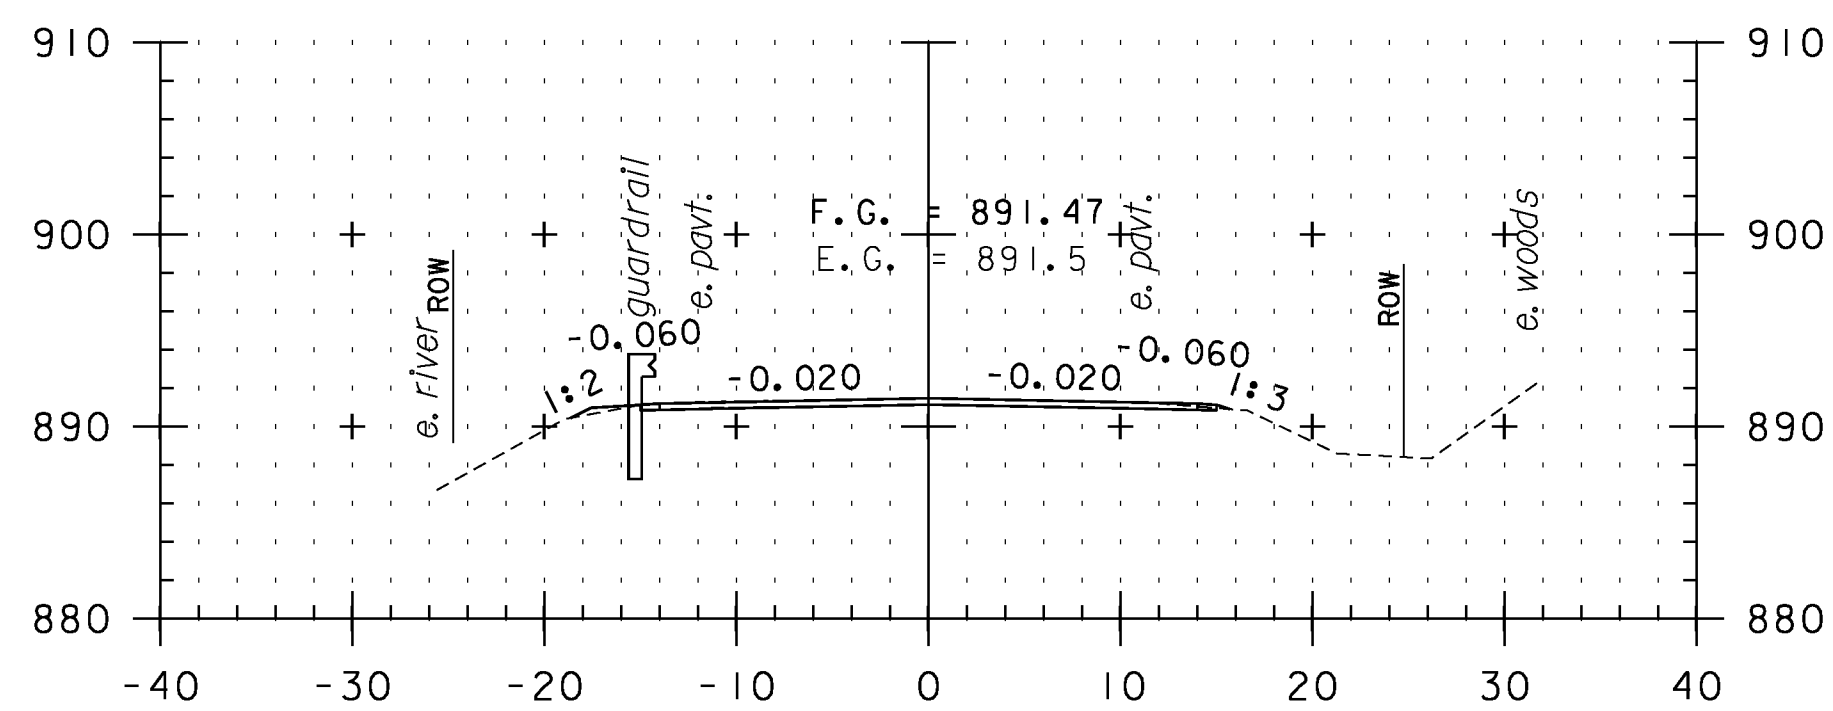


316+00

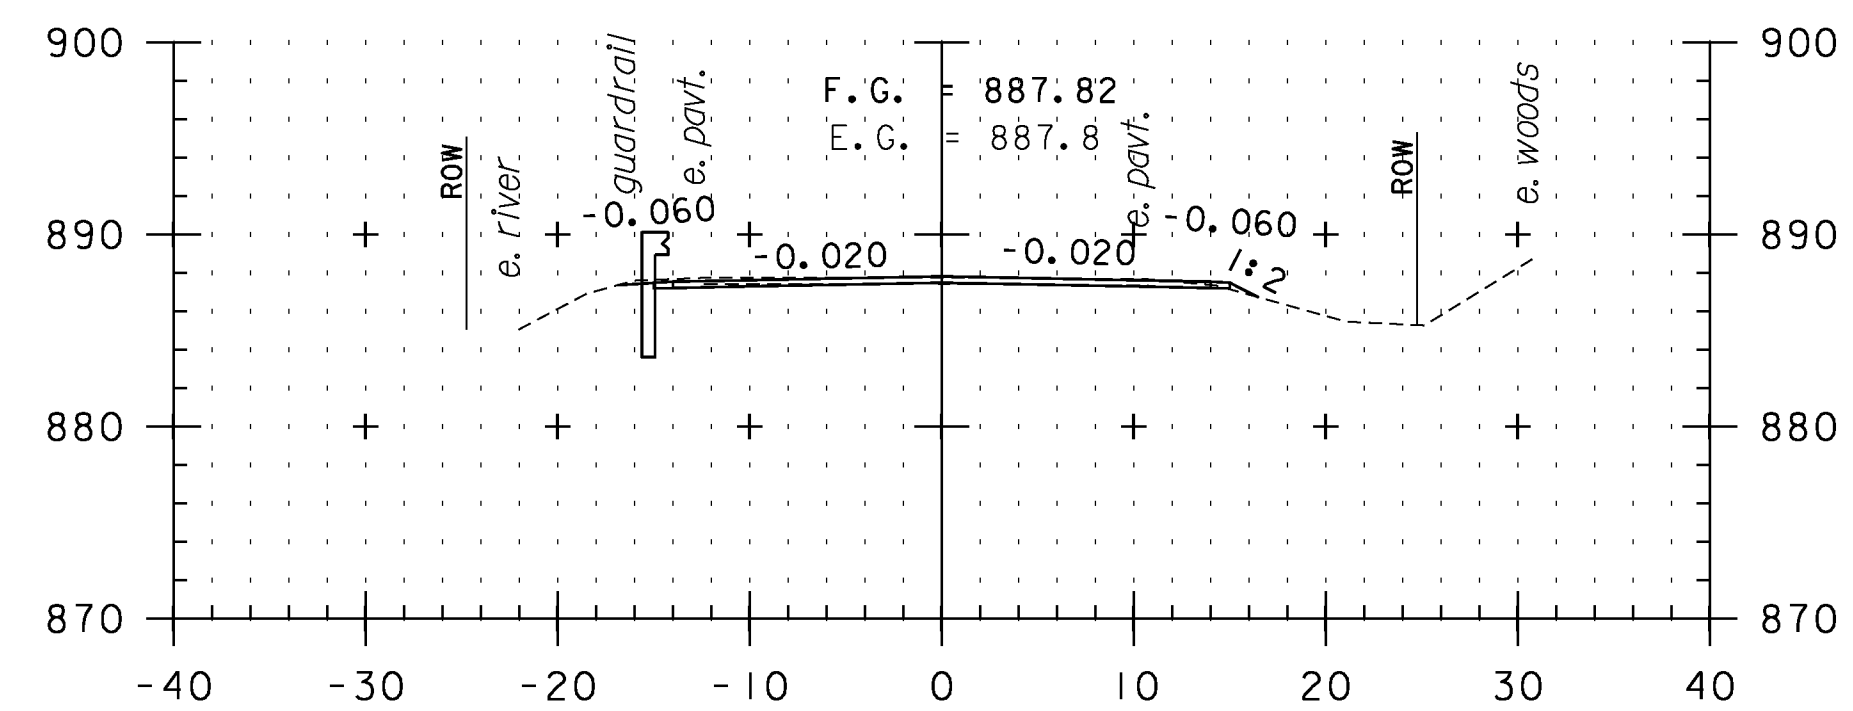


317+50

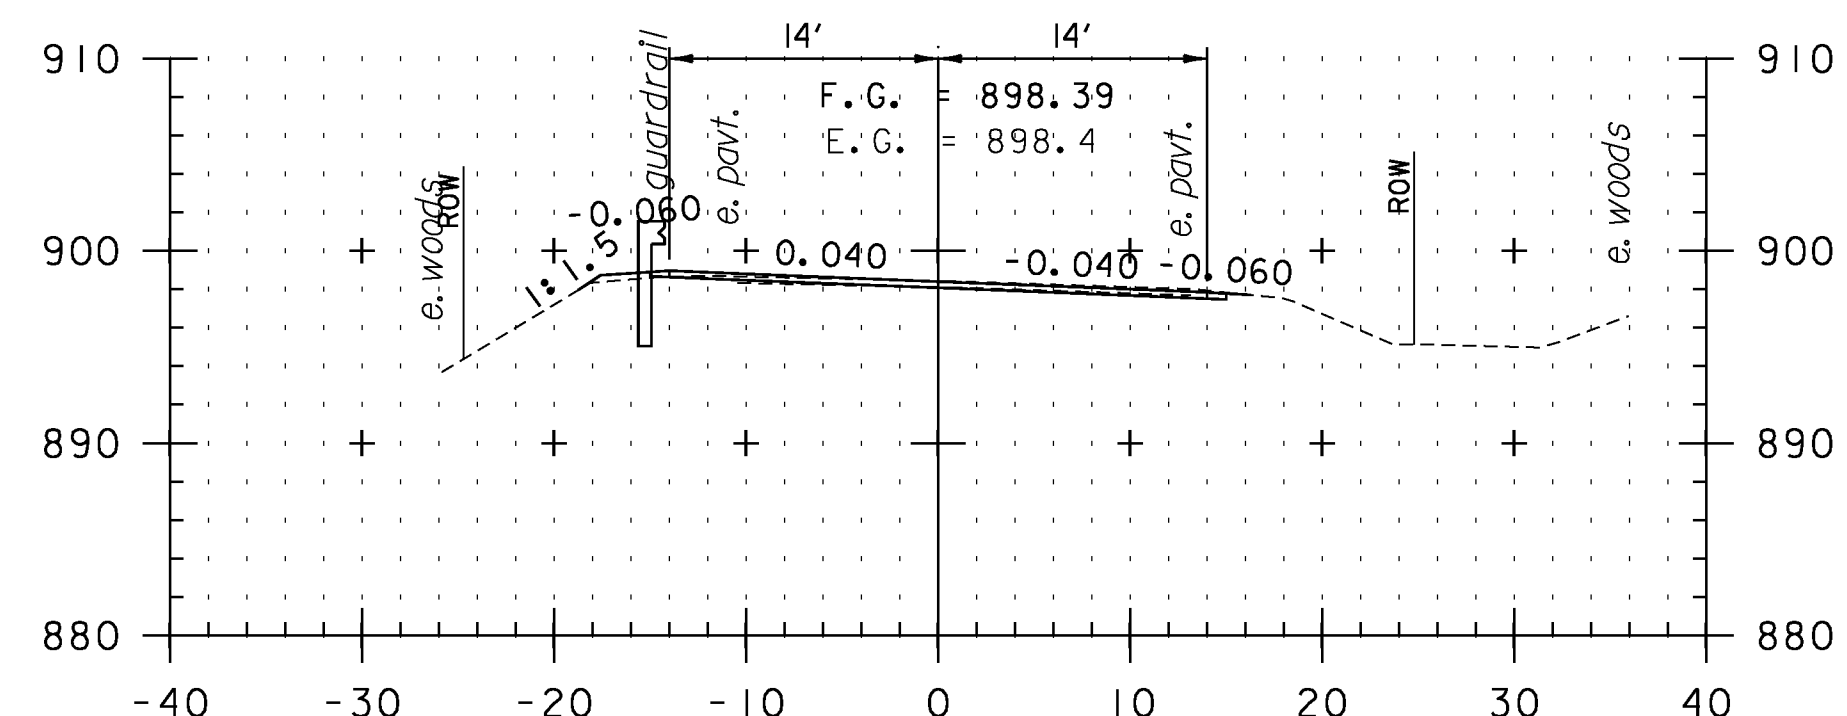

314+00

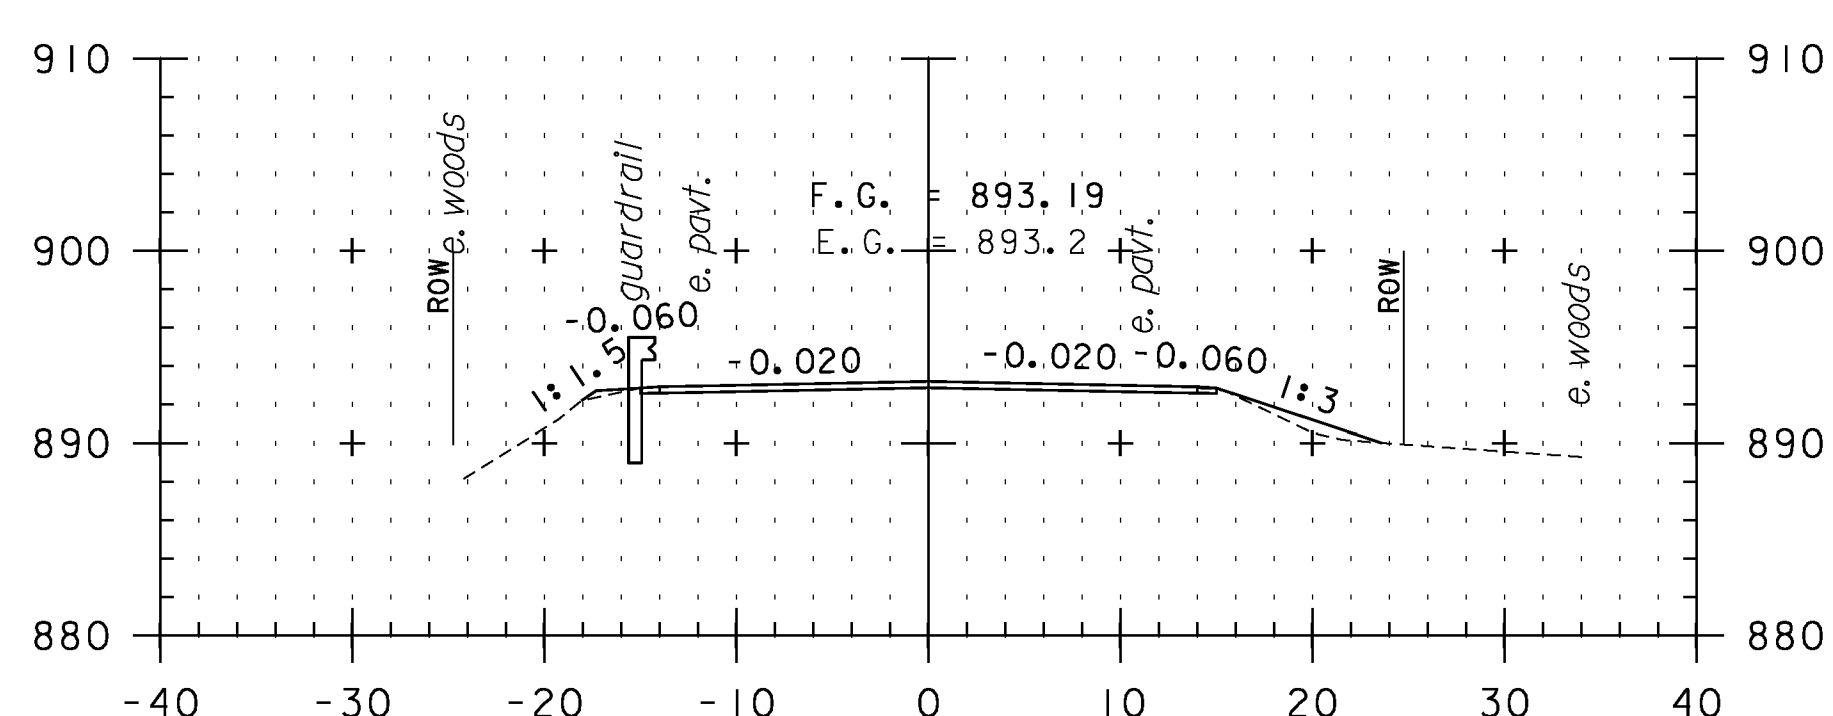

315+50

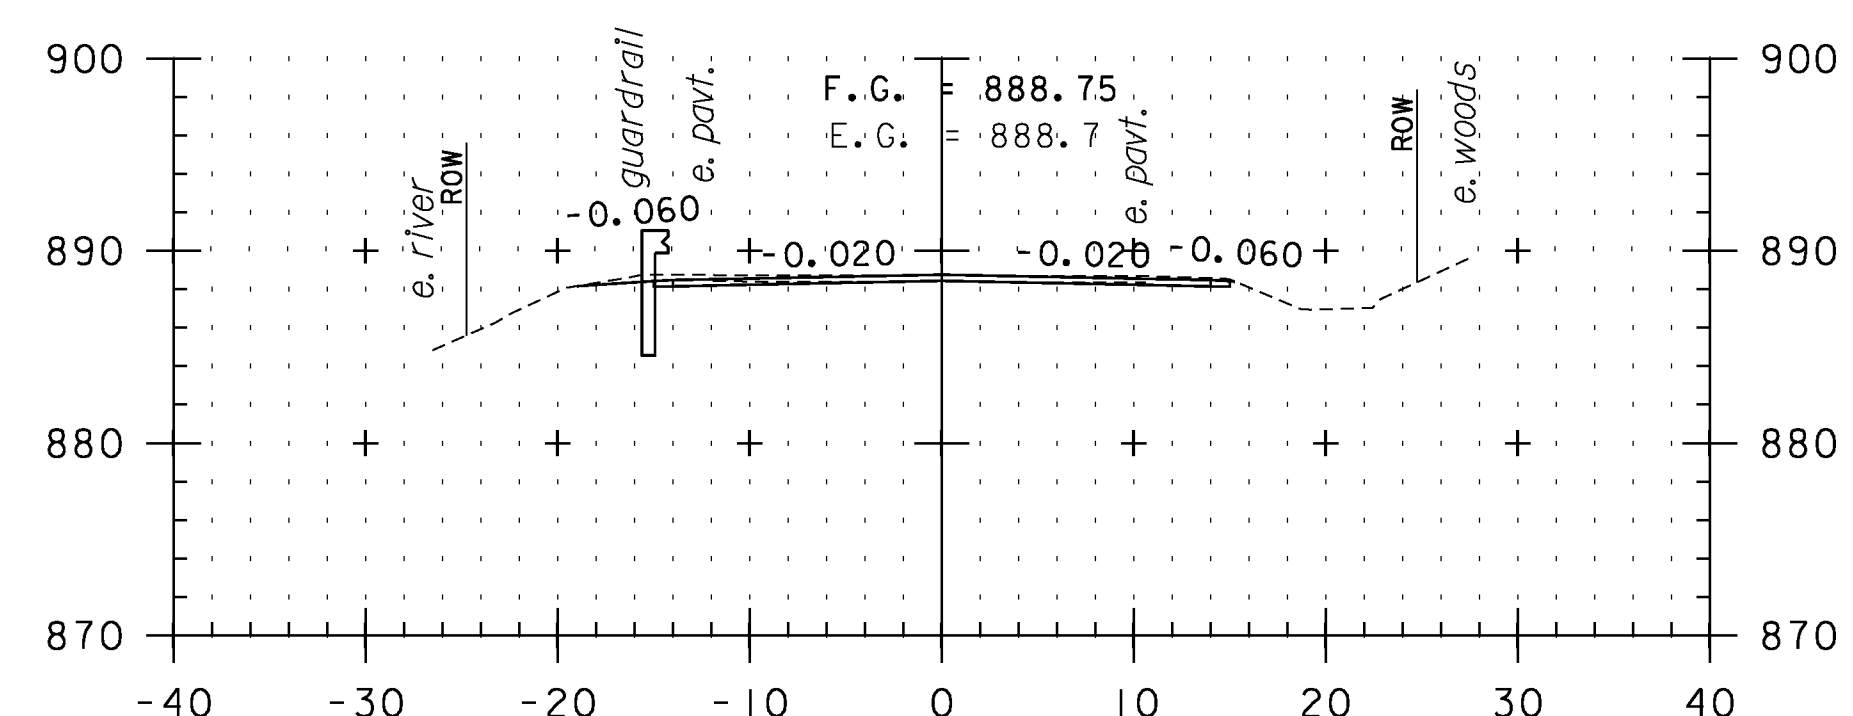

317+00

**CROSS SECTION SHEET 31**

PROJECT NAME: VERSHIRE-THETFORD

PROJECT NUMBER: STP 2911(I)

FILE NAME: pl0c224.dgn

PLOT DATE: 1/29/2013

PROJECT LEADER: PTS

DRAWN BY: SNG

DESIGNED BY: NLL

CHECKED BY: PTS

IPARM FILE NAME: IOC224\_I39

SHEET 139 OF 232

STA. 314+00 TO STA. 318+00

