


**CROSS SECTION SHEET 33**

STA. 323+00 TO STA. 327+00

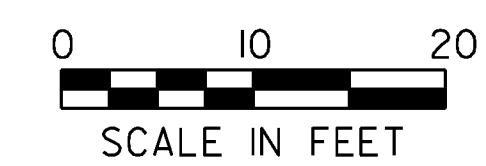

PROJECT NAME: VERSHIRE-THETFORD	PLOT DATE: 1/29/2013
PROJECT NUMBER: STP 2911(I)	DRAWN BY: SNG
FILE NAME: pl0c224.dgn	CHECKED BY: PTS
PROJECT LEADER: PTS	SHEET 141 OF 232
DESIGNED BY: NLL	
IPARM FILE NAME: IOC224_I41	