




333+00

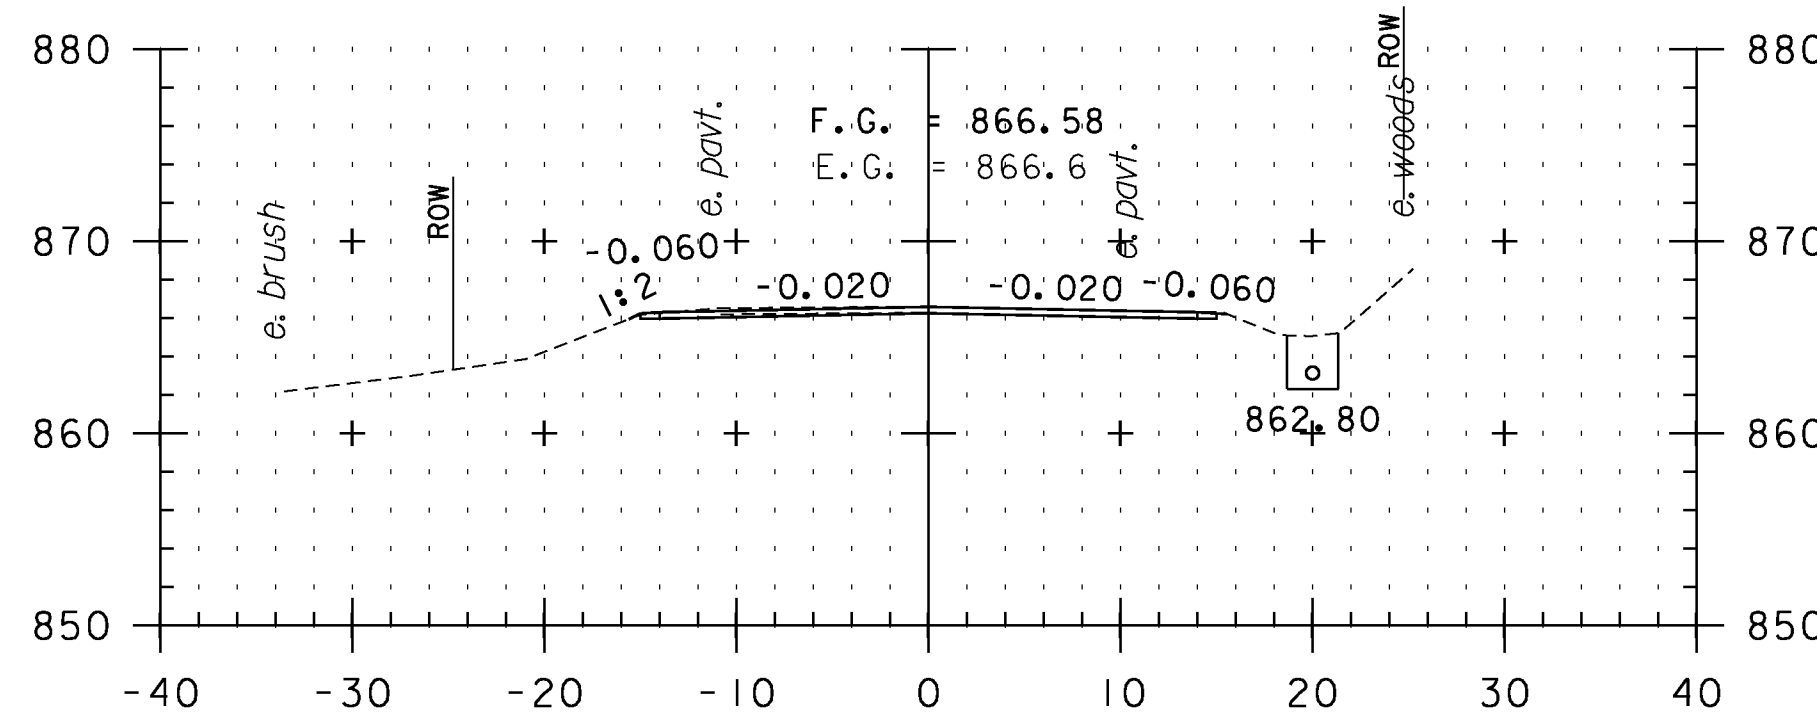


334+50

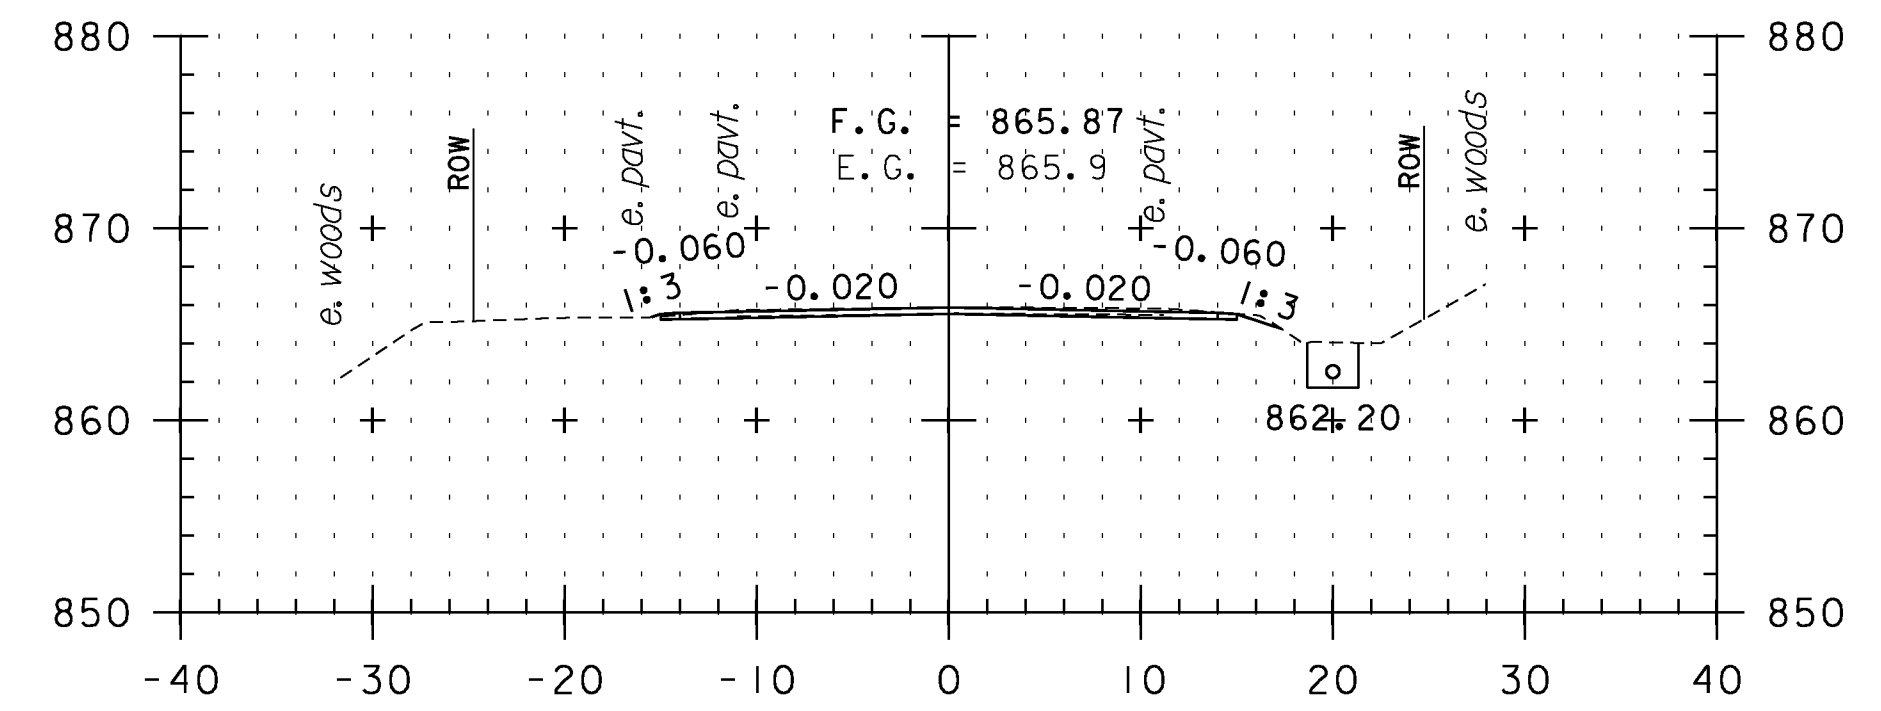


336+00

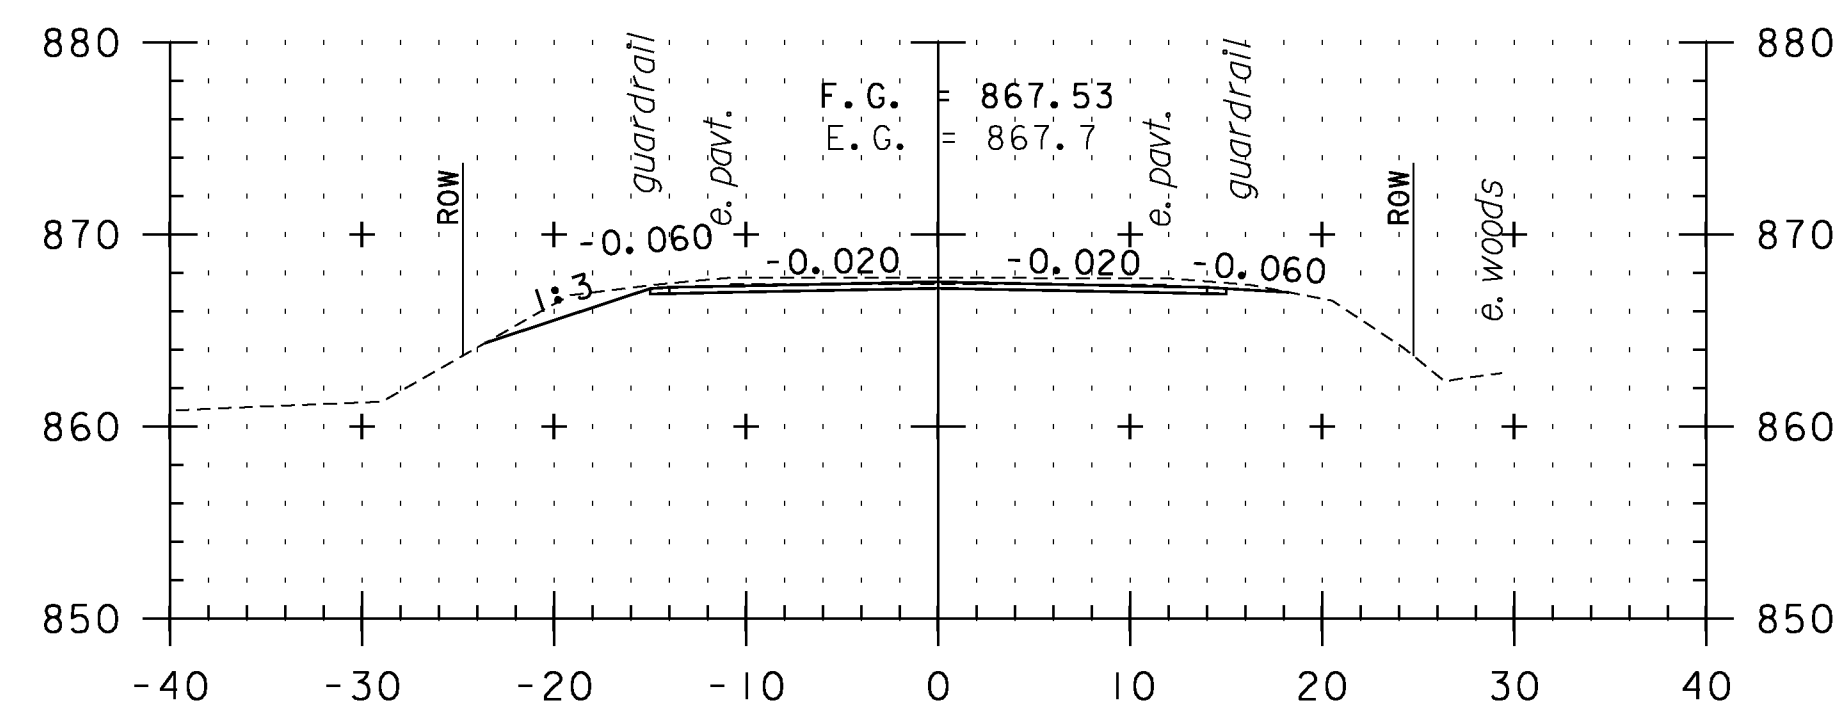


332+50

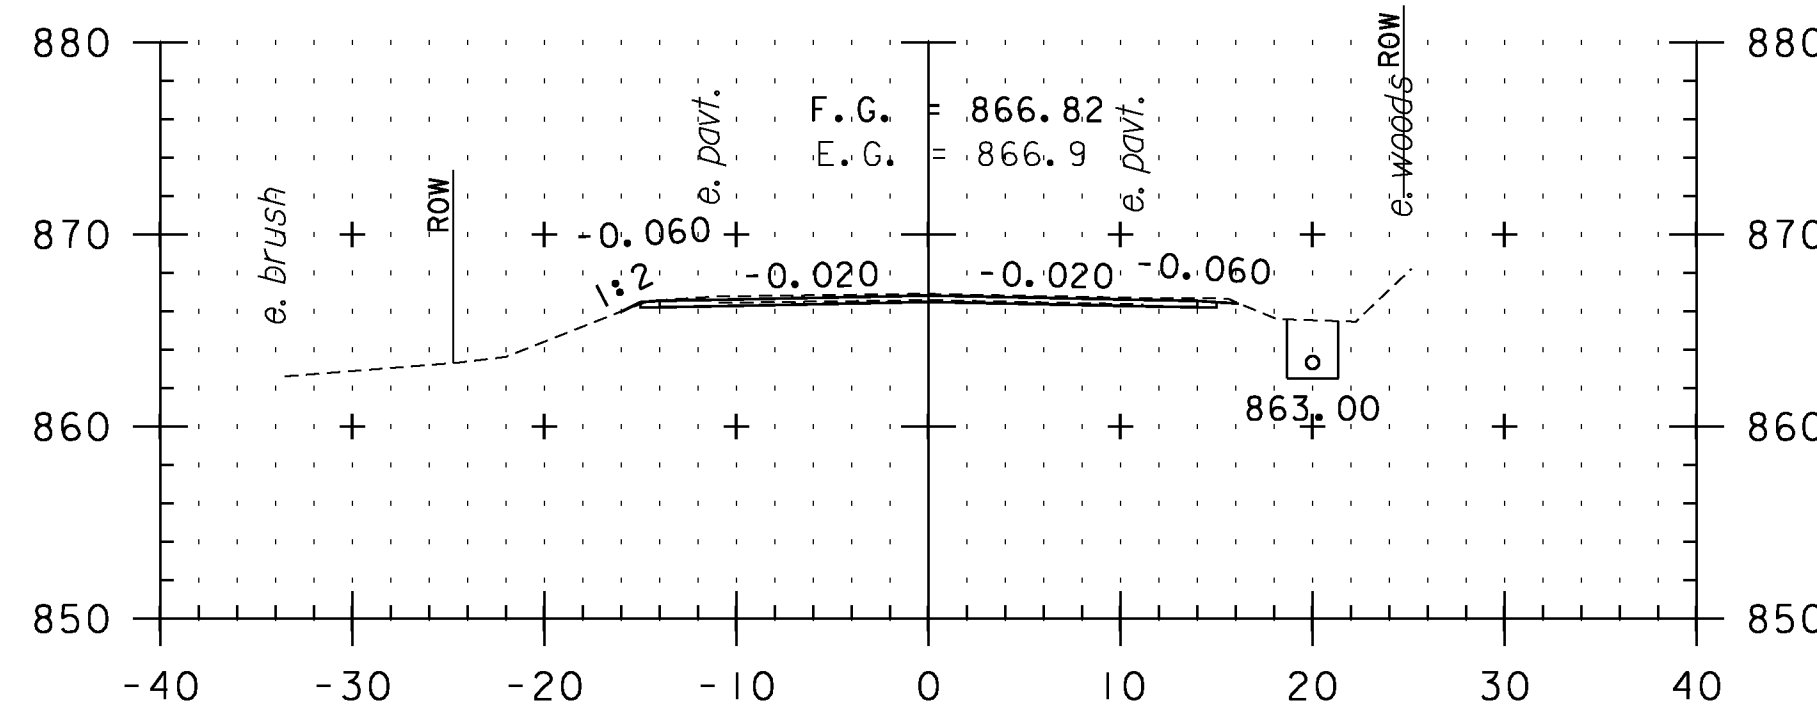


334+00

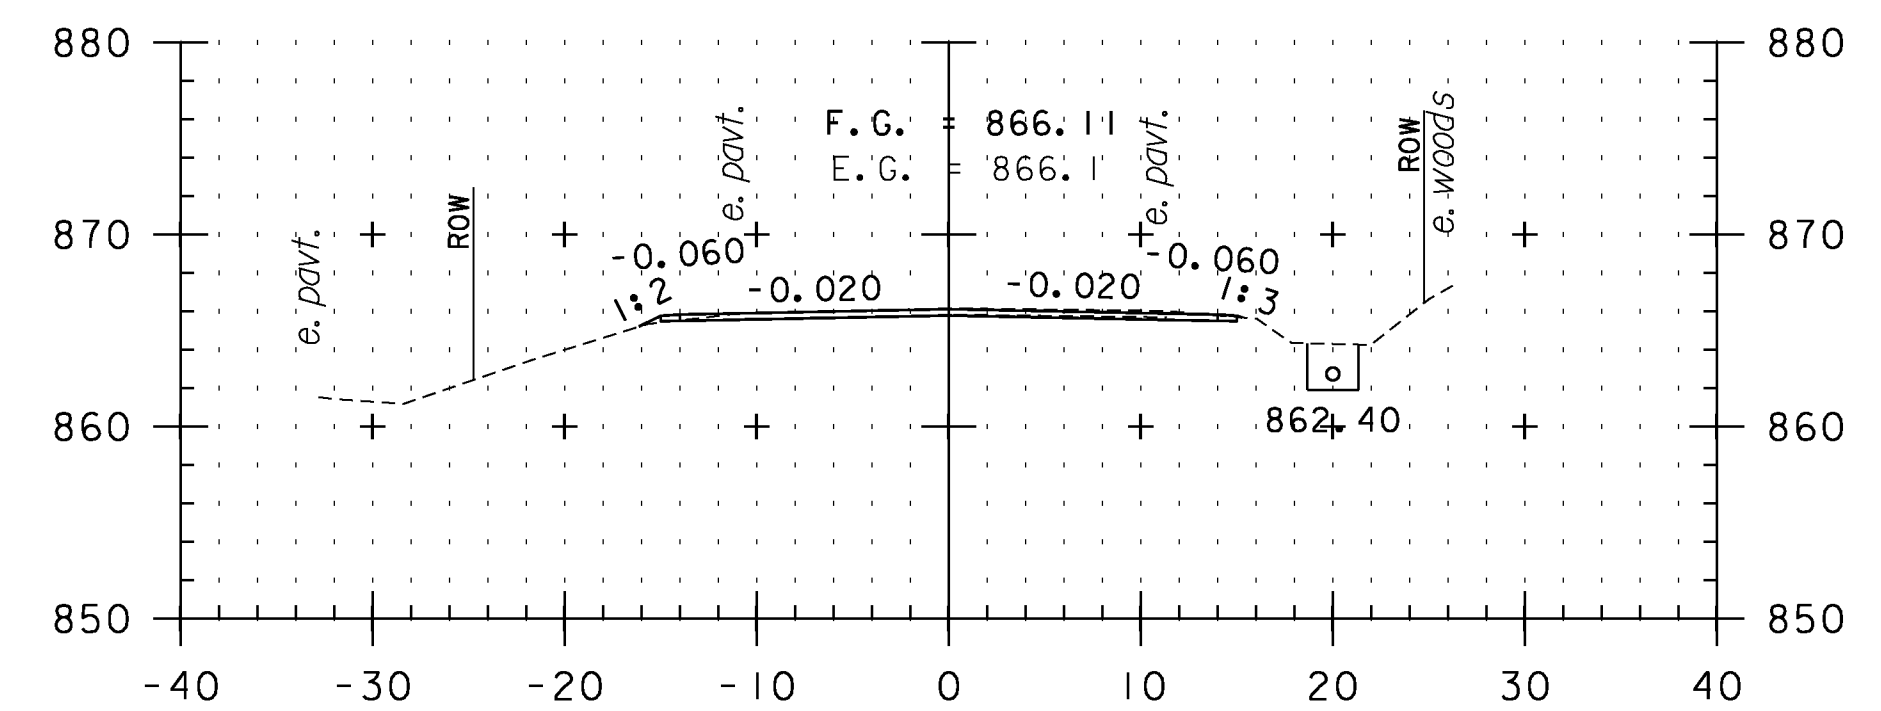


335+50

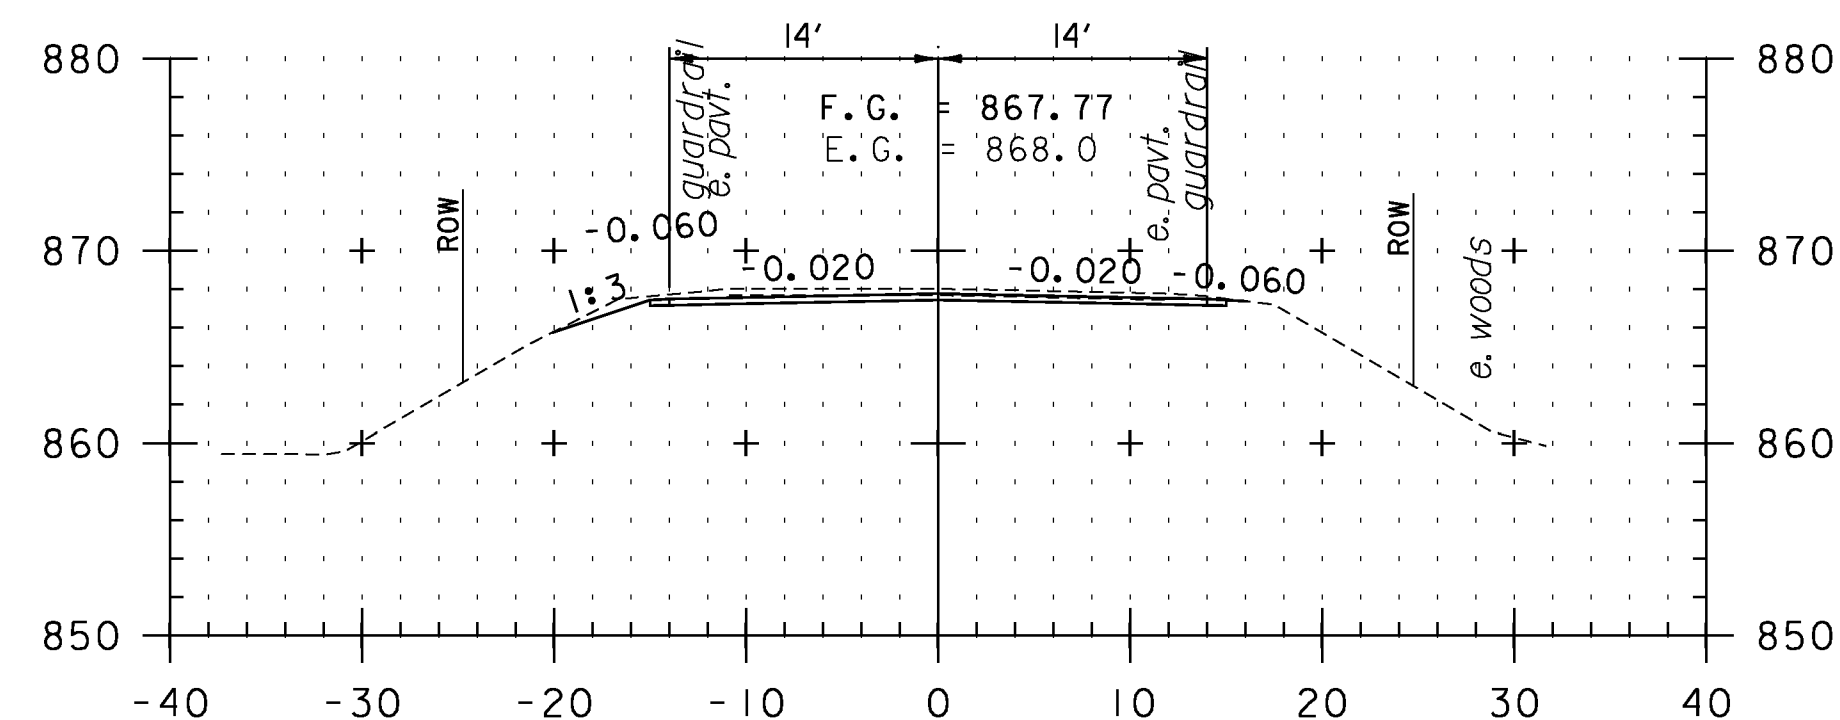

332+00

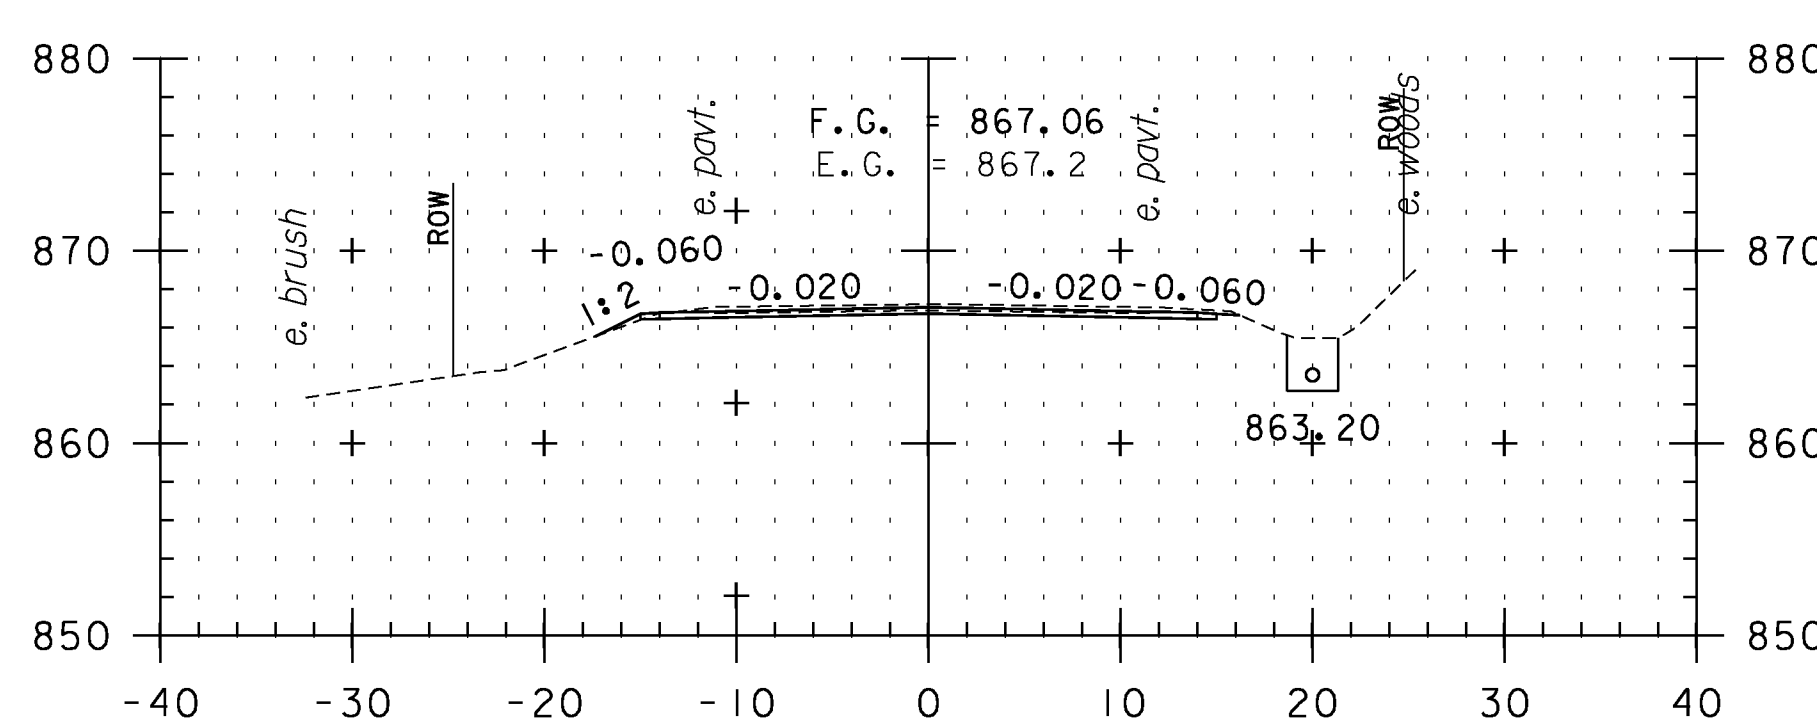


333+50

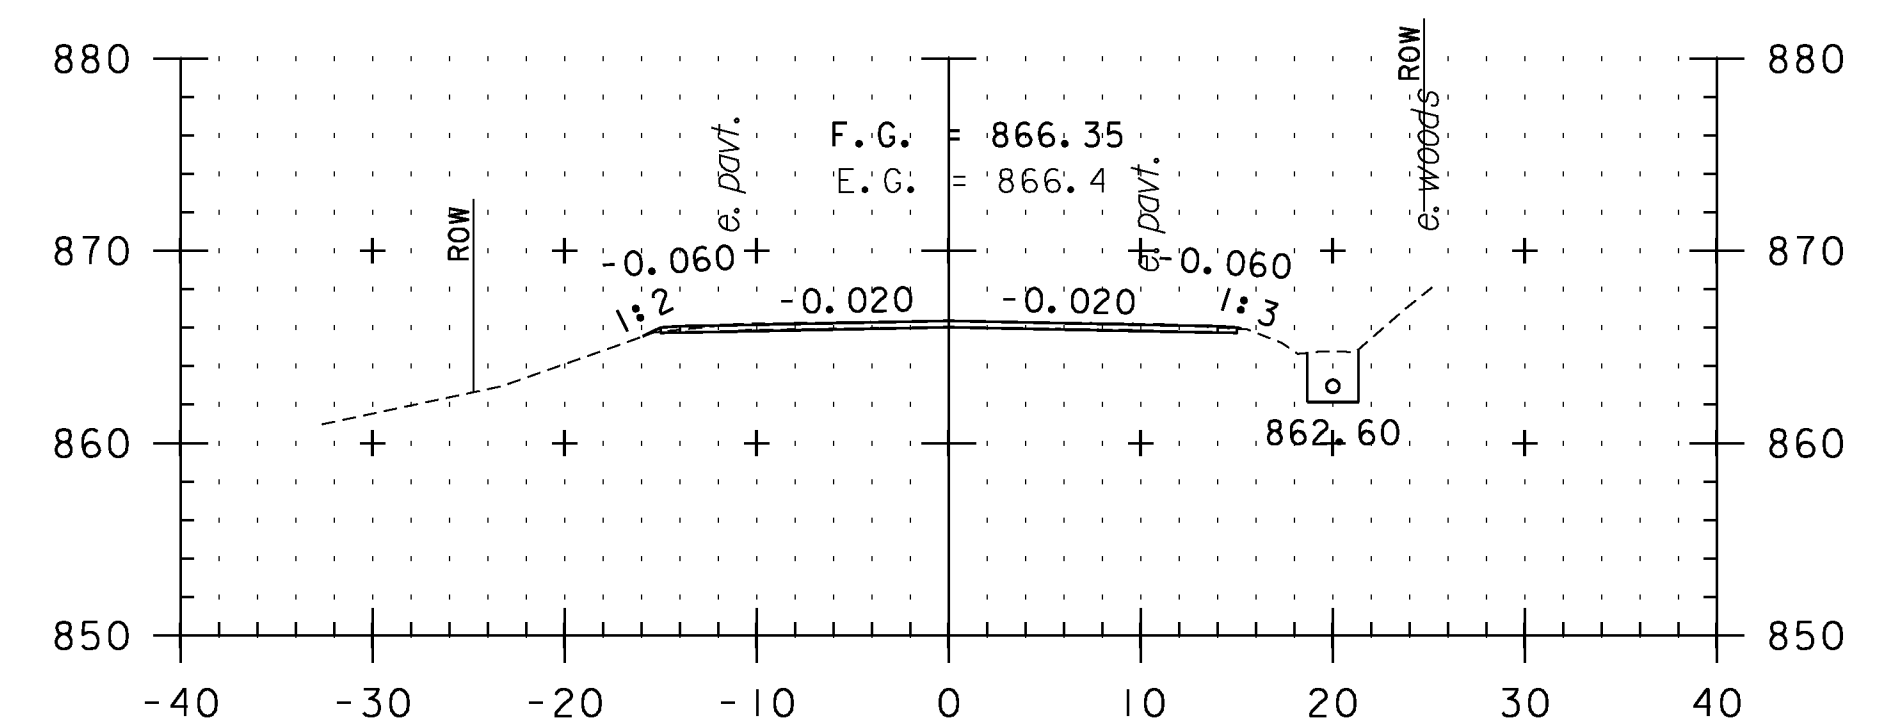

335+00

CROSS SECTION SHEET 35

STA. 332+00 TO STA. 336+00

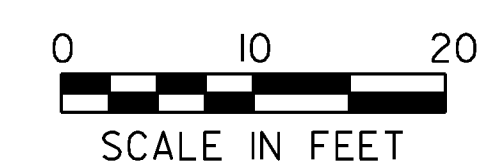

PROJECT NAME: VERSHIRE-THETFORD	PLOT DATE: 1/29/2013
PROJECT NUMBER: STP 2911(I)	DRAWN BY: SNG
FILE NAME: pl0c224.dgn	CHECKED BY: PTS
PROJECT LEADER: PTS	SHEET 143 OF 232
DESIGNED BY: NLL	
IPARM FILE NAME: IOC224_I43	