




337+50

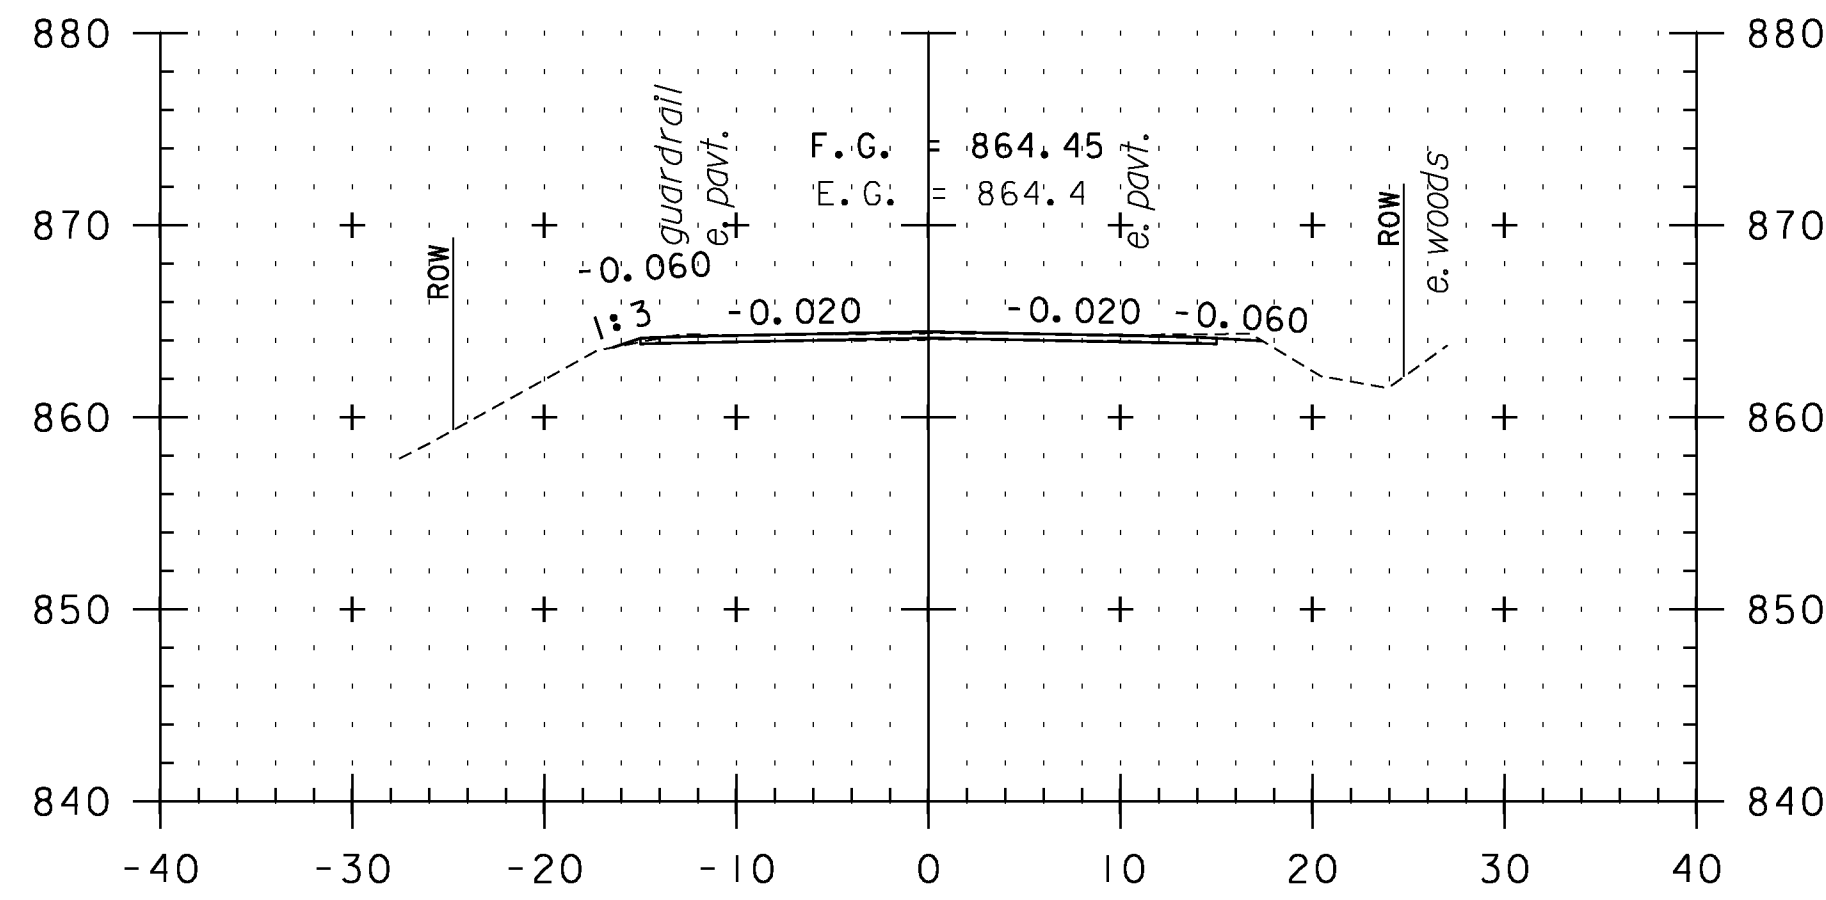


339+00

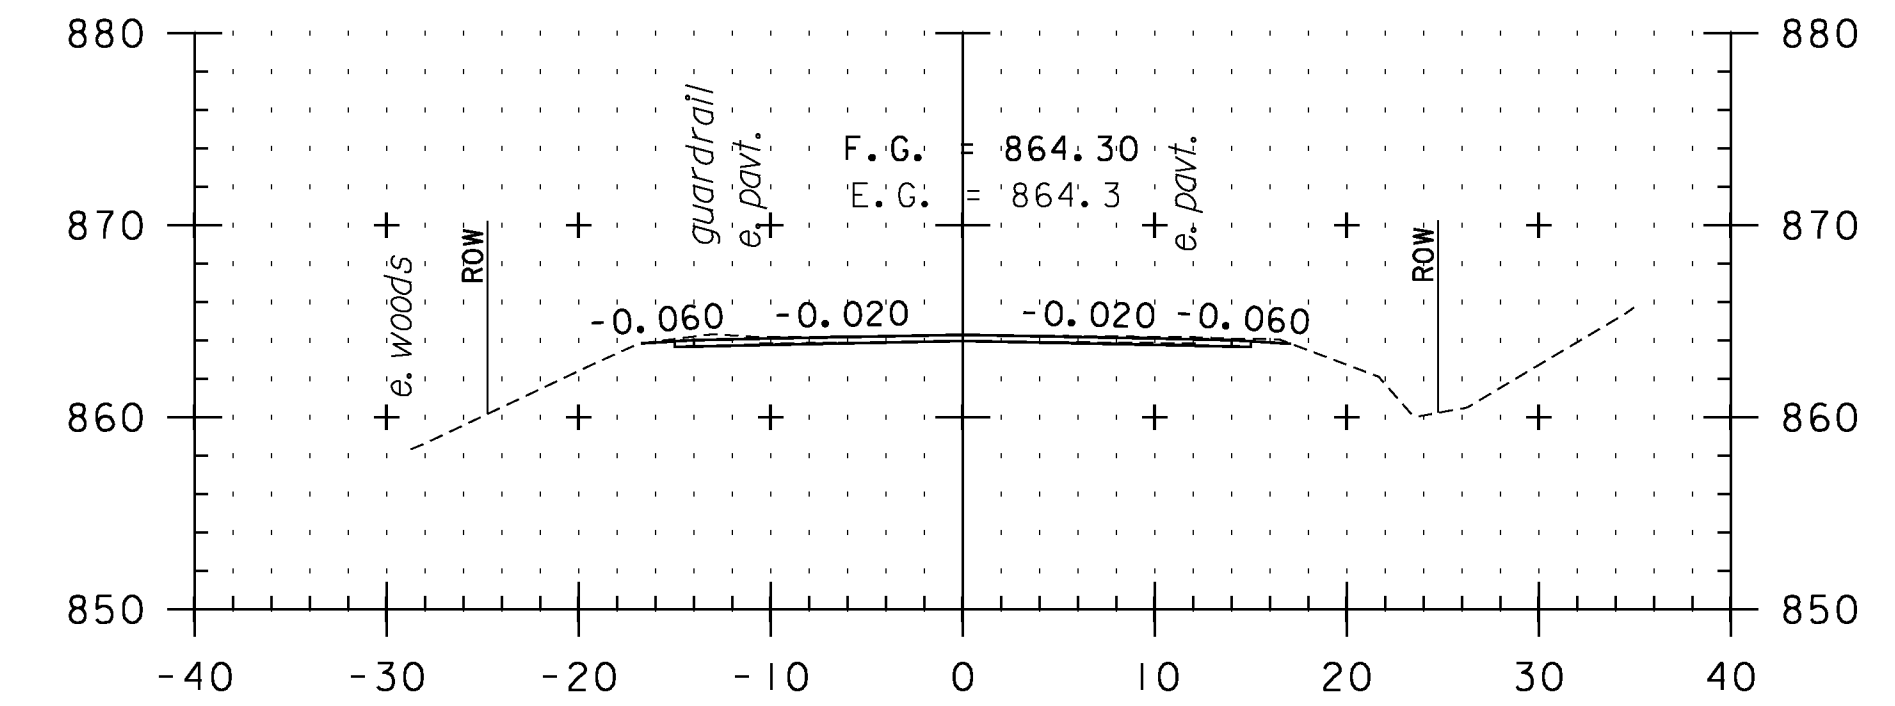


340+50

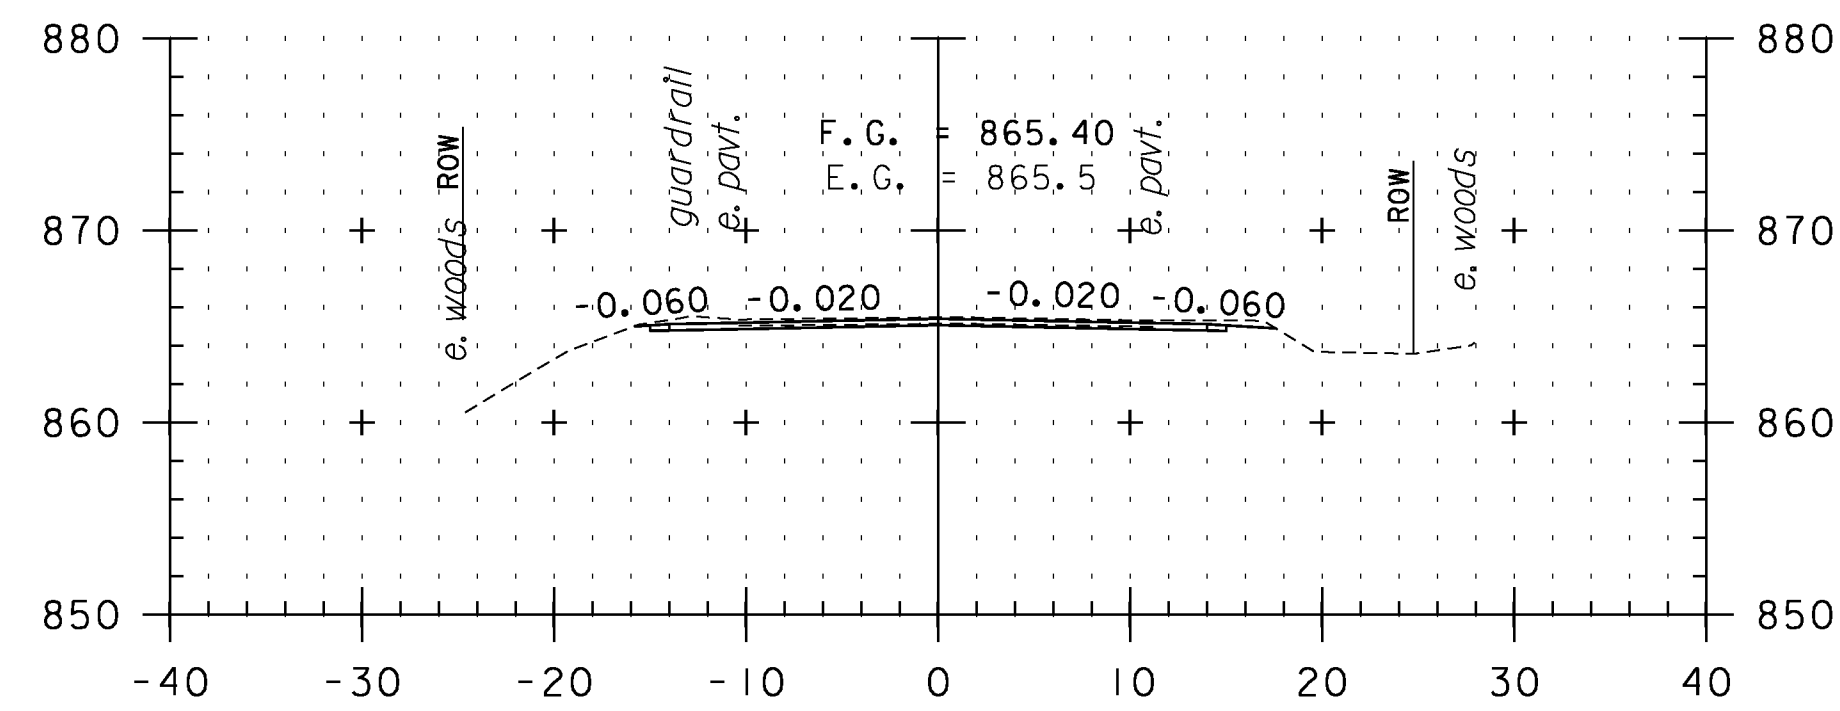


337+00

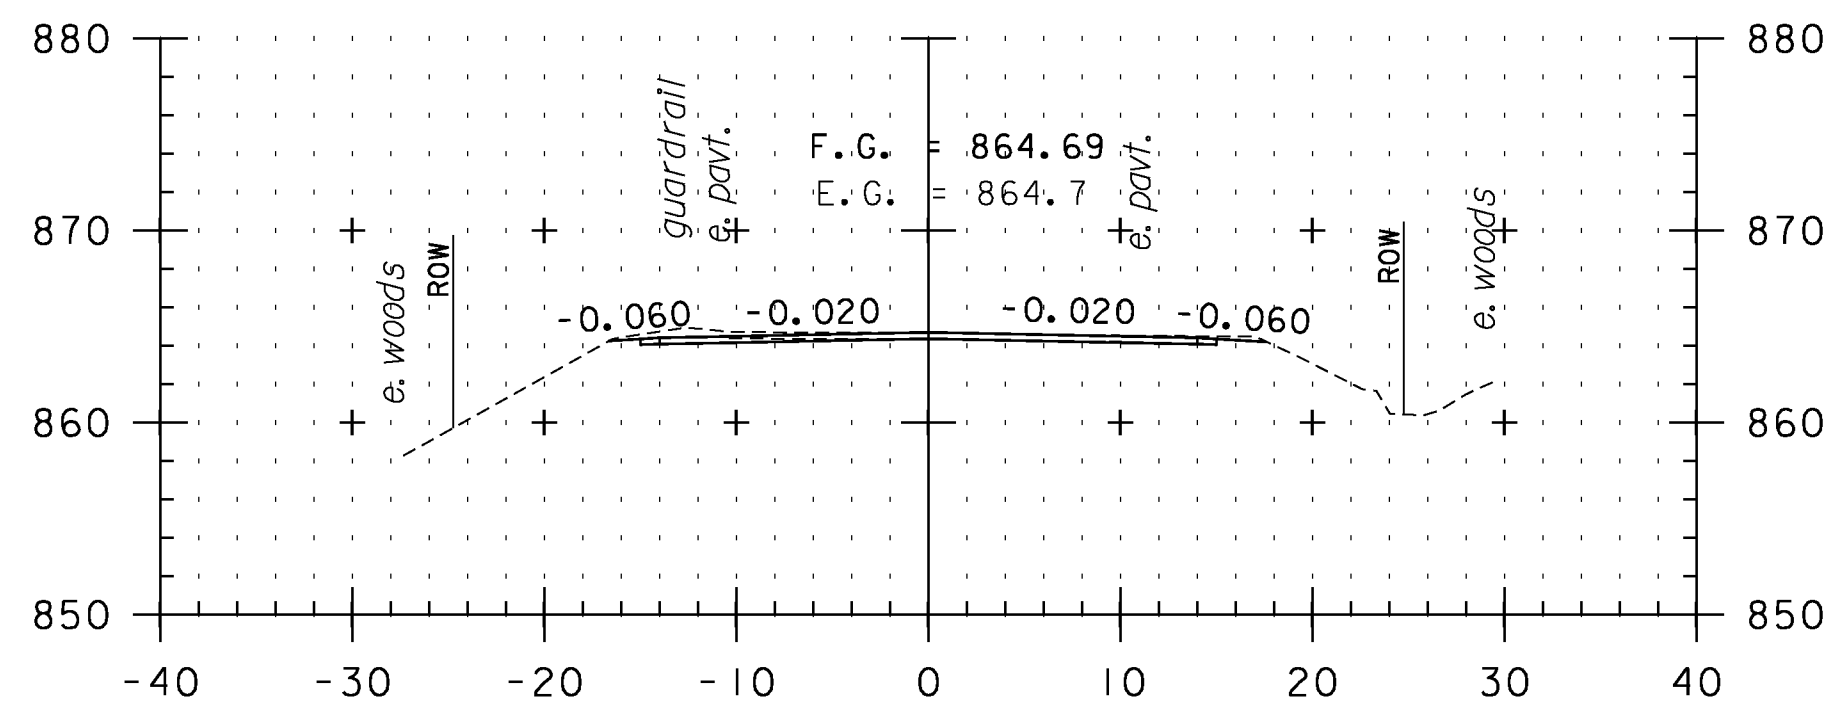


338+50

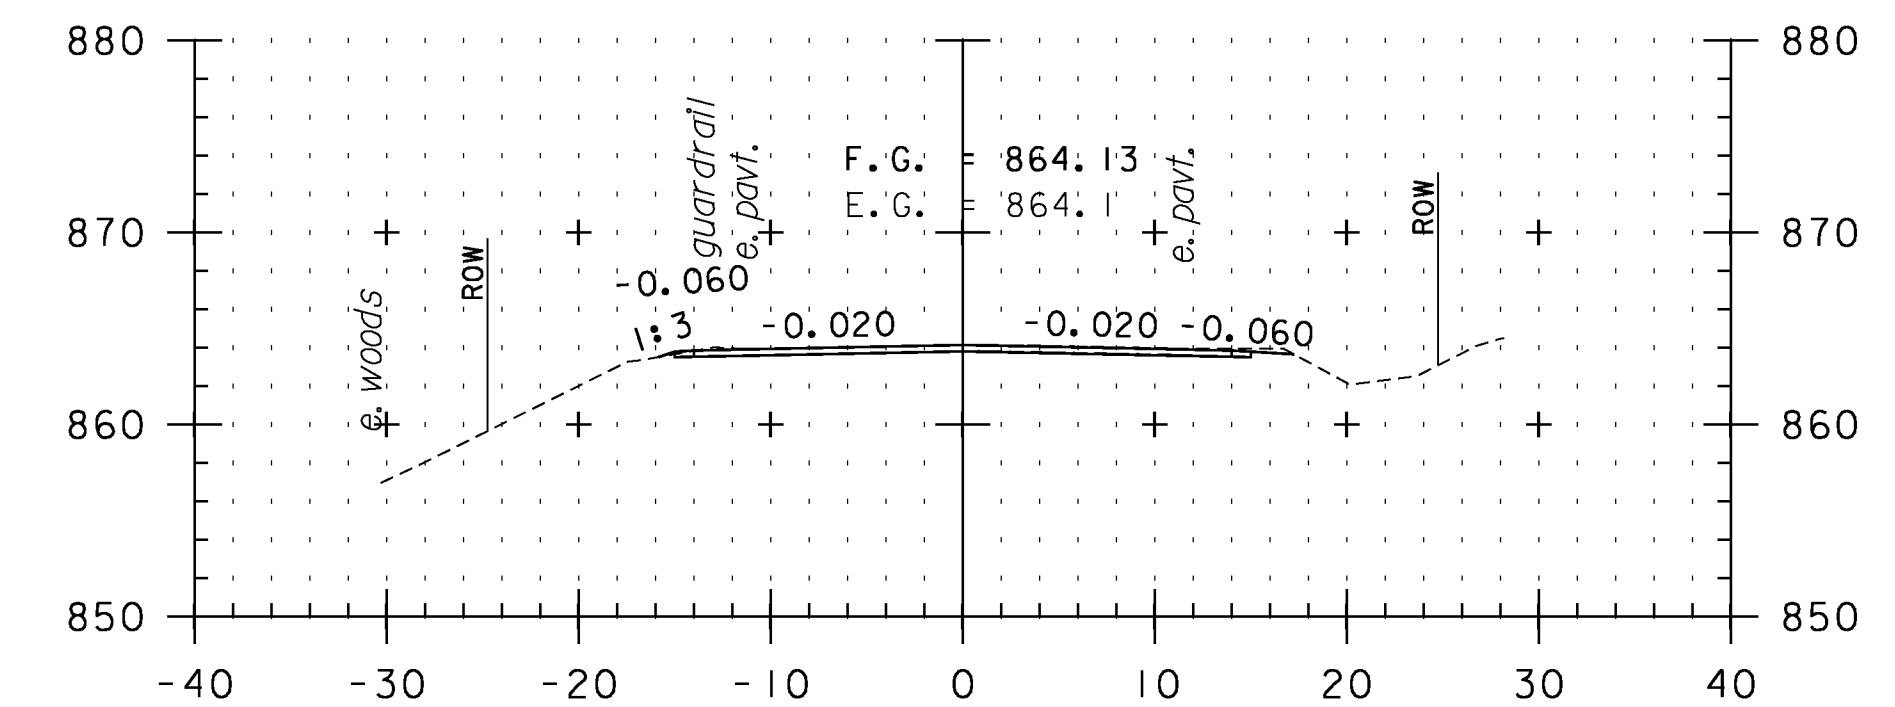


340+00

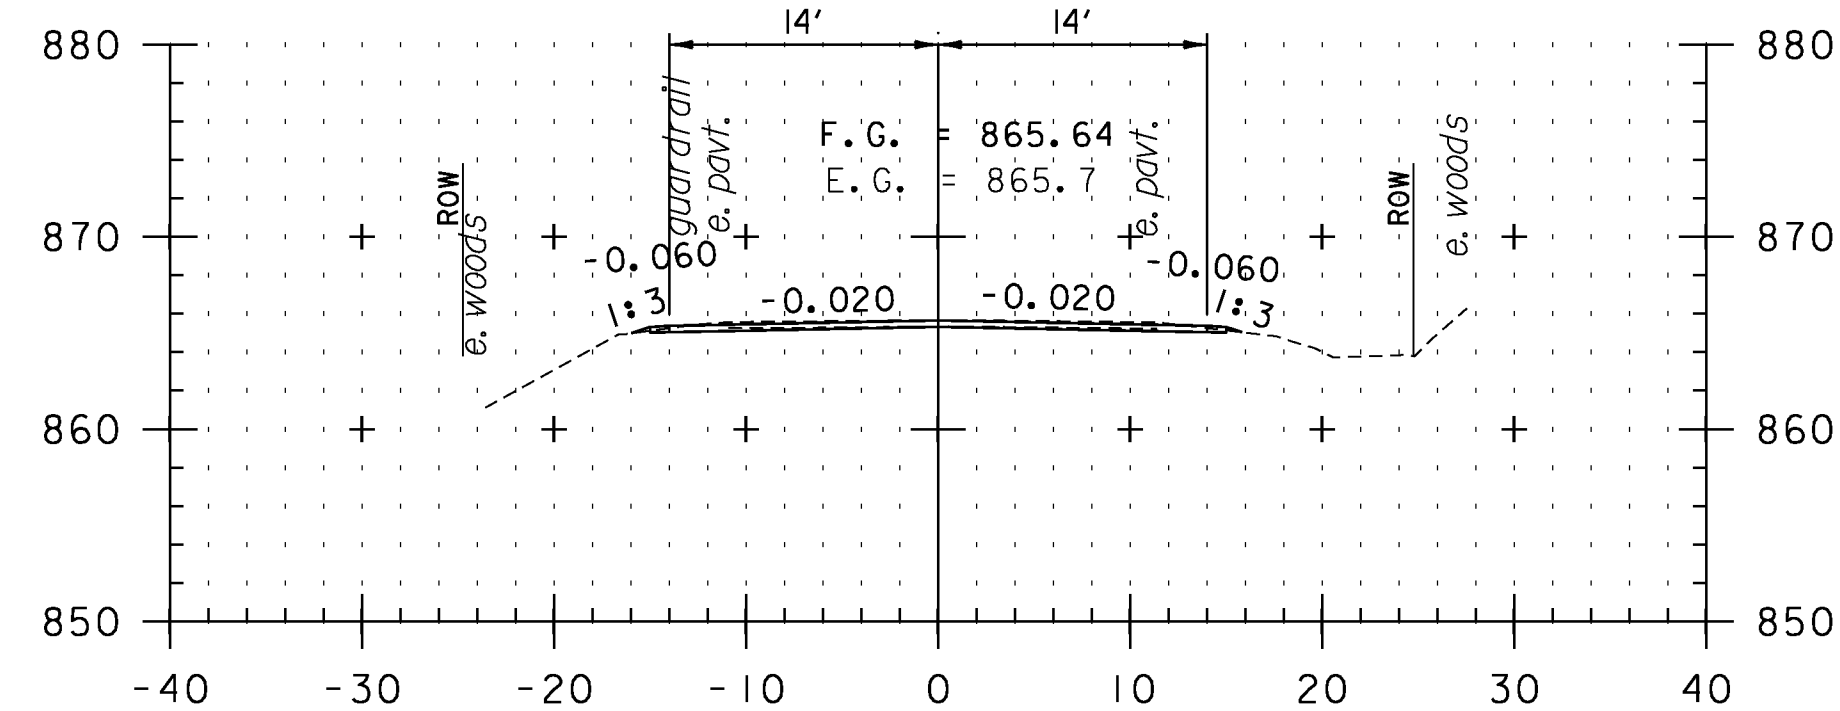

336+50

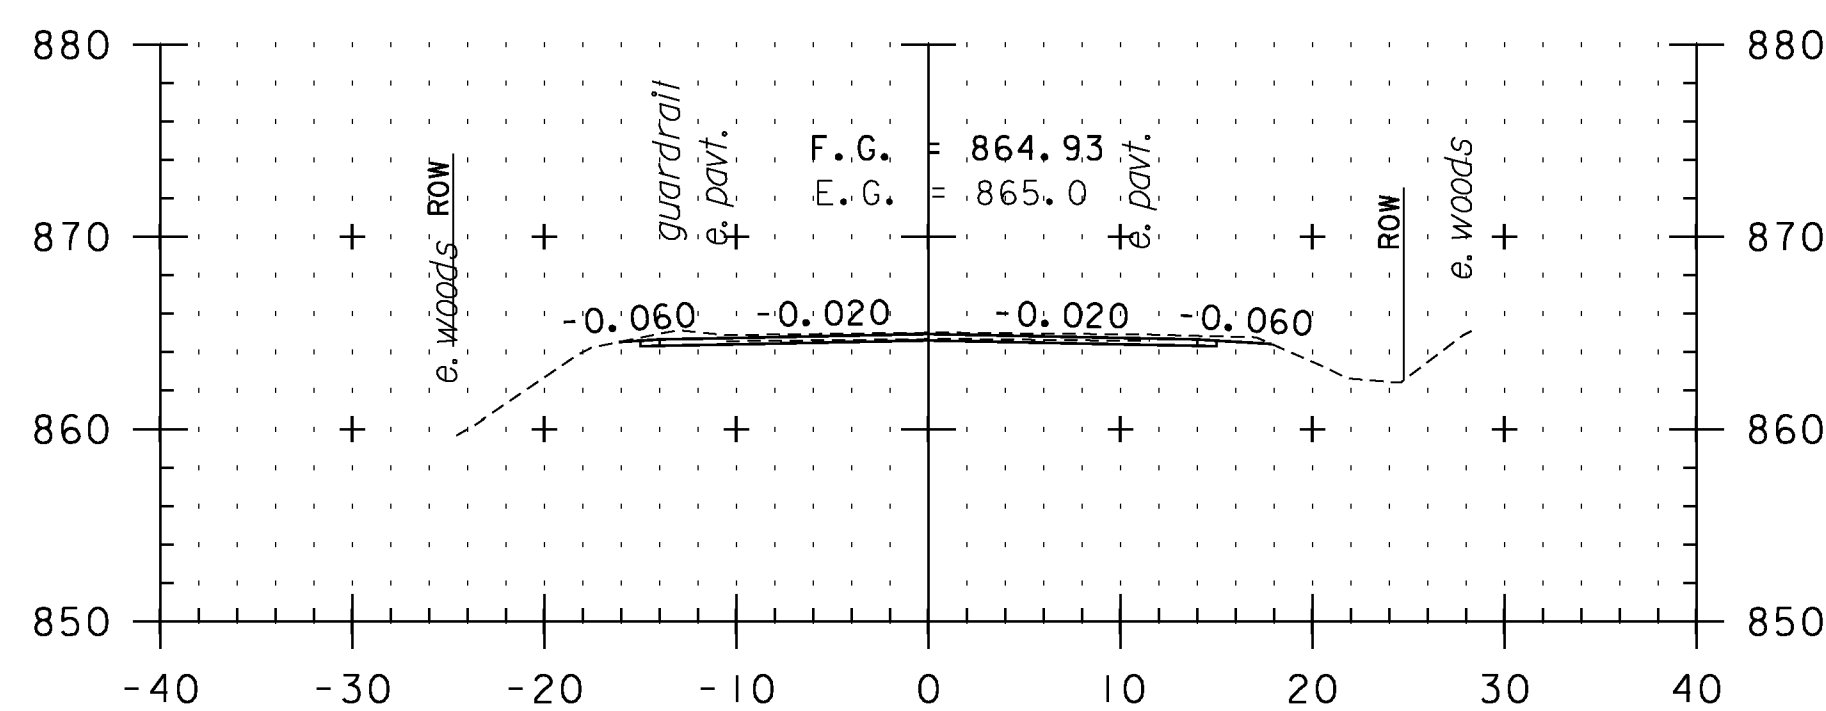

338+00

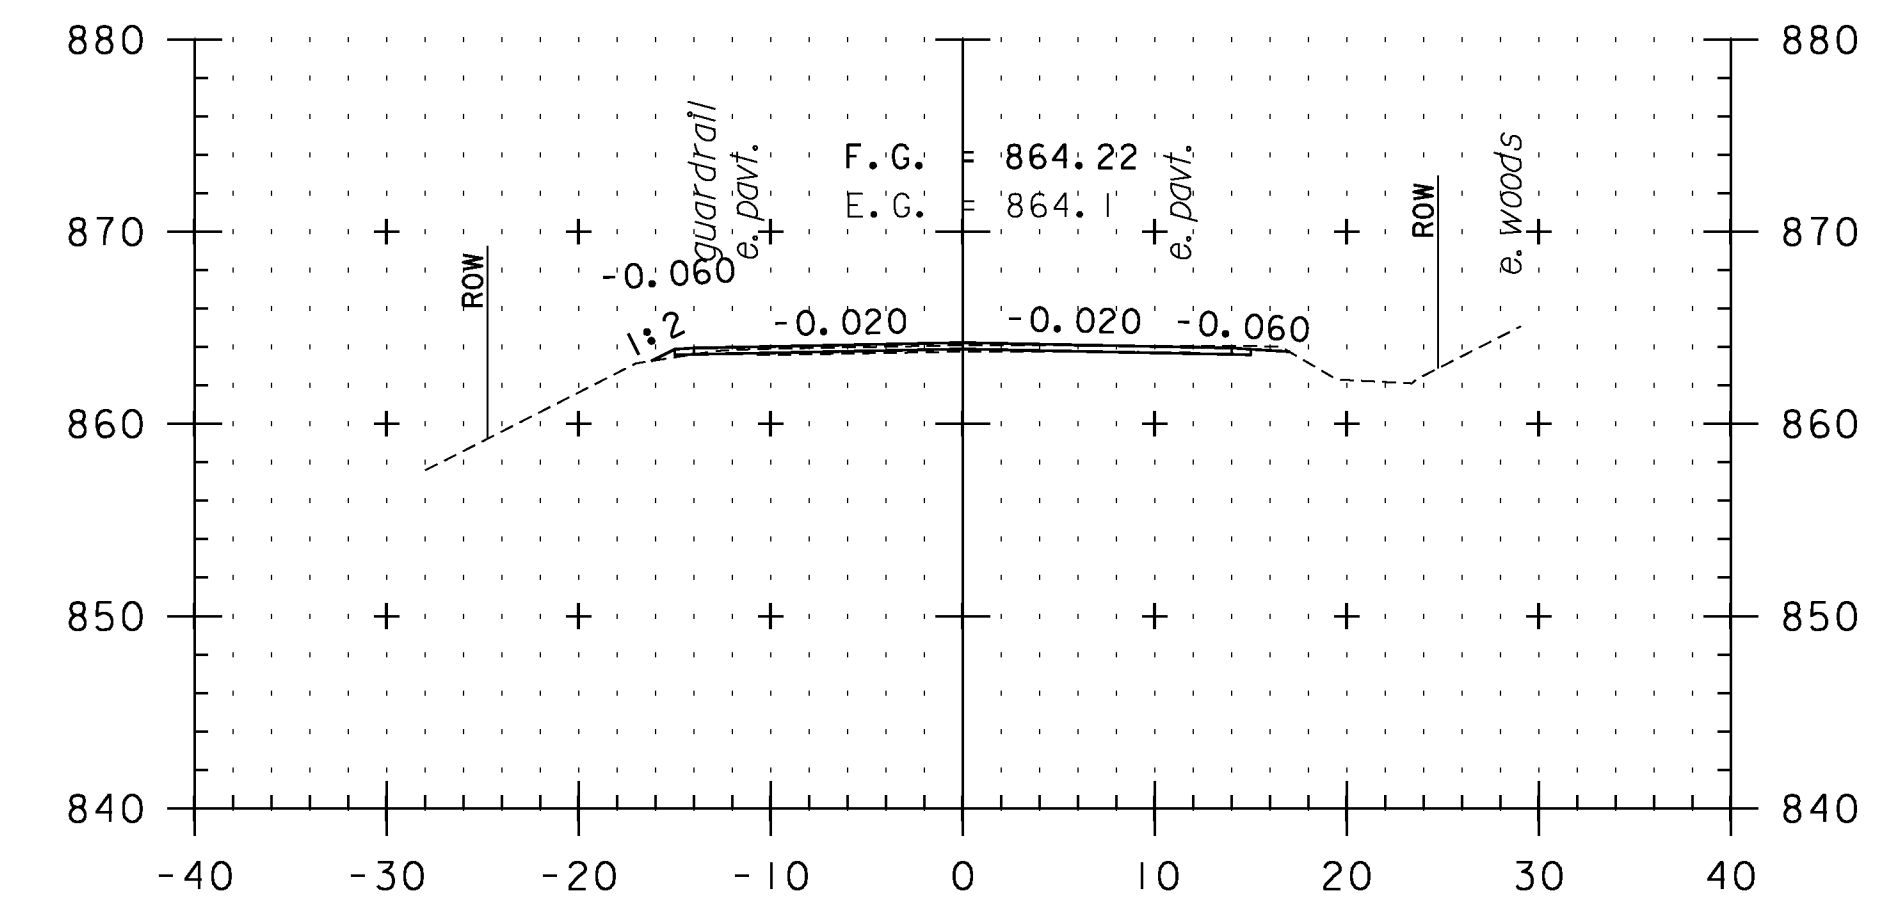

339+50

CROSS SECTION SHEET 36

STA. 336+50 TO STA. 340+50



PROJECT NAME: VERSHIRE-THETFORD	PLOT DATE: 1/29/2013
PROJECT NUMBER: STP 2911(I)	DRAWN BY: SNG
FILE NAME: pl0c224.dgn	CHECKED BY: PTS
PROJECT LEADER: PTS	SHEET 144 OF 232
DESIGNED BY: NLL	
IPARM FILE NAME: IOC224_144	