



342+00




343+50

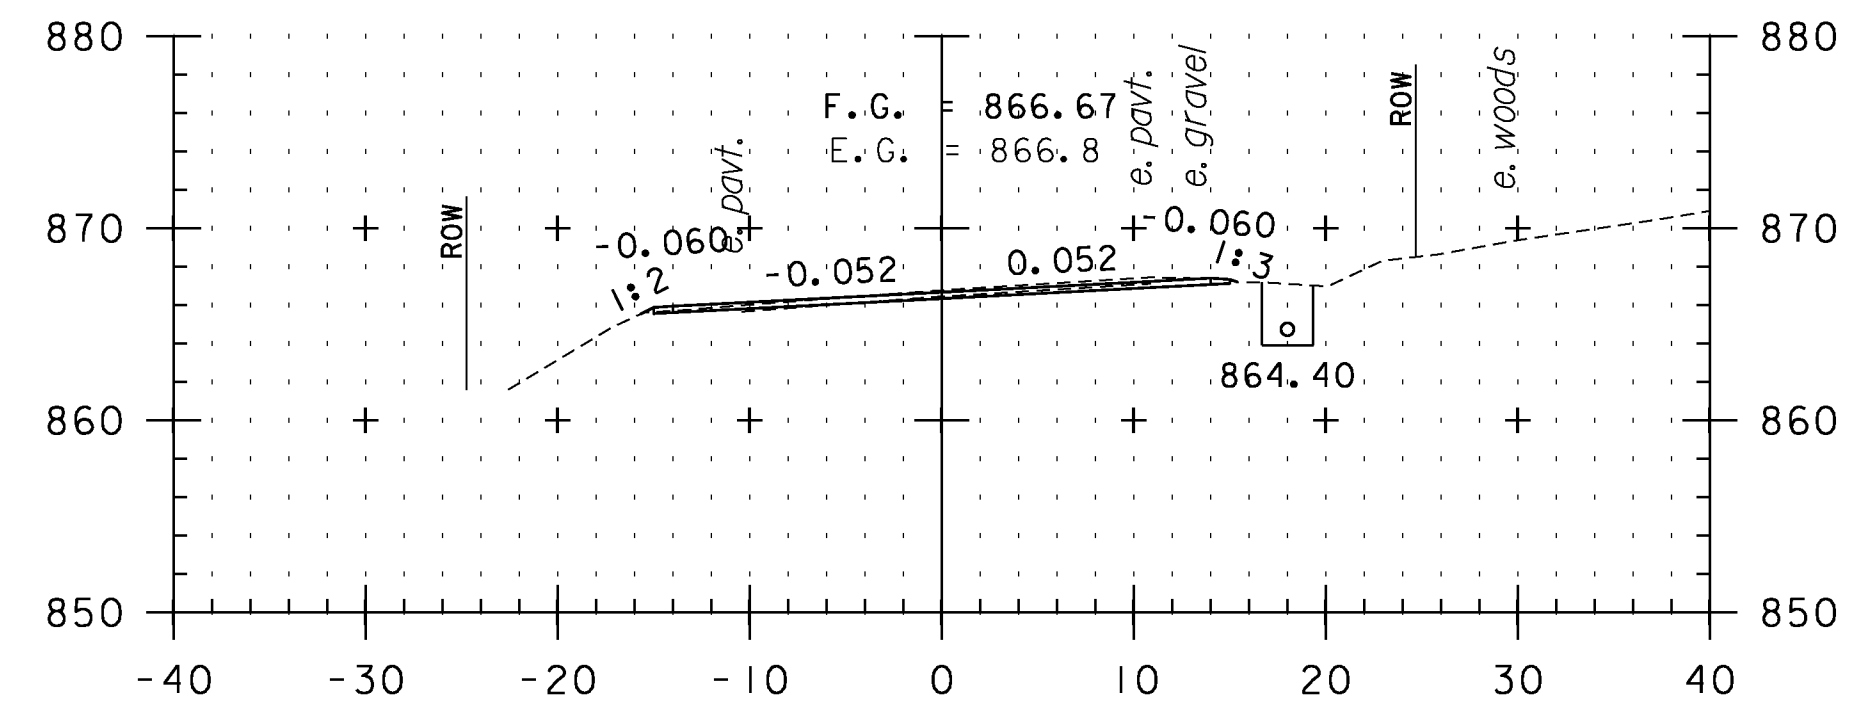


345+00

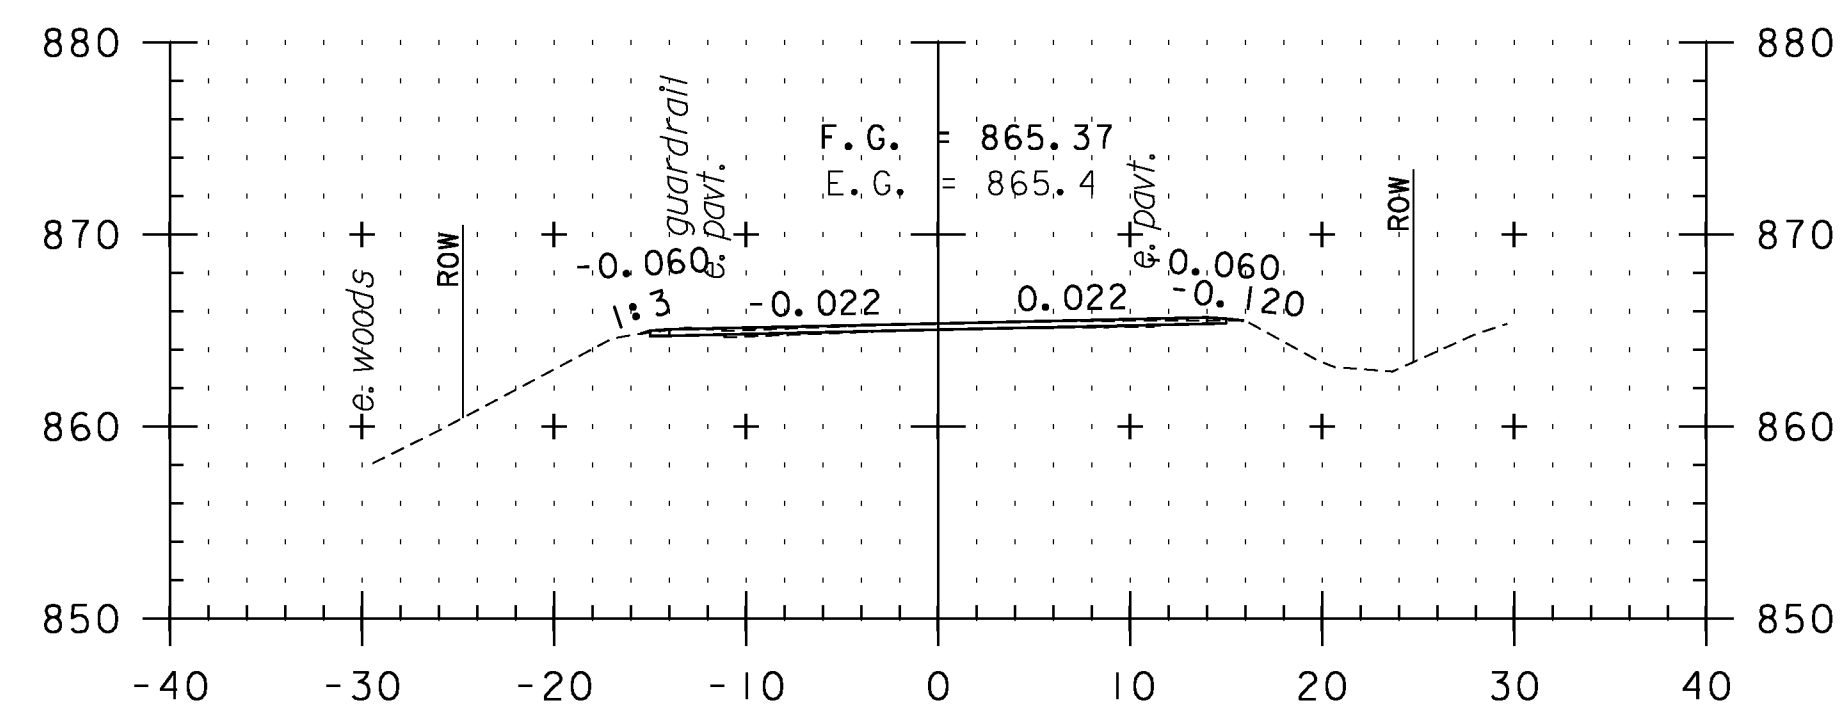


341+50

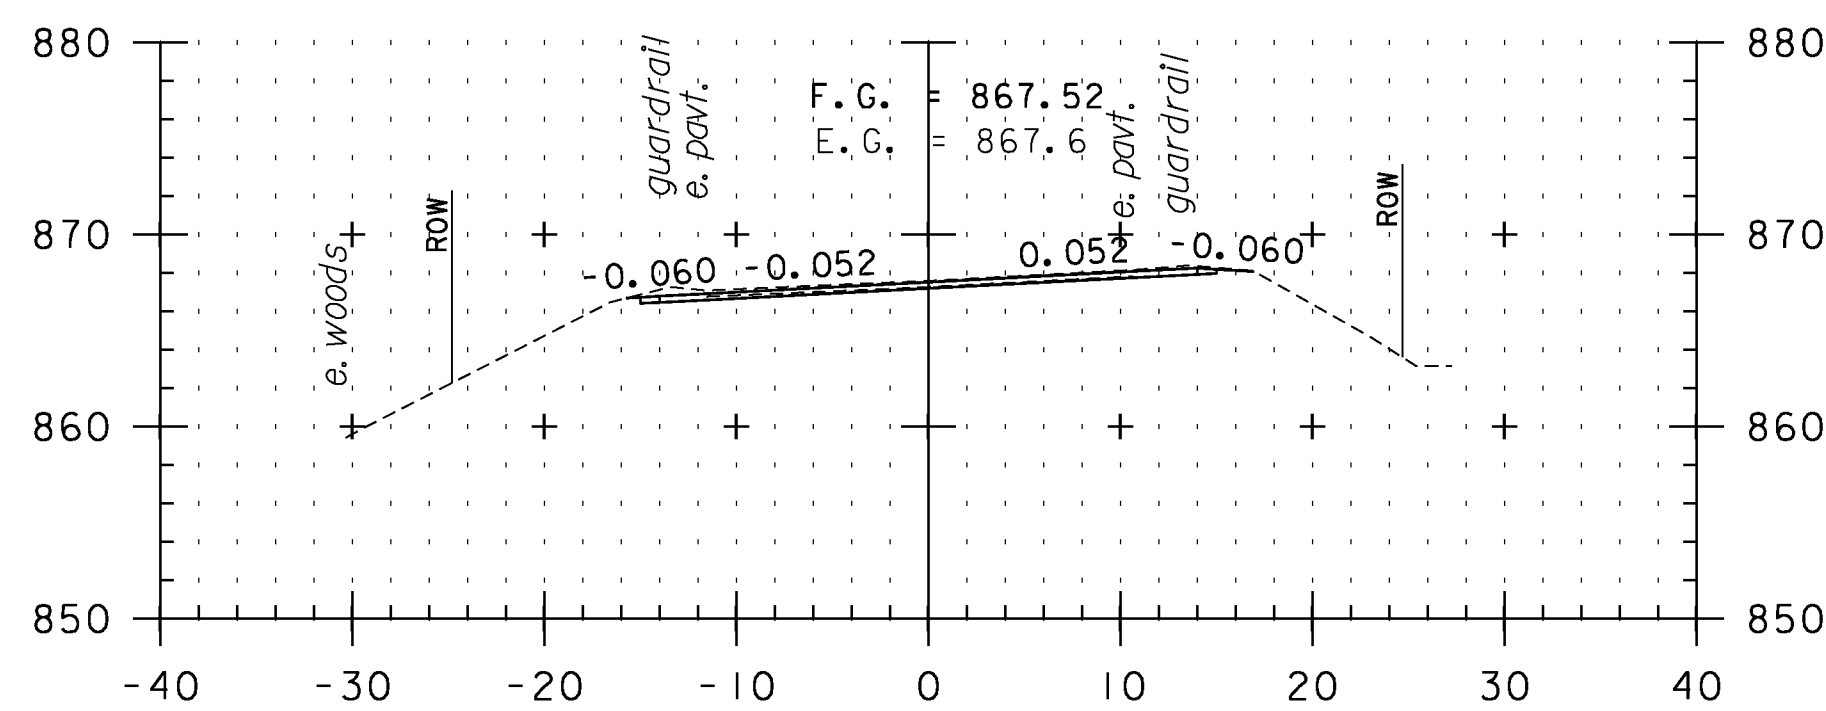


343+00

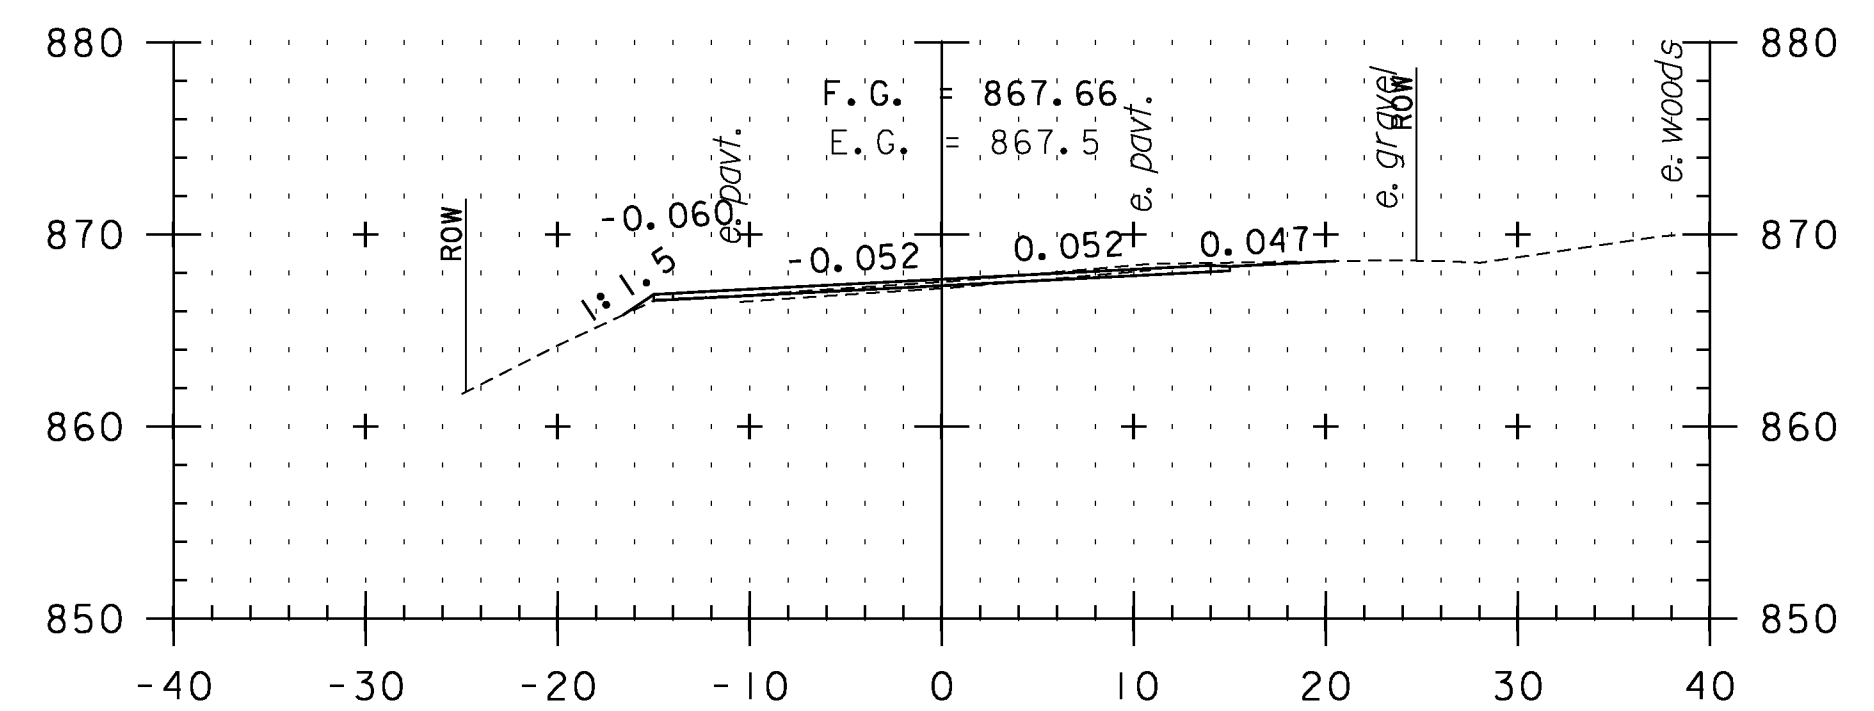


344+50

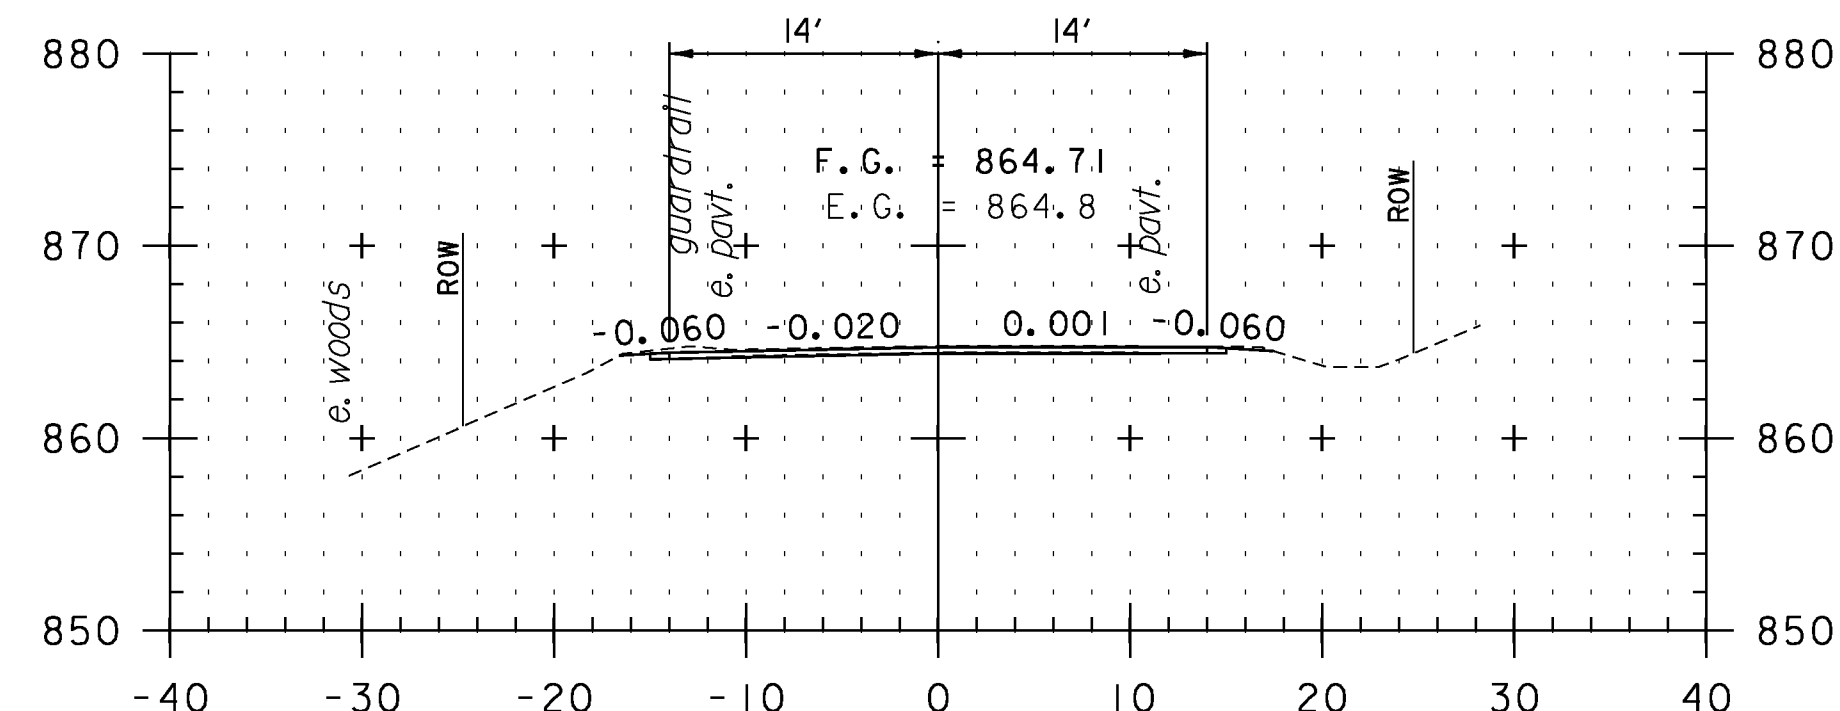

341+00

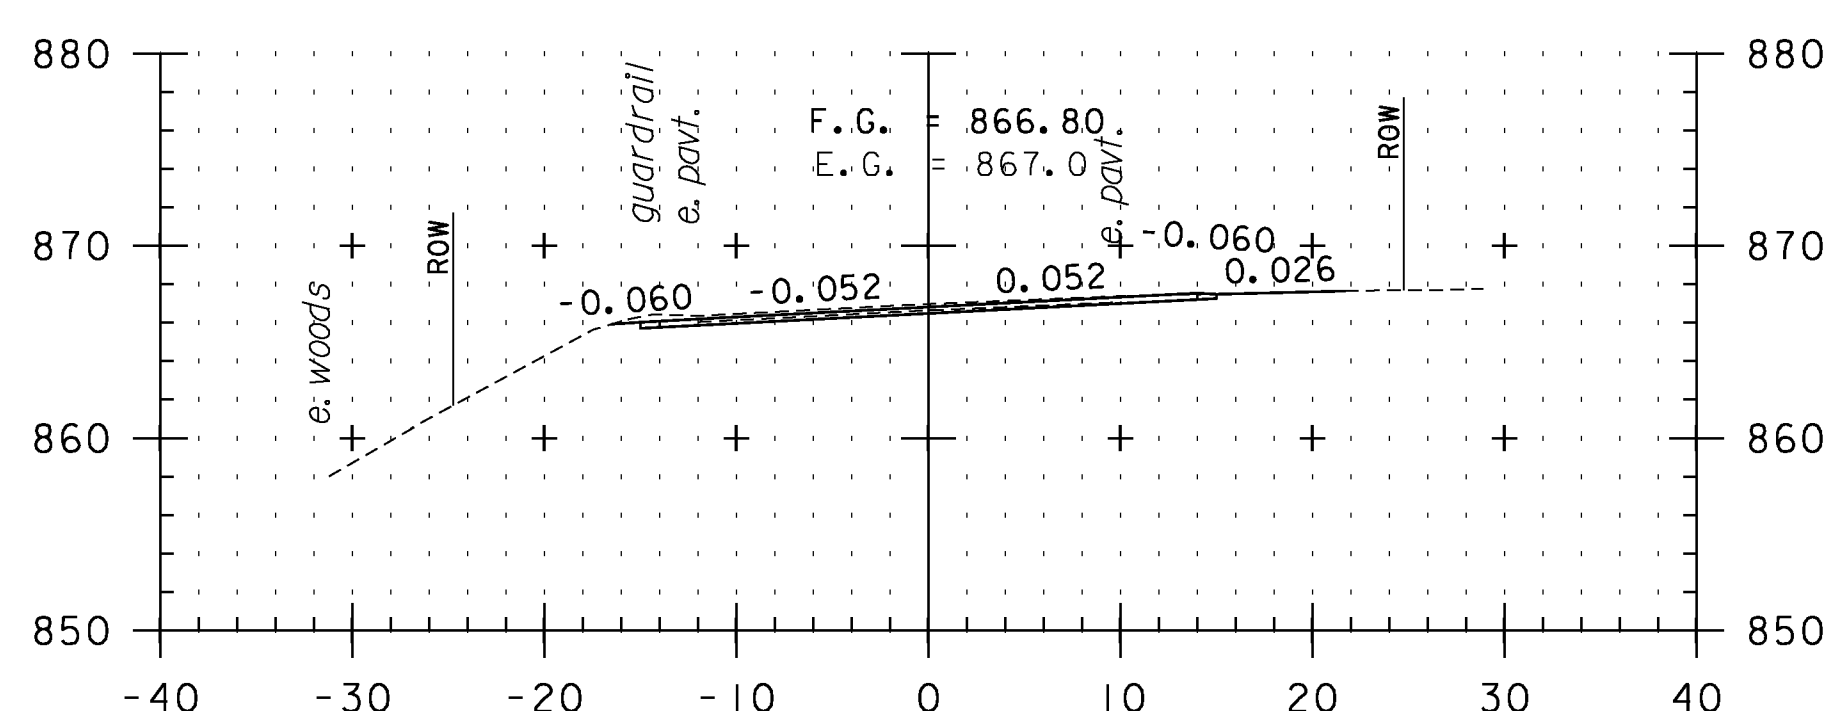

342+50

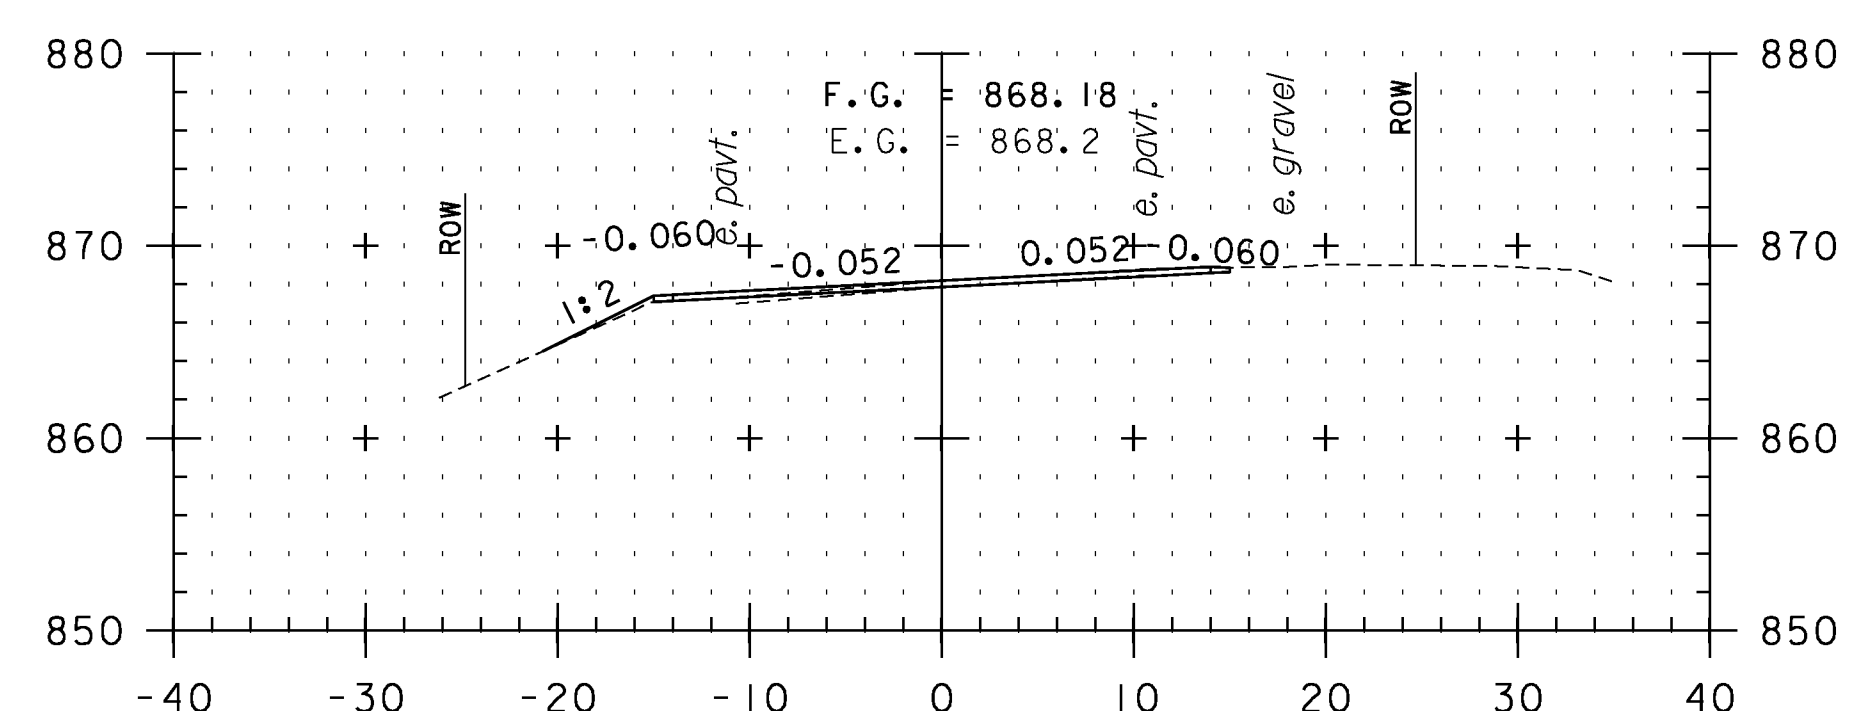

344+00

**CROSS SECTION SHEET 37**

PROJECT NAME: VERSHIRE-THETFORD

PROJECT NUMBER: STP 2911(I)

FILE NAME: pl0c224.dgn

PLOT DATE: 1/29/2013

PROJECT LEADER: PTS

DRAWN BY: SNG

DESIGNED BY: NLL

CHECKED BY: PTS

IPARM FILE NAME: IOC224\_I45

SHEET 145 OF 232

STA. 341+00 TO STA. 345+00

