




350+50

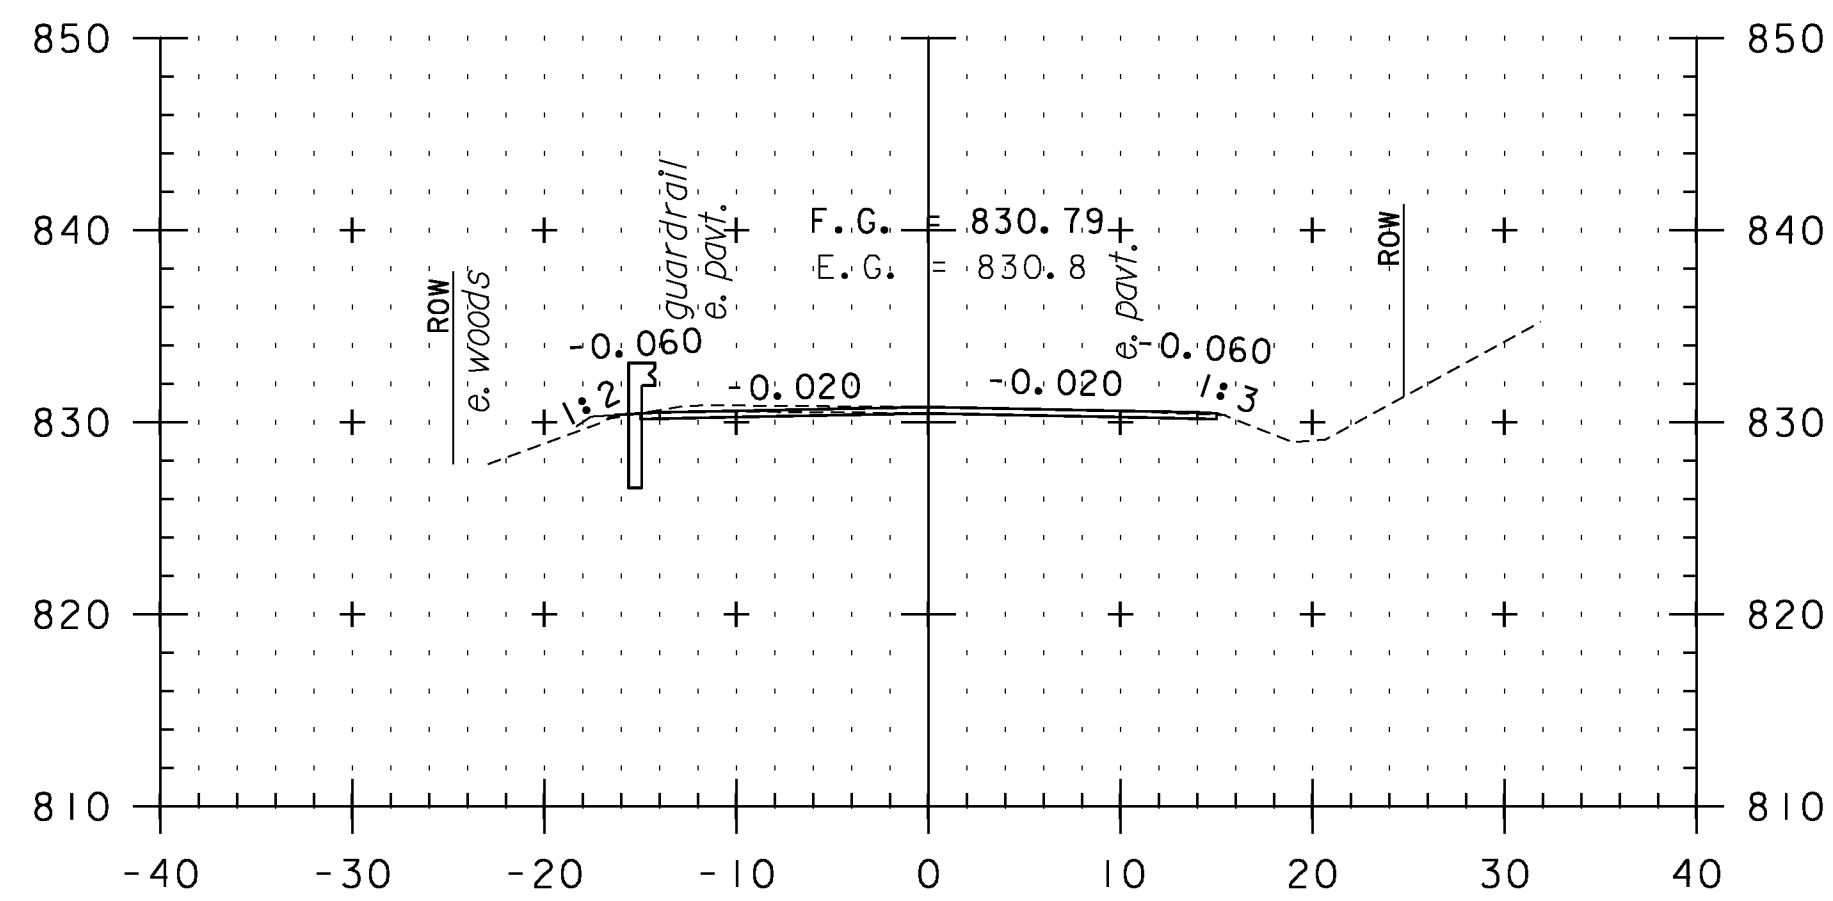


352+00

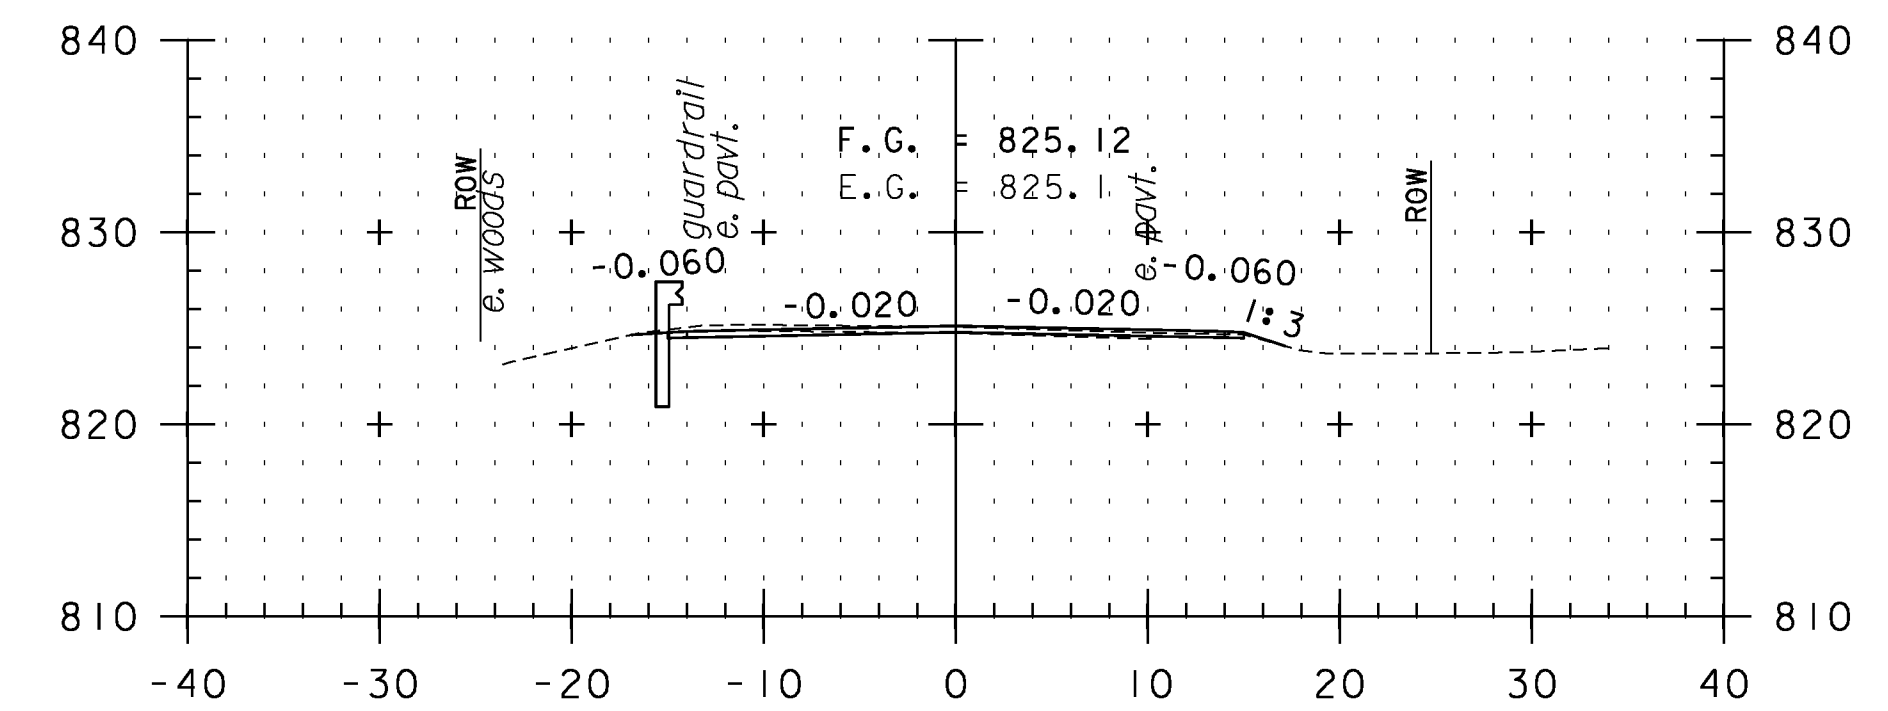


353+50

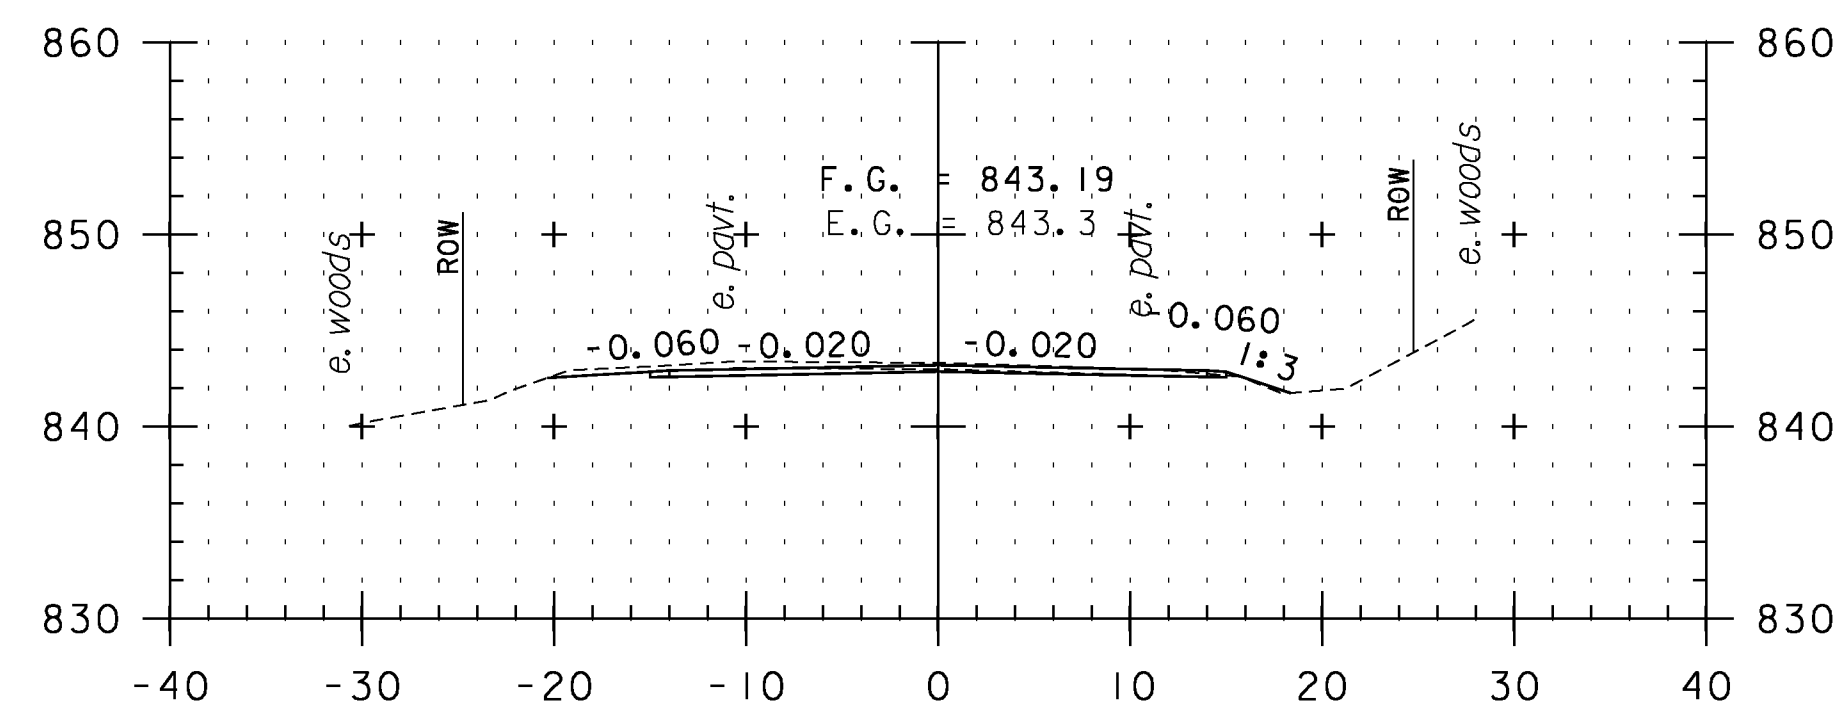


350+00

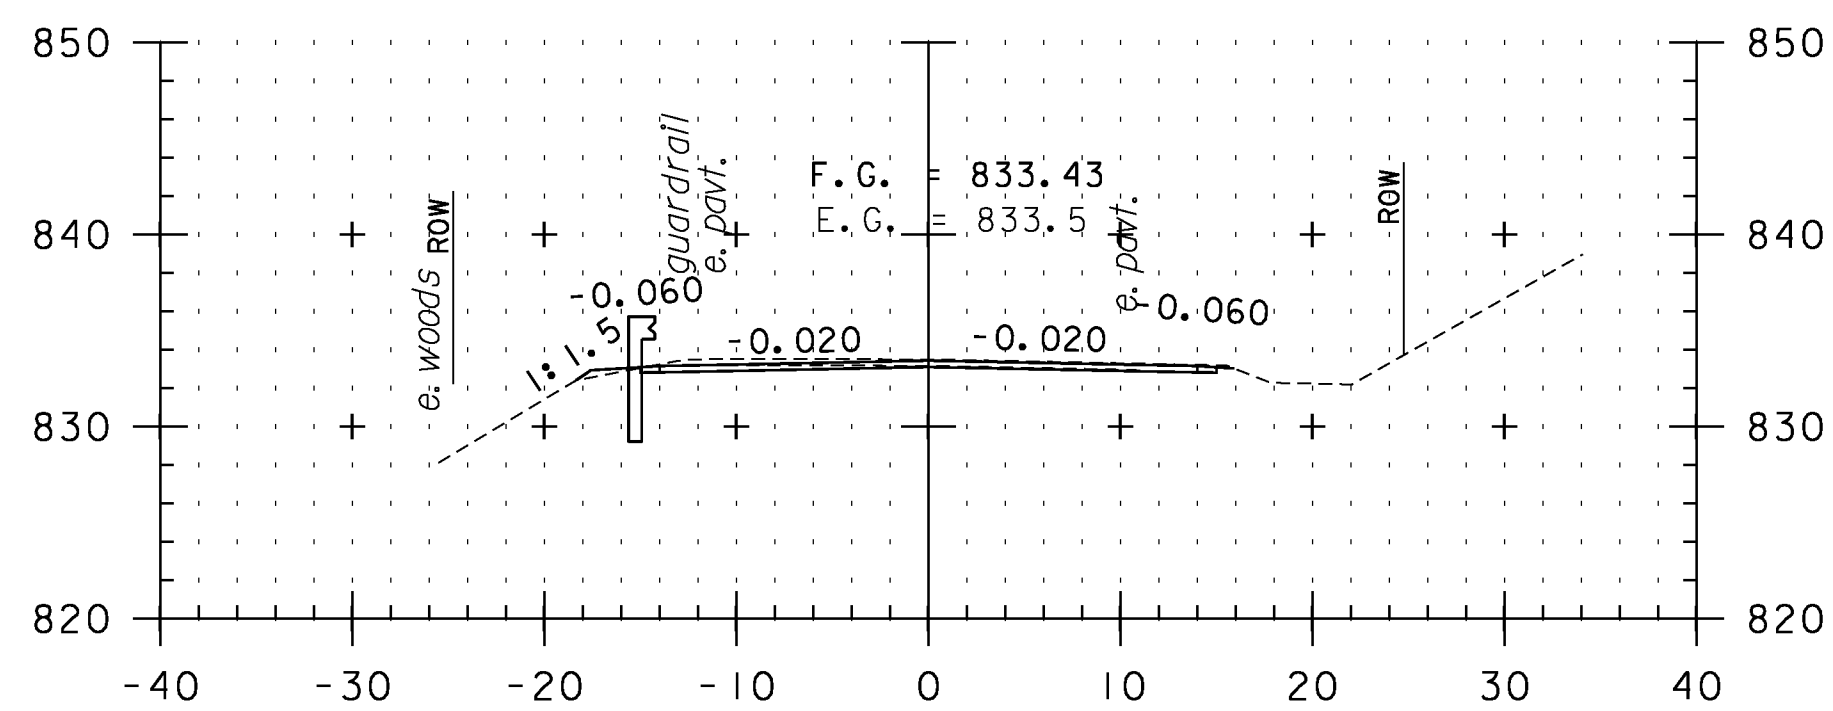


351+50

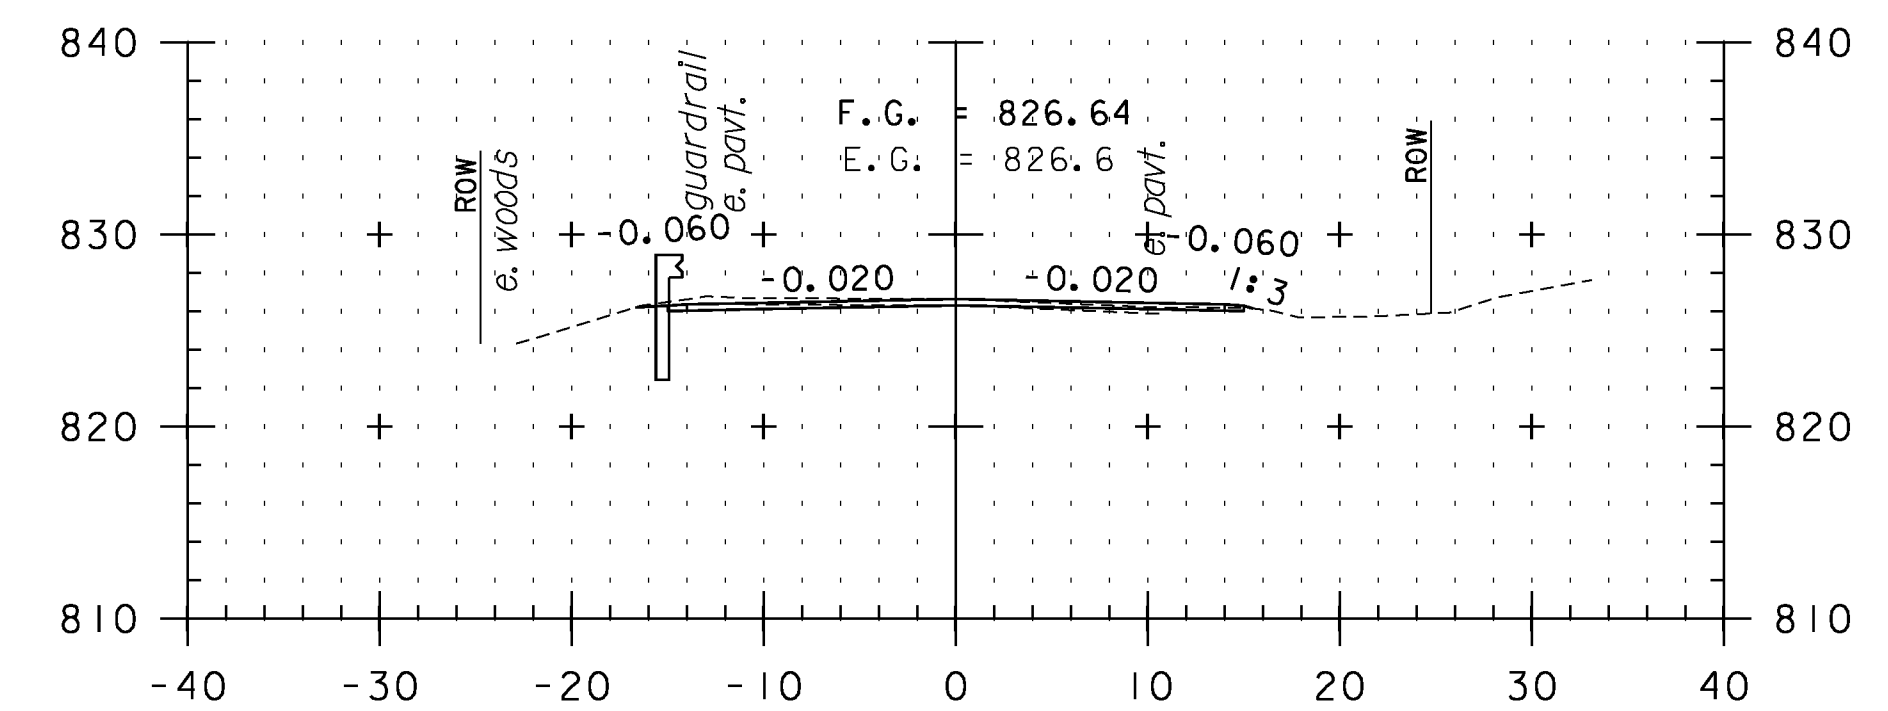


353+00

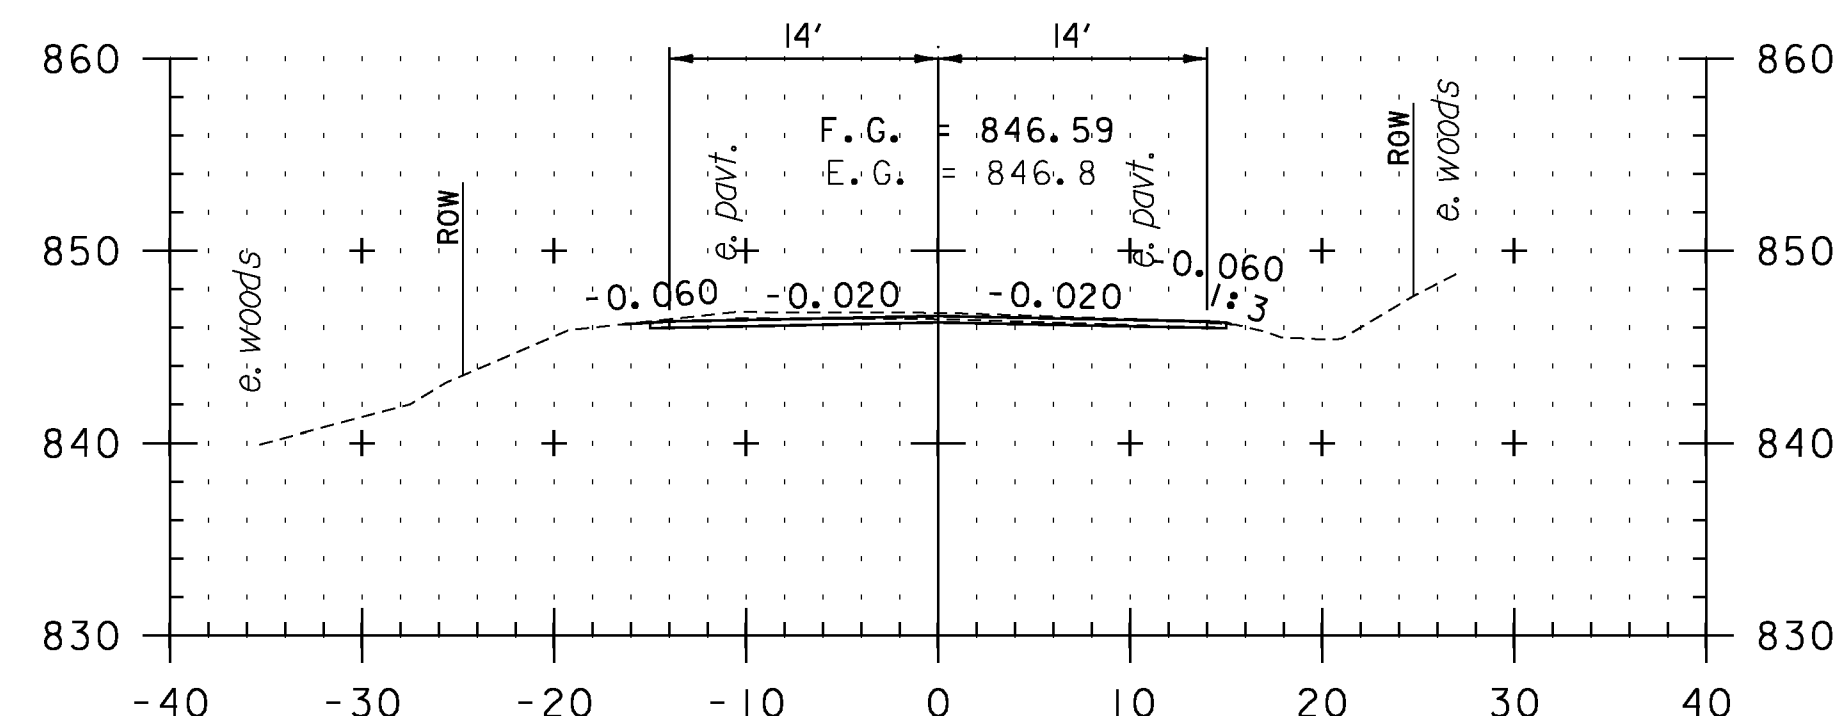

349+50

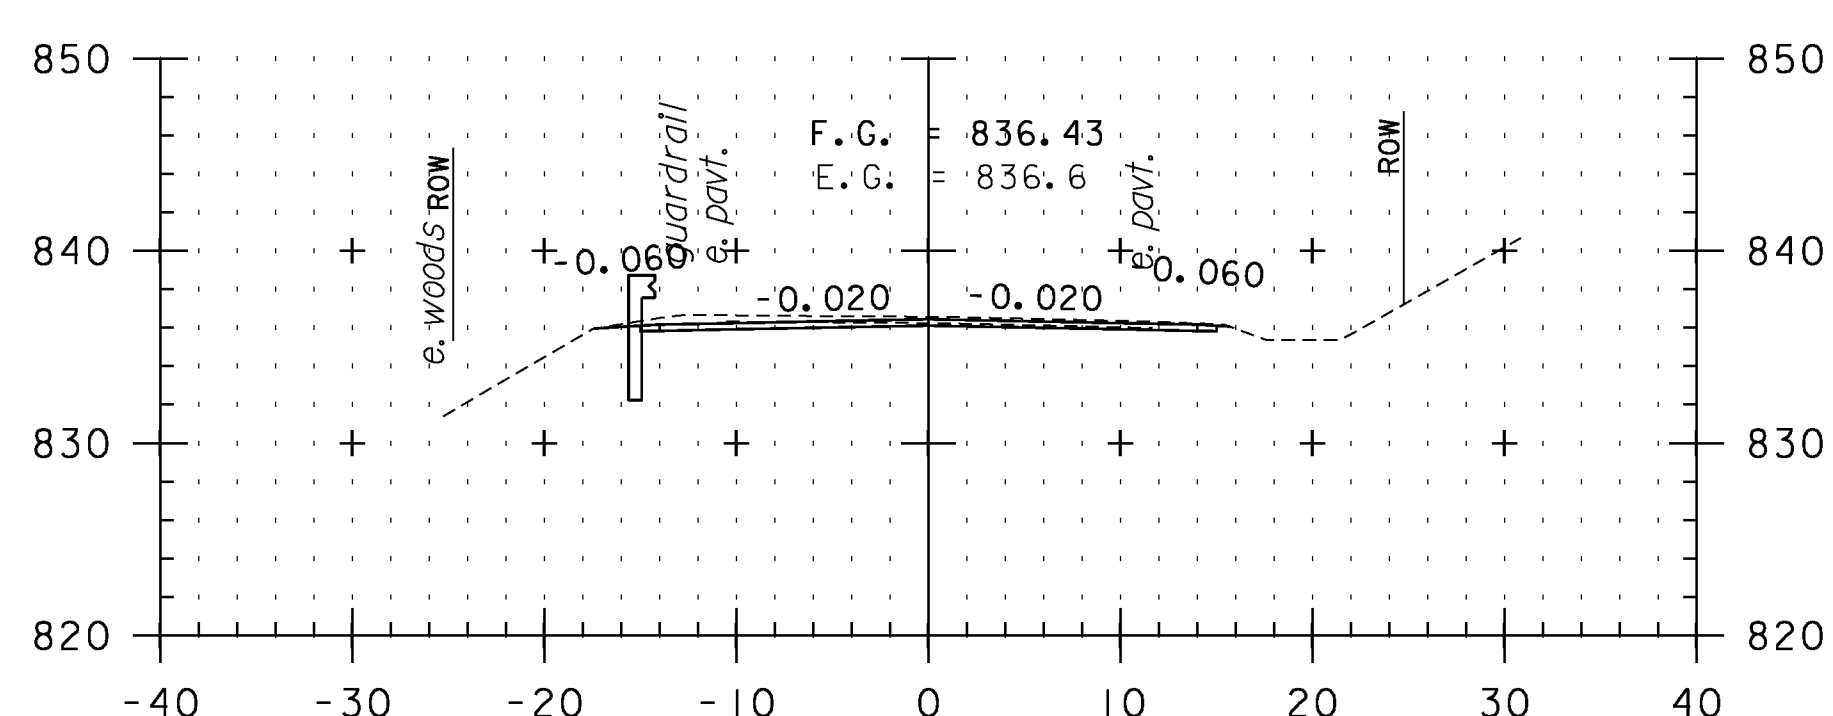


351+00

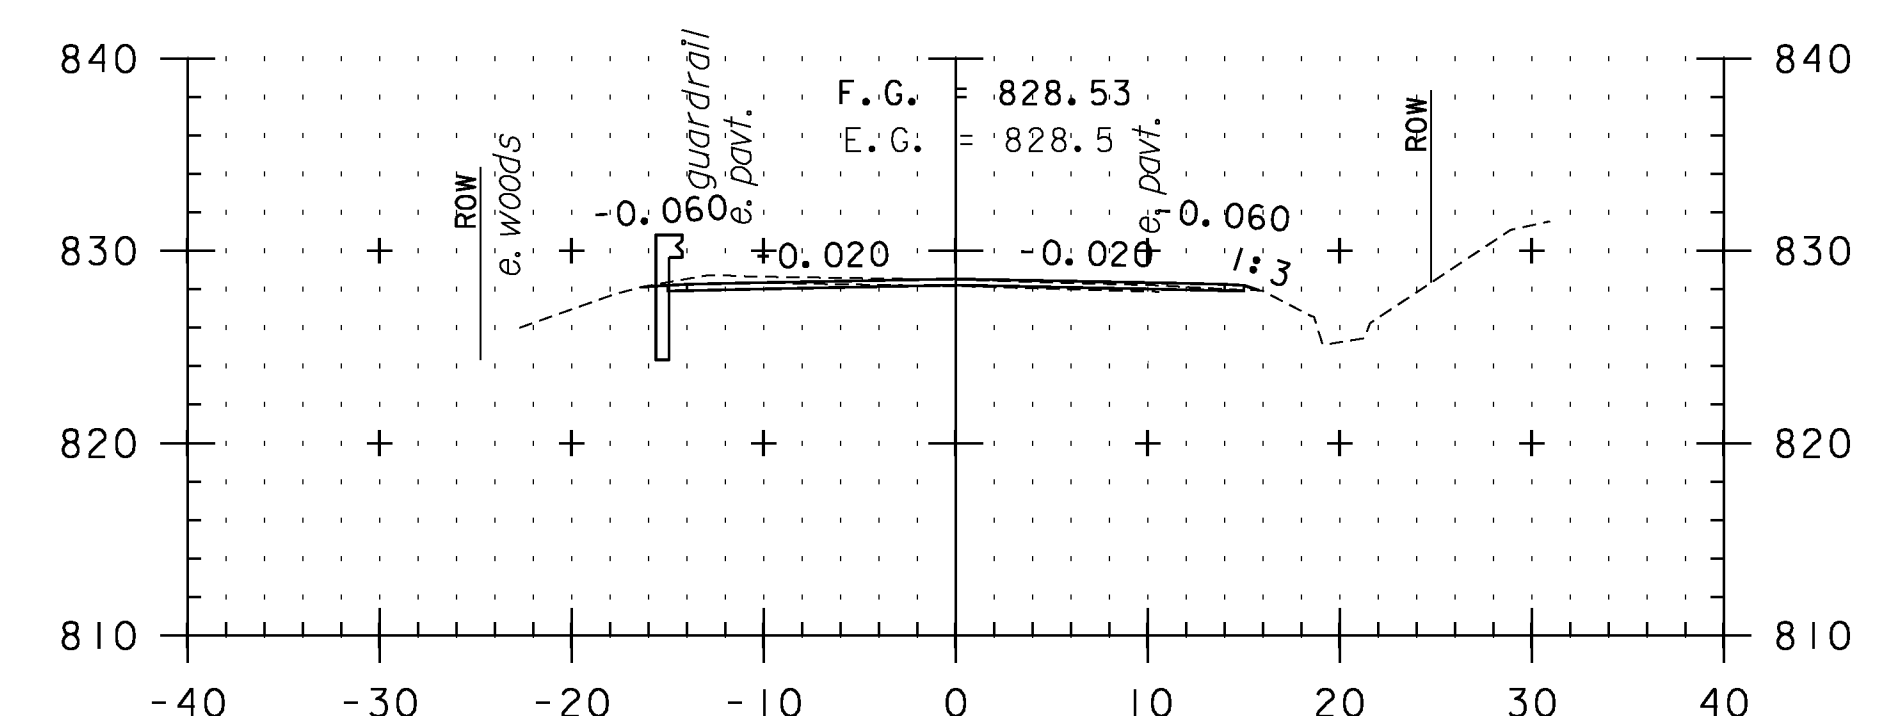

352+50

**CROSS SECTION SHEET 39**

STA. 349+50 TO STA. 353+50

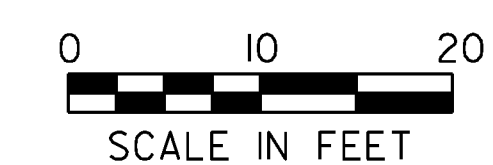

PROJECT NAME: VERSHIRE-THETFORD	PLOT DATE: 1/29/2013
PROJECT NUMBER: STP 2911(I)	DRAWN BY: SNG
FILE NAME: pl0c224.dgn	CHECKED BY: PTS
PROJECT LEADER: PTS	SHEET 147 OF 232
DESIGNED BY: NLL	
IPARM FILE NAME: IOC224_I47	