




355+00

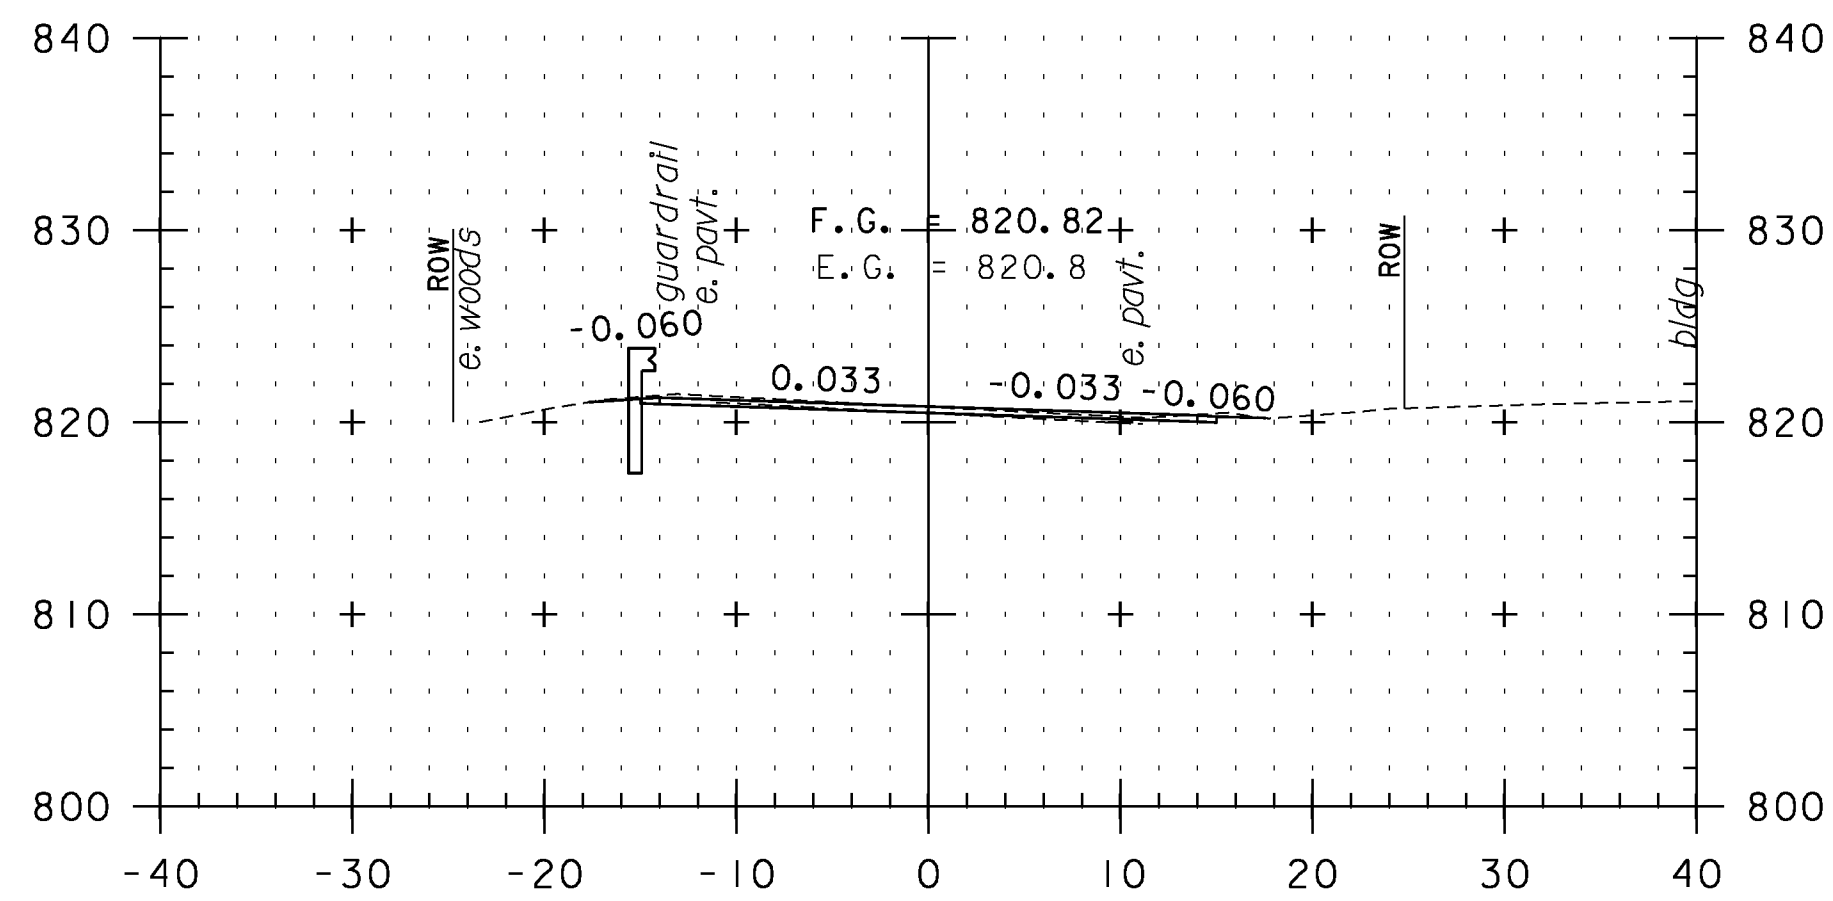


356+50

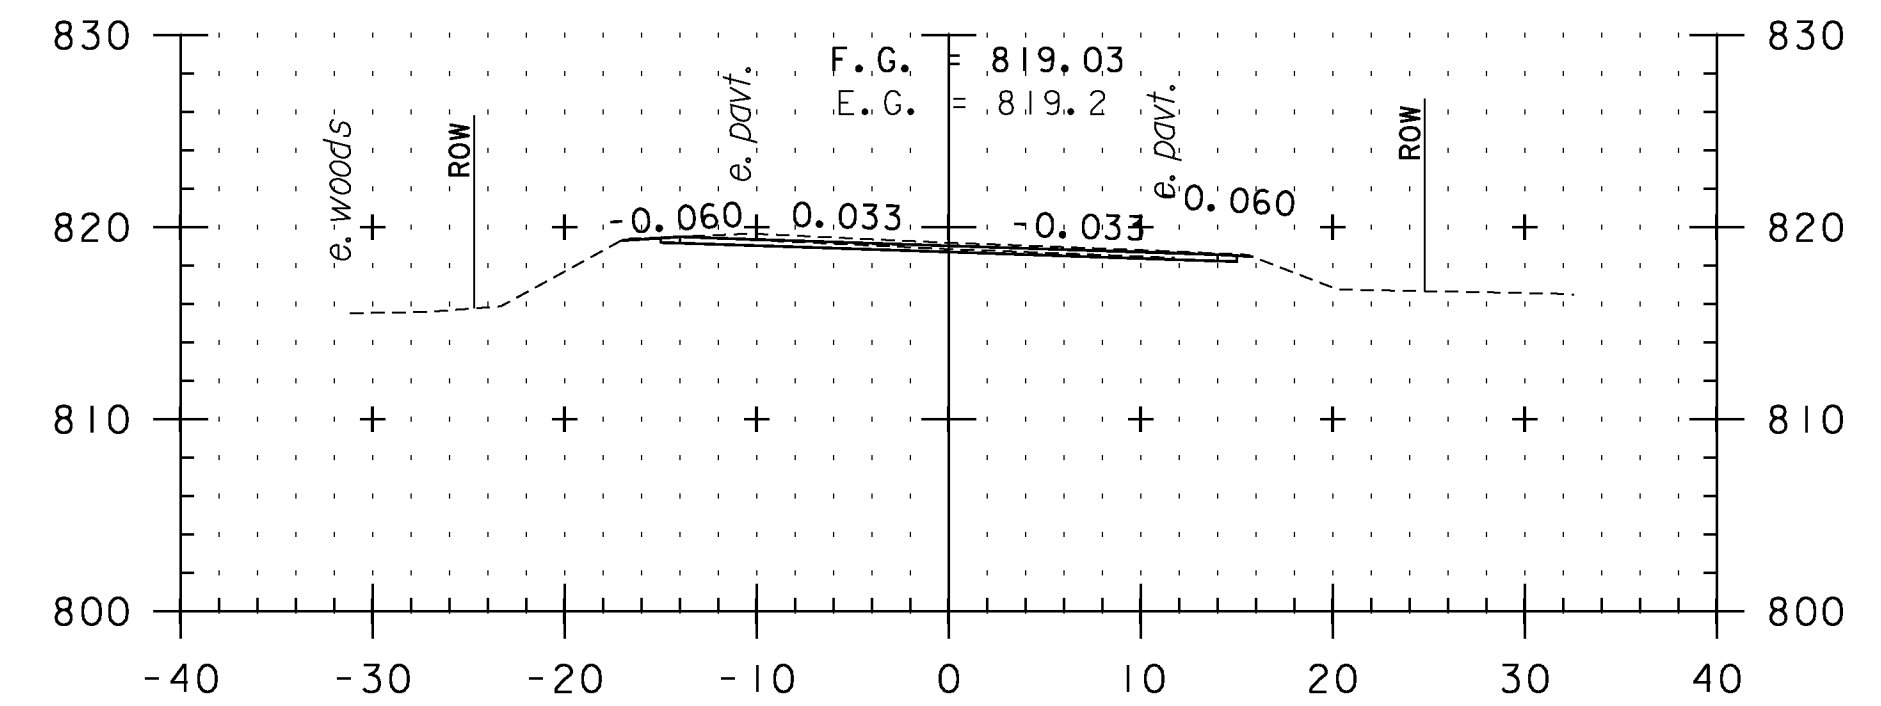


358+00

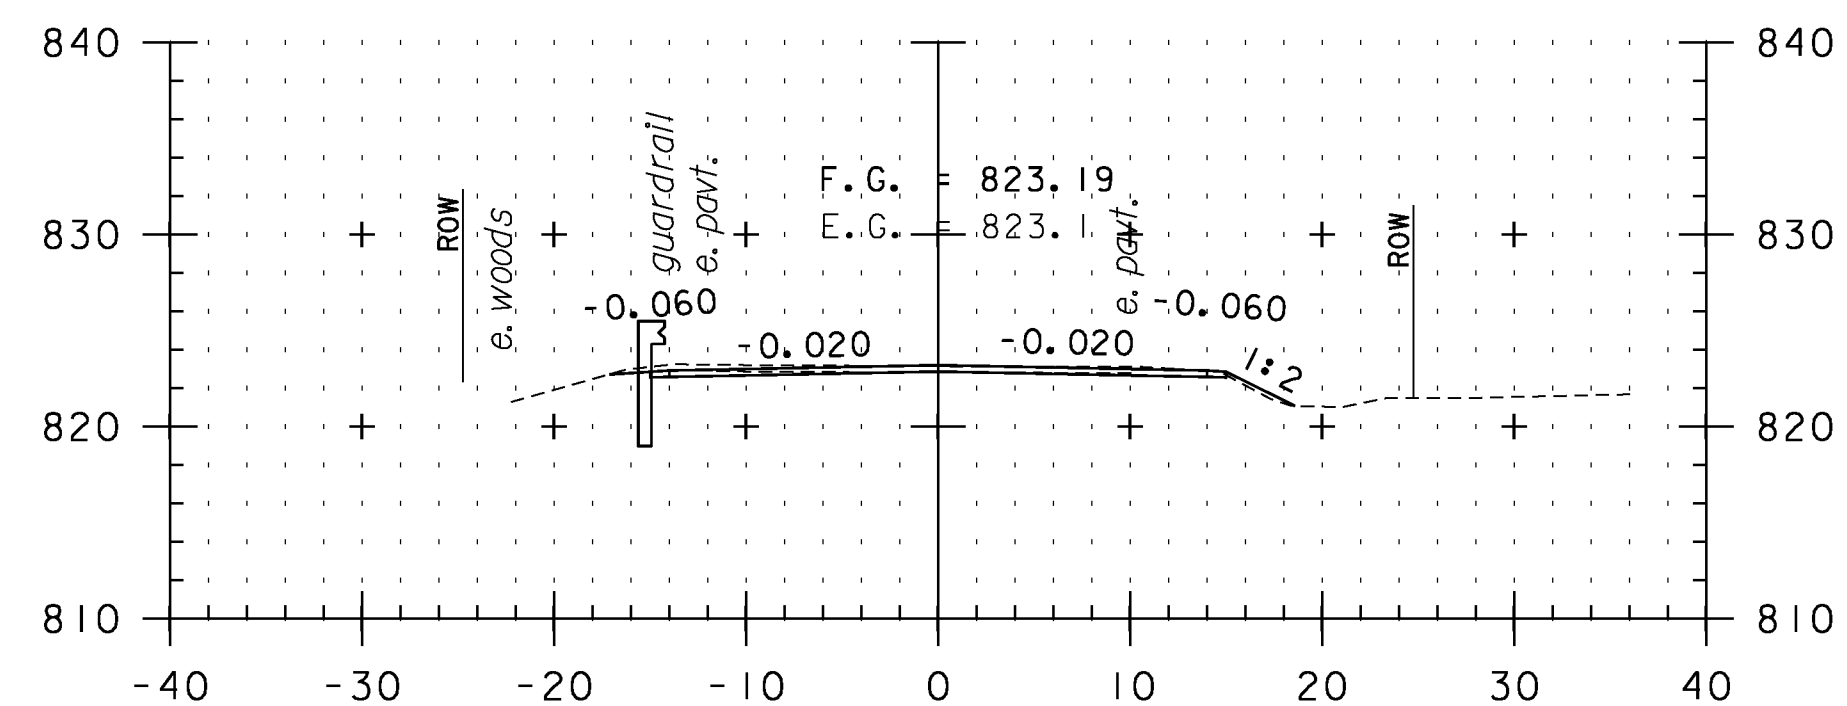


354+50

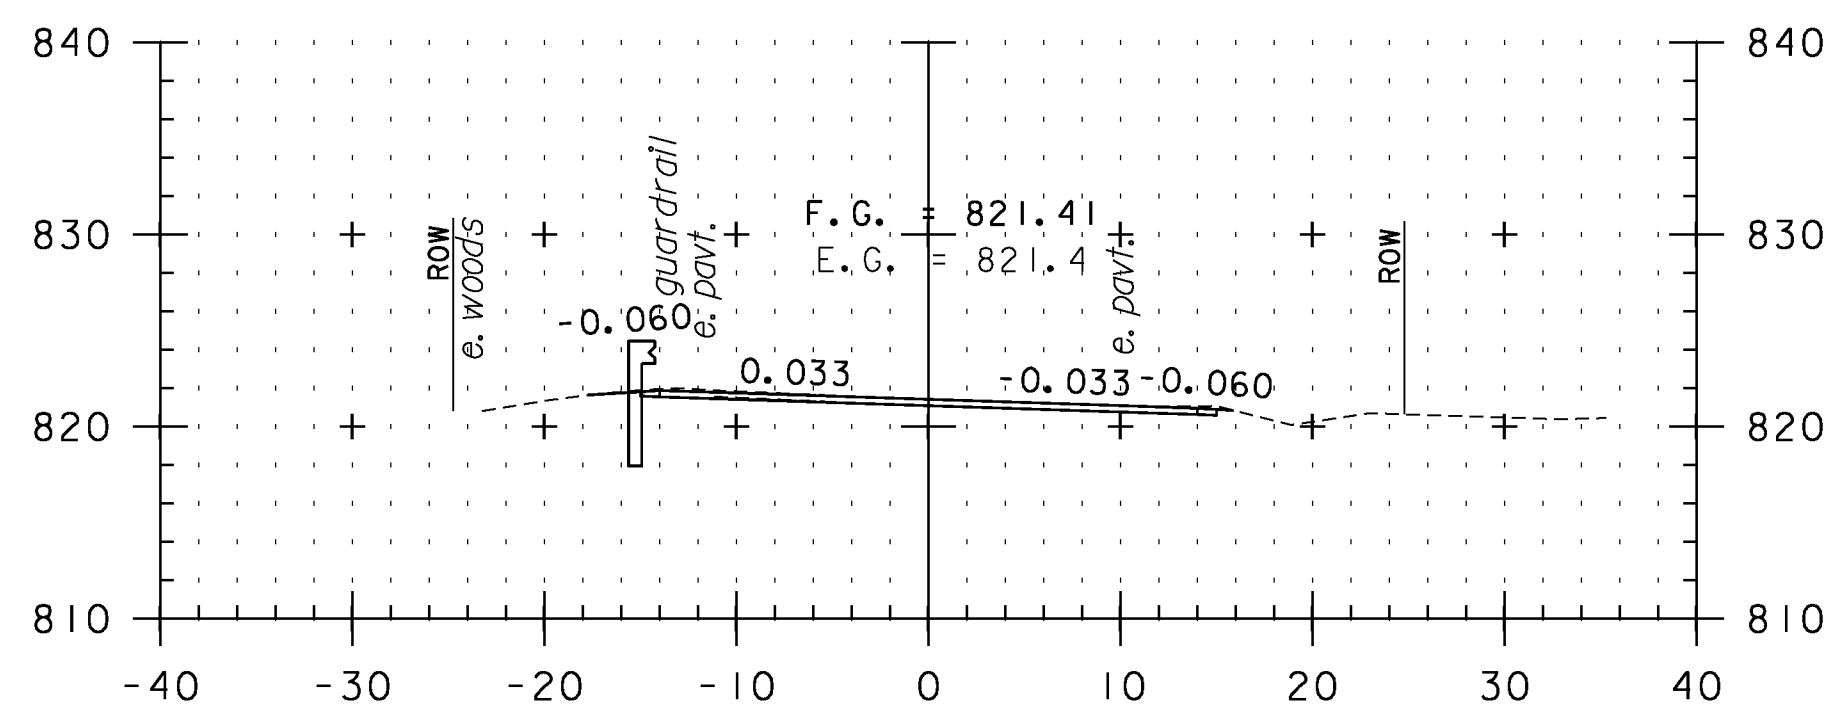


356+00

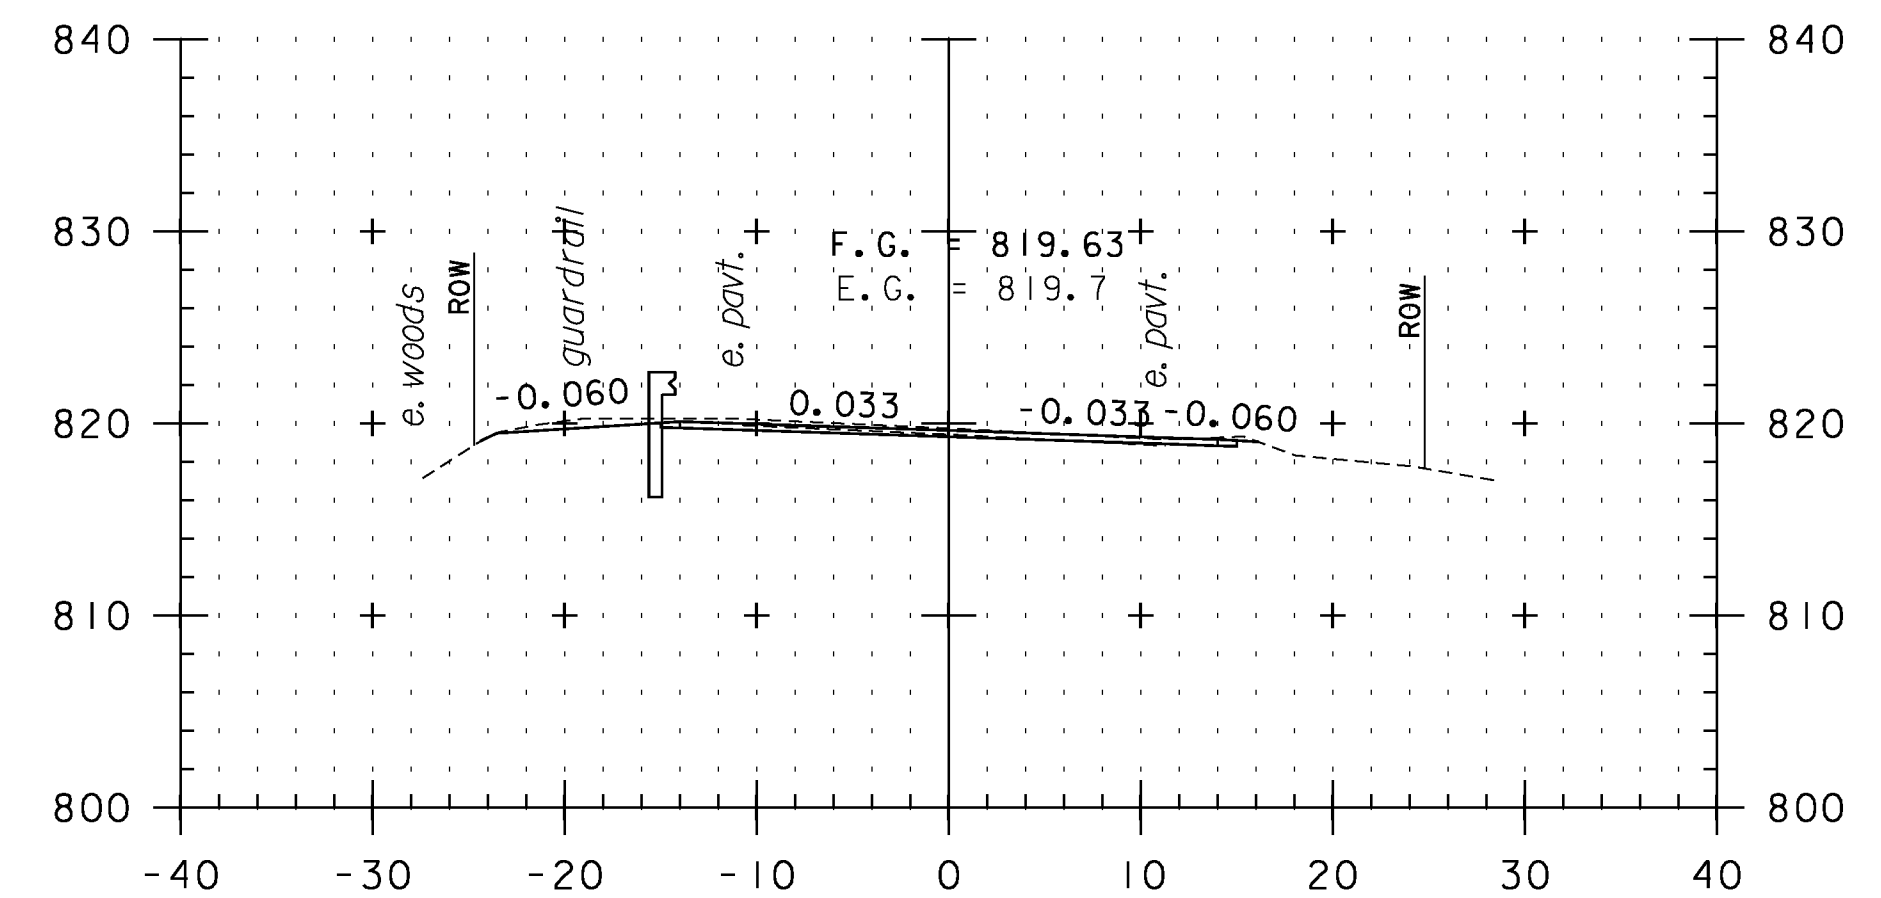


357+50

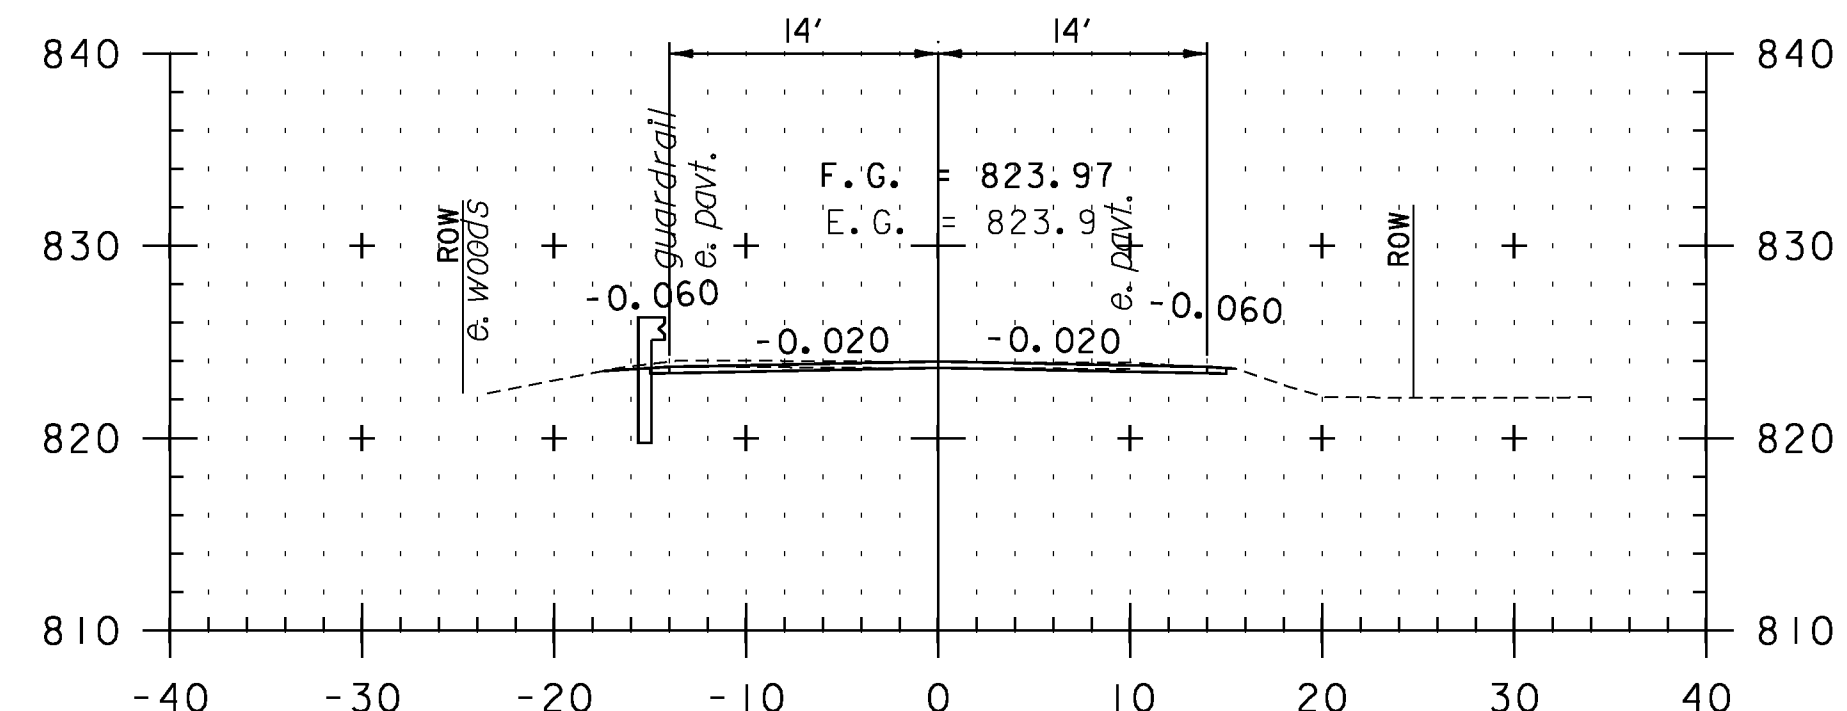

354+00

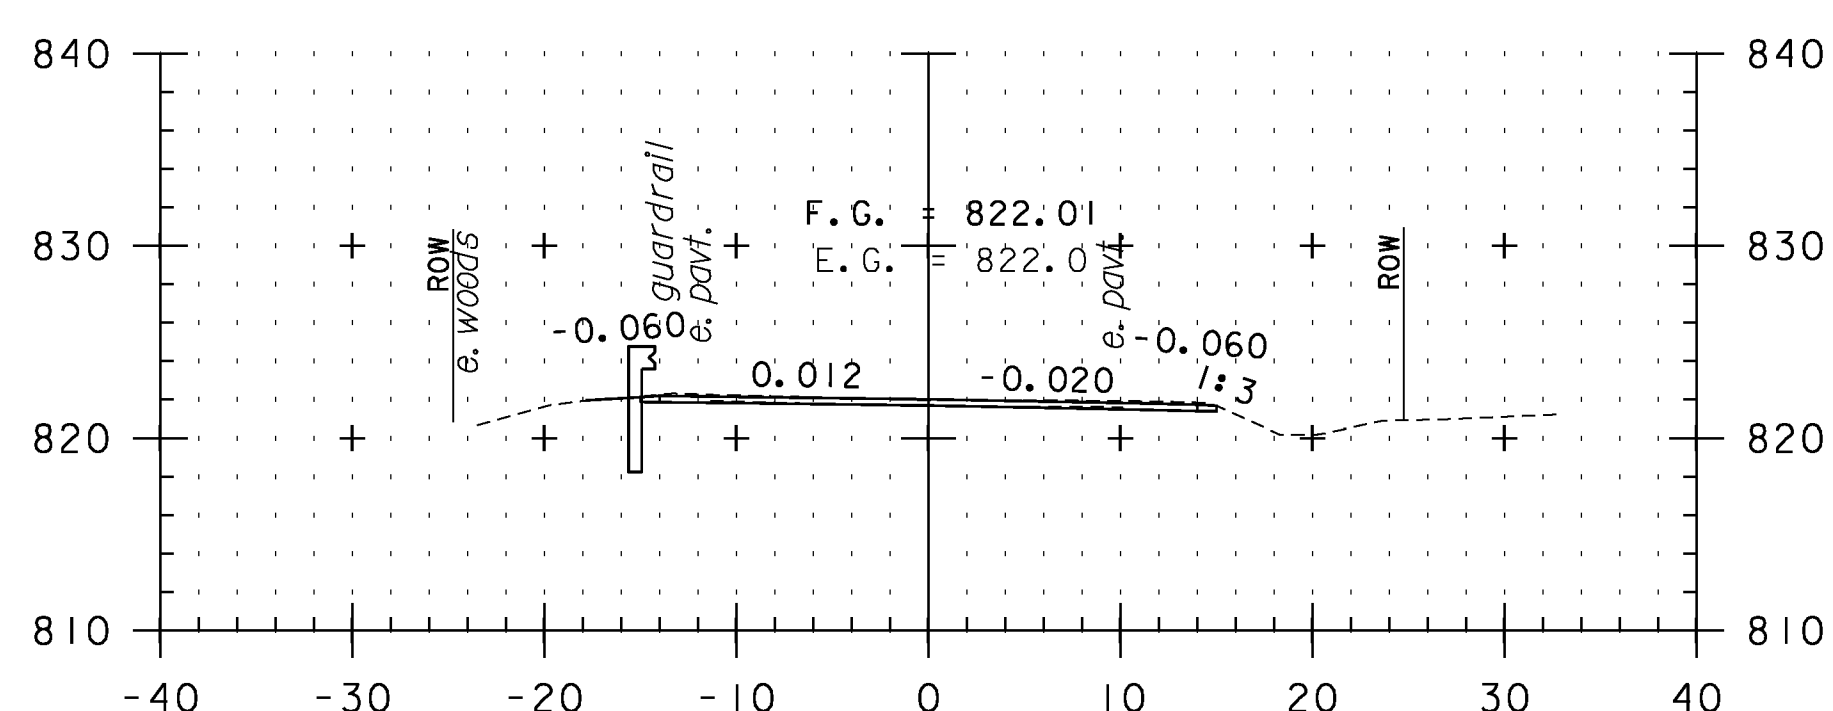

355+50

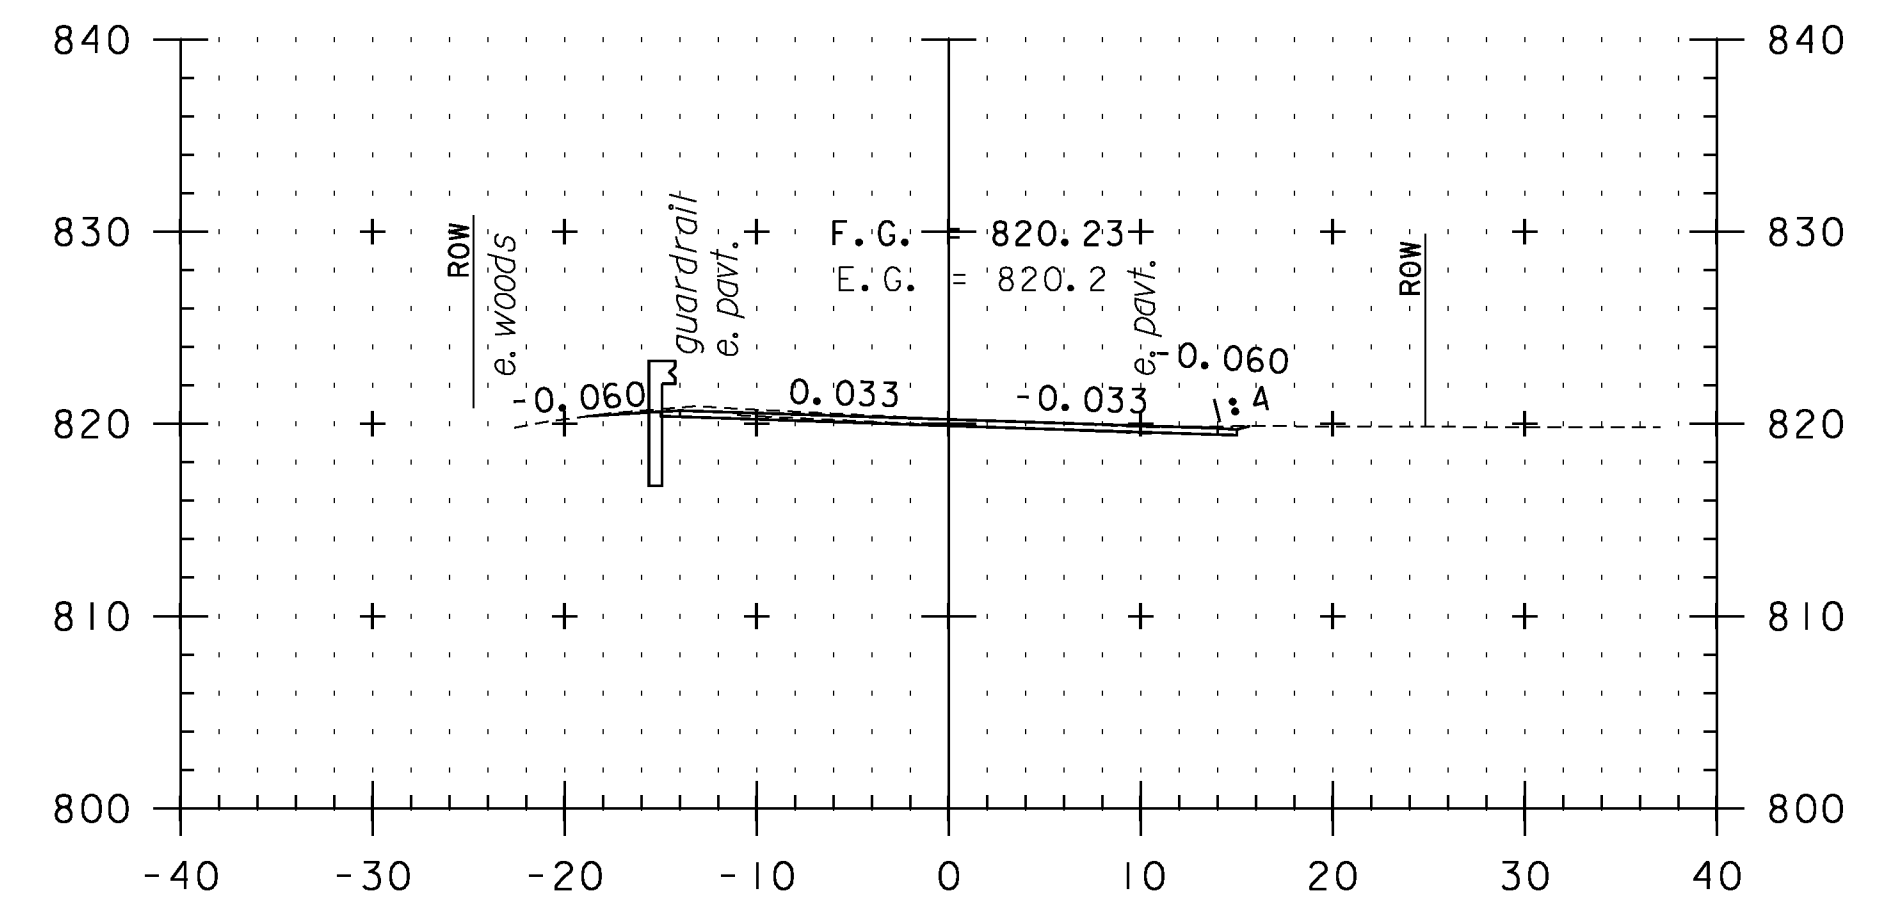

357+00

CROSS SECTION SHEET 40

PROJECT NAME: VERSHIRE-THETFORD

PROJECT NUMBER: STP 2911(I)

FILE NAME: pl0c224.dgn

PLOT DATE: 1/29/2013

PROJECT LEADER: PTS

DRAWN BY: SNG

DESIGNED BY: NLL

CHECKED BY: PTS

IPARM FILE NAME: IOC224_I48

SHEET 148 OF 232

STA. 354+00 TO STA. 358+00

