




359+50

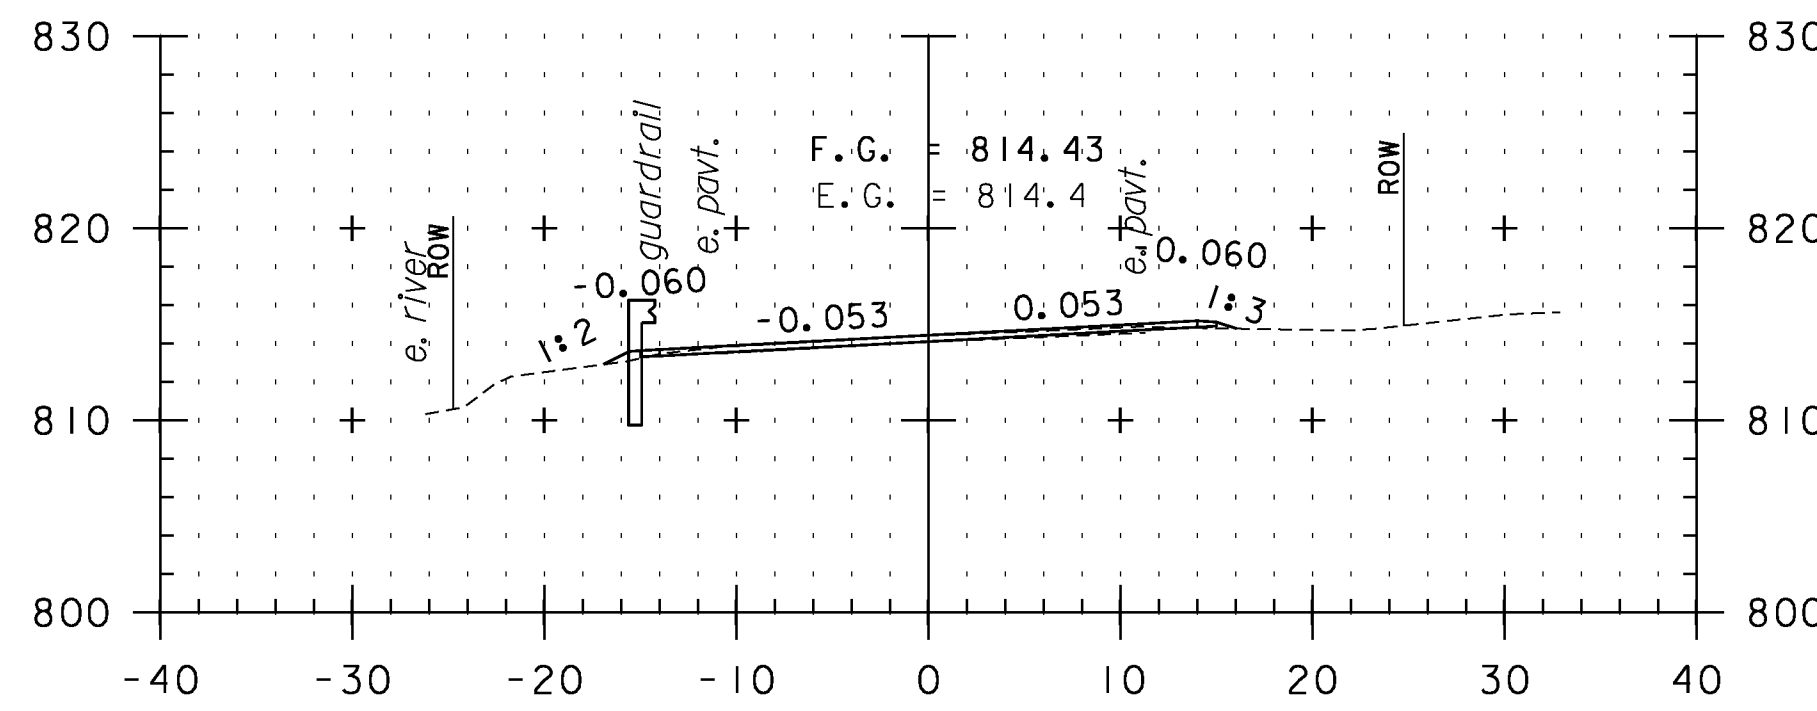


361+00

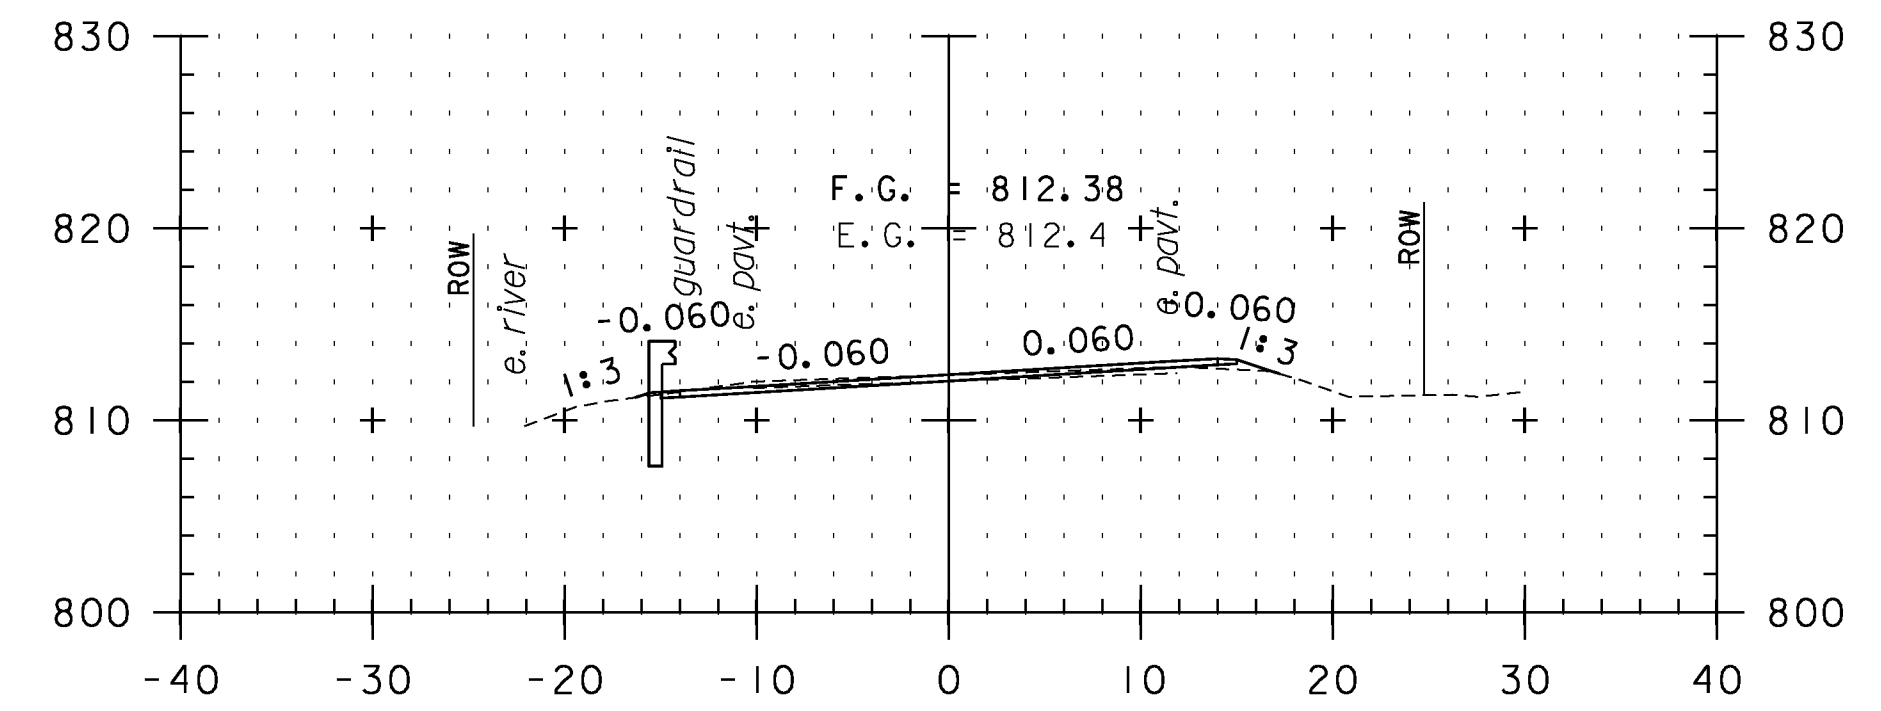


362+50

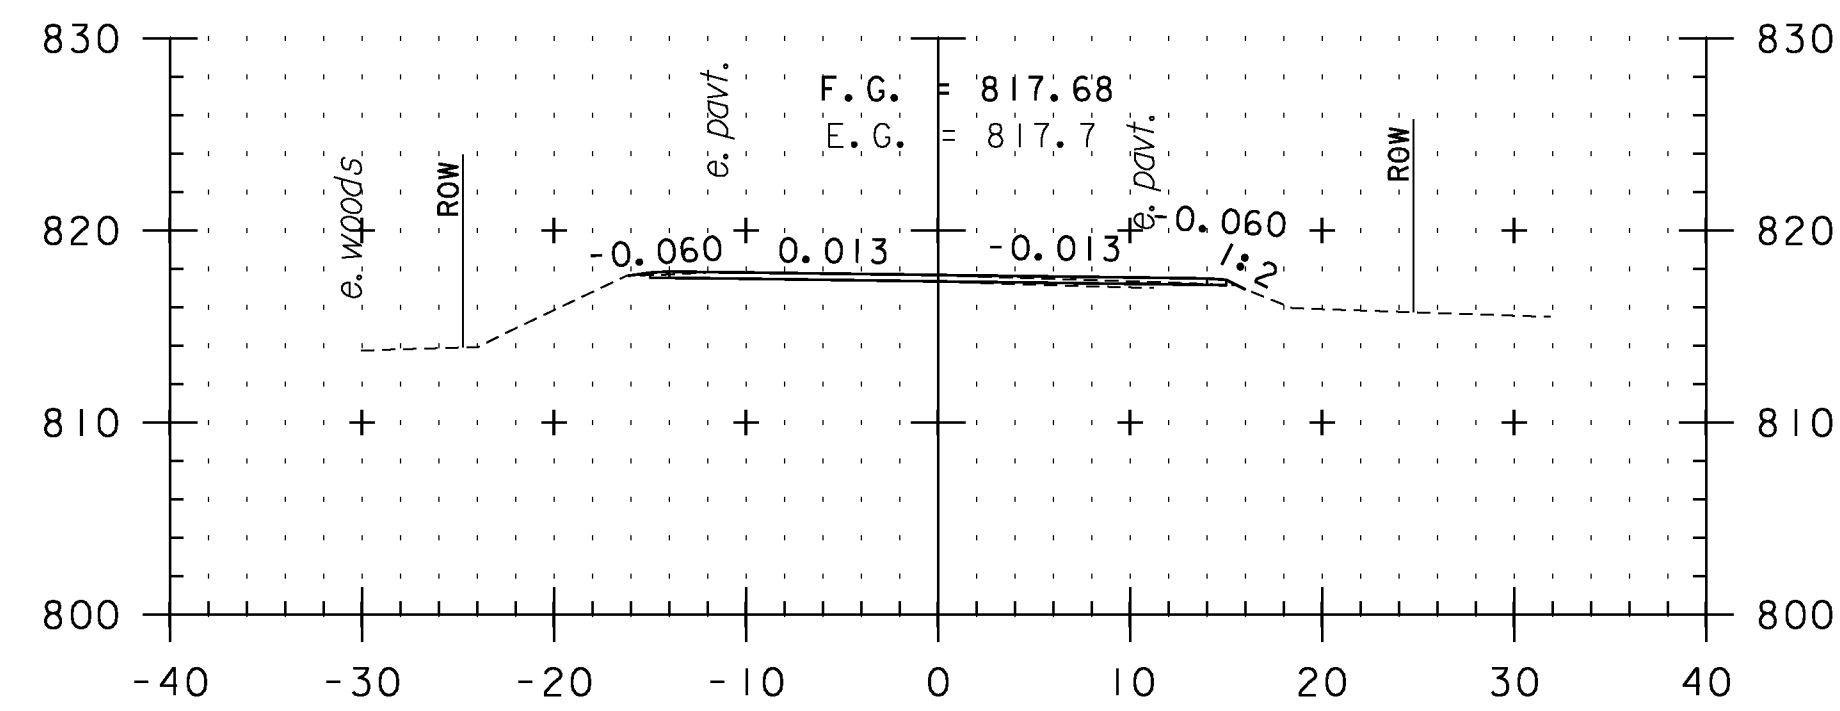


359+00

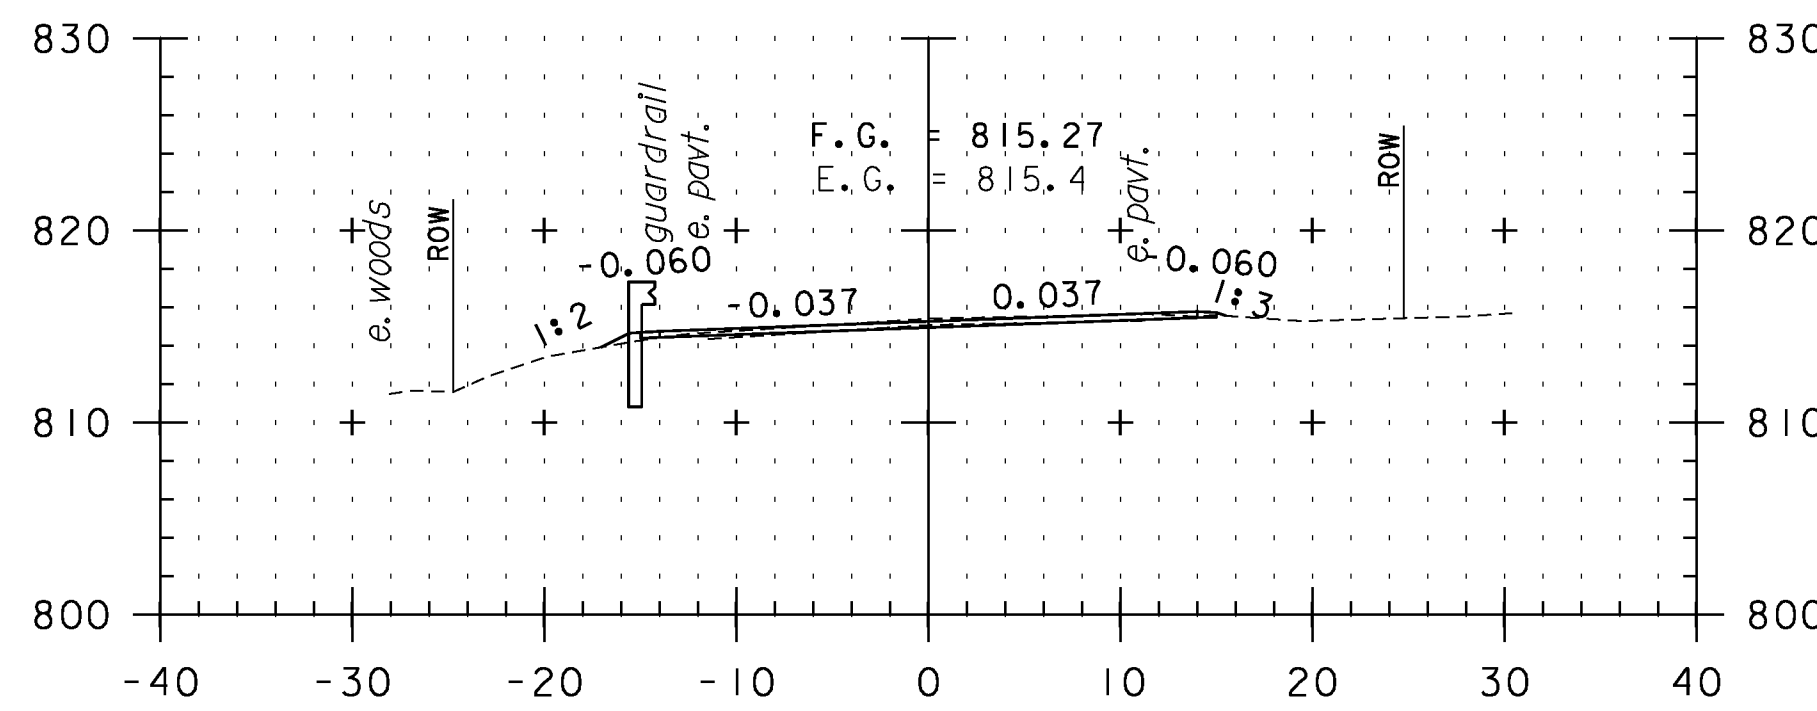


360+50

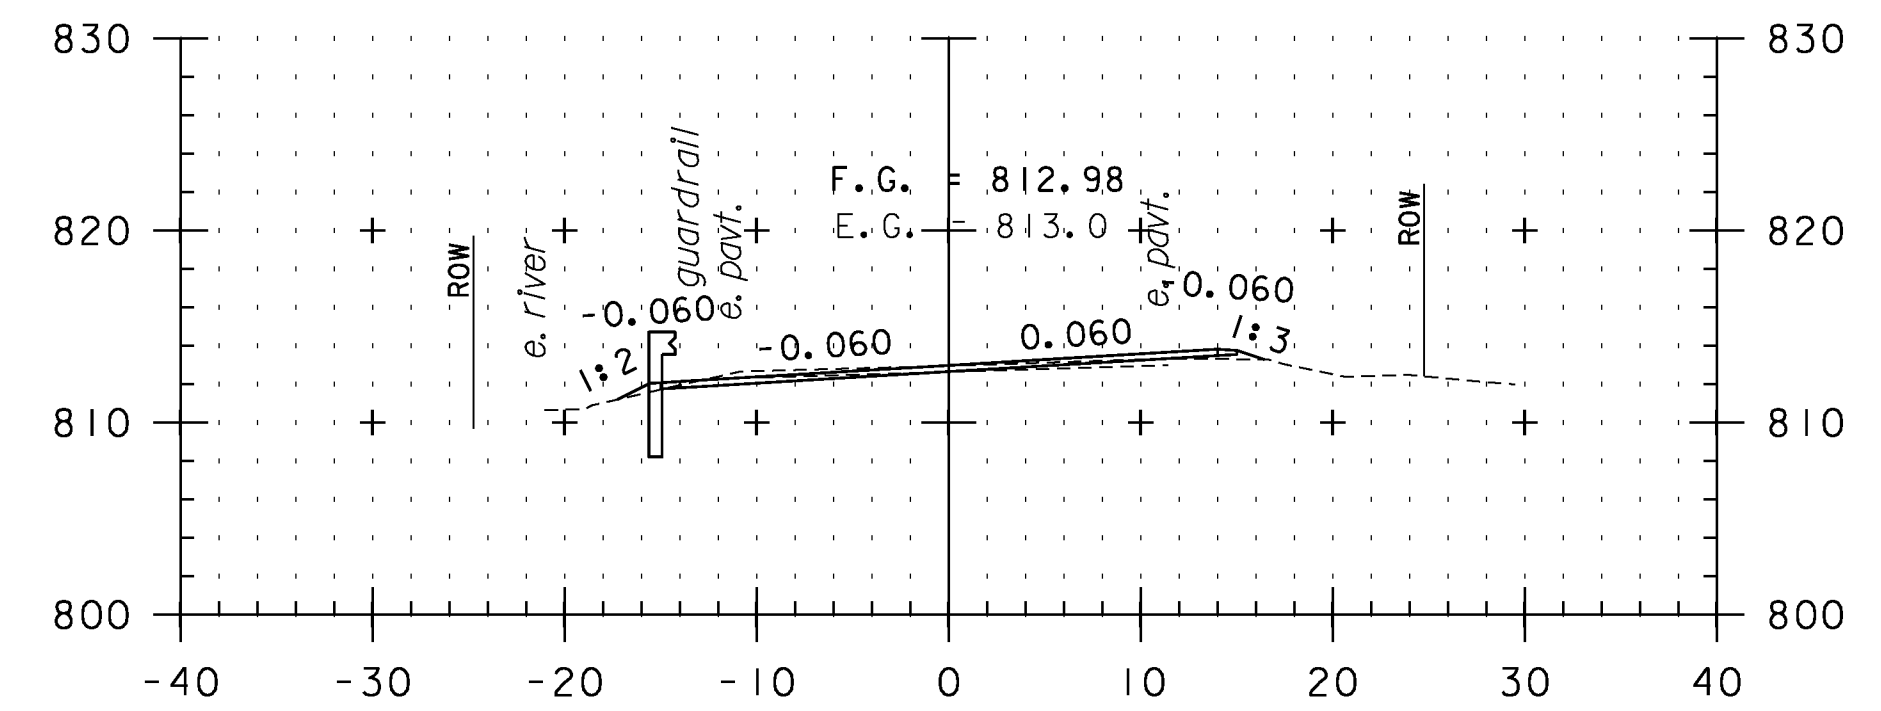


362+00

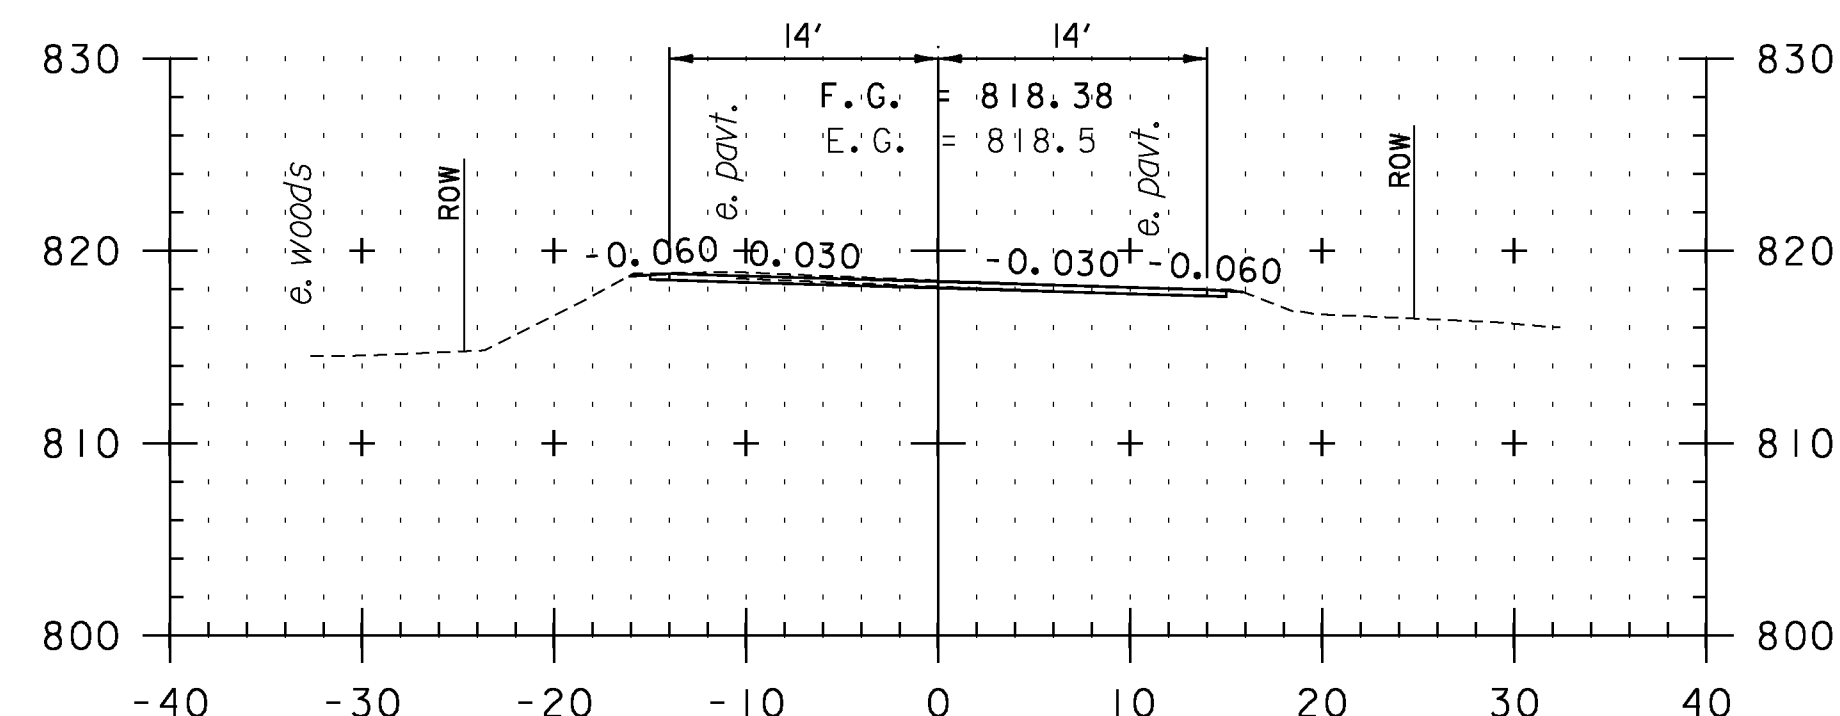

358+50

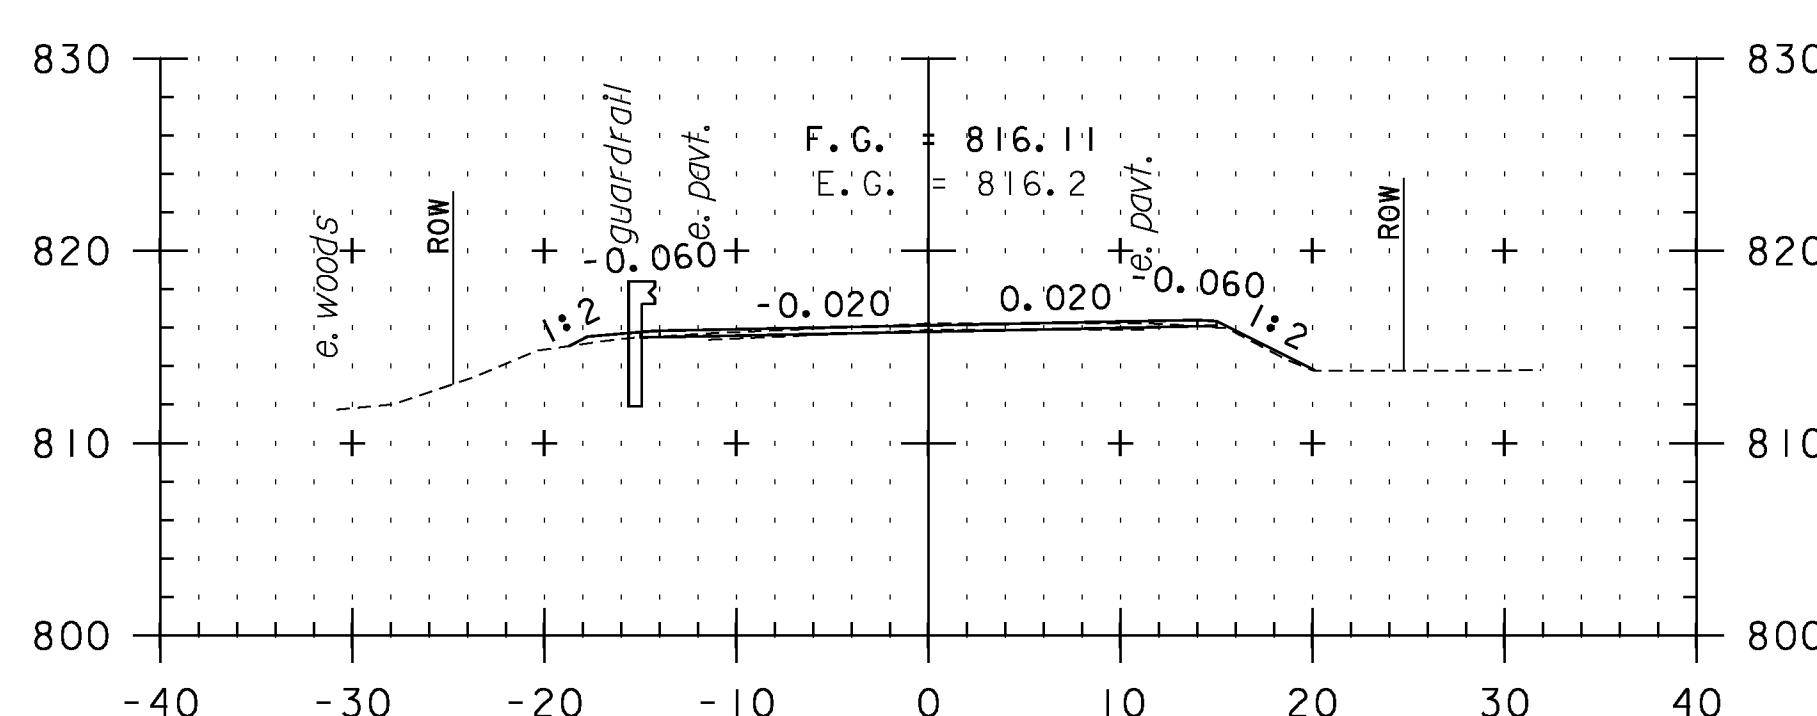


360+00

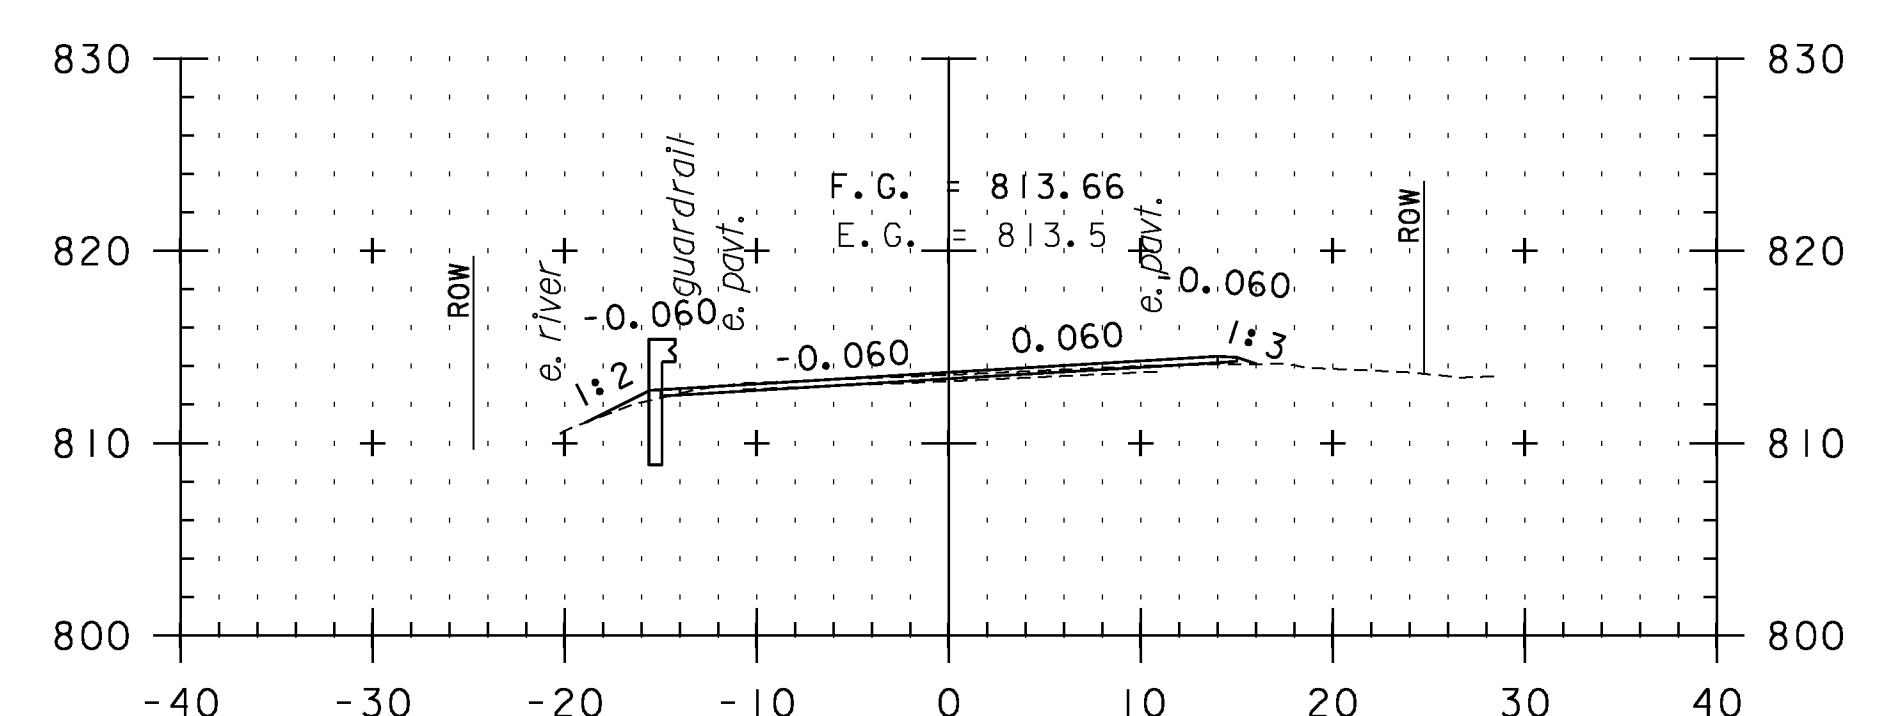

361+50

**CROSS SECTION SHEET 41**

STA. 358+50 TO STA. 362+50

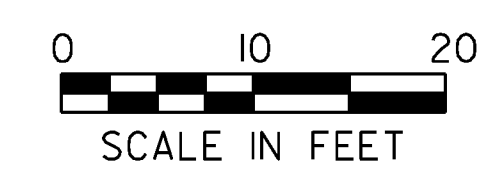

PROJECT NAME: VERSHIRE-THETFORD

PROJECT NUMBER: STP 2911(I)

FILE NAME: pl0c224.dgn

PROJECT LEADER: PTS

DESIGNED BY: NLL

IPARM FILE NAME: IOC224\_I49

PLOT DATE: 1/29/2013

DRAWN BY: SNG

CHECKED BY: PTS

SHEET 149 OF 232