




364+00

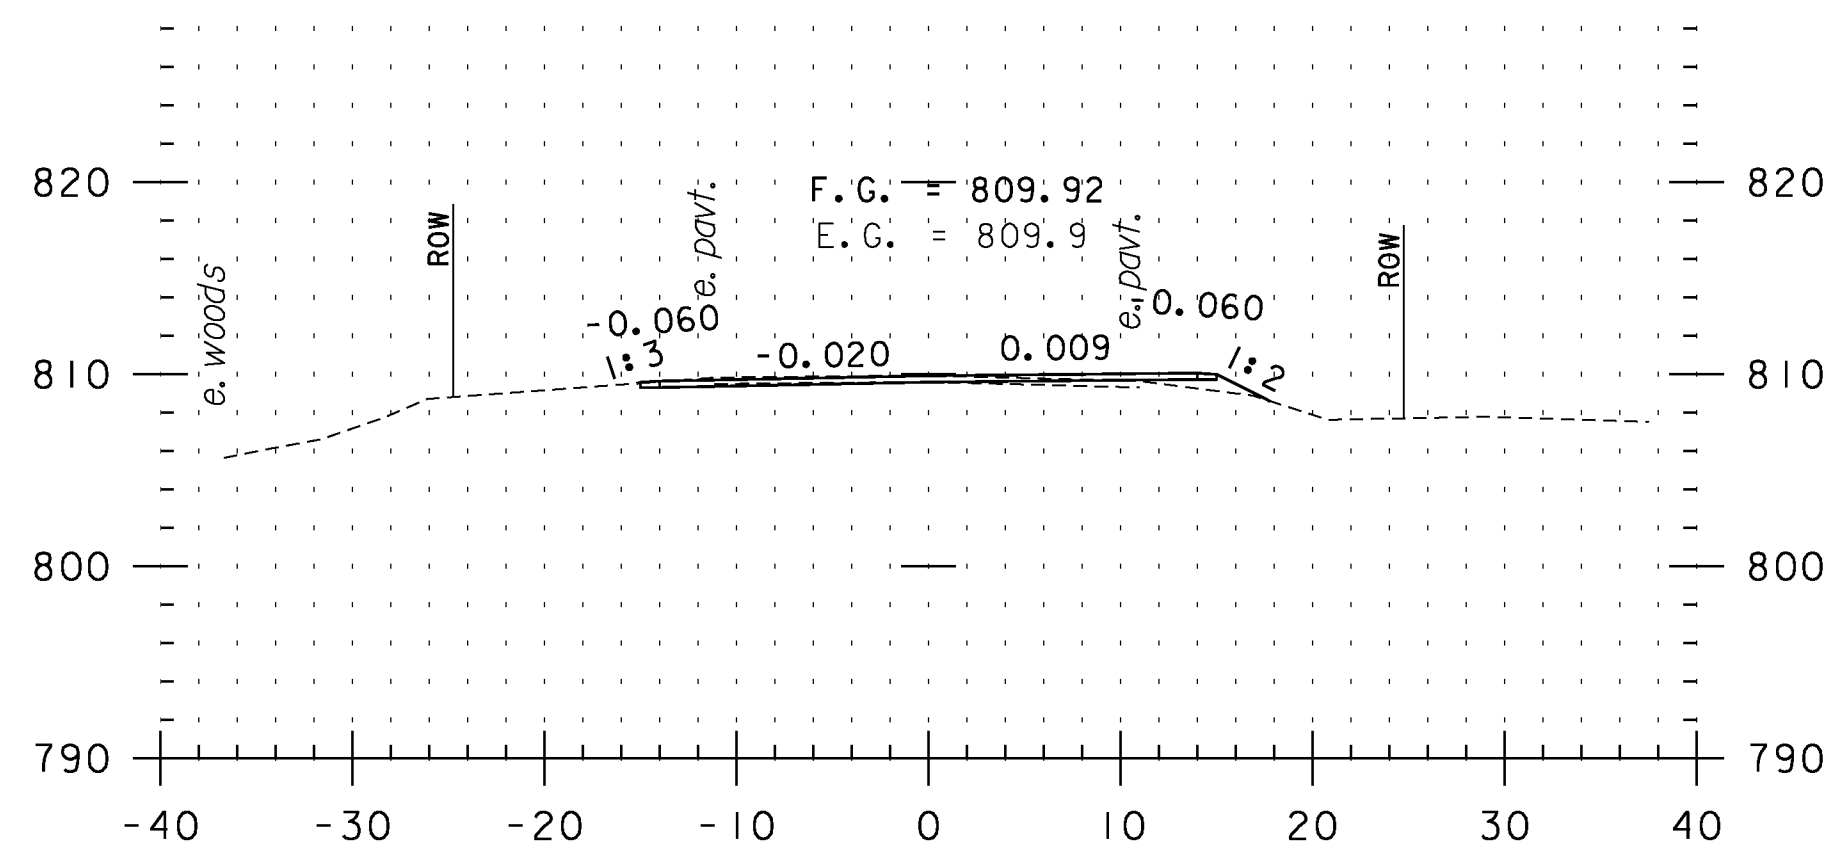


365+50

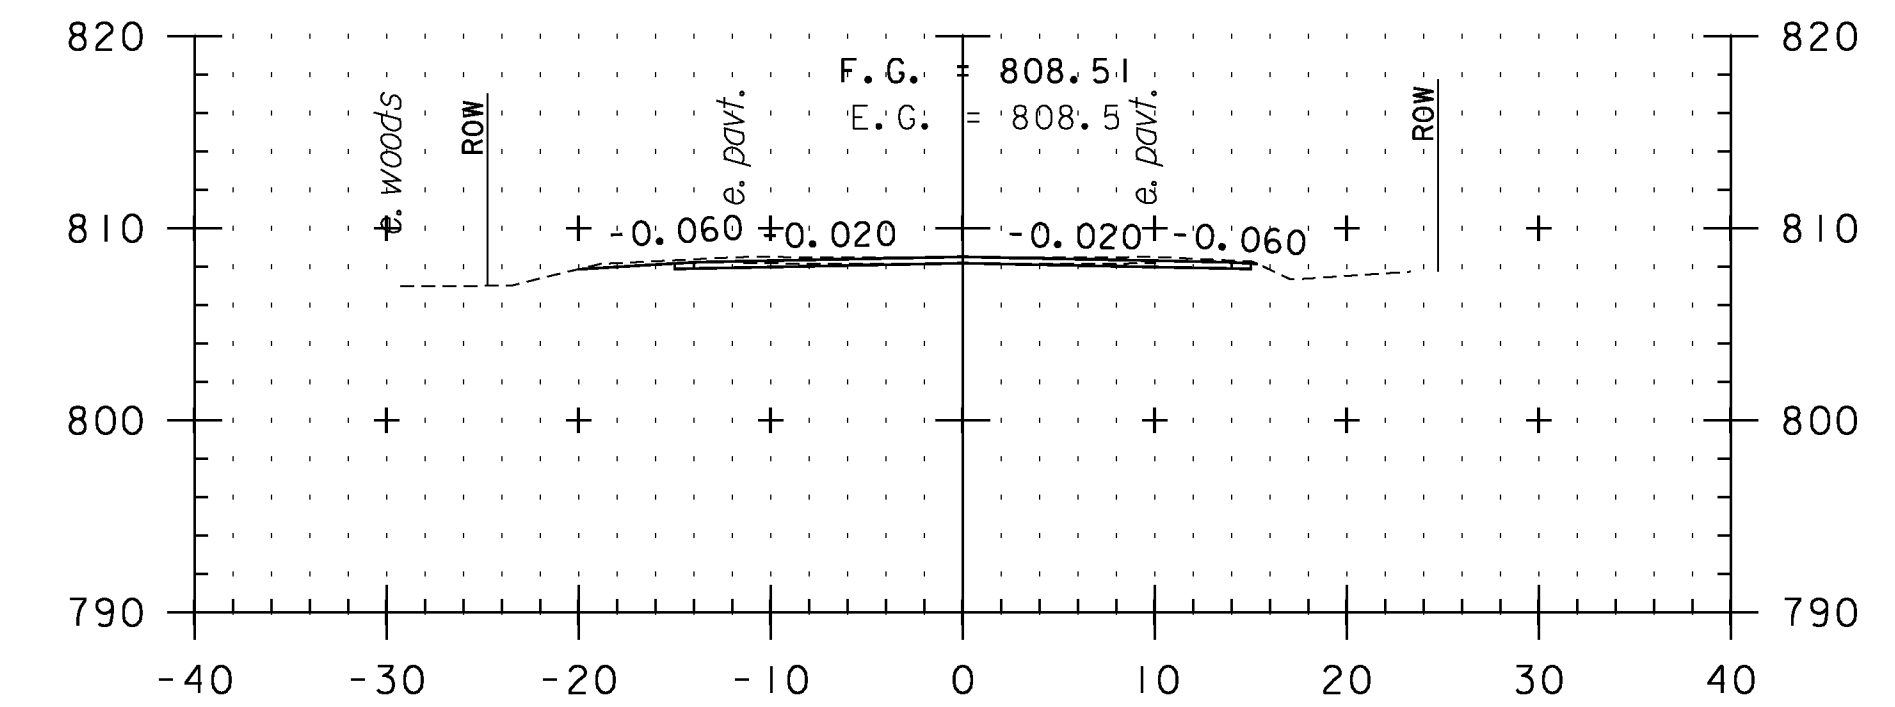


367+00

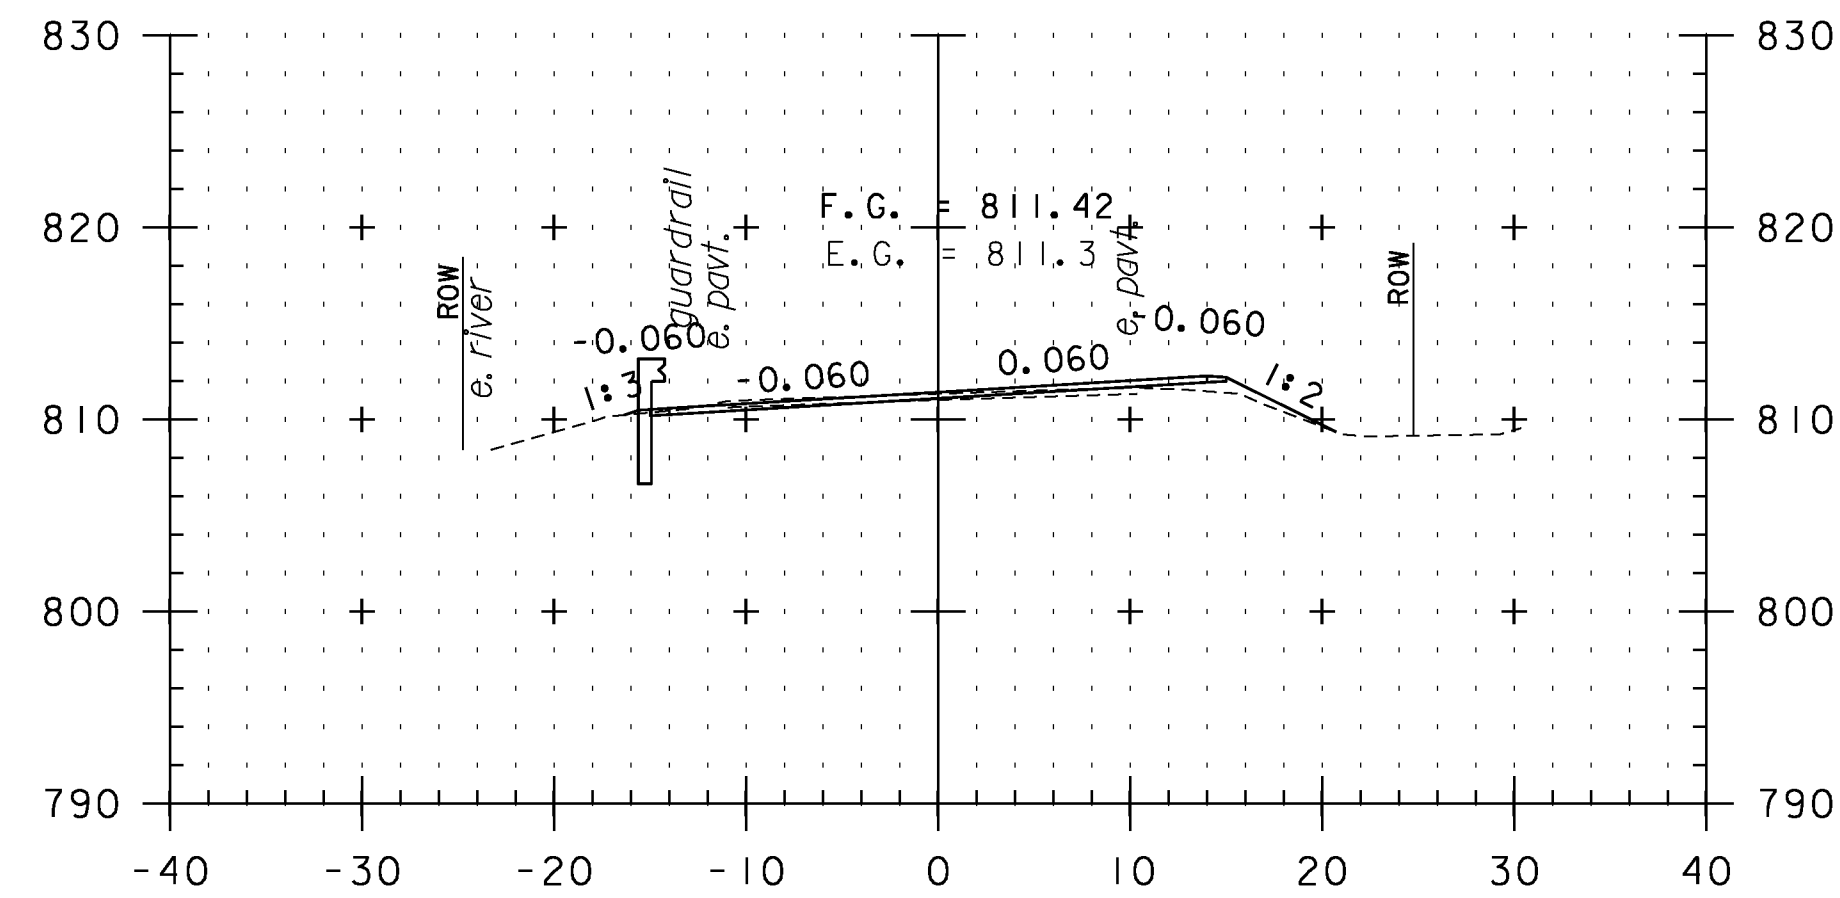


363+50

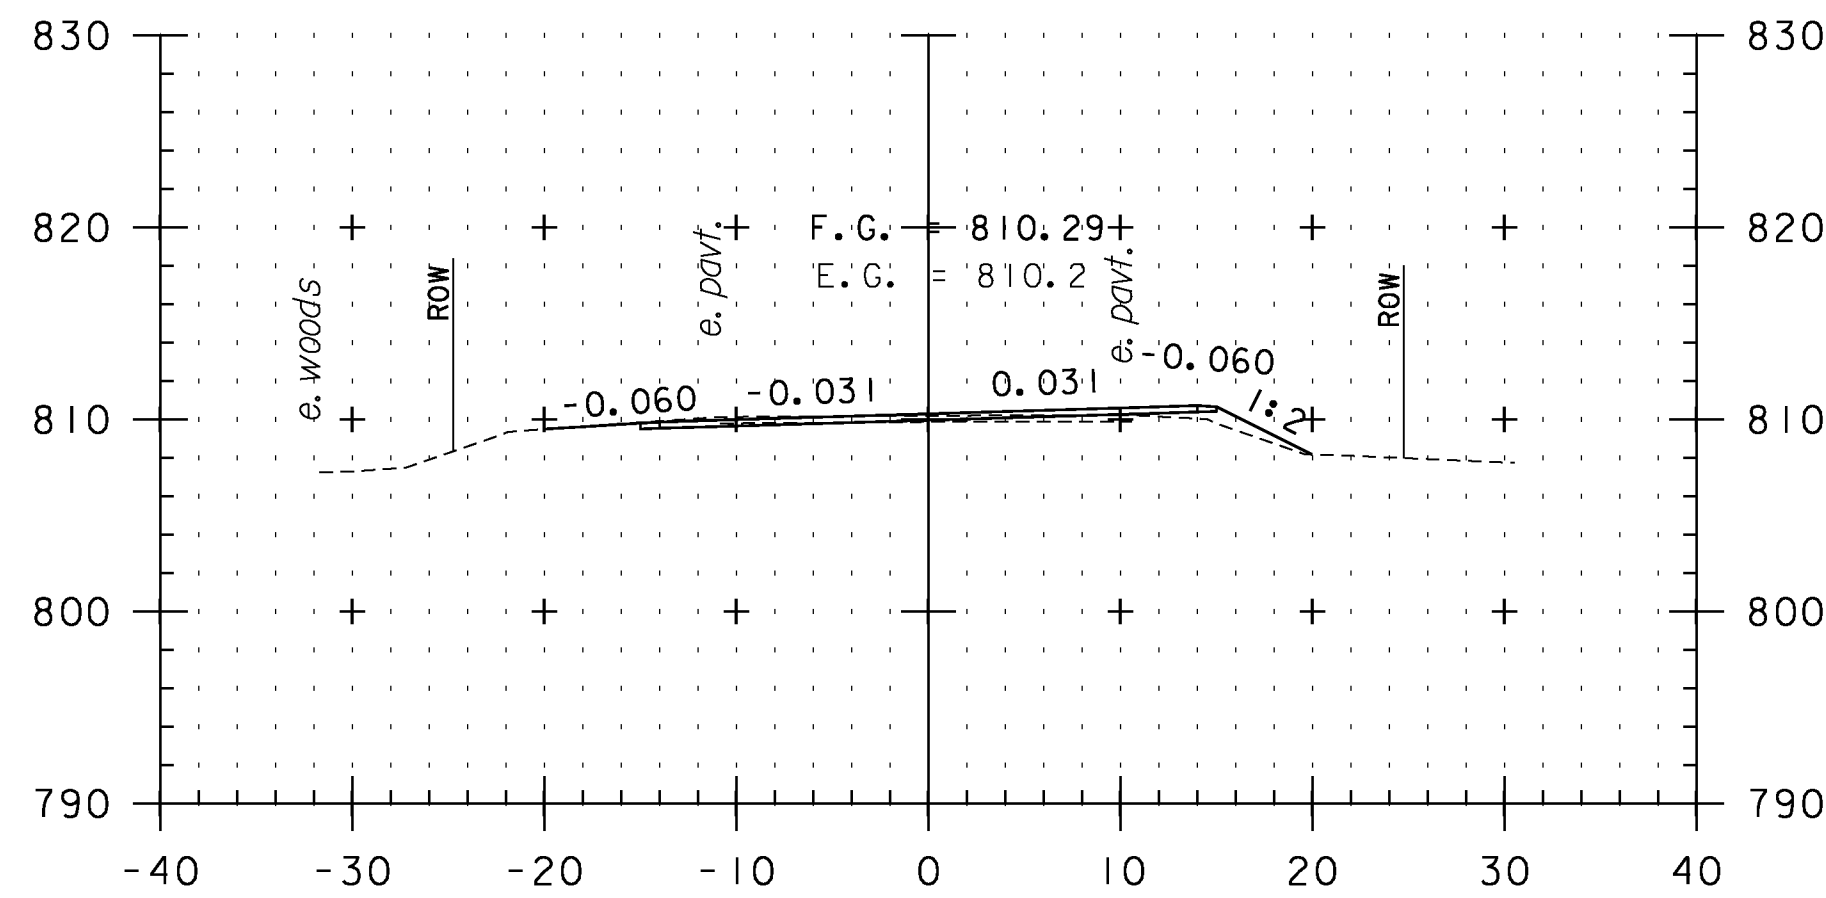


365+00

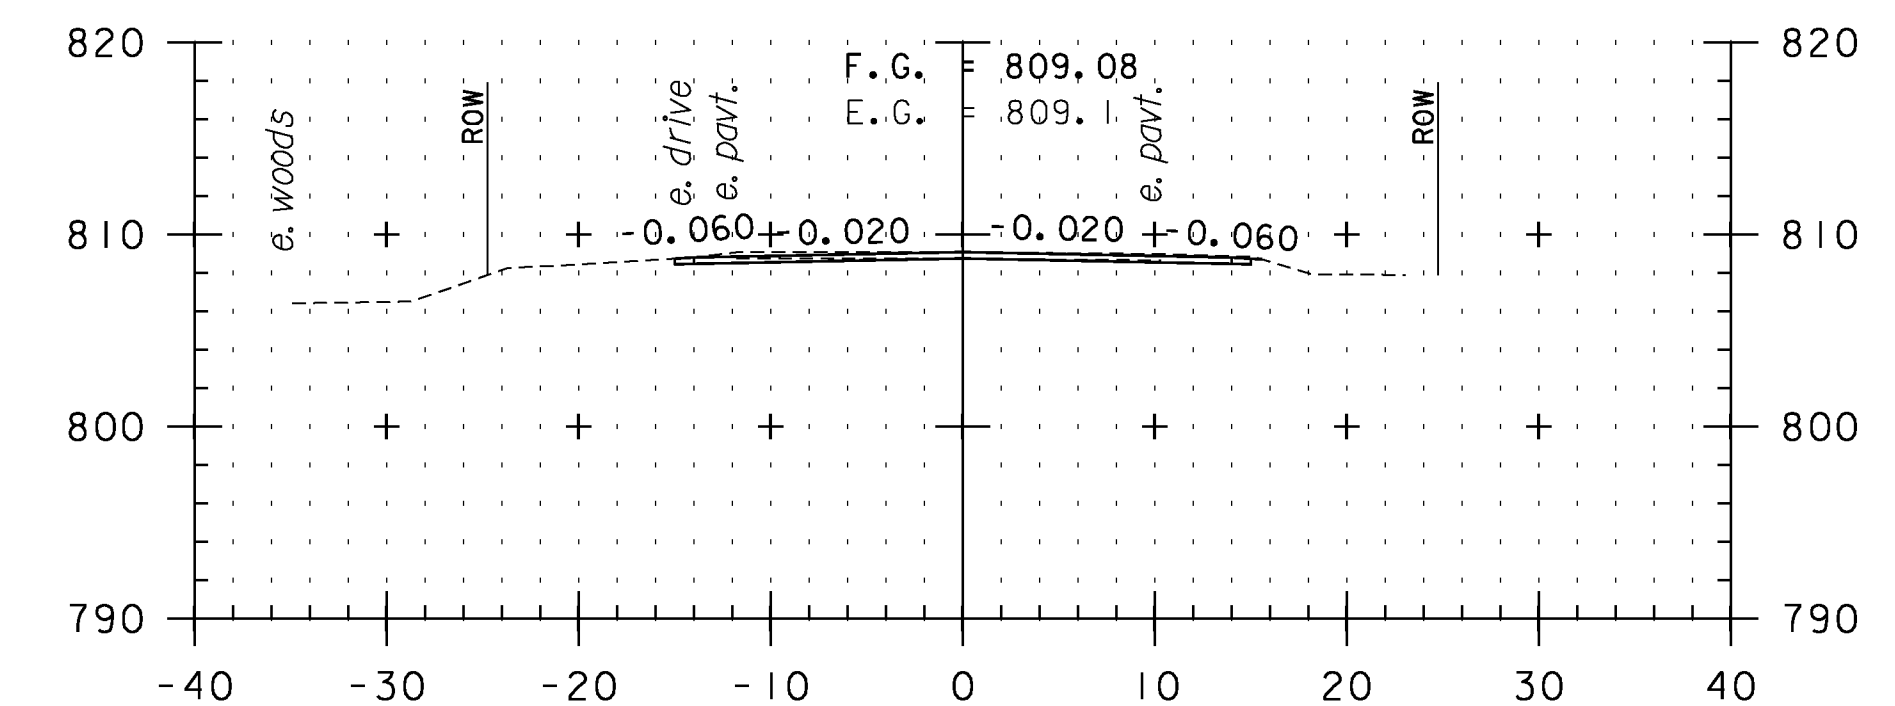


366+50

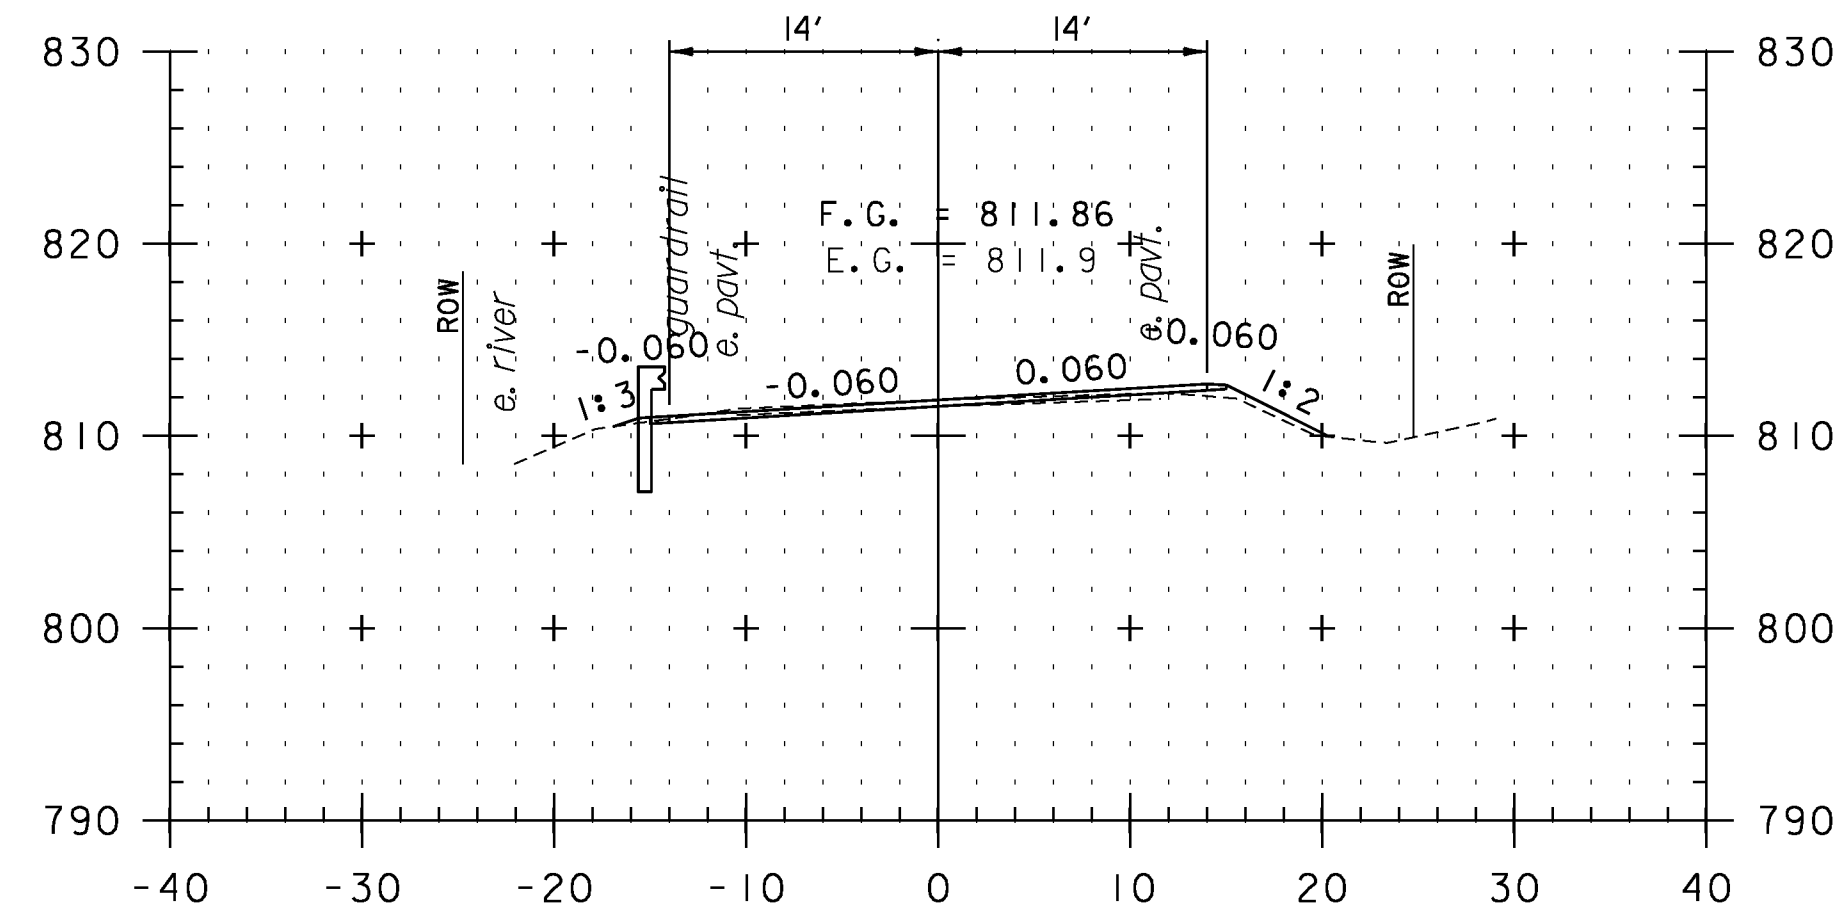

363+00

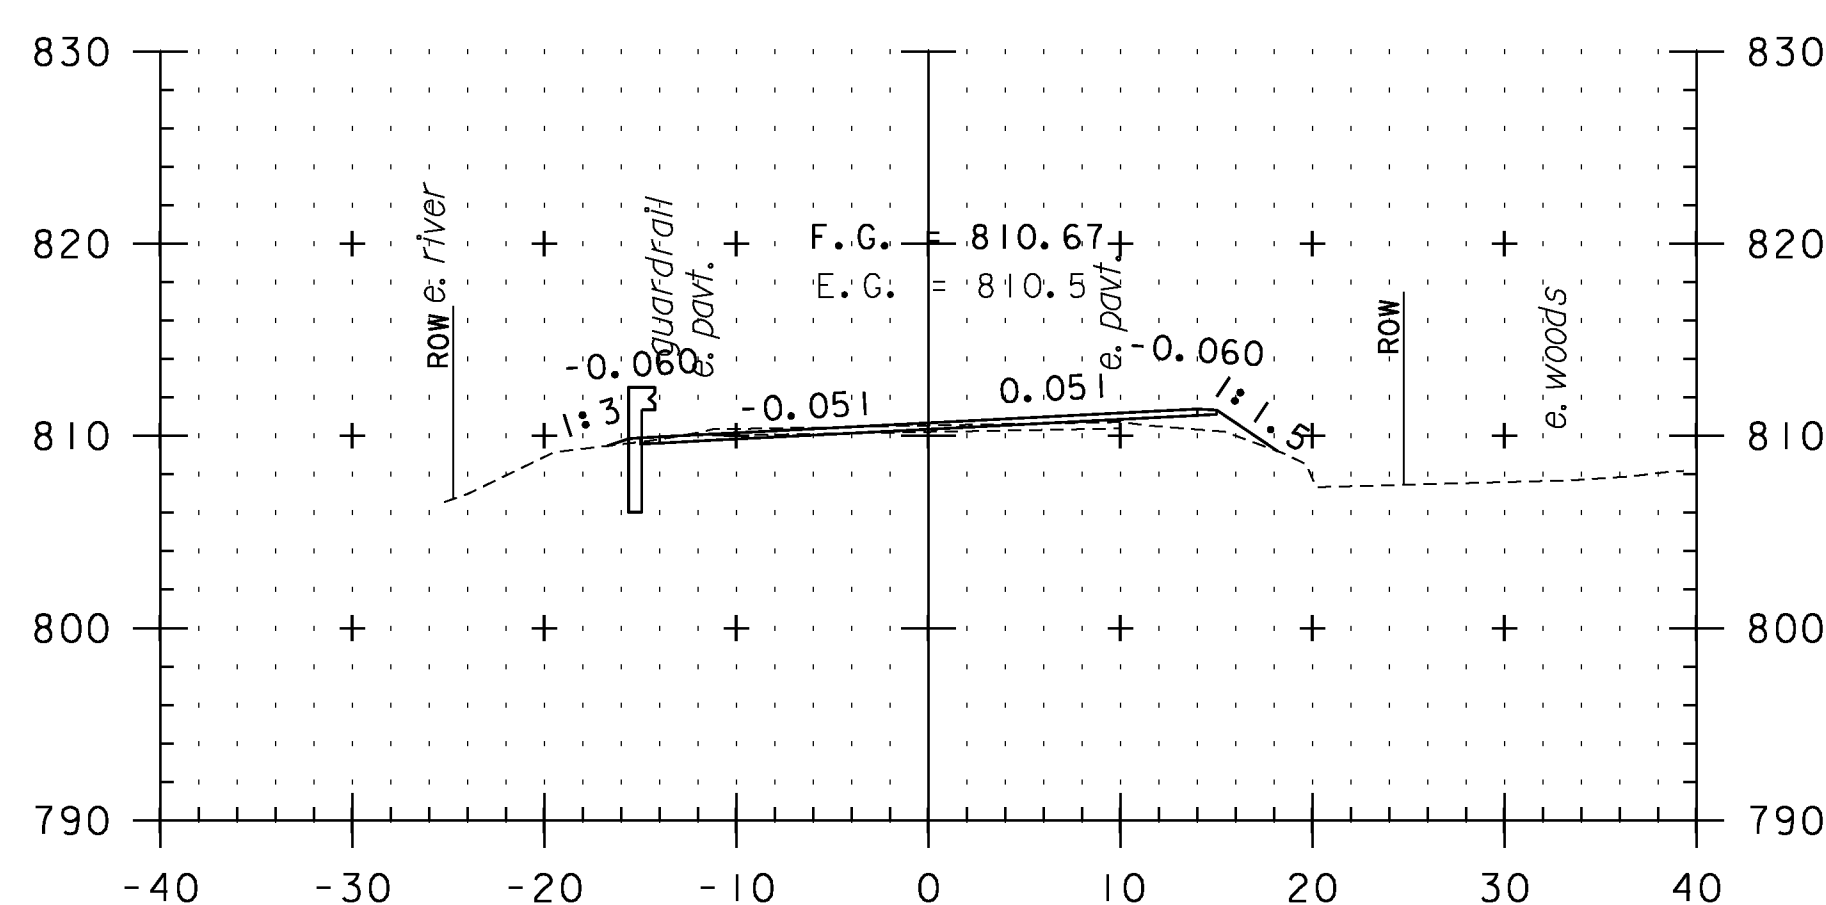

364+50

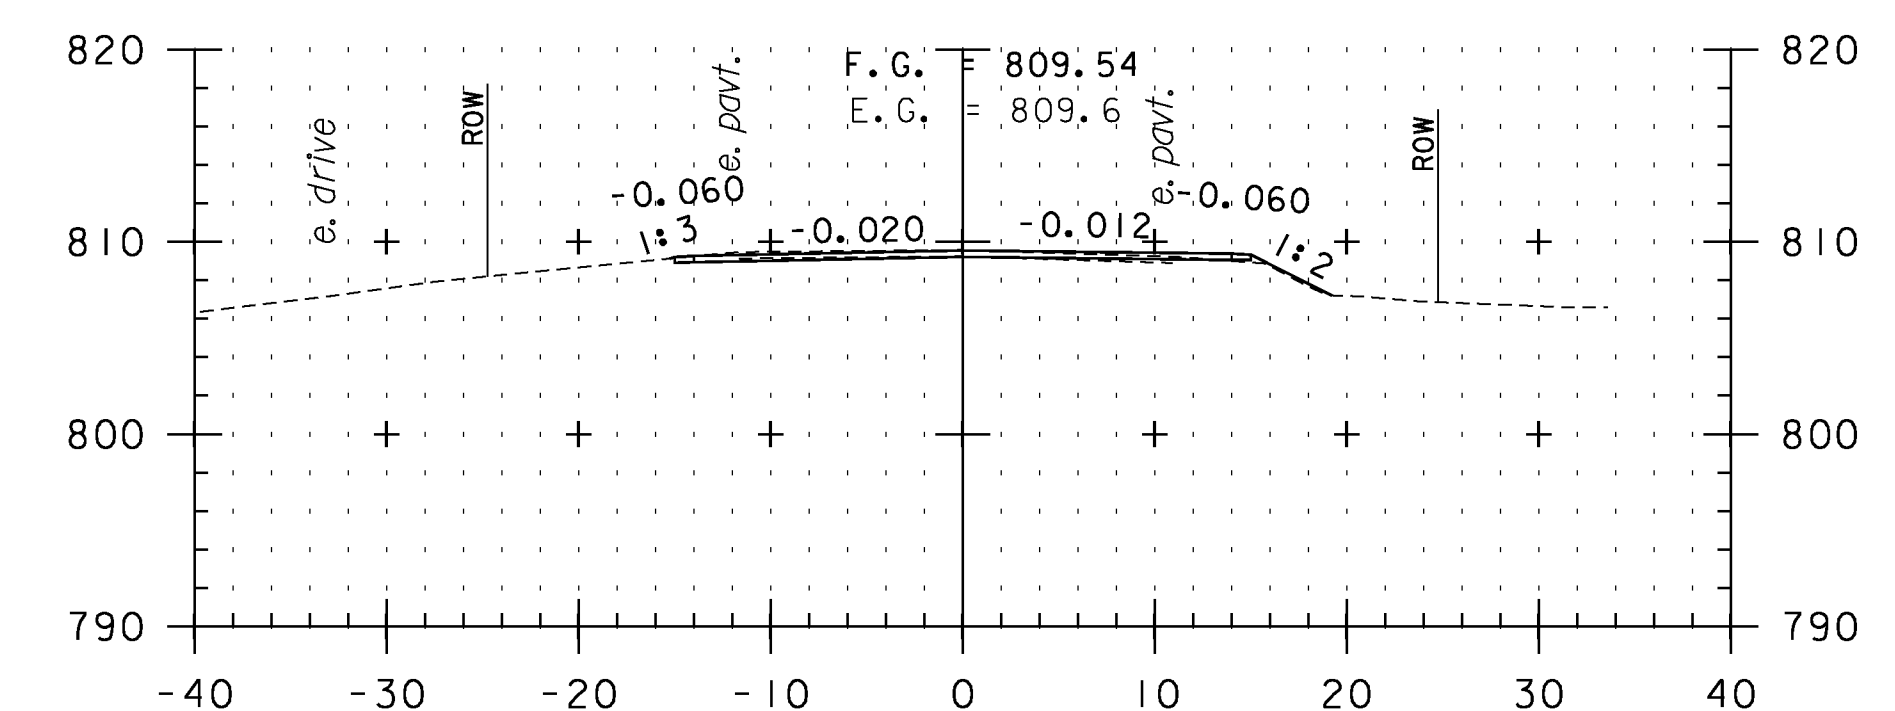

366+00

CROSS SECTION SHEET 42

STA. 363+00 TO STA. 367+00



PROJECT NAME: VERSHIRE-THETFORD	PLOT DATE: 1/29/2013
PROJECT NUMBER: STP 2911(I)	DRAWN BY: SNG
FILE NAME: pl0c224.dgn	CHECKED BY: PTS
PROJECT LEADER: PTS	SHEET 150 OF 232
DESIGNED BY: NLL	
IPARM FILE NAME: IOC224_150	