




368+50

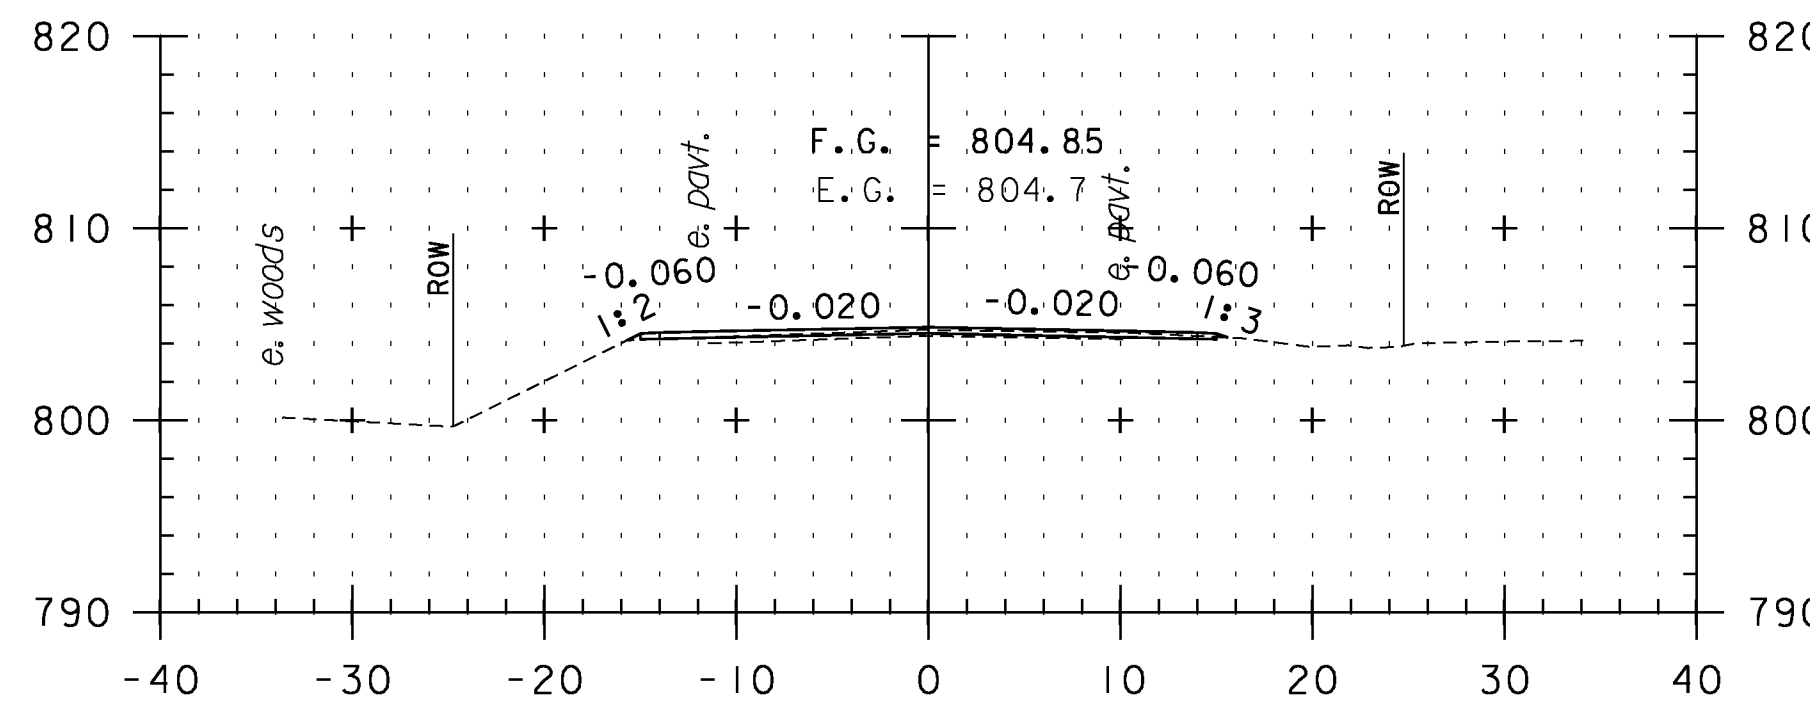


370+00

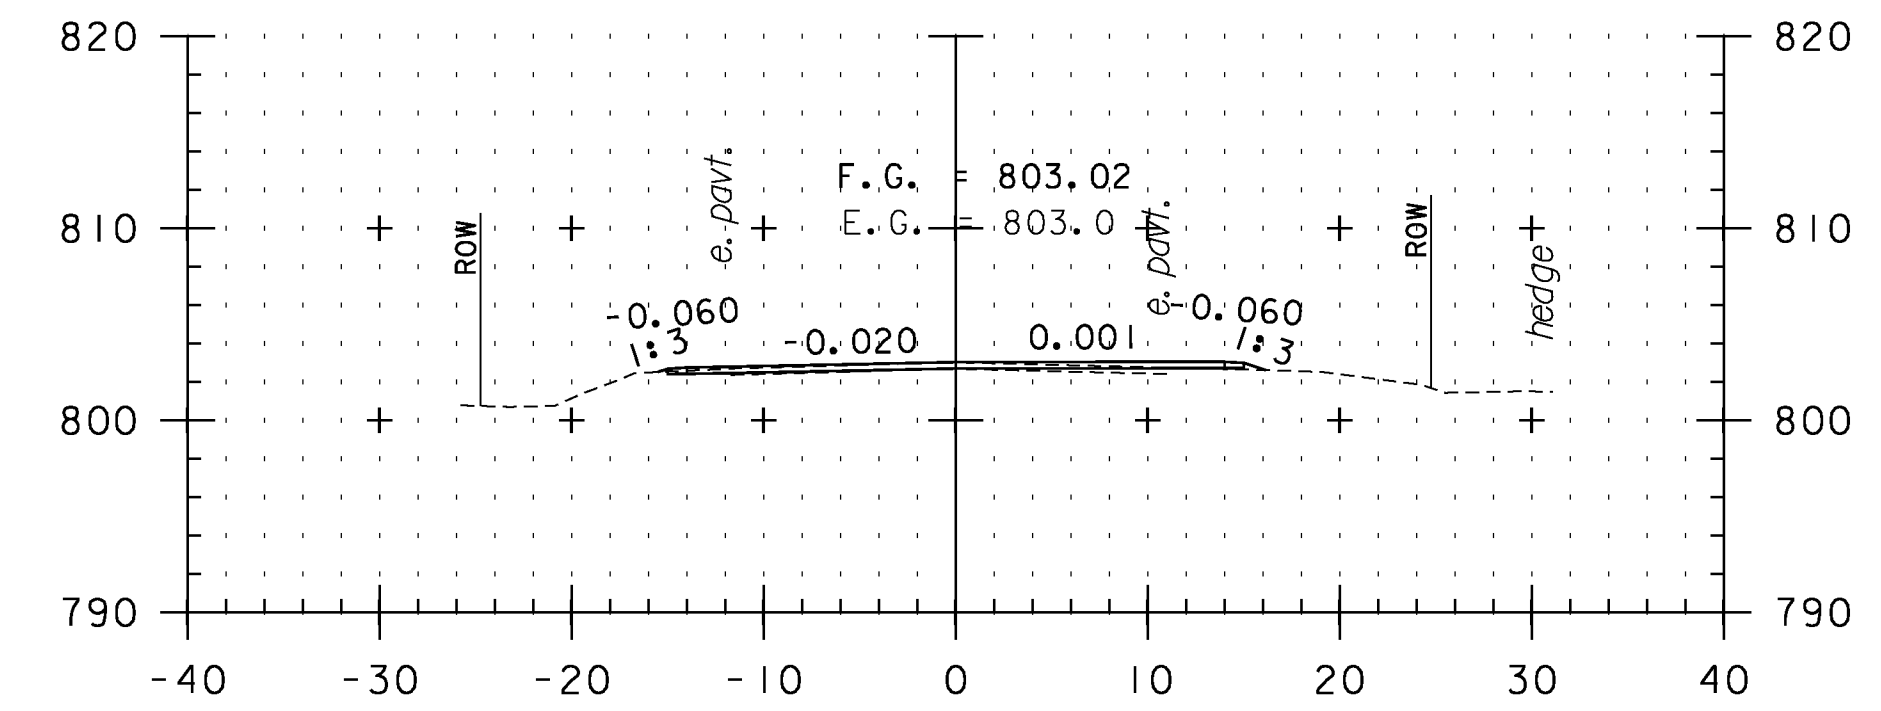


371+50

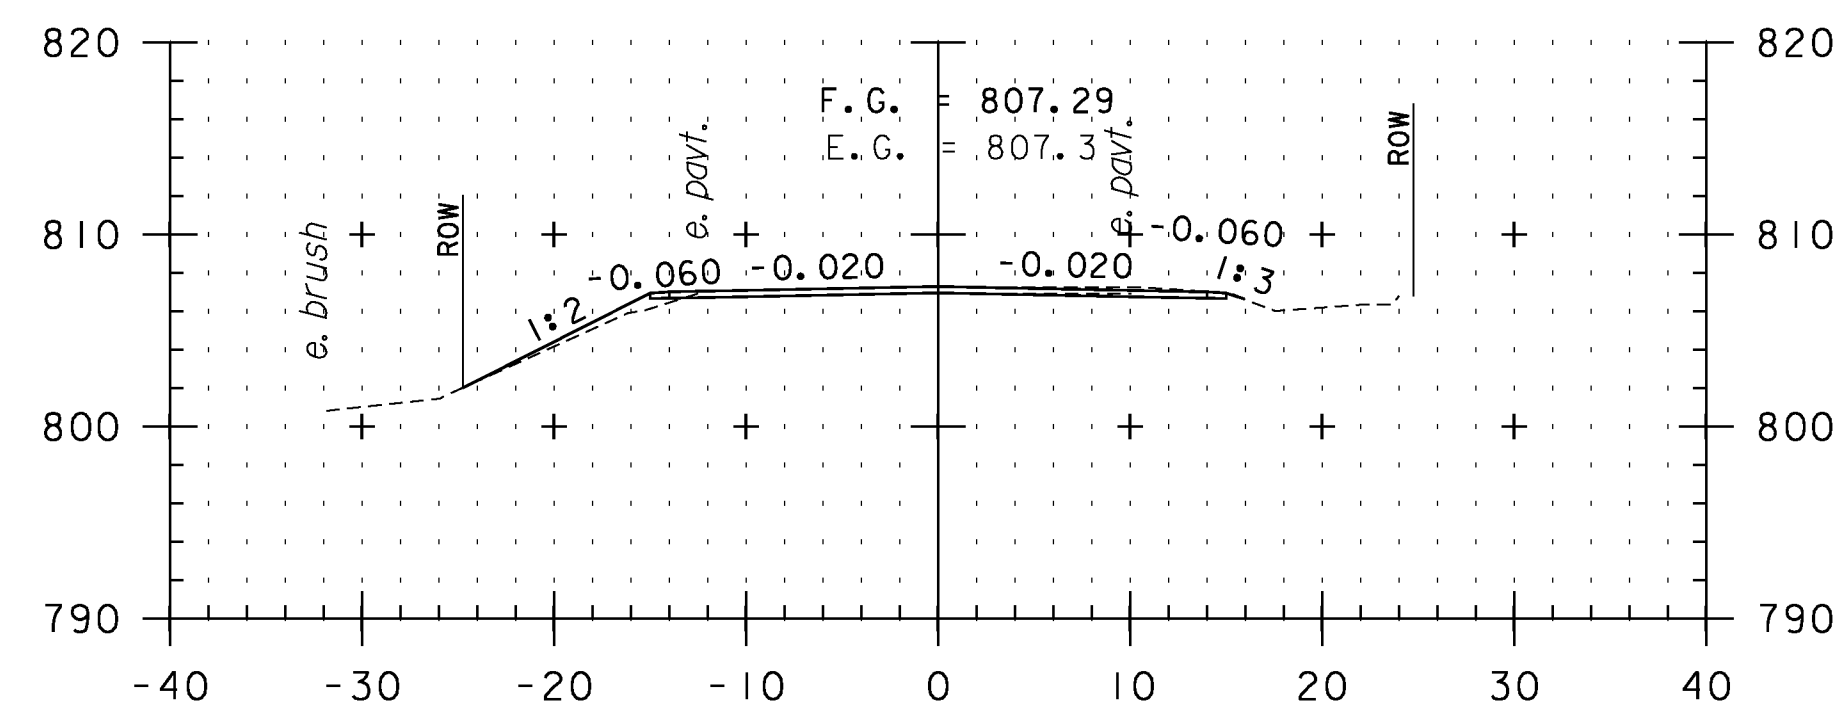


368+00

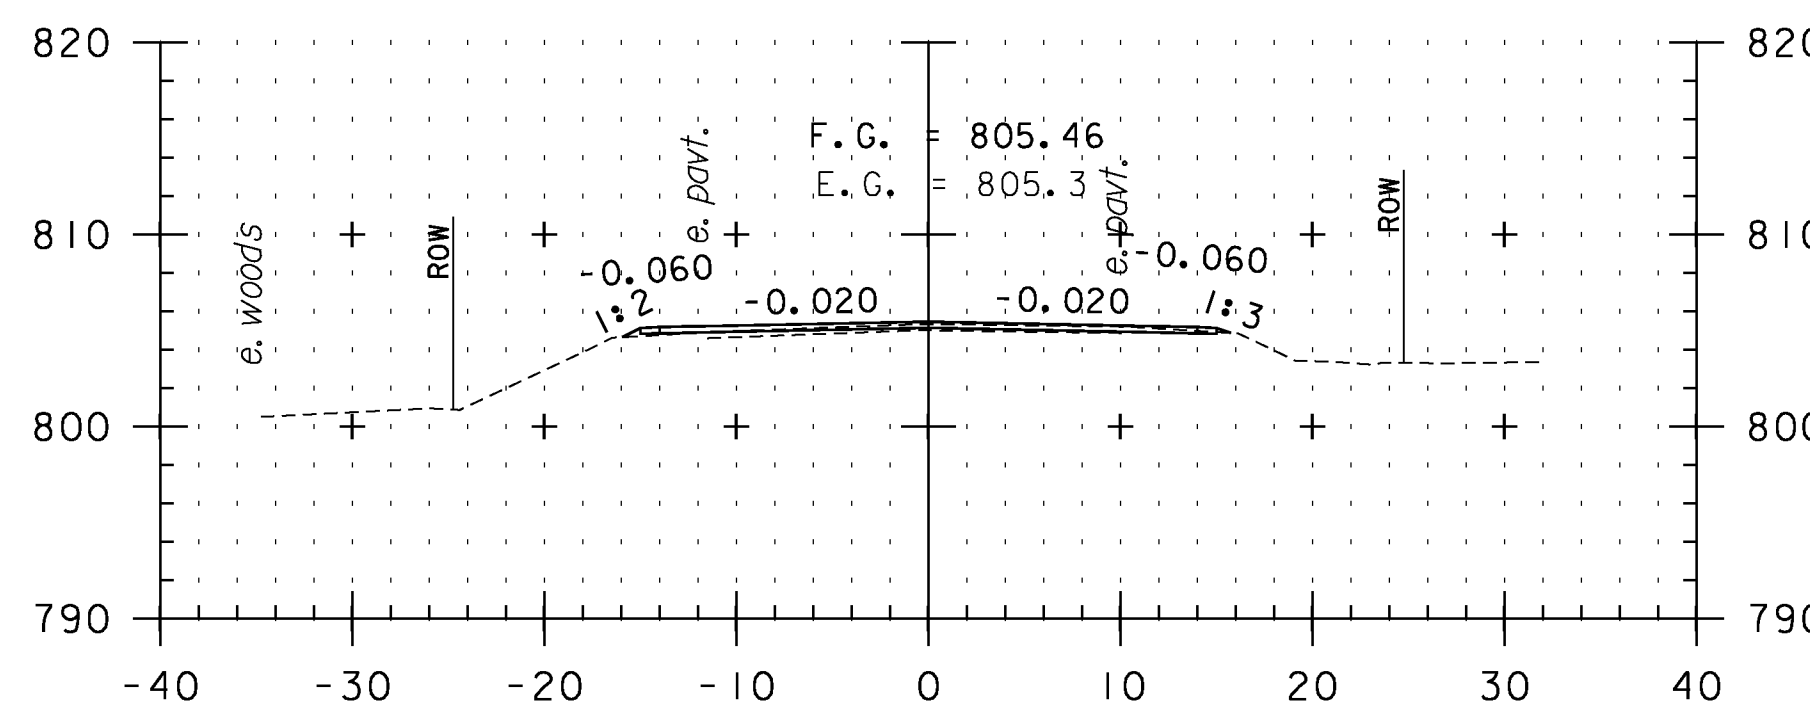


369+50

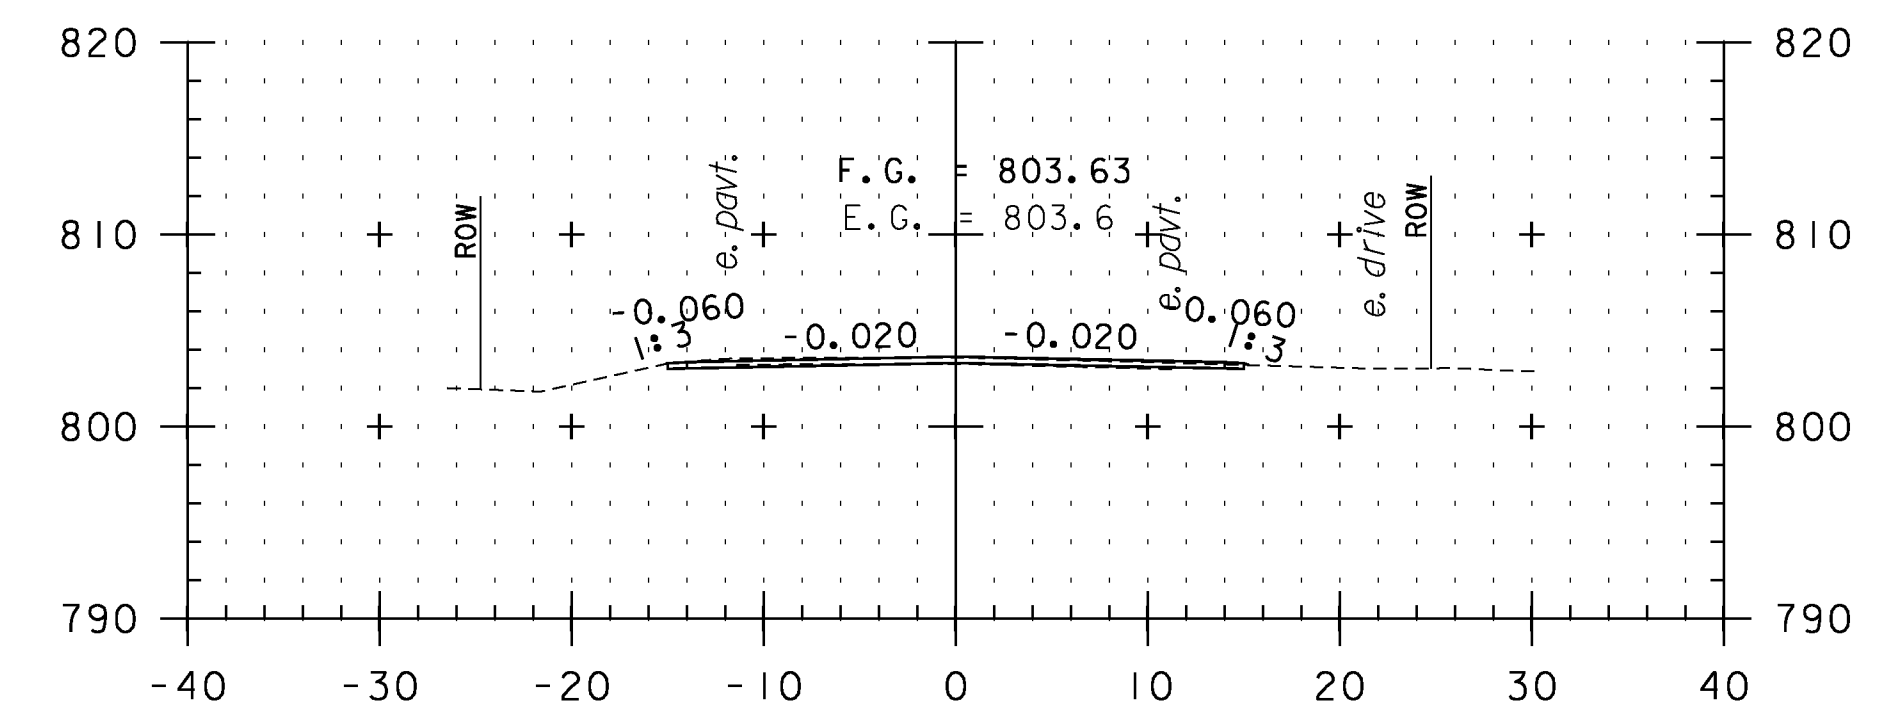


371+00

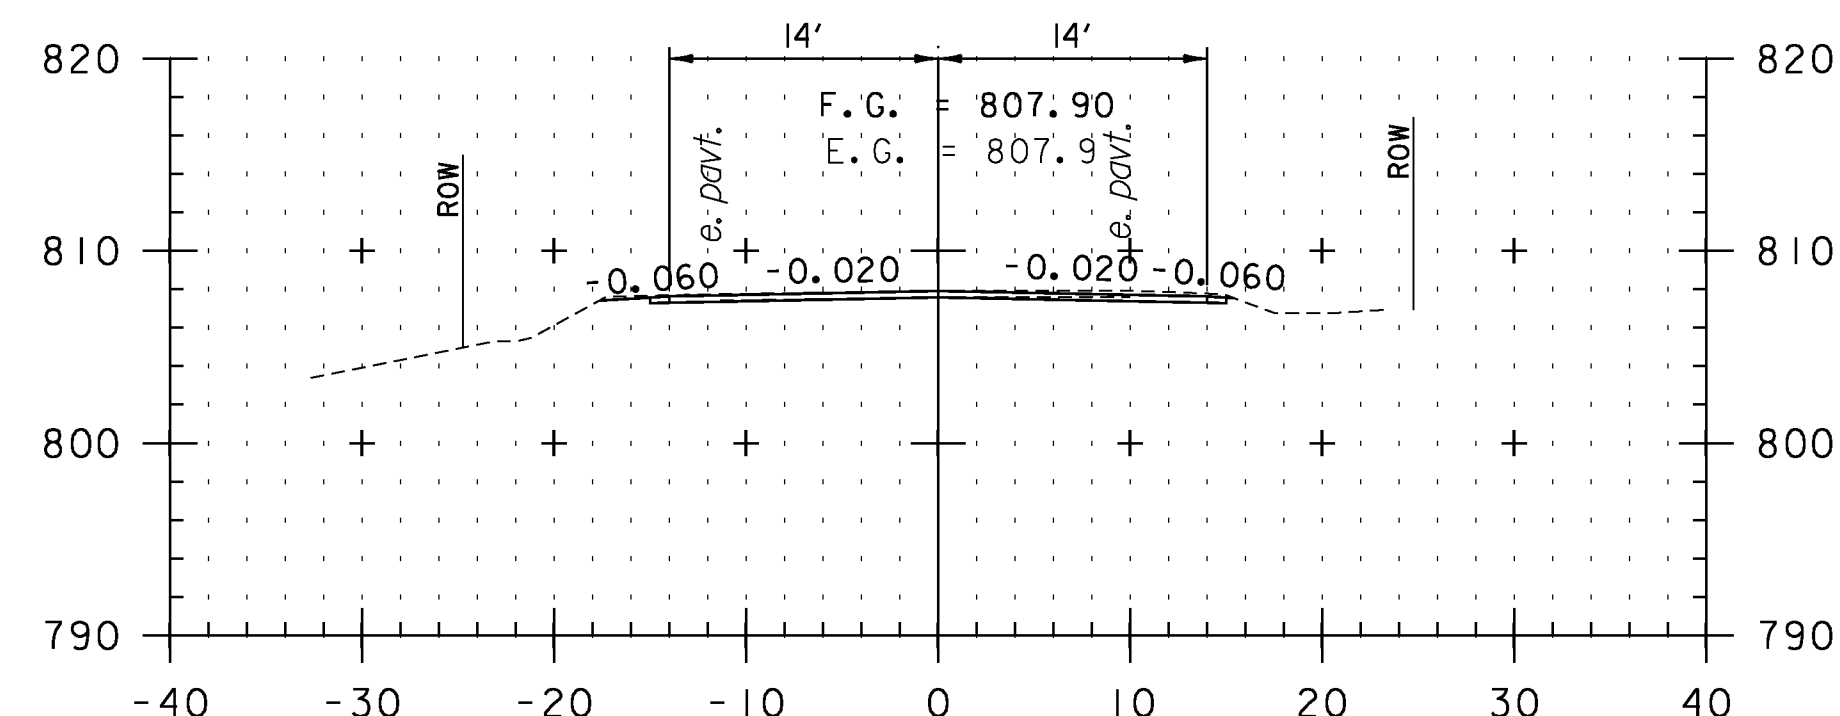

367+50

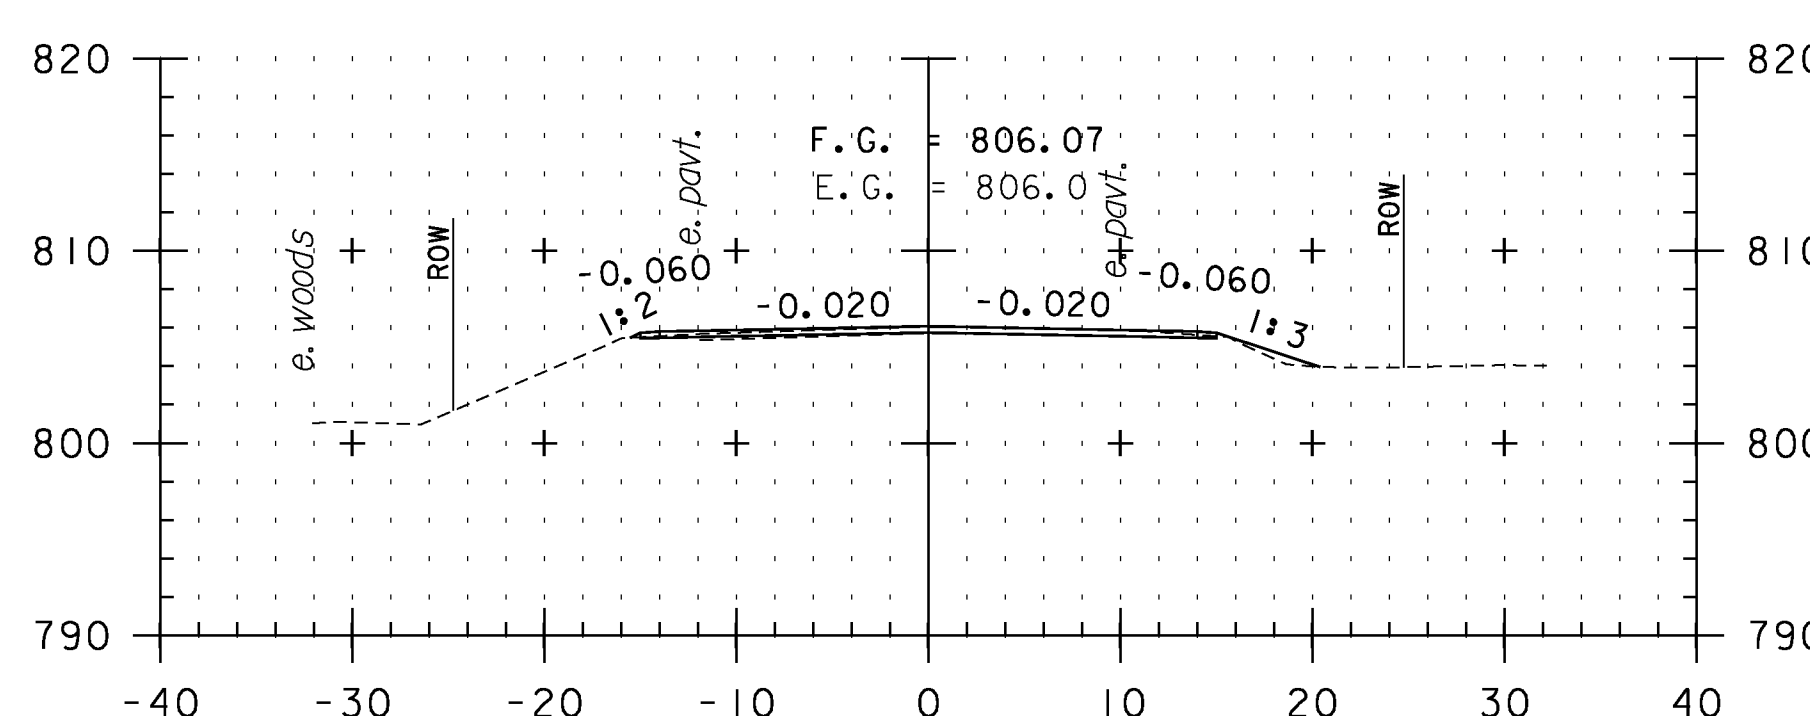


369+00

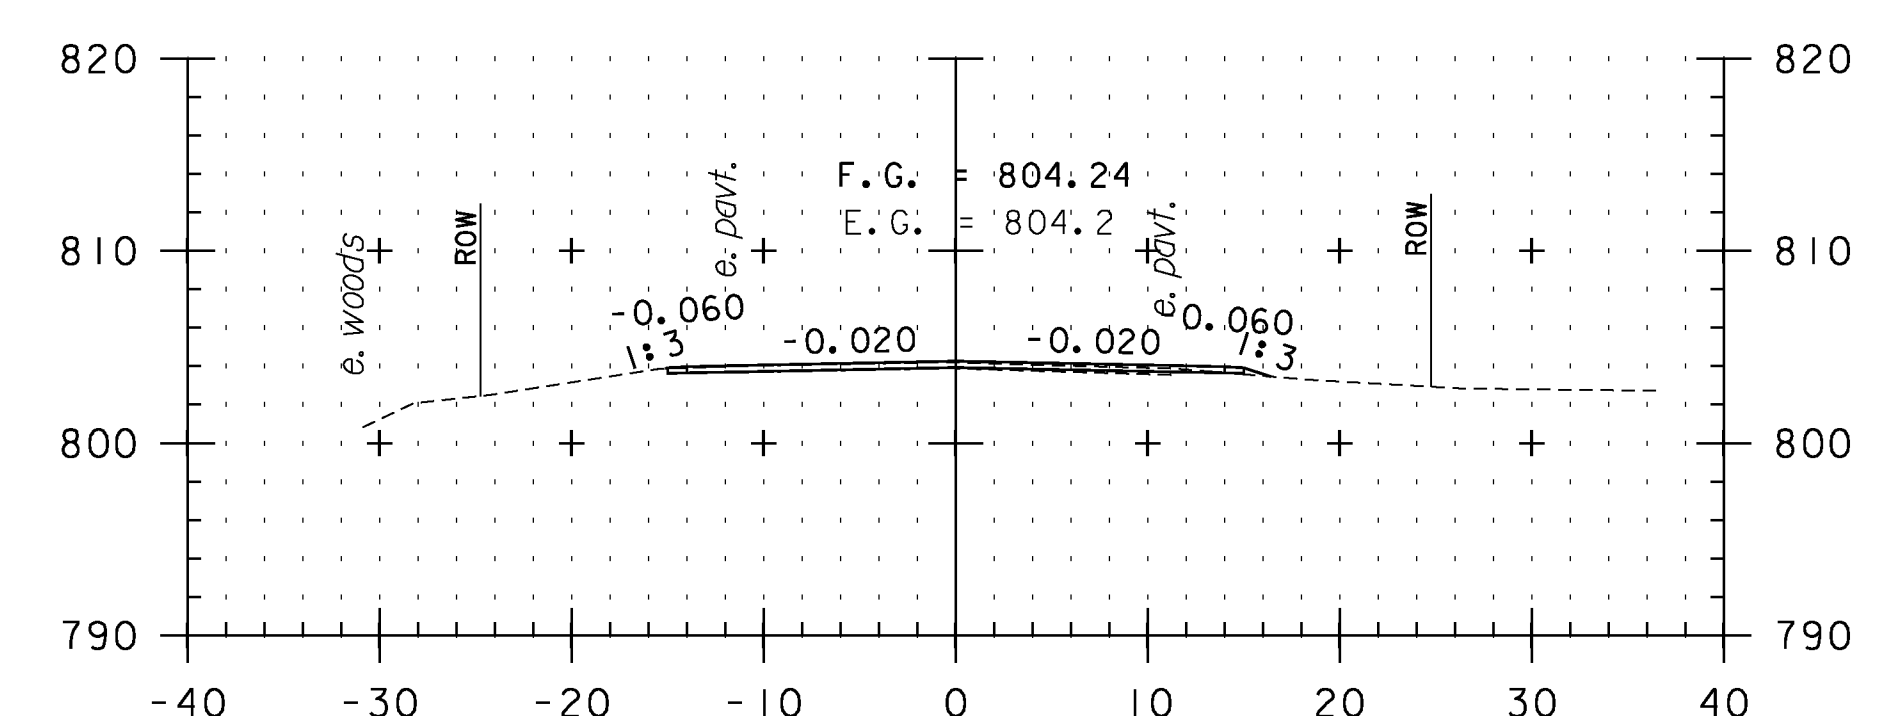

370+50

CROSS SECTION SHEET 43

STA. 367+50 TO STA. 371+50

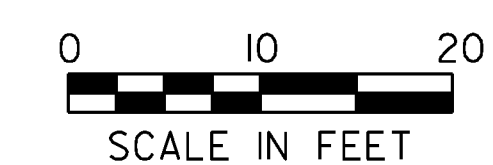

PROJECT NAME: VERSHIRE-THETFORD	PLOT DATE: 1/29/2013
PROJECT NUMBER: STP 2911(I)	DRAWN BY: SNG
FILE NAME: pl0c224.dgn	CHECKED BY: PTS
PROJECT LEADER: PTS	SHEET 151 OF 232
DESIGNED BY: NLL	
IPARM FILE NAME: IOC224_151	