




373+00

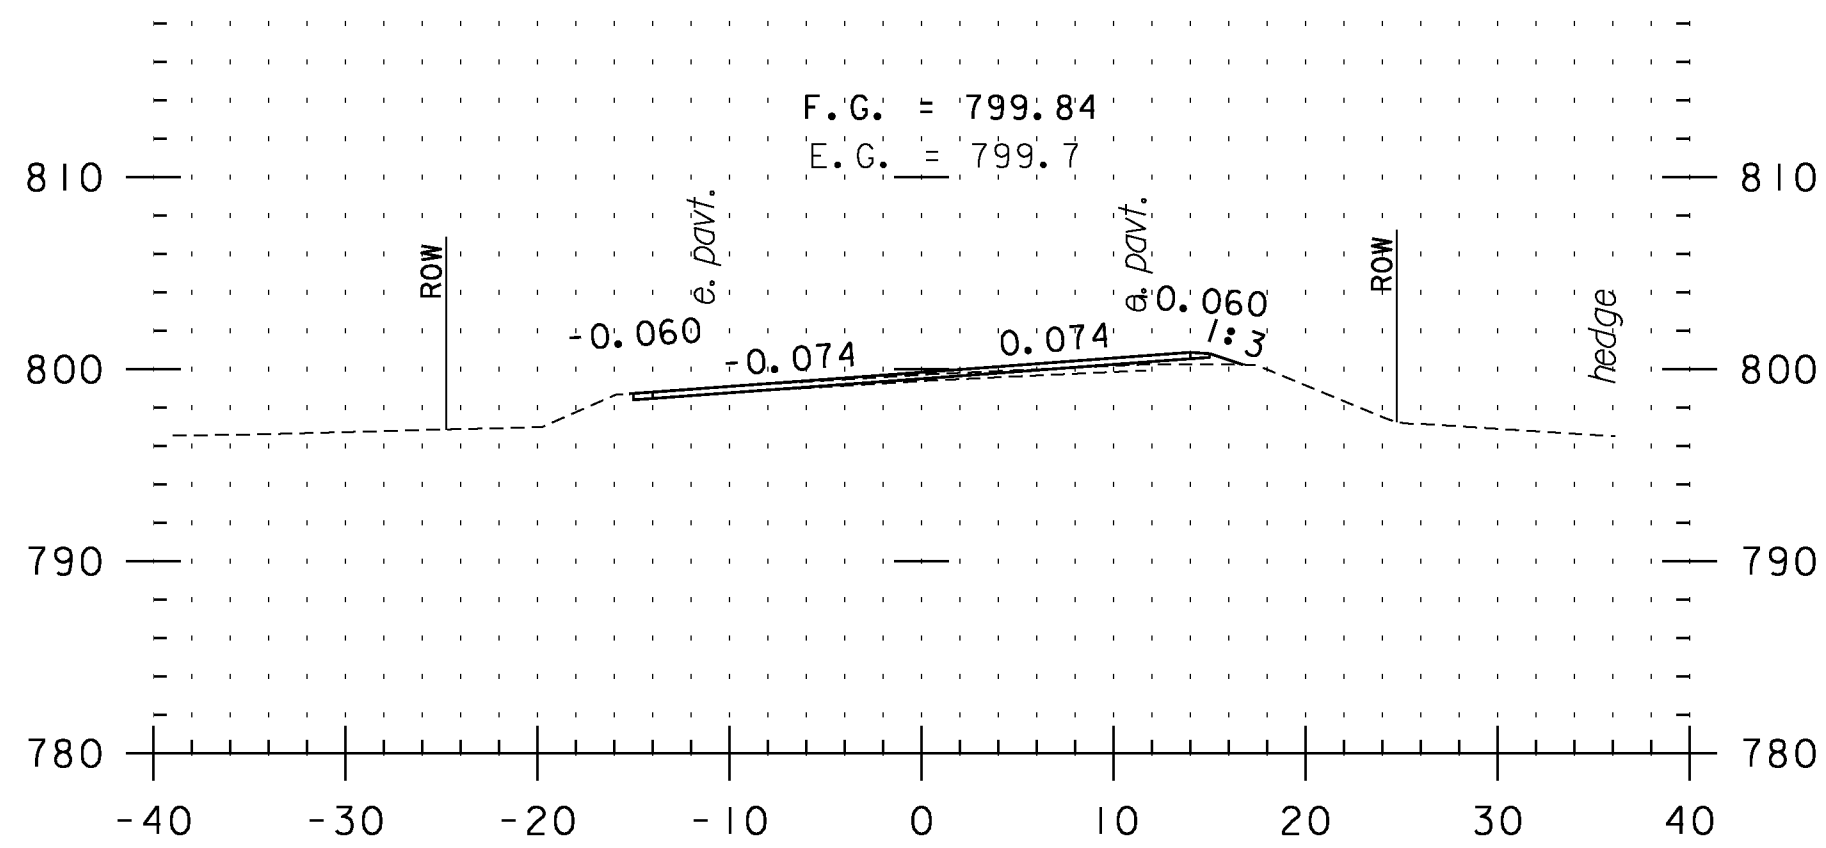


374+50

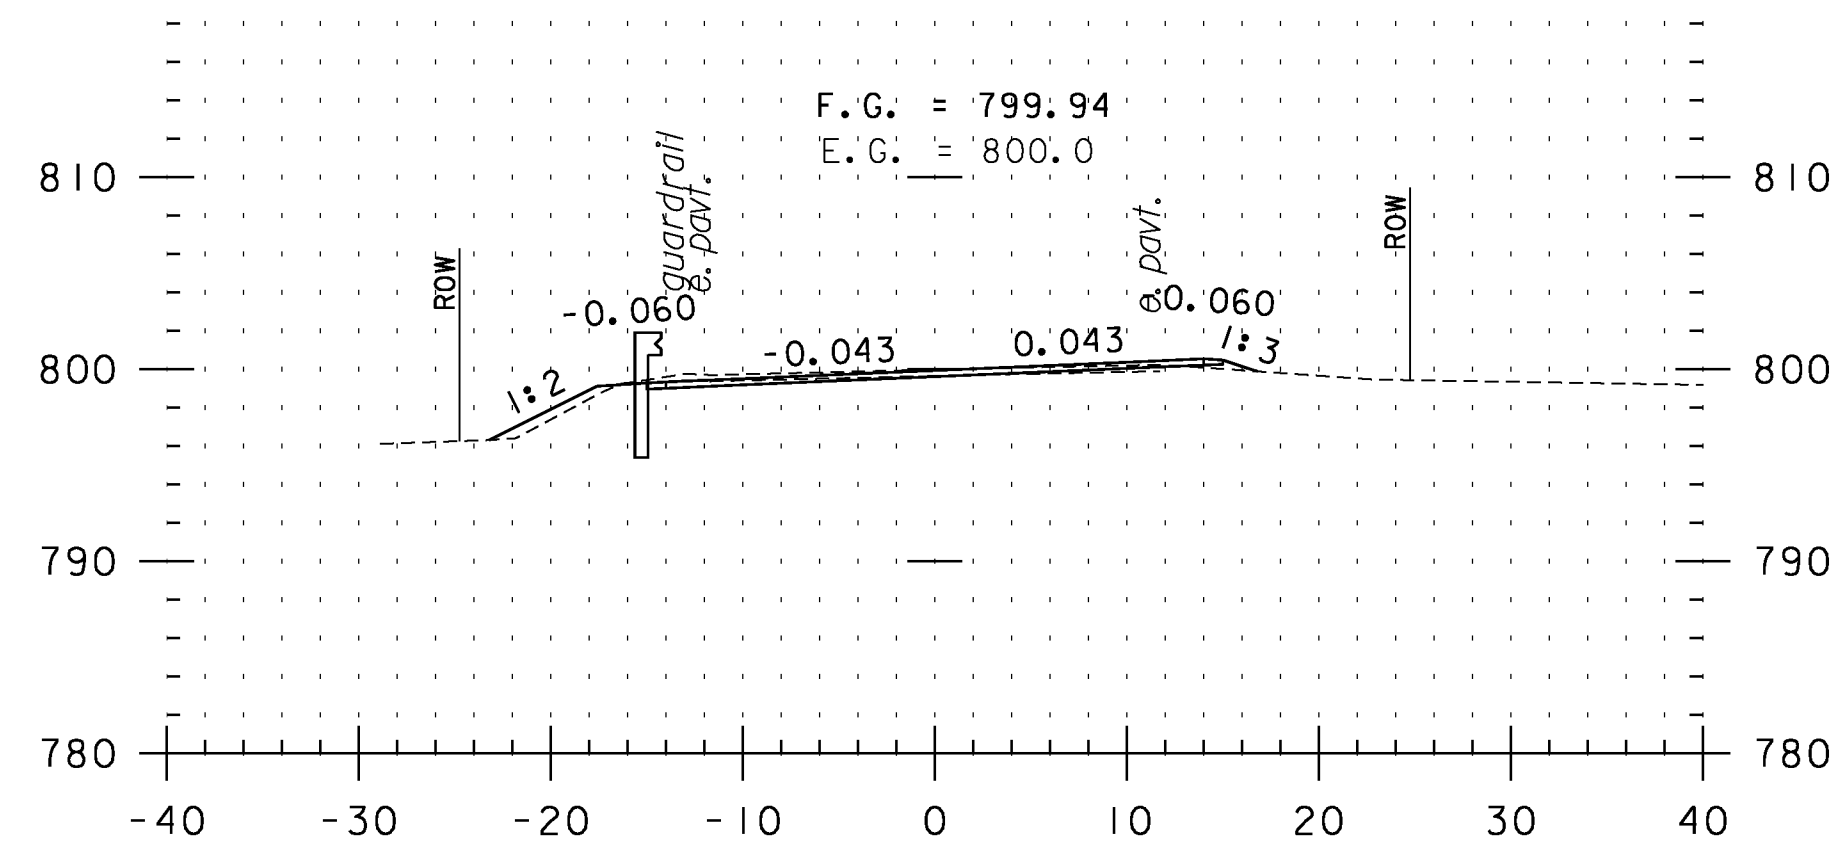


376+00

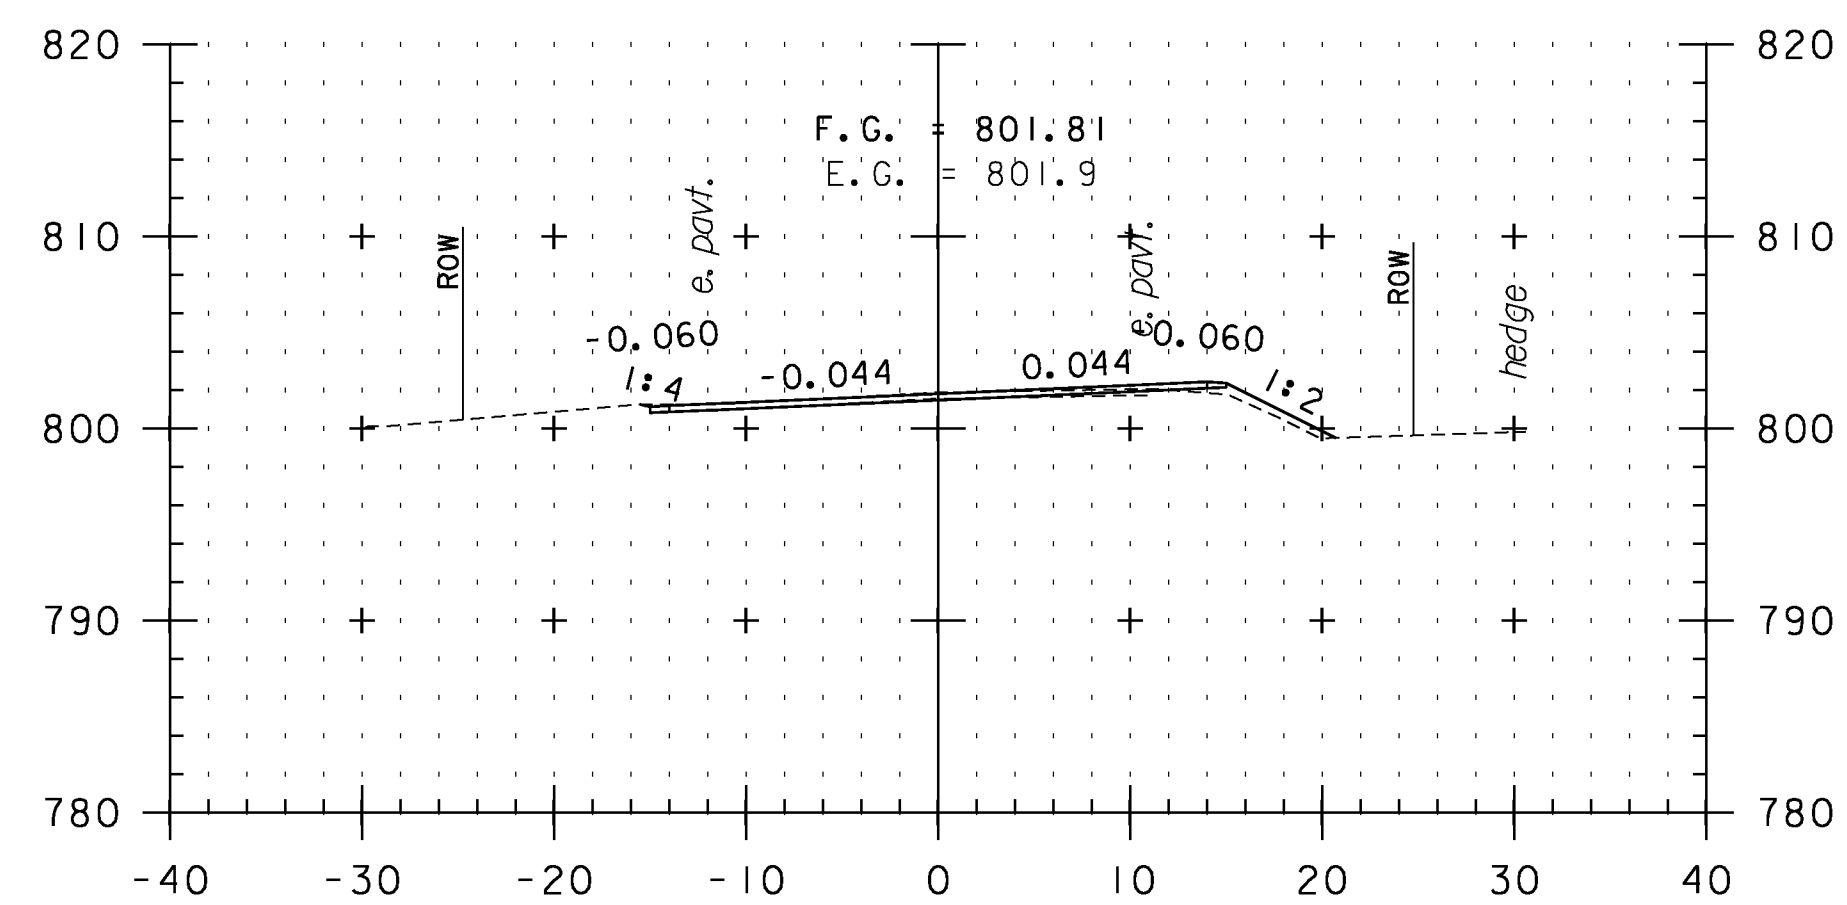


372+50

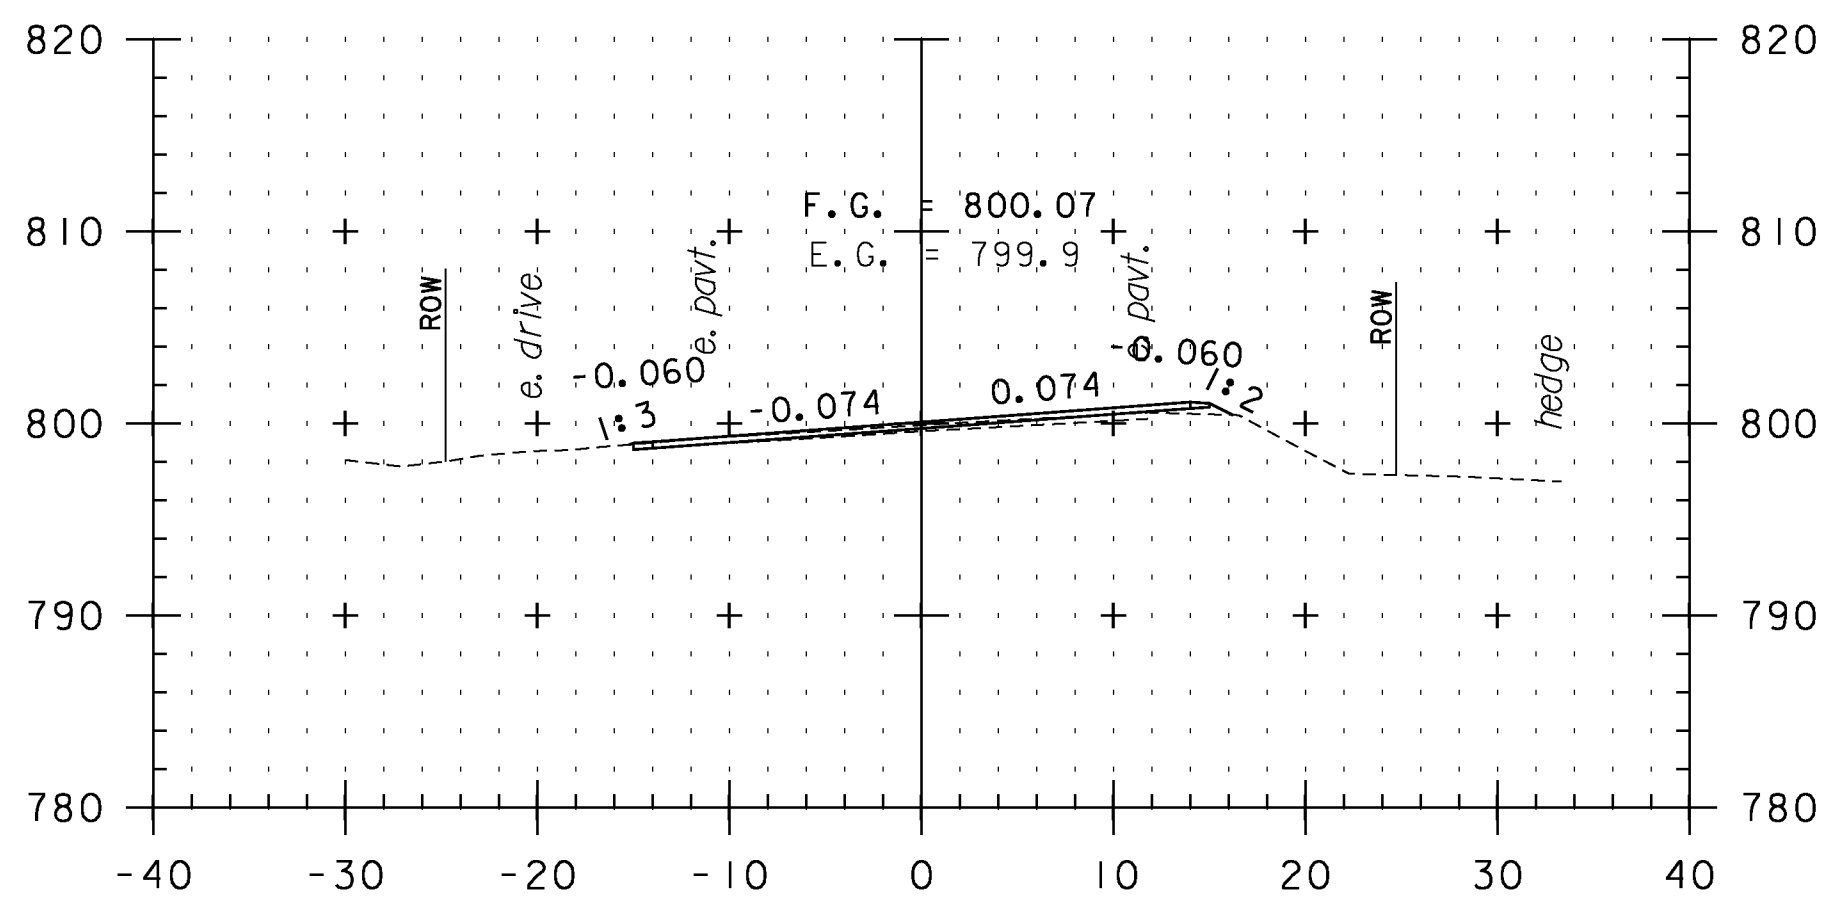


374+00

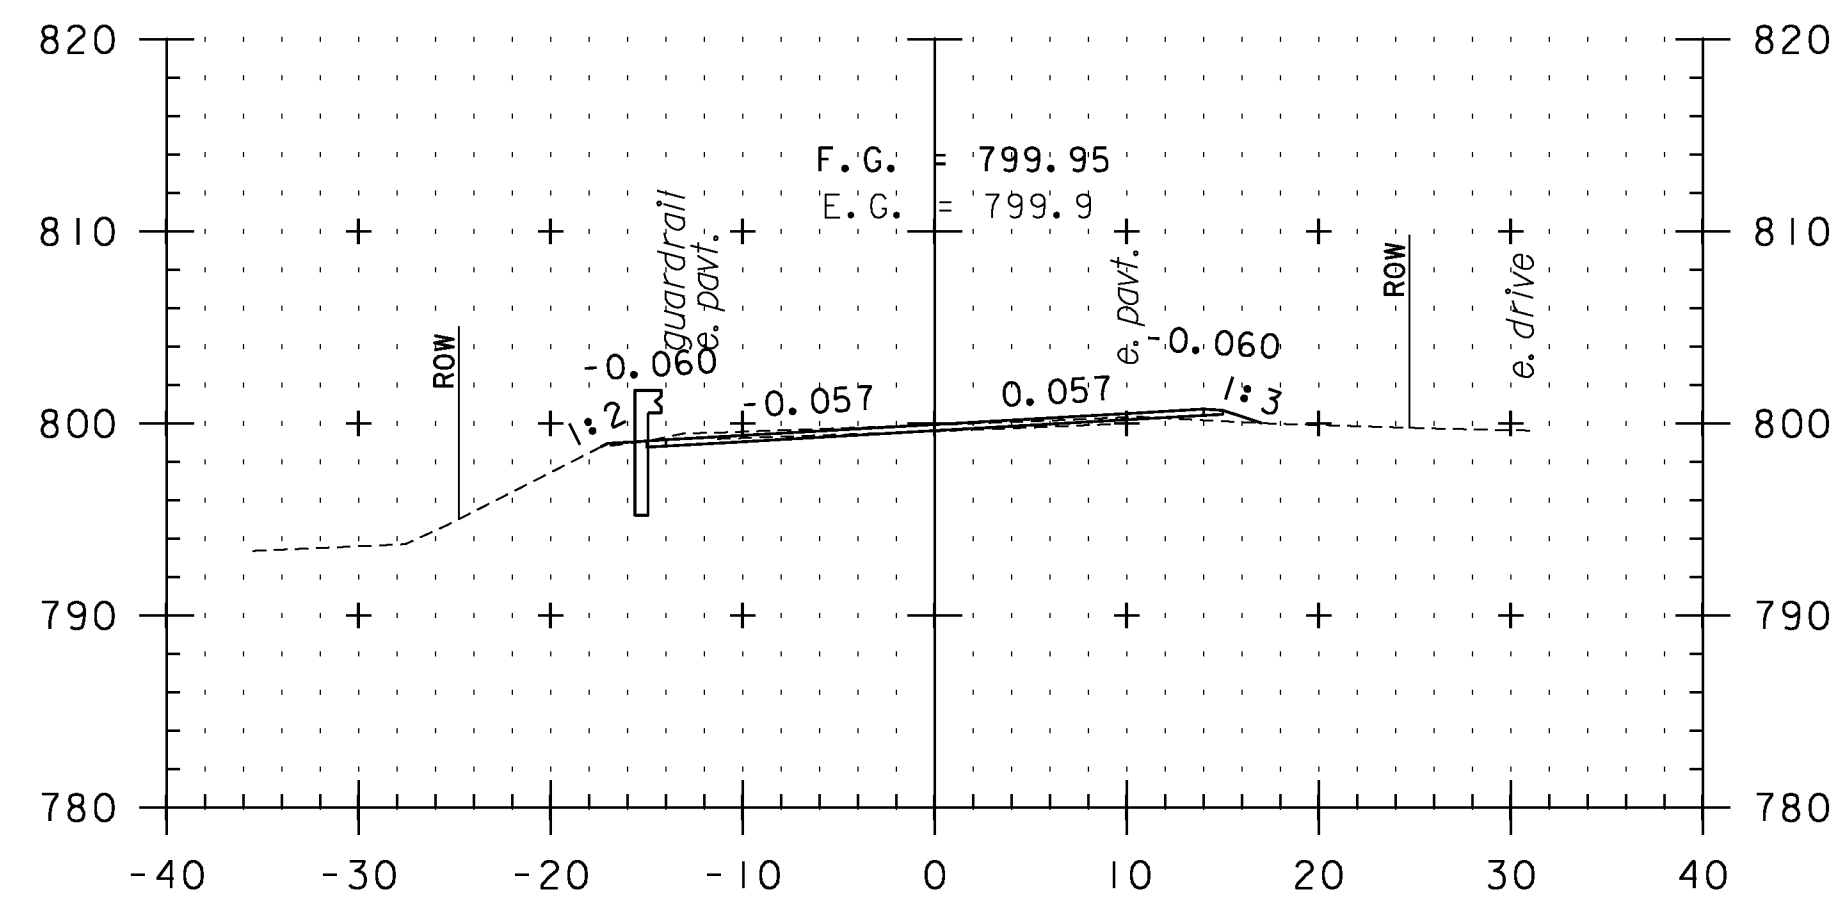


375+50

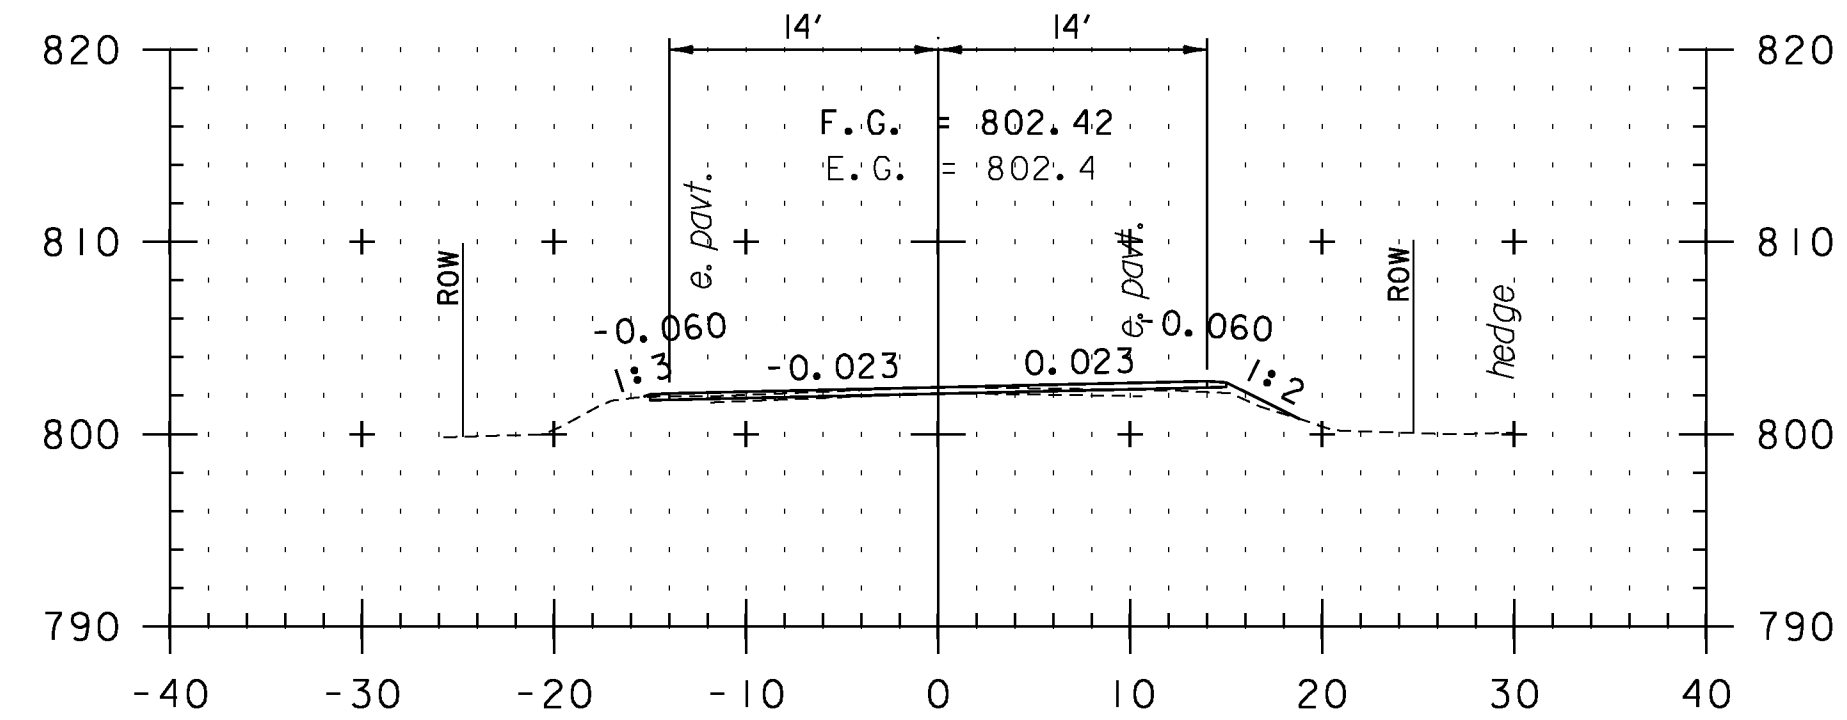

372+00

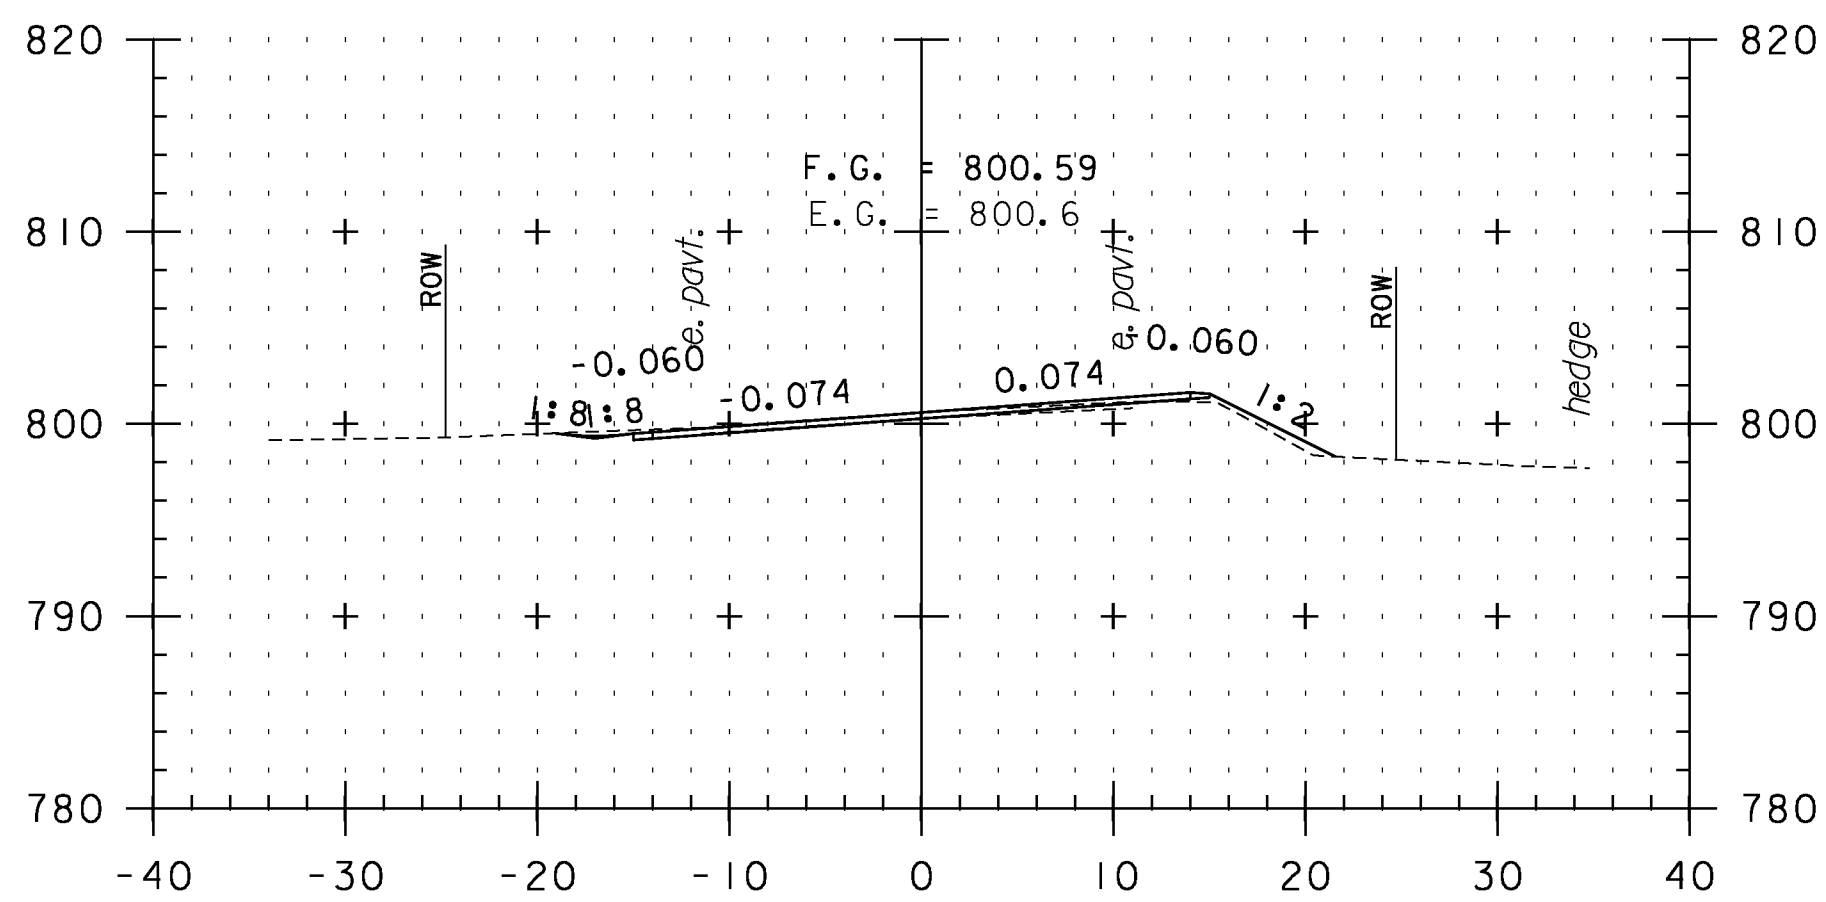


373+50

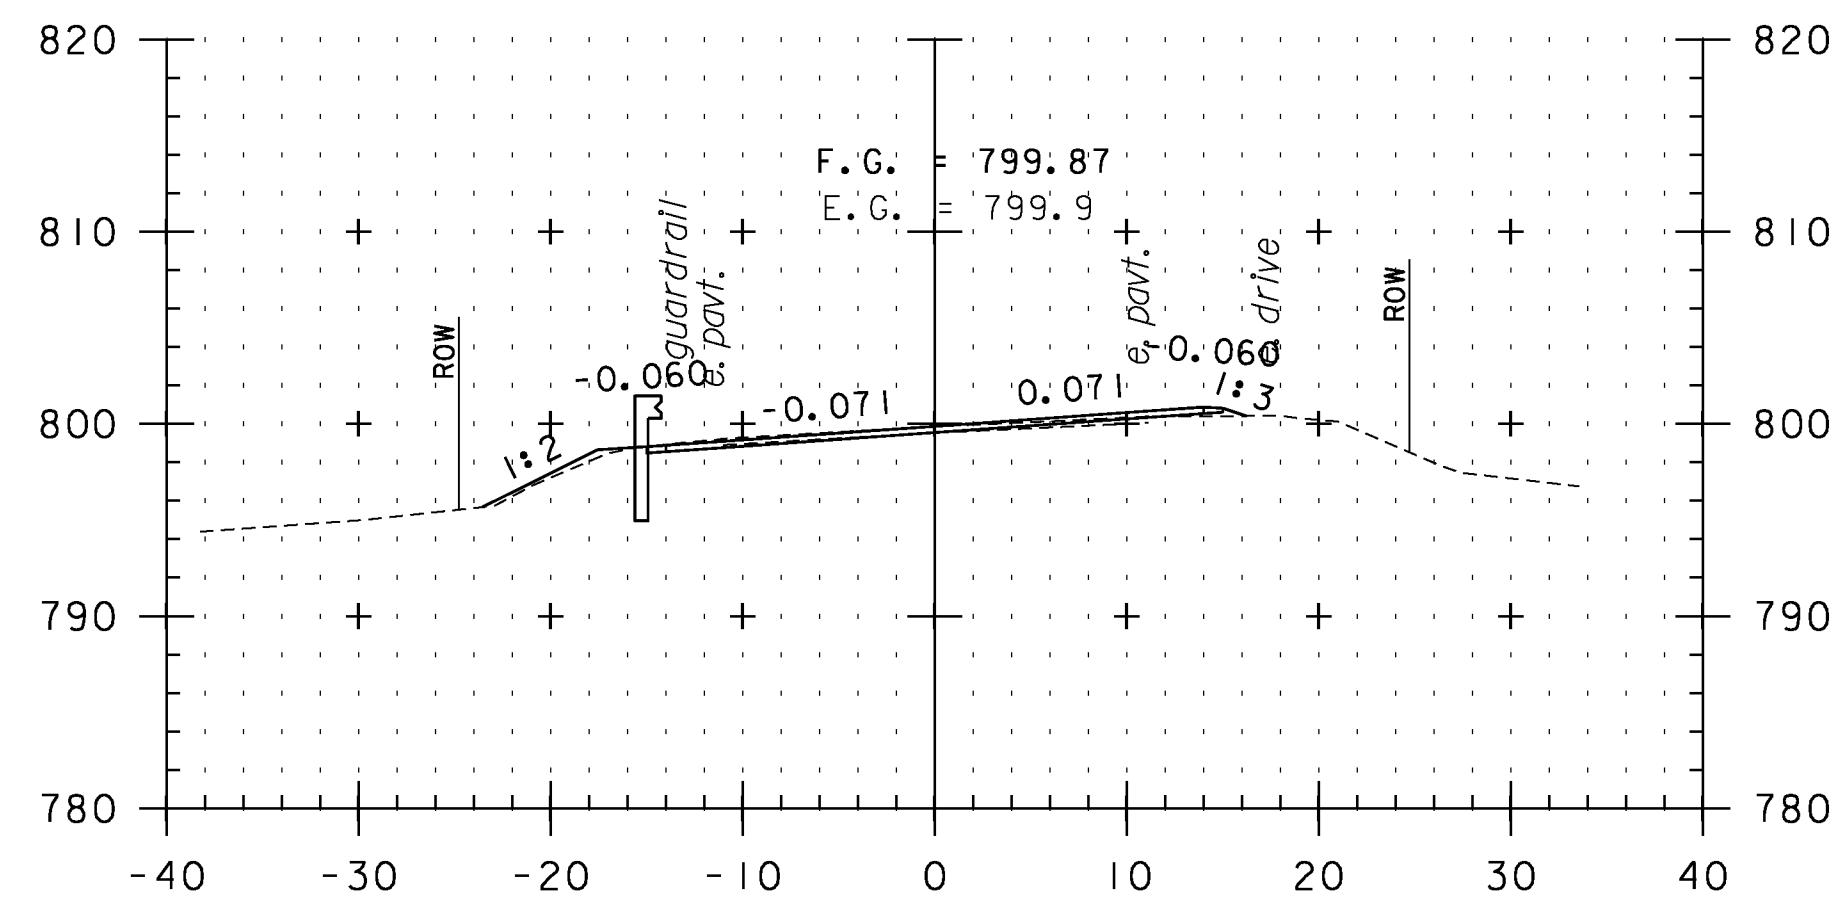

375+00

CROSS SECTION SHEET 44

STA. 372+00 TO STA. 376+00

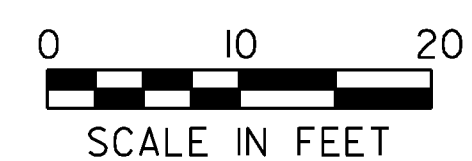

PROJECT NAME: VERSHIRE-THETFORD	PLOT DATE: 1/29/2013
PROJECT NUMBER: STP 2911(I)	DRAWN BY: SNG
FILE NAME: pl0c224.dgn	CHECKED BY: PTS
PROJECT LEADER: PTS	SHEET 152 OF 232
DESIGNED BY: NLL	
IPARM FILE NAME: IOC224_152	