




377+00
BRIDGE 20

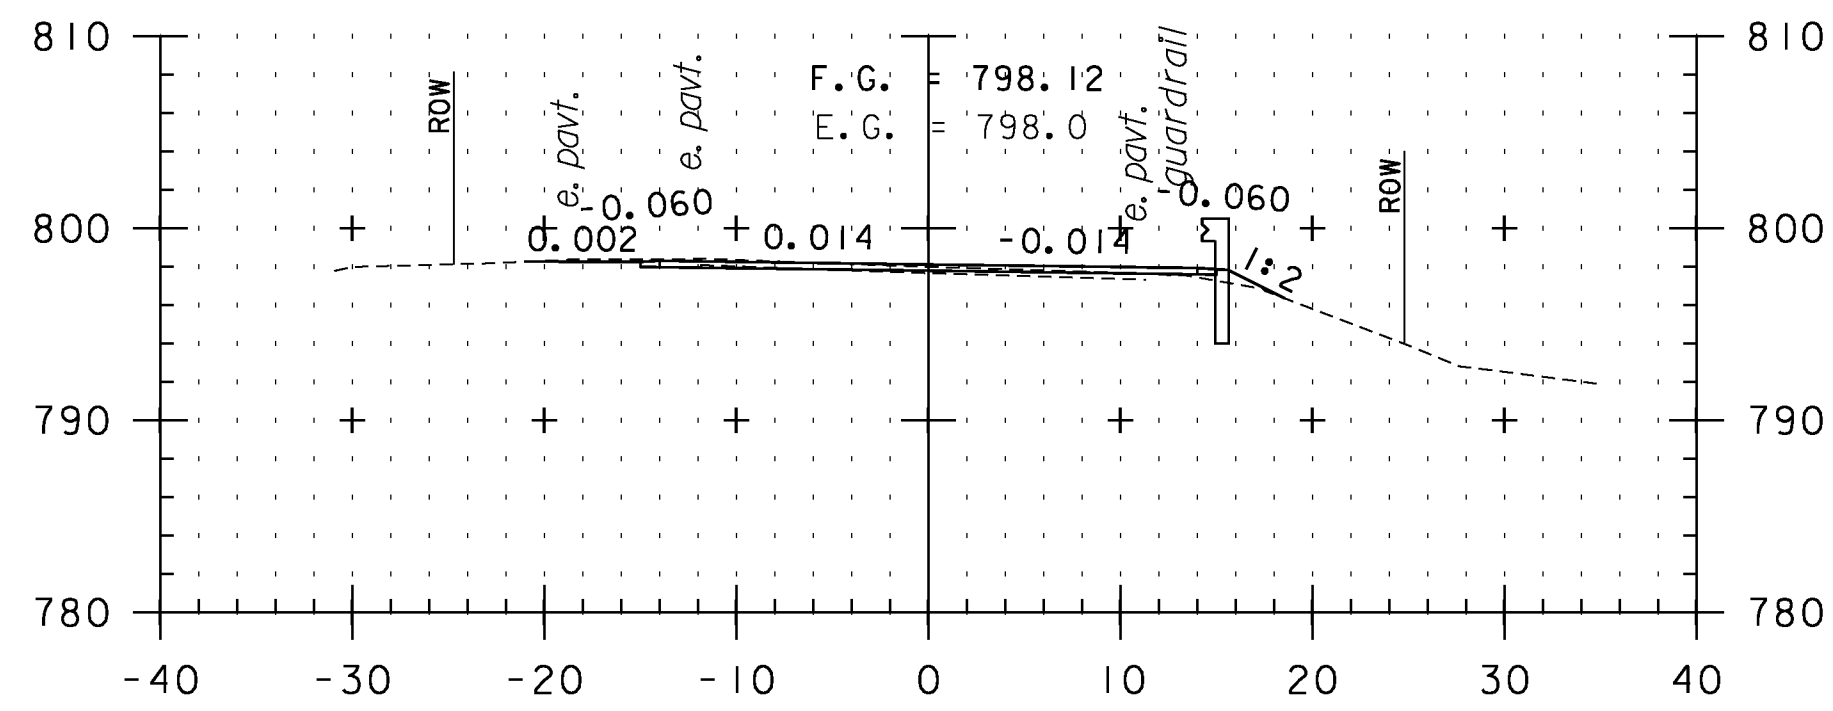


378+00

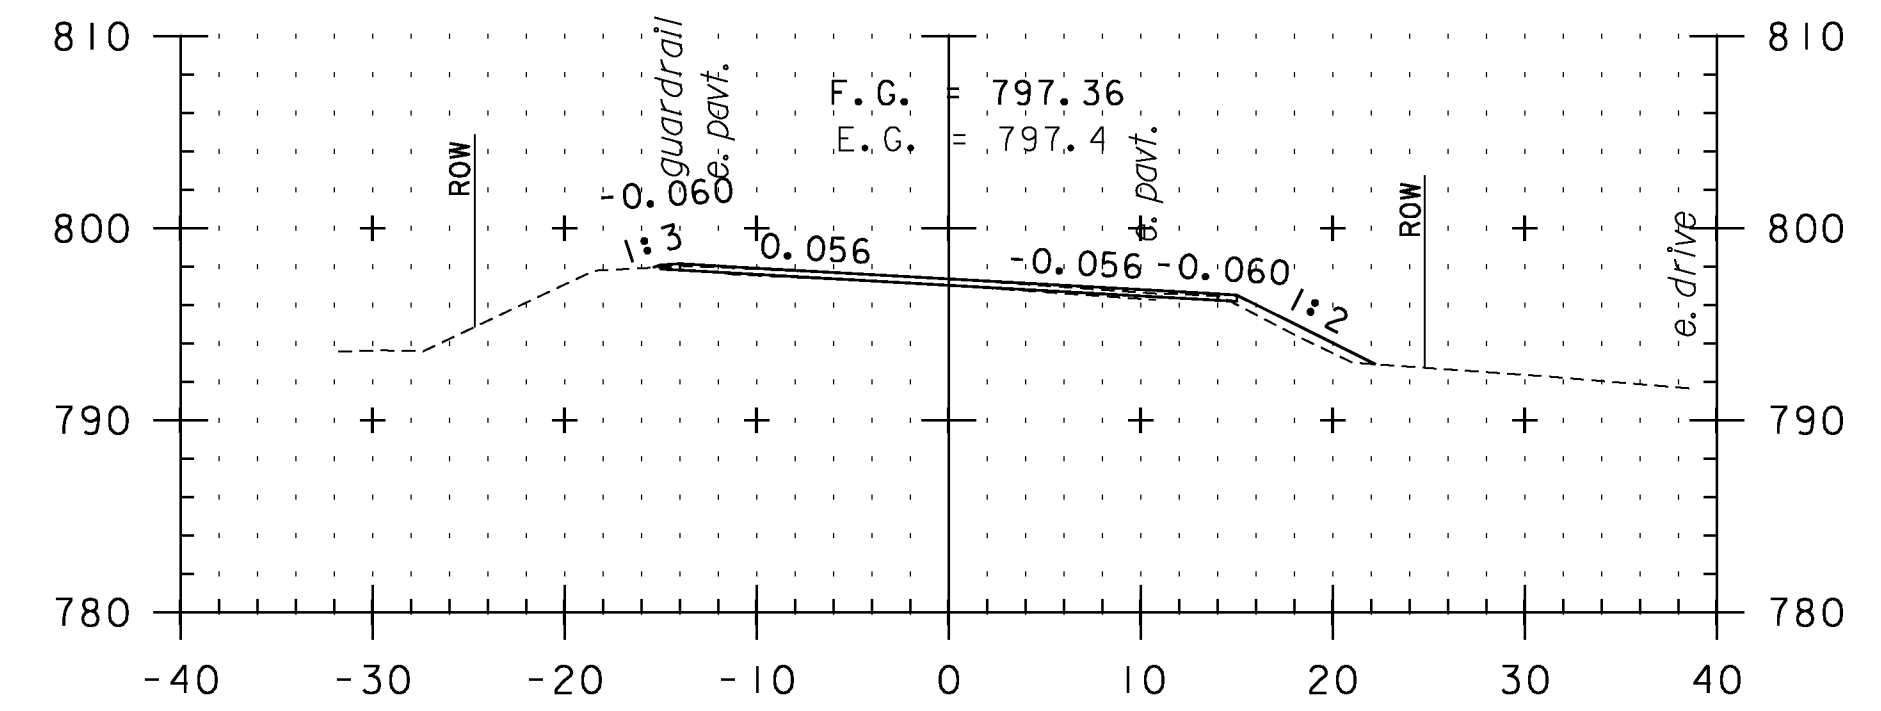


379+50

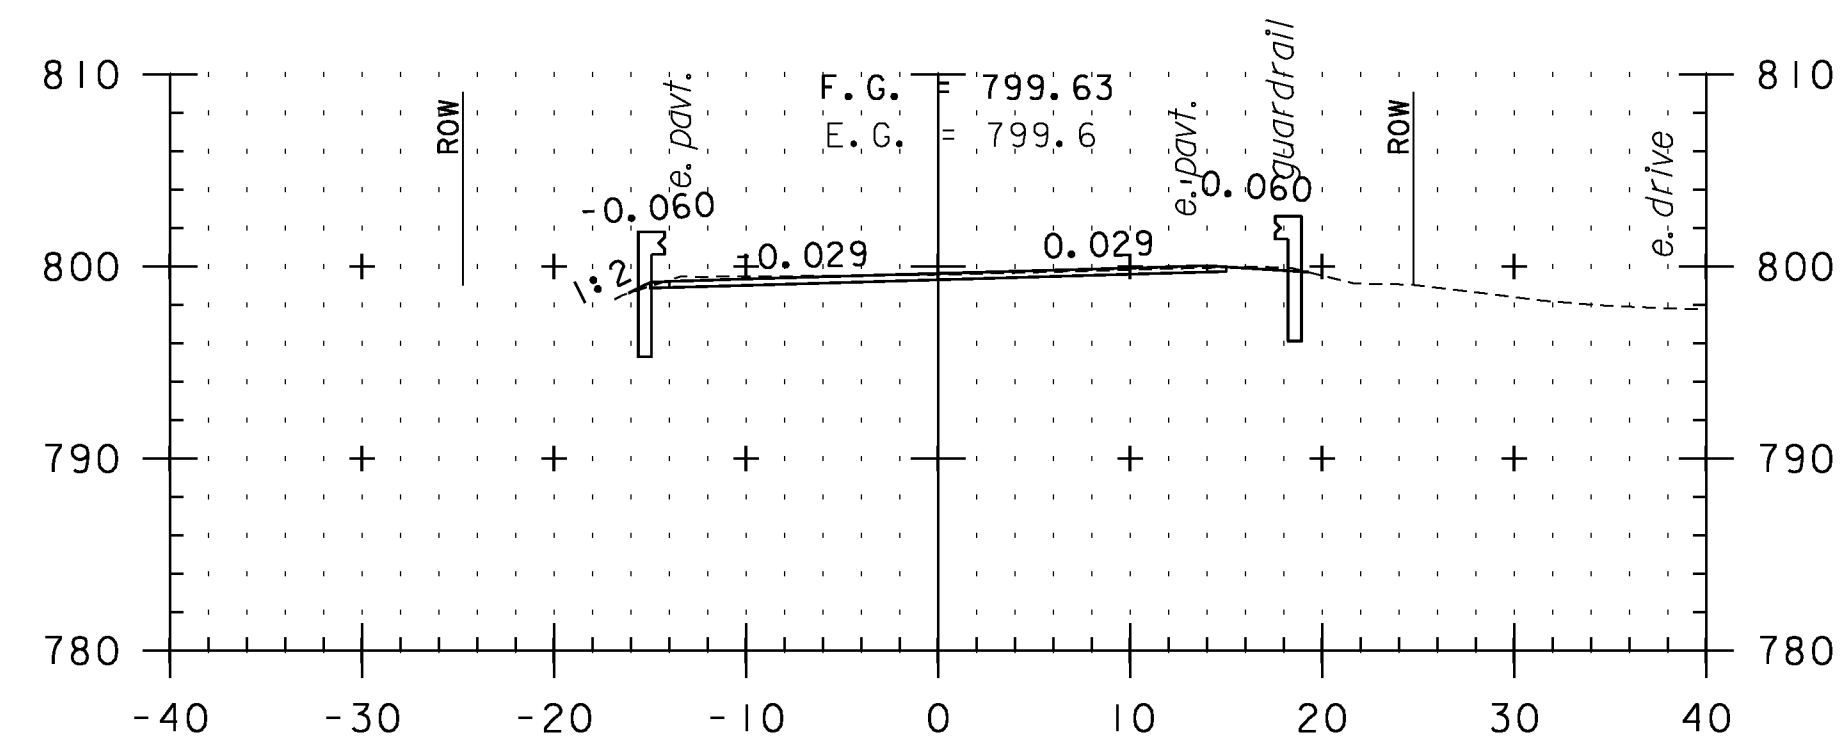


376+50
BRIDGE 20

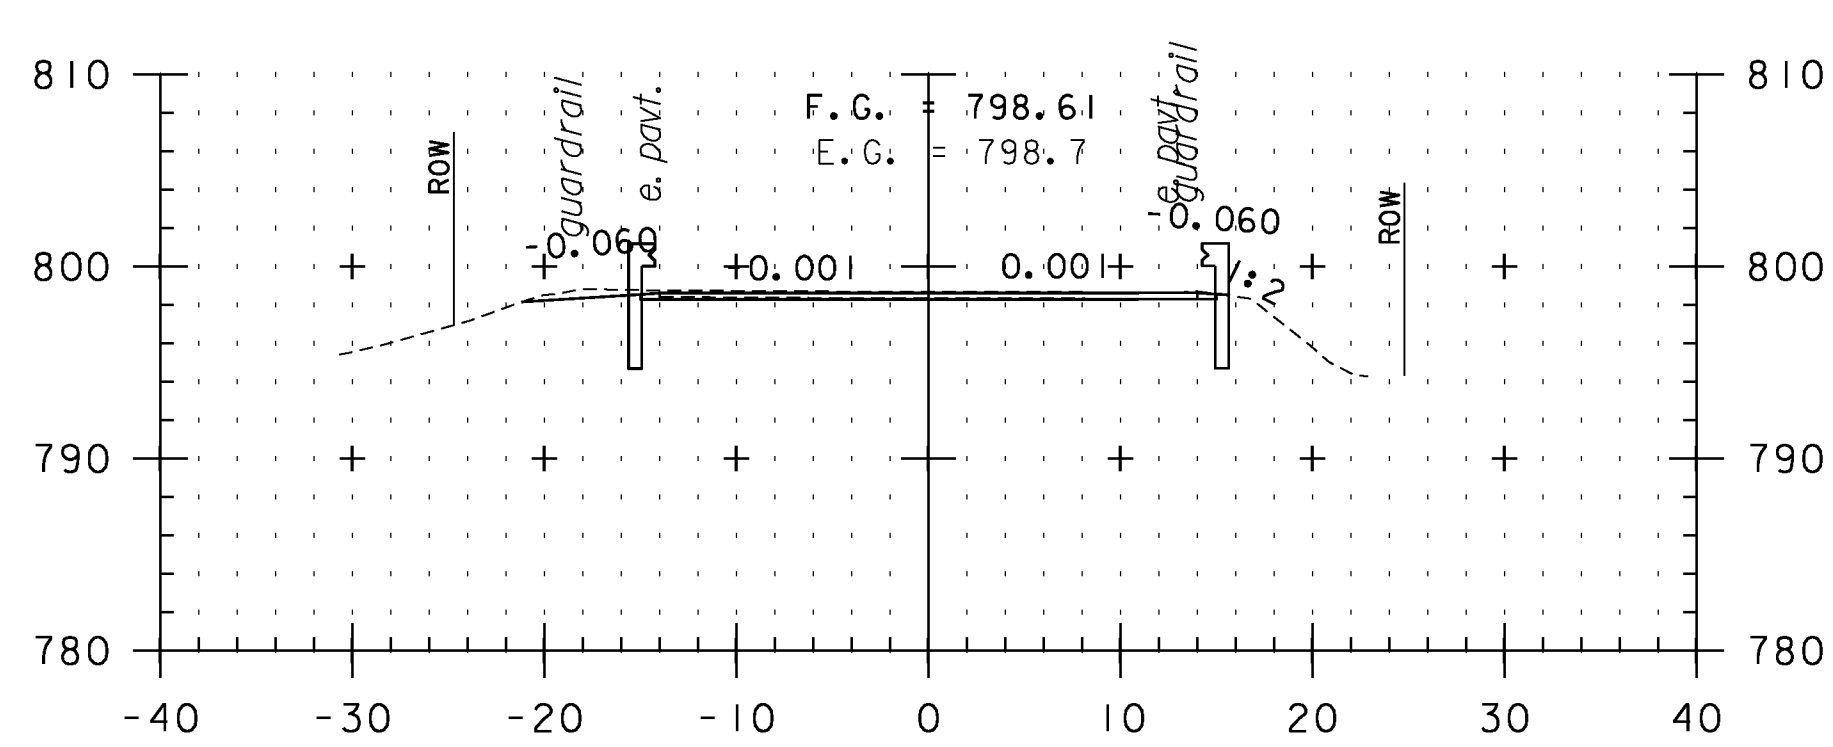


377+50

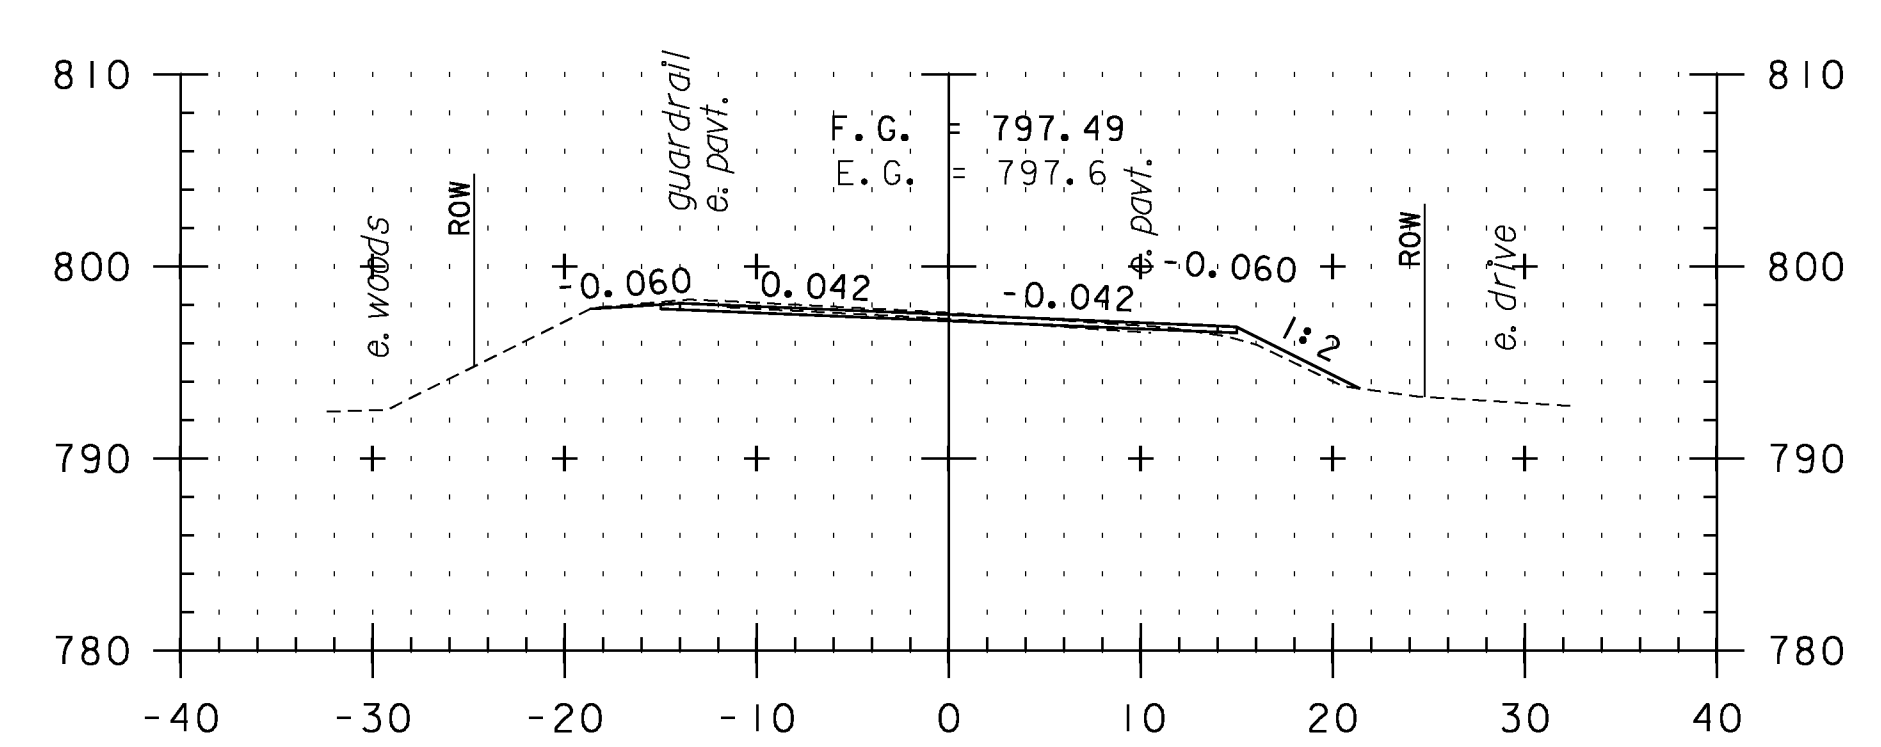


379+00

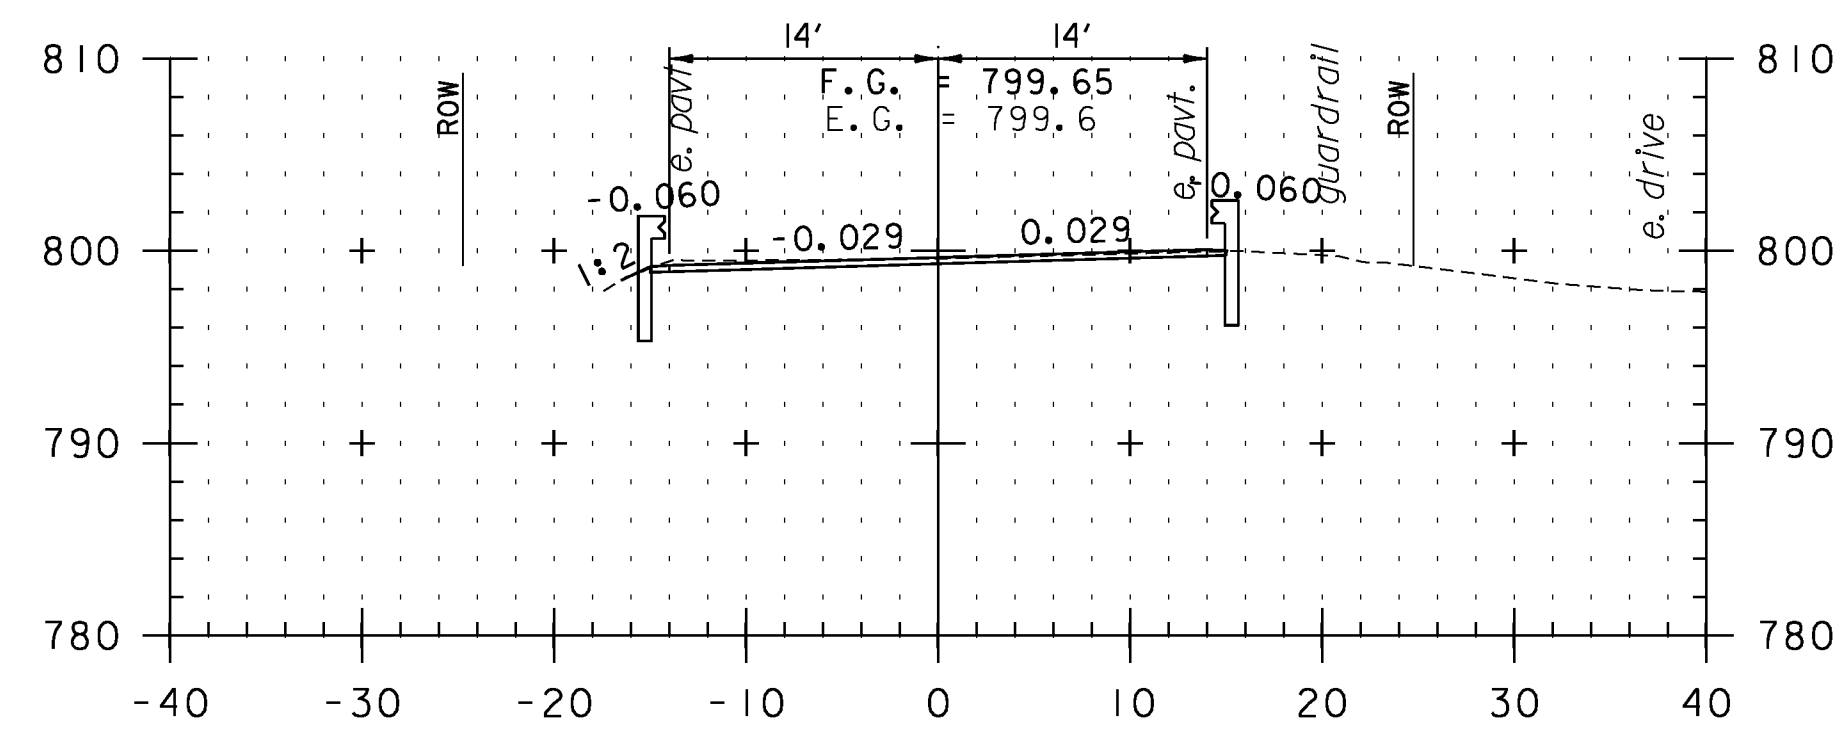

376+48
BEGIN BRIDGE 20 APPROACH

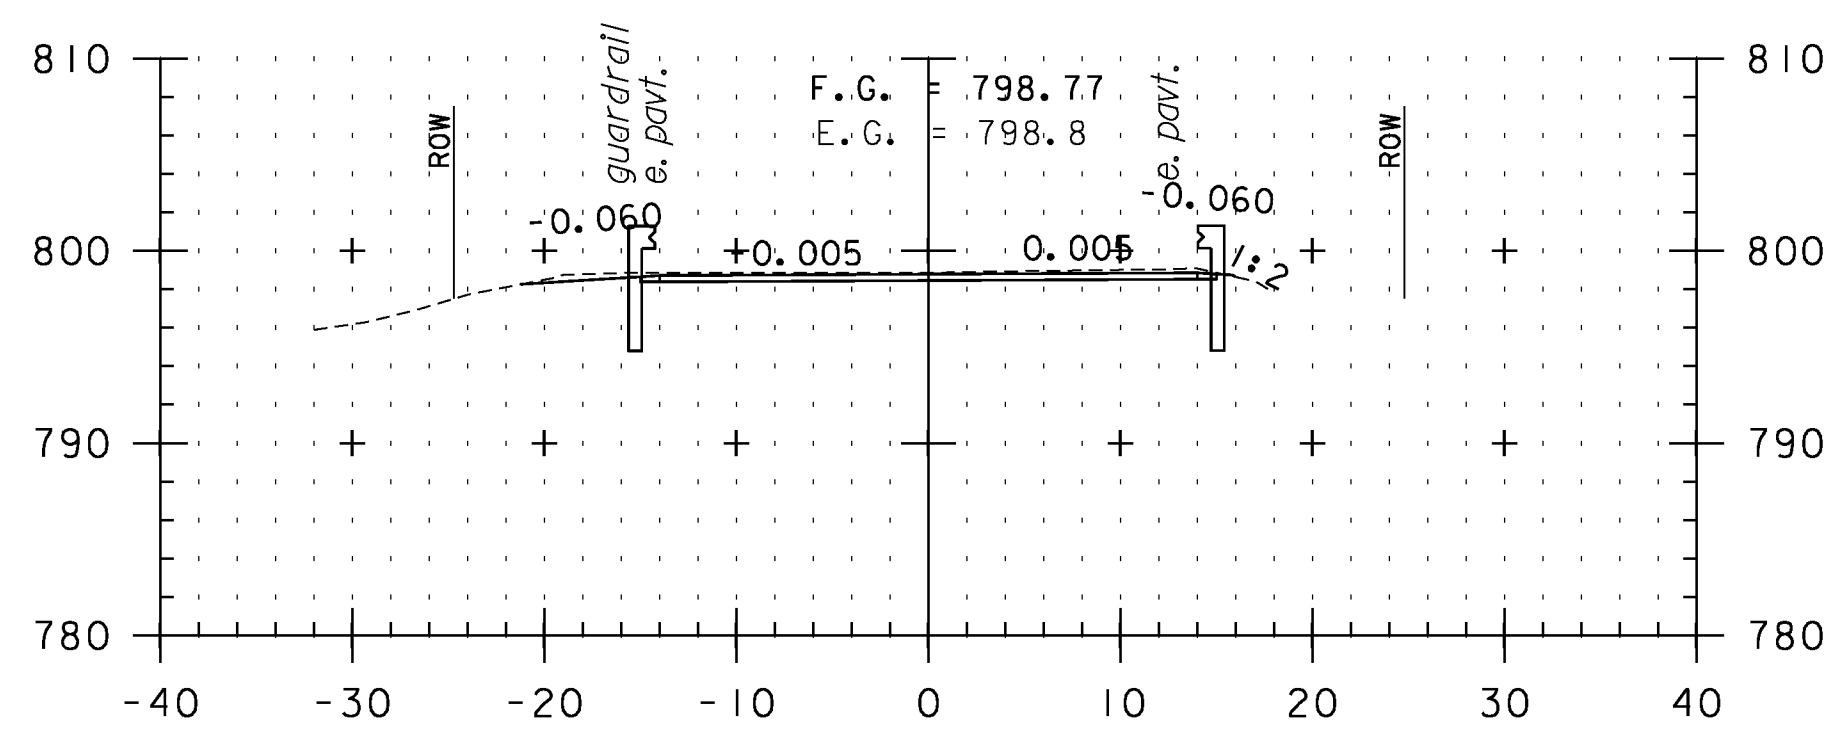

377+34
END BRIDGE 20 APPROACH

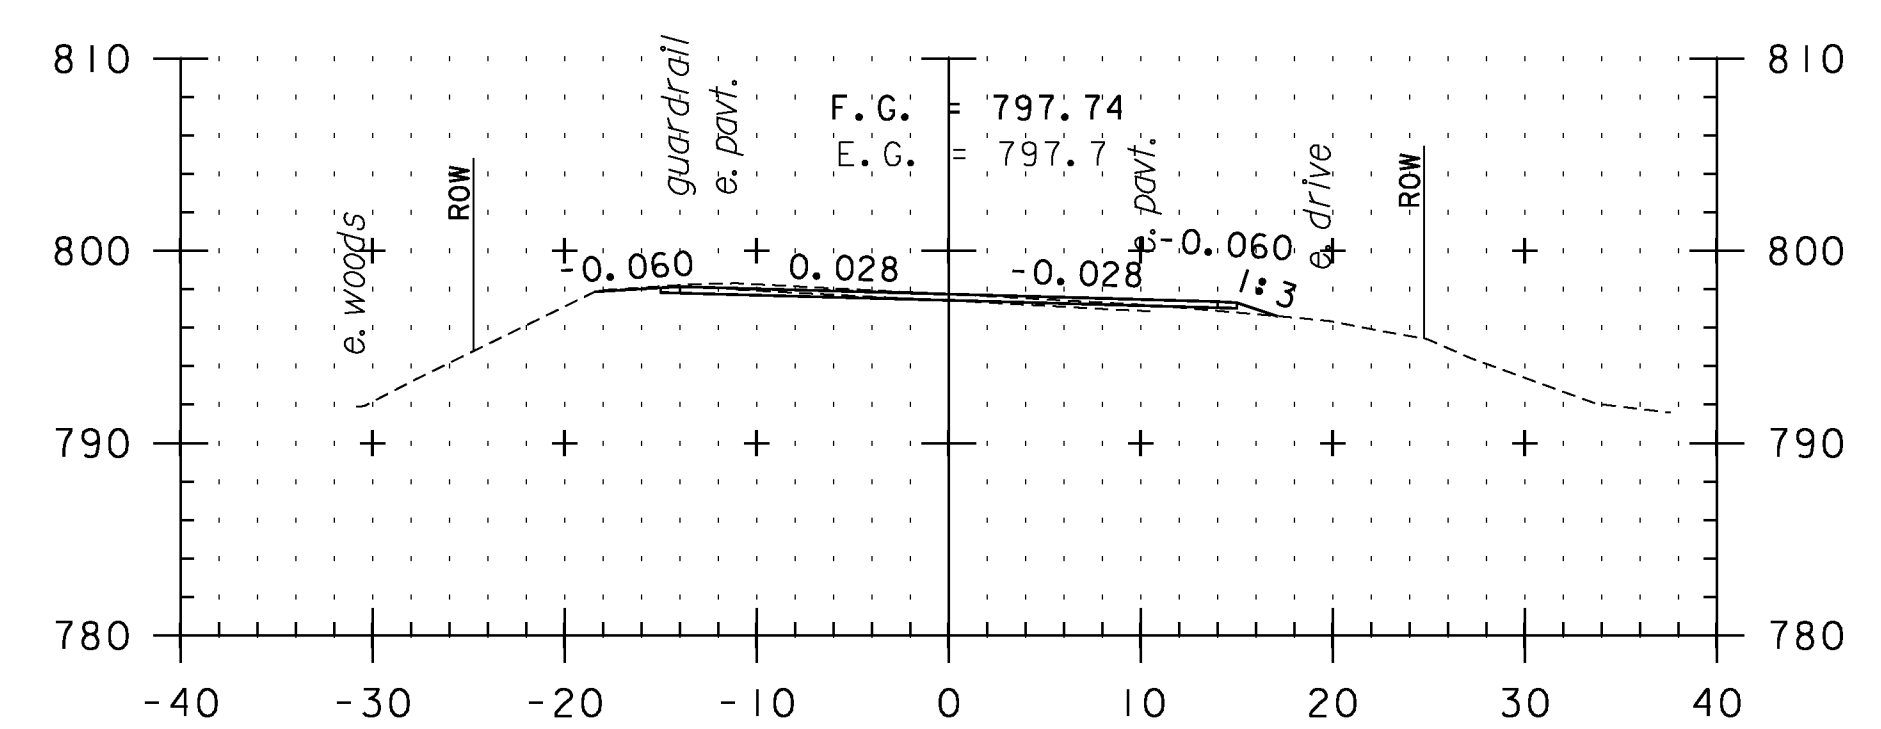

378+50

CROSS SECTION SHEET 45

PROJECT NAME: VERSHIRE-THETFORD

PROJECT NUMBER: STP 2911(I)

FILE NAME: pl0c224.dgn

PLOT DATE: 1/29/2013

PROJECT LEADER: PTS

DRAWN BY: SNG

DESIGNED BY: NLL

CHECKED BY: PTS

IPARM FILE NAME: IOC224_I53

SHEET 153 OF 232

STA. 376+48 TO STA. 379+50

