




381+00

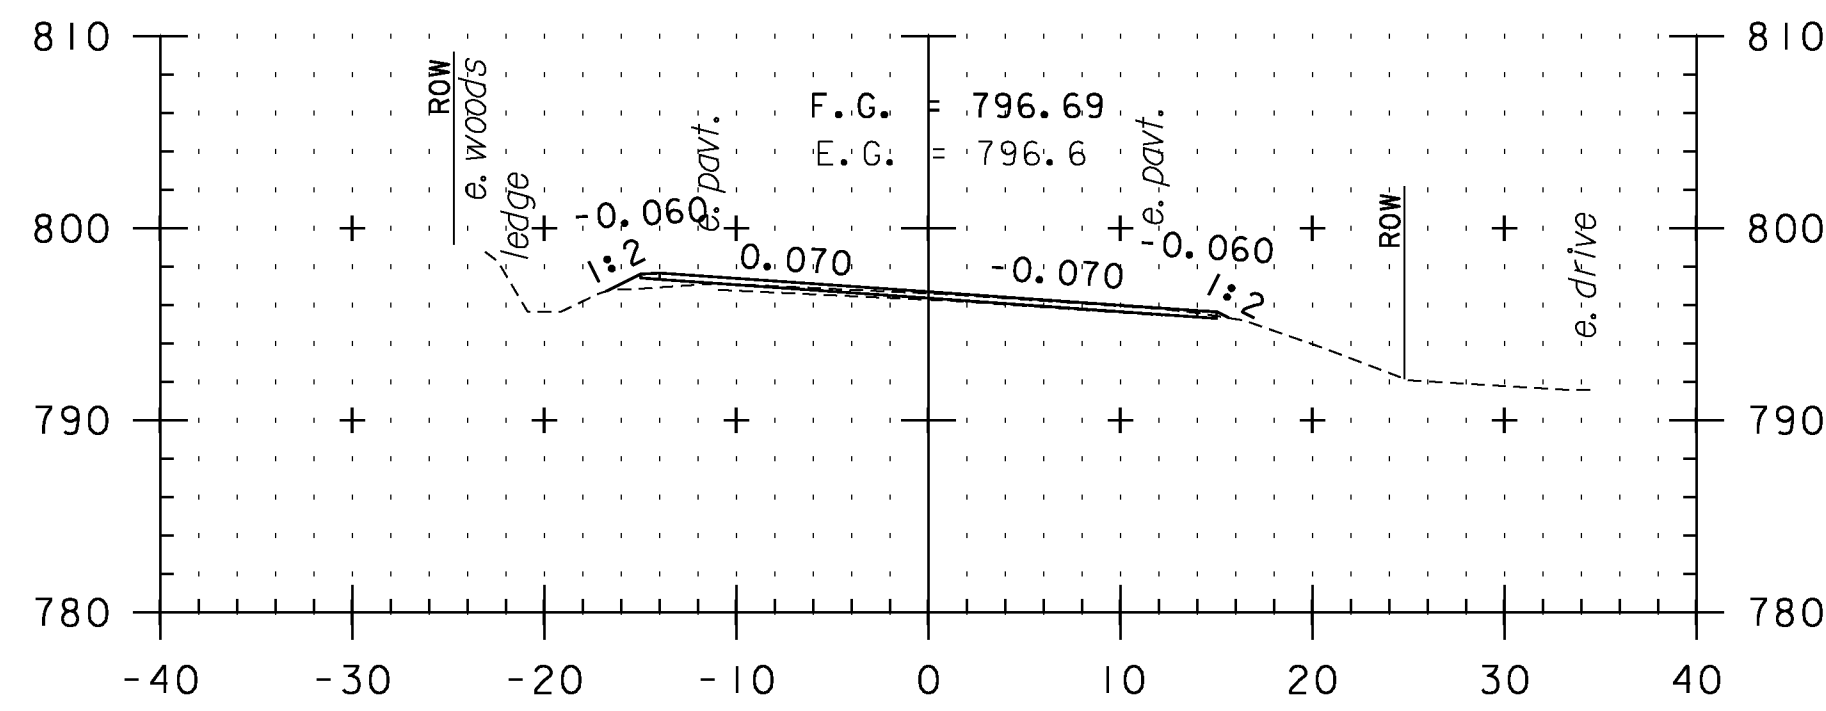


382+50

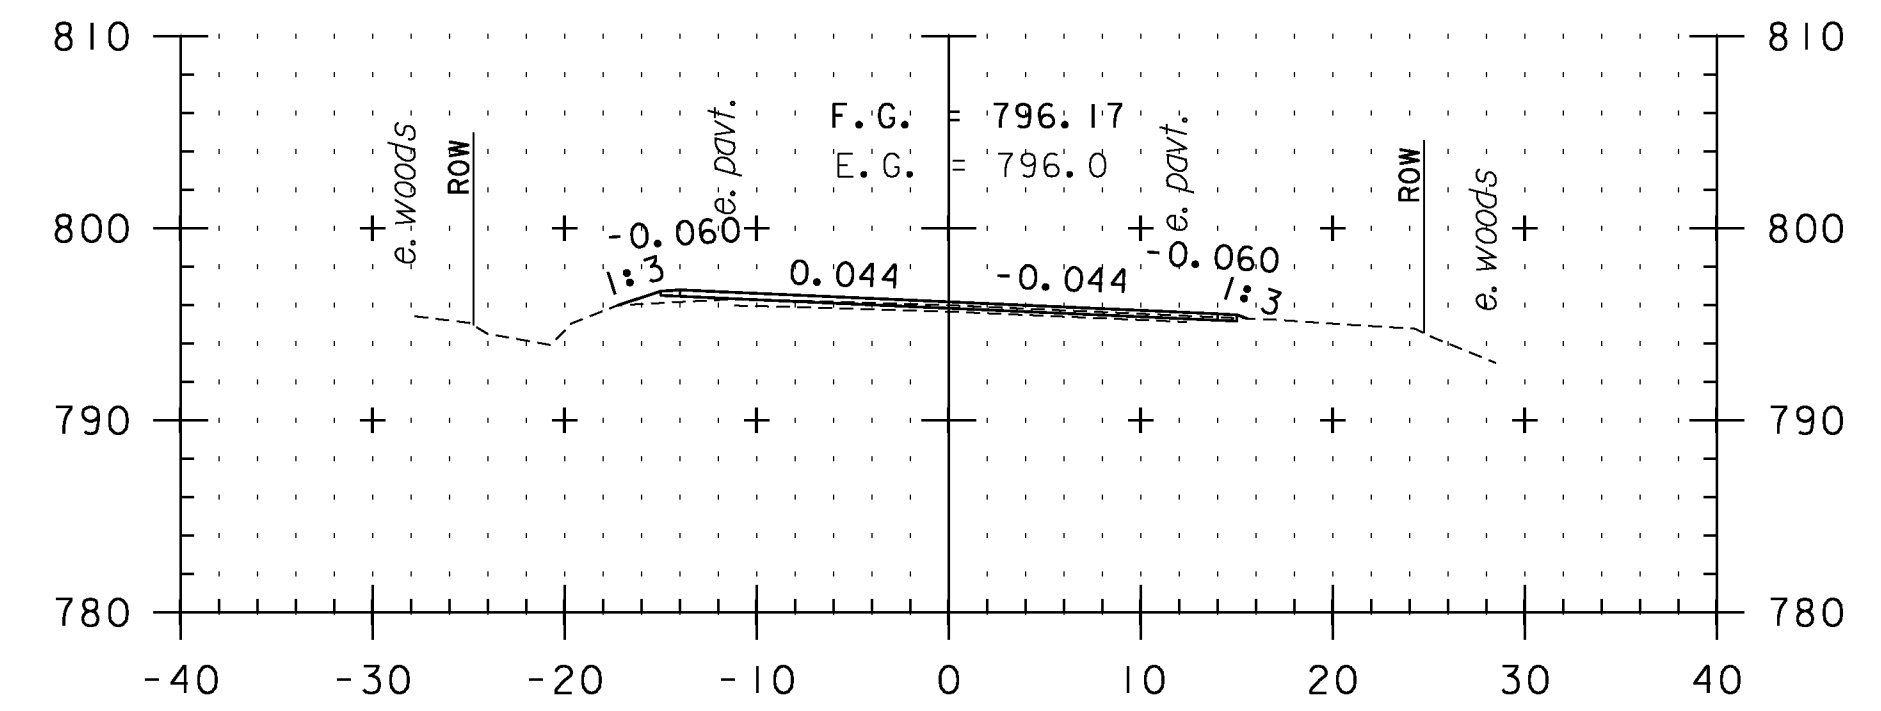


384+00

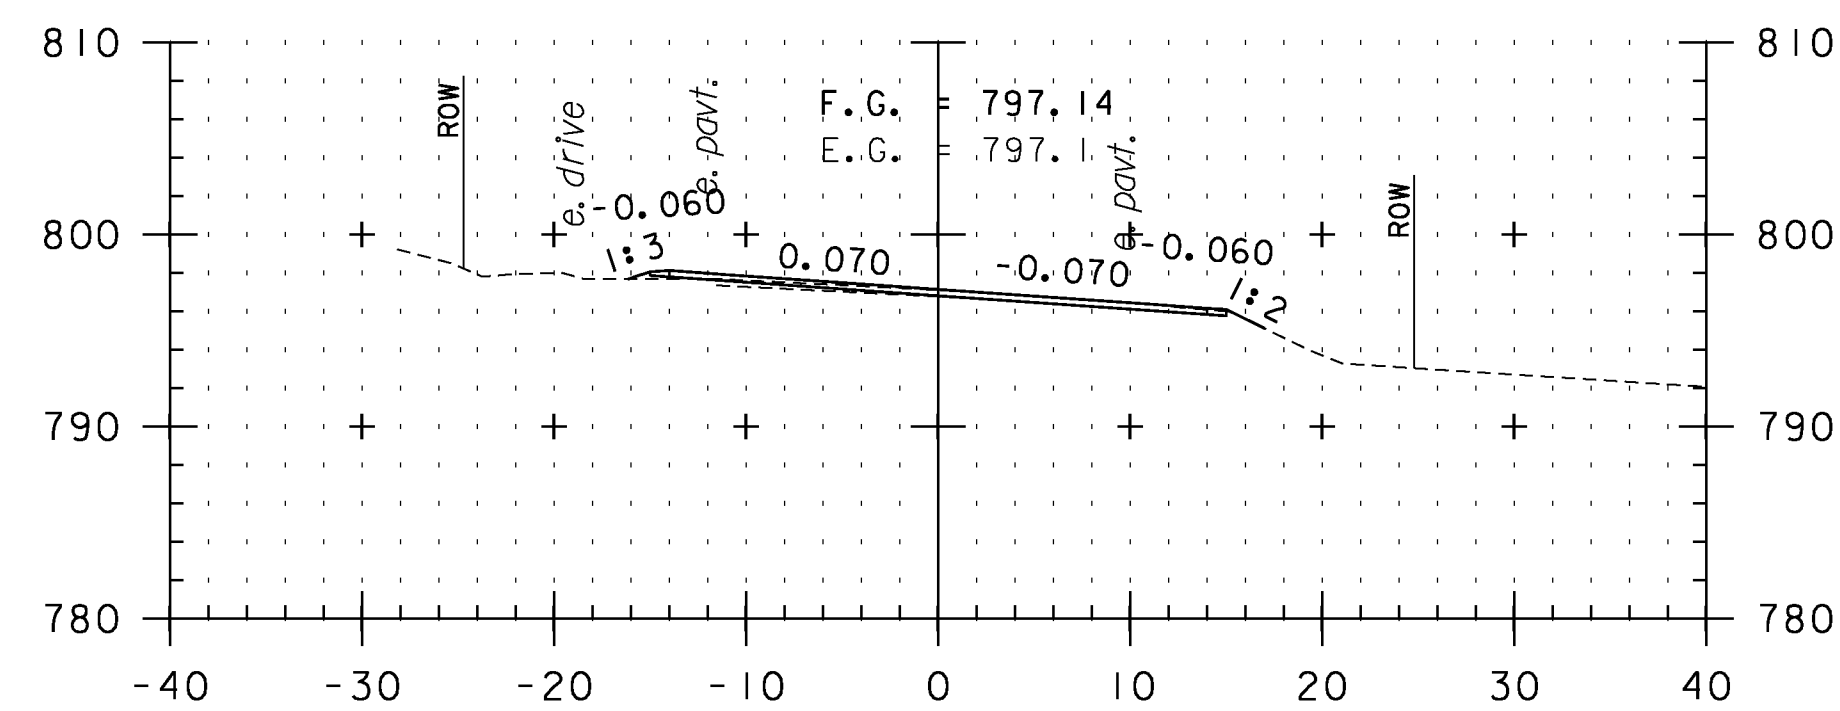


380+50

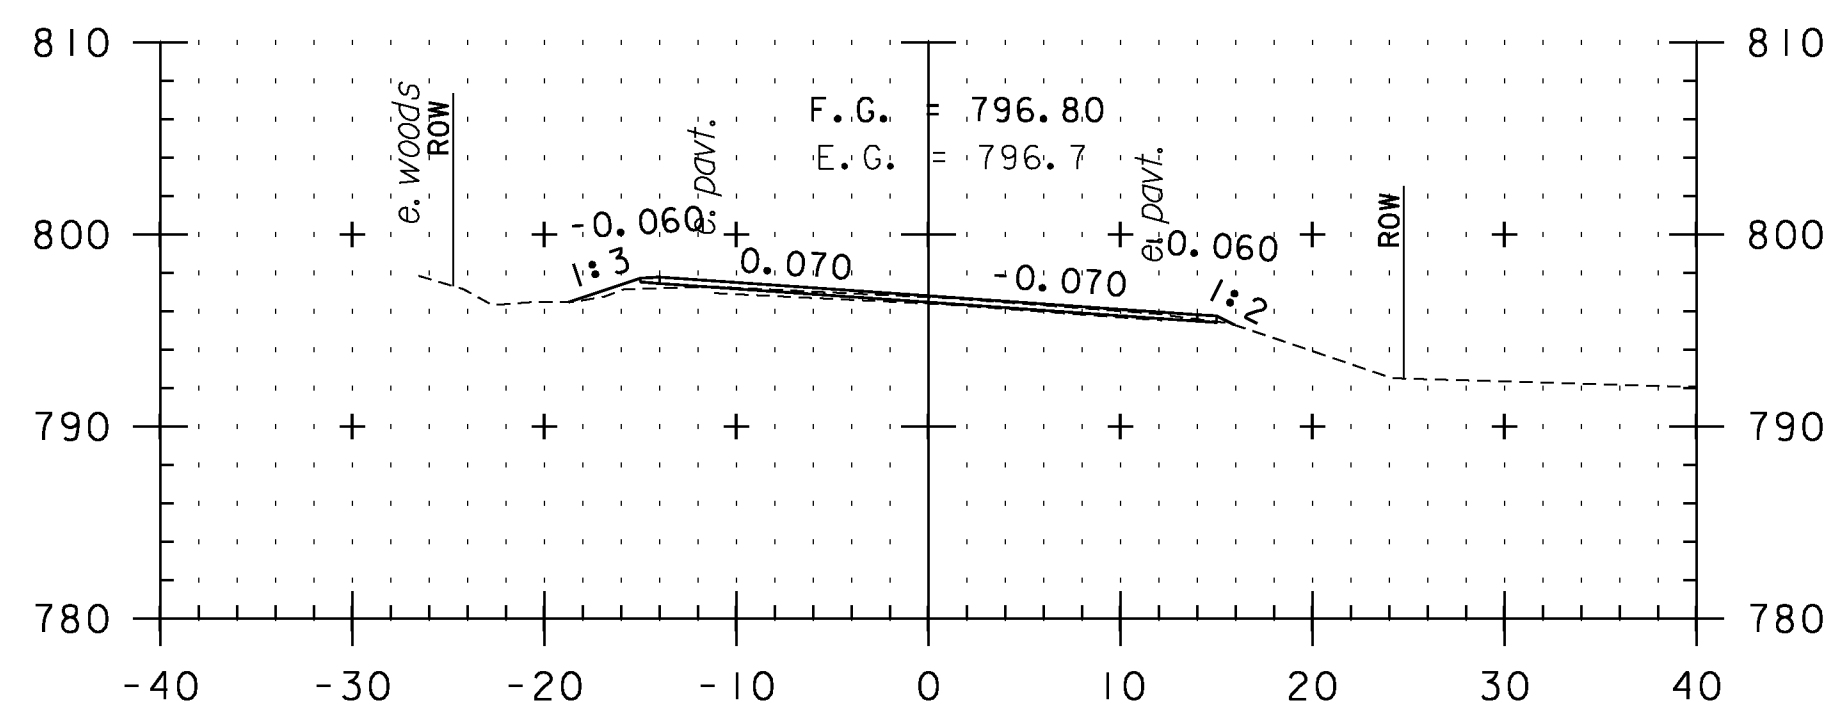


382+00

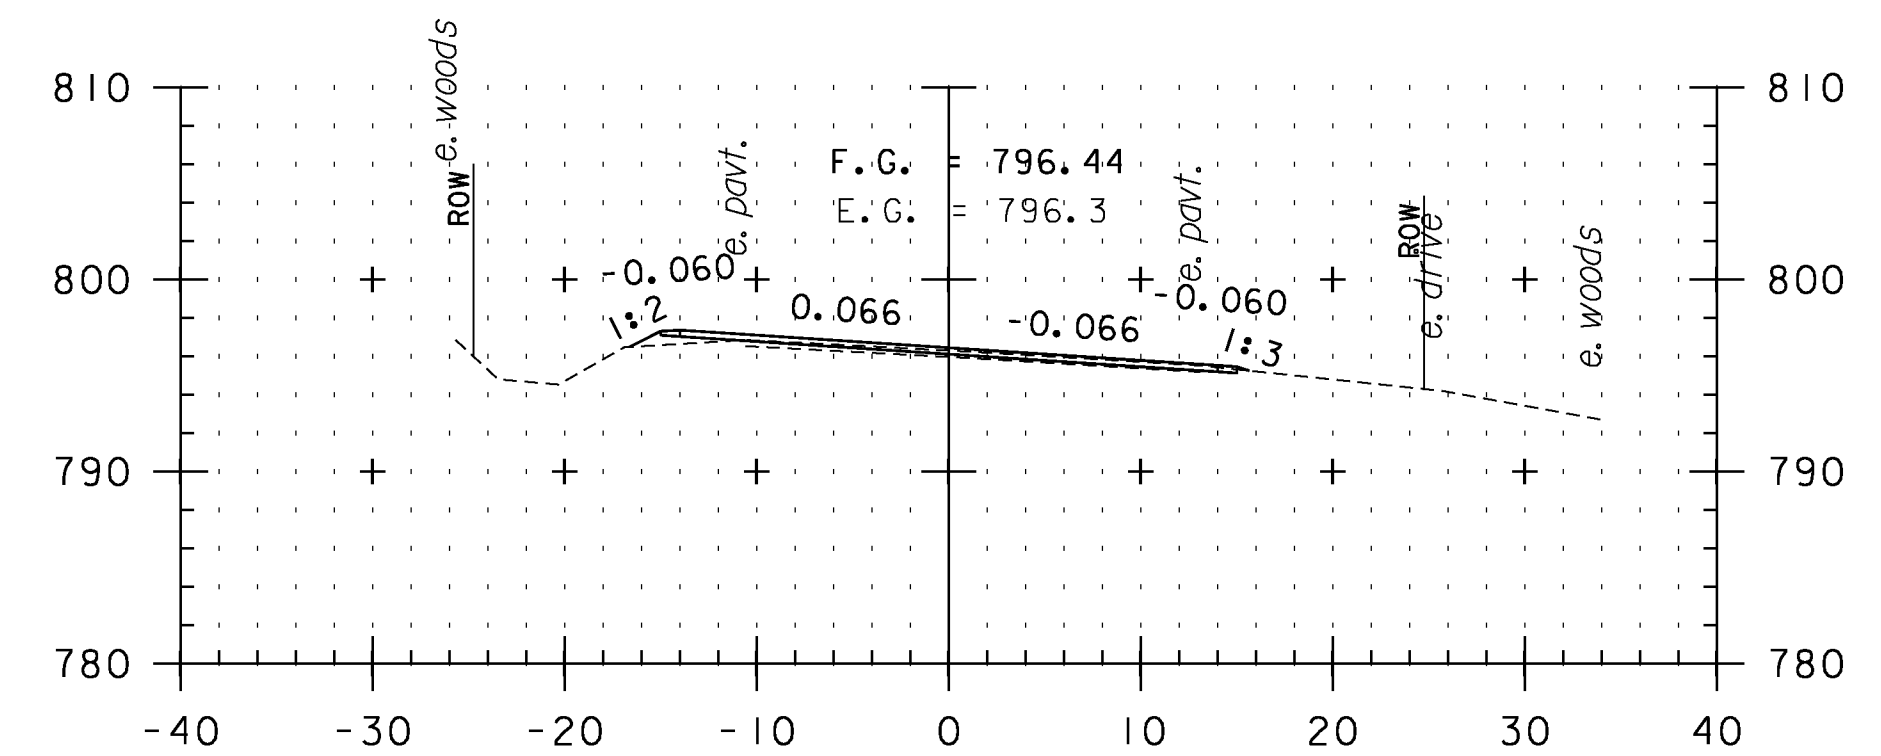


383+50

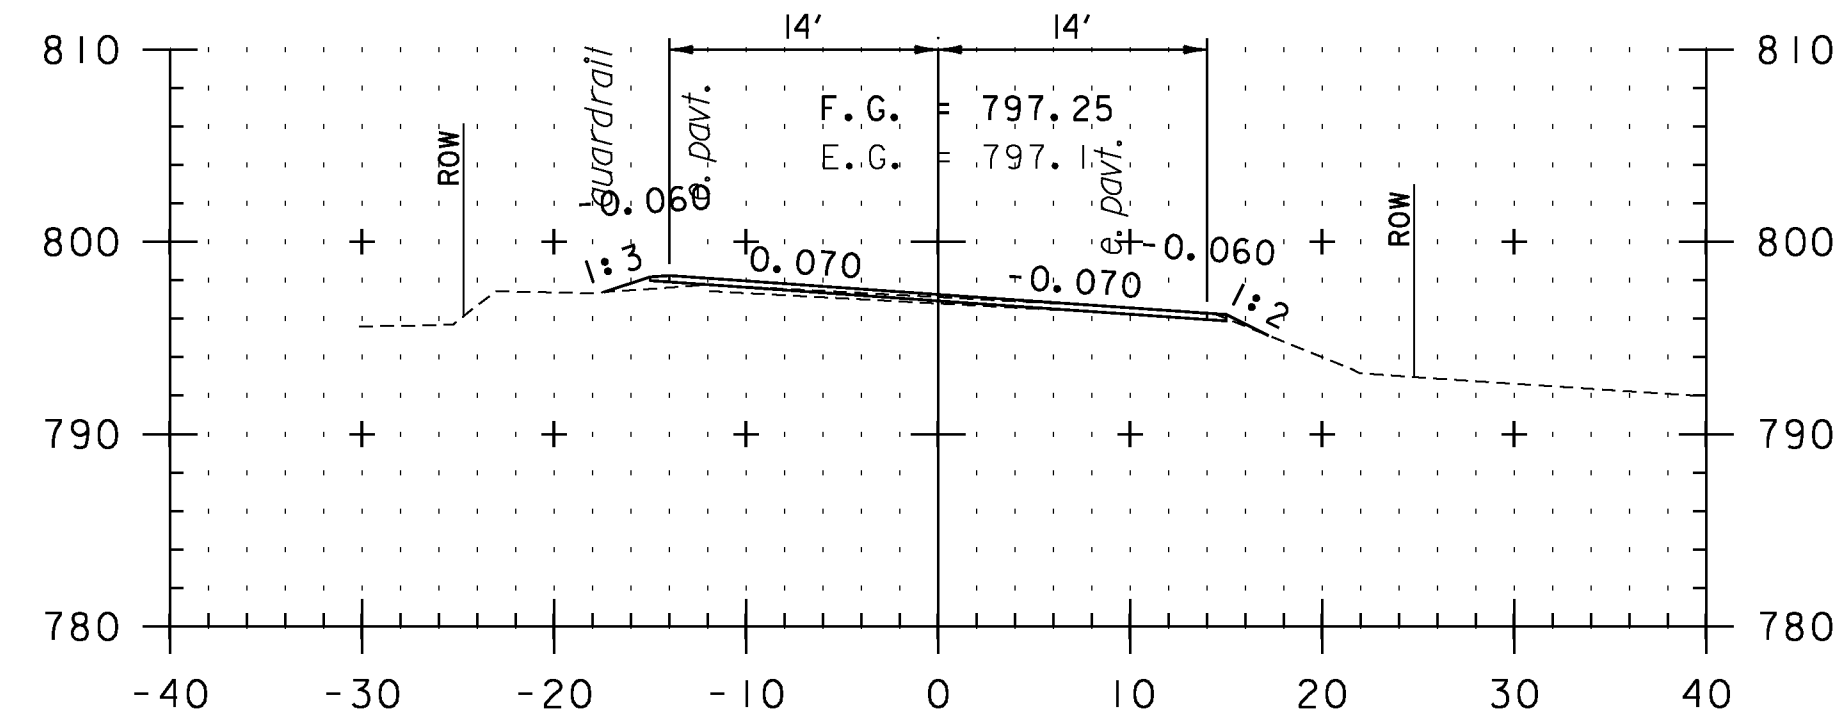

380+00

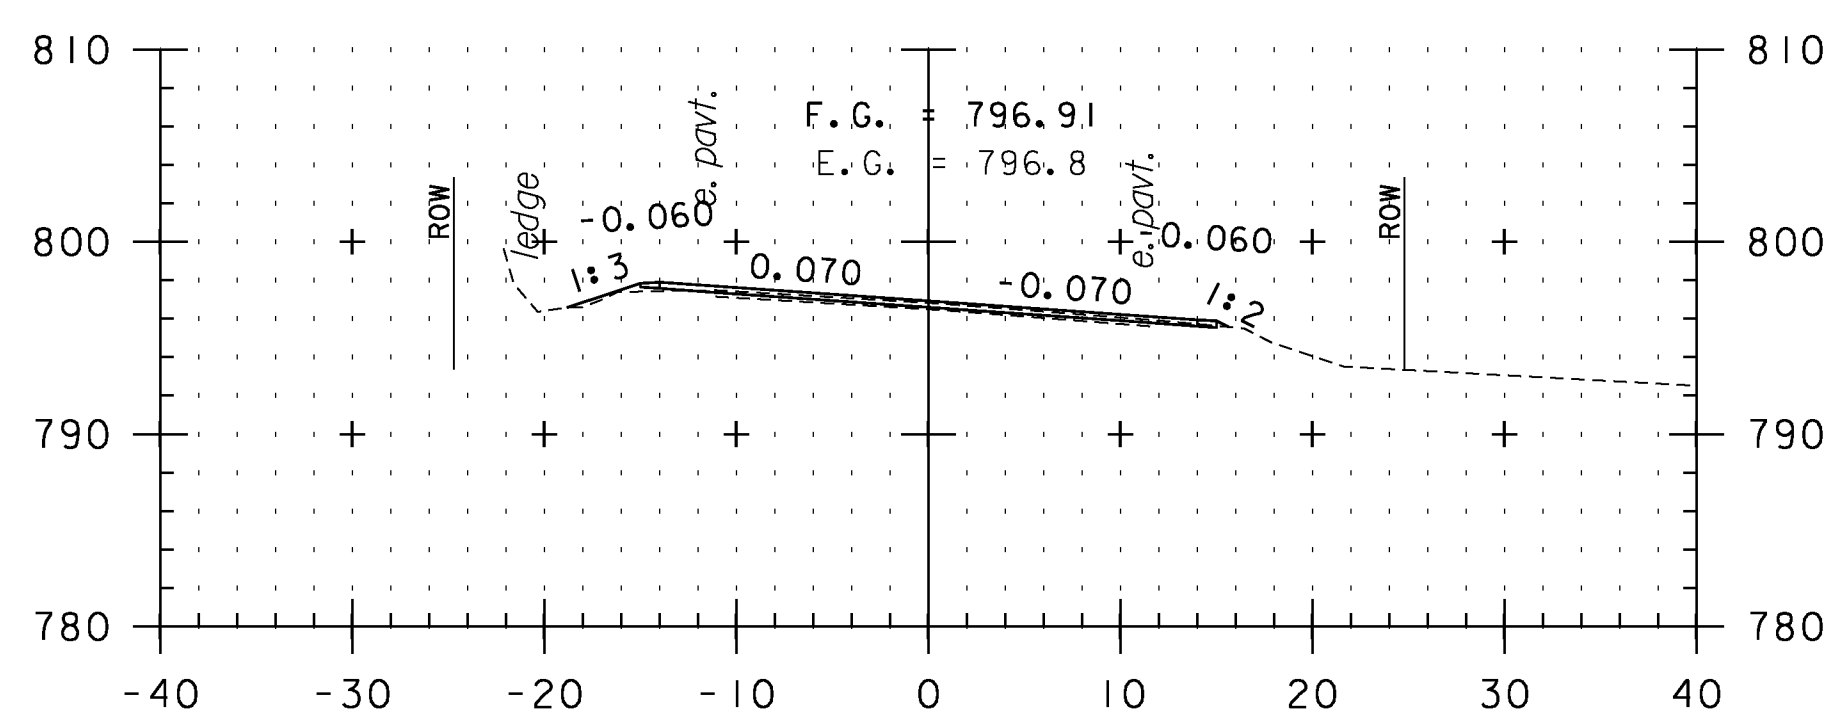


381+50

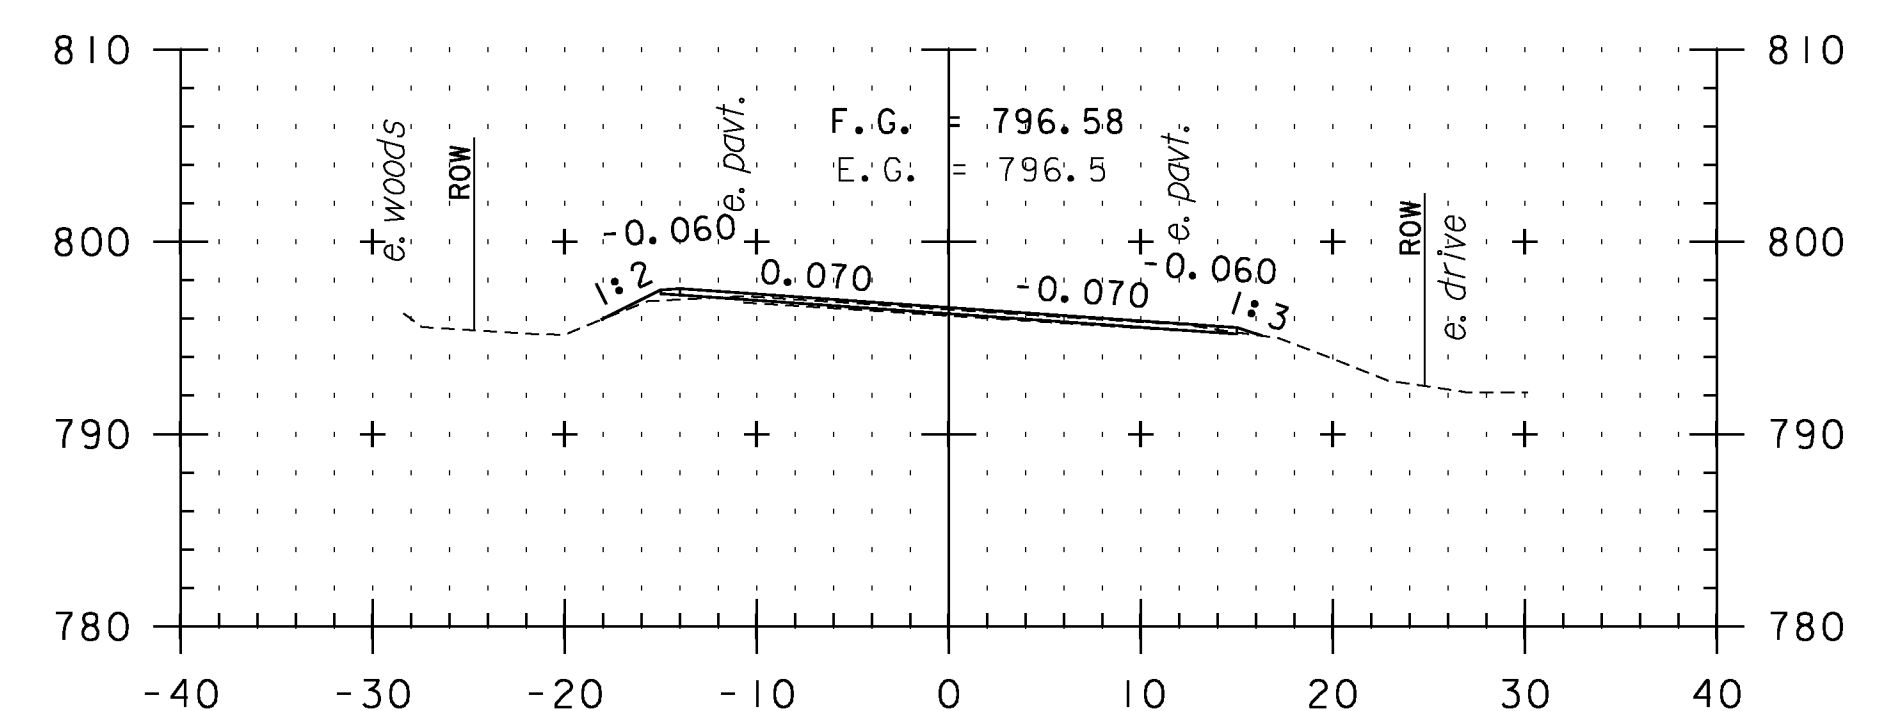

383+00

CROSS SECTION SHEET 46

STA. 380+00 TO STA. 384+00

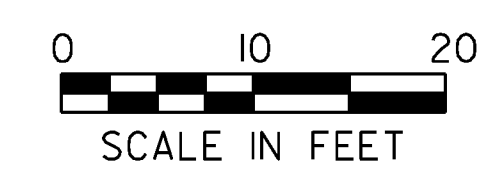

PROJECT NAME: VERSHIRE-THETFORD	PLOT DATE: 1/29/2013
PROJECT NUMBER: STP 2911(I)	DRAWN BY: SNG
FILE NAME: pl0c224.dgn	CHECKED BY: PTS
PROJECT LEADER: PTS	SHEET 154 OF 232
DESIGNED BY: NLL	
IPARM FILE NAME: IOC224_154	