




385+50

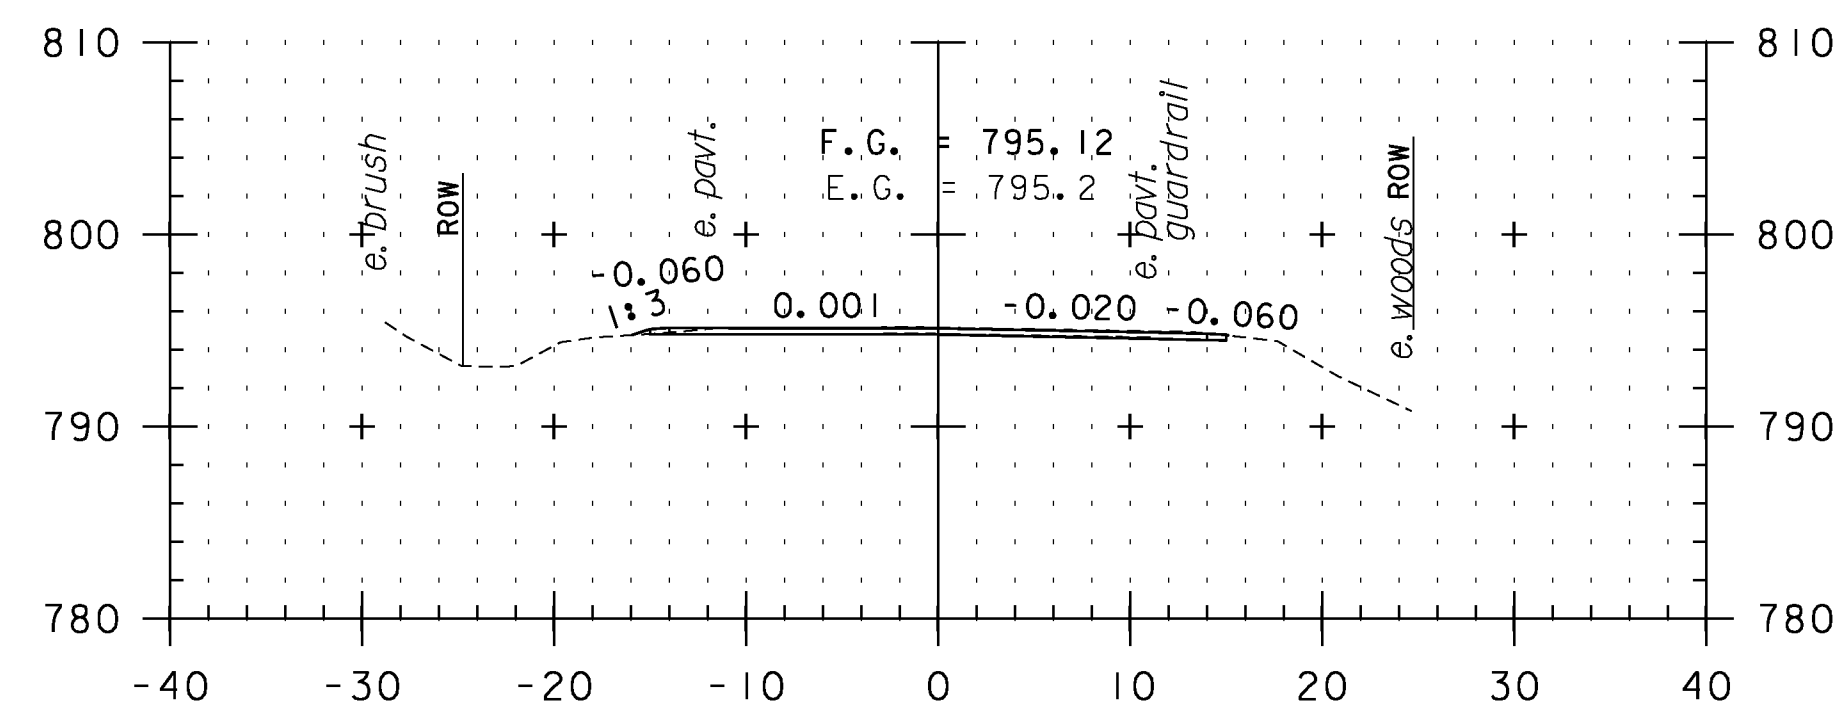


385+00

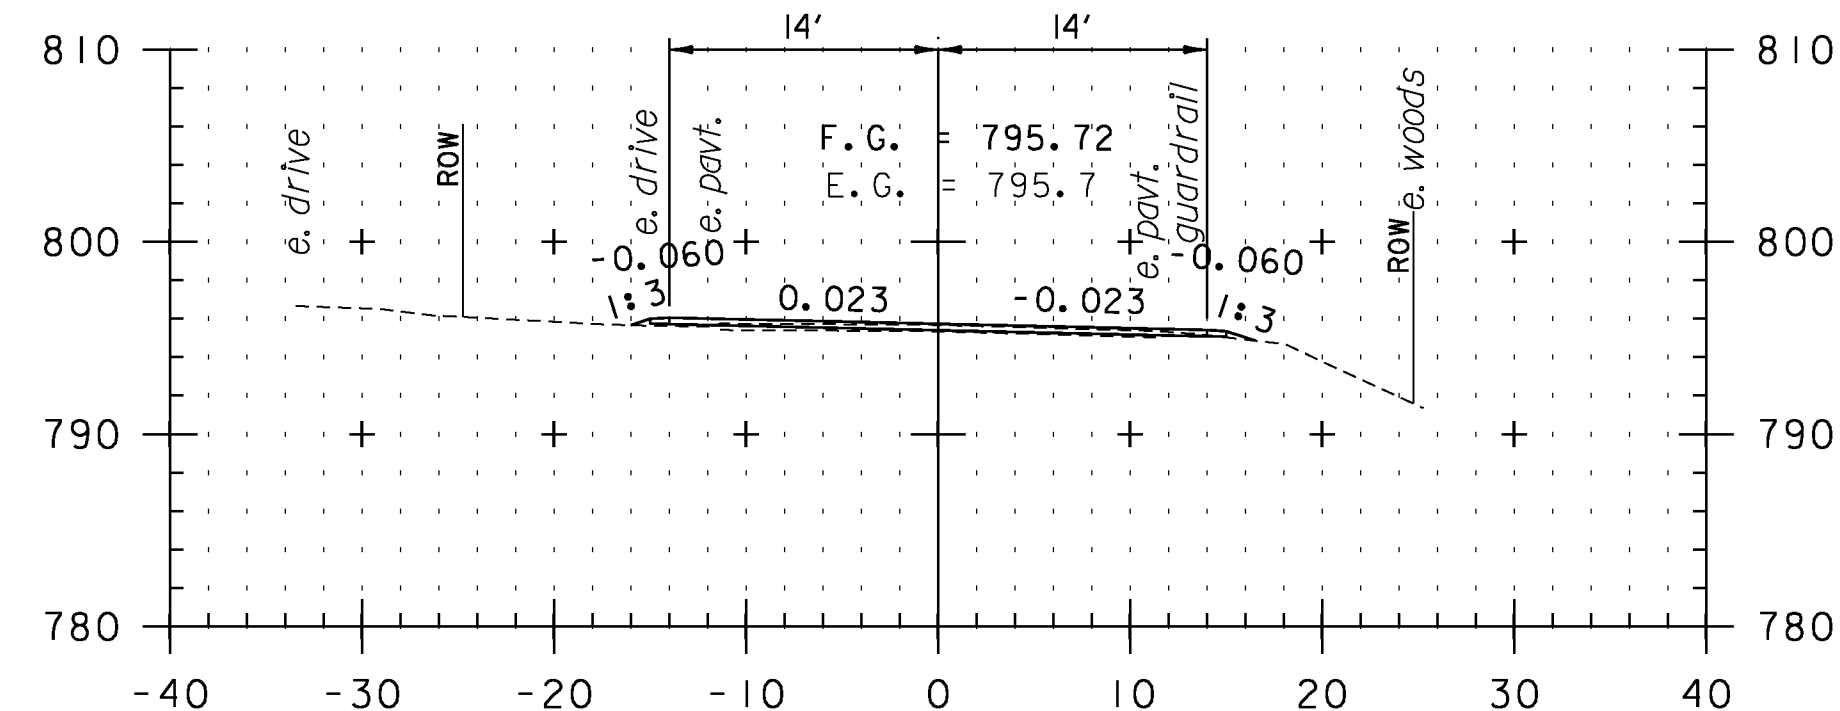


384+50

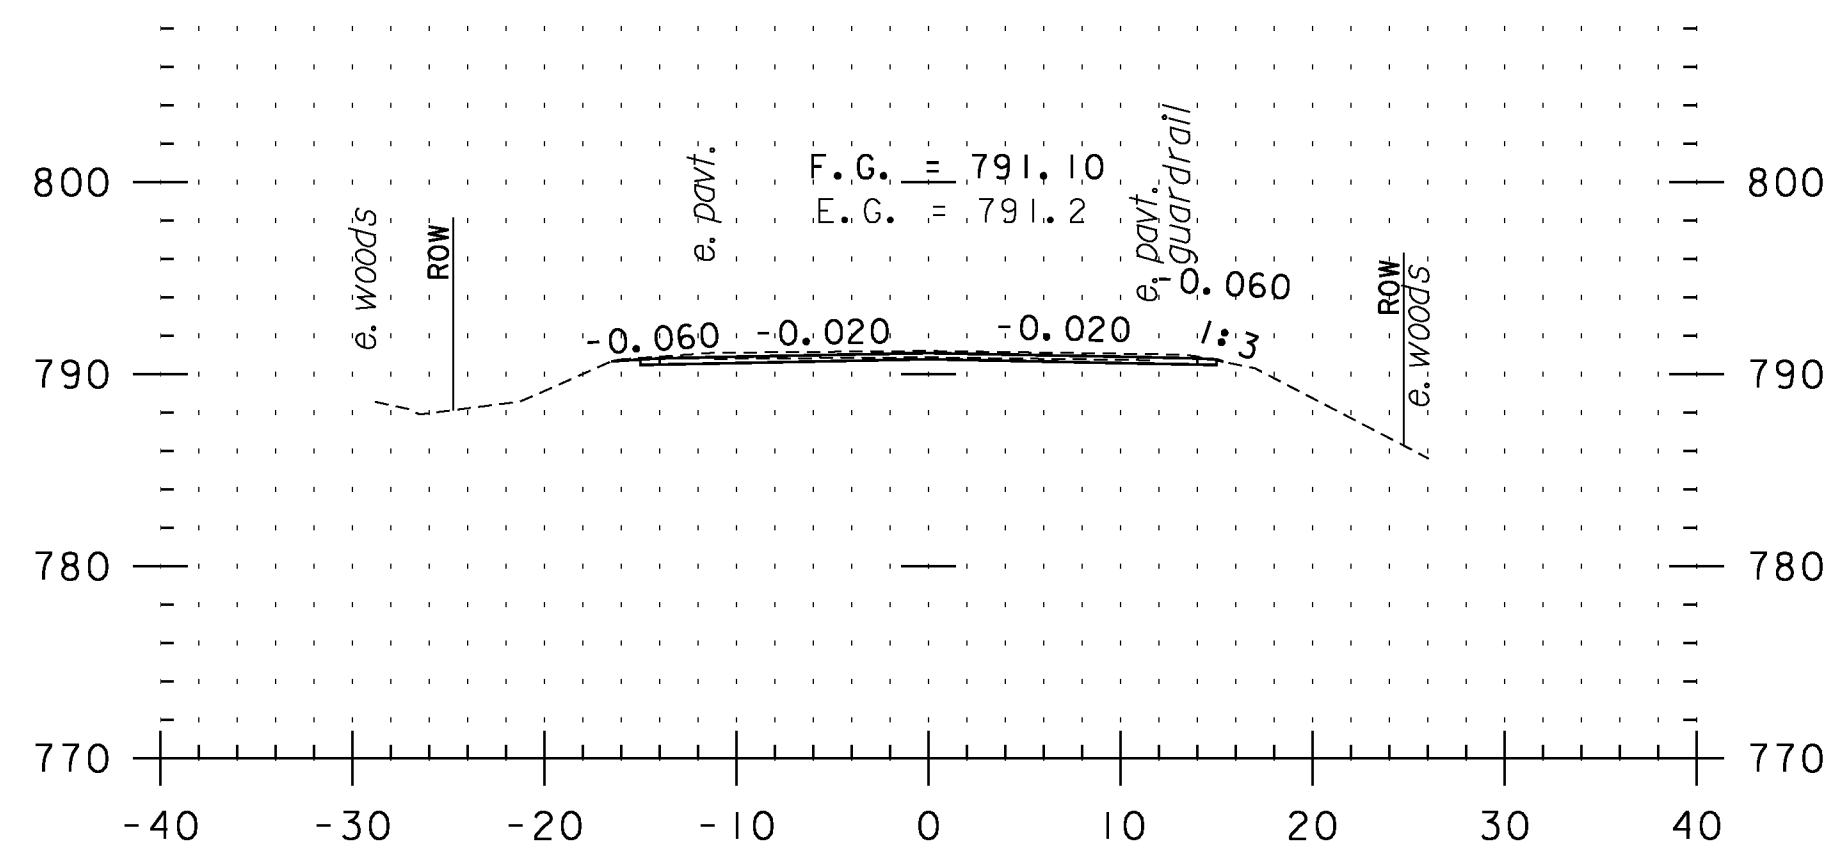


387+00

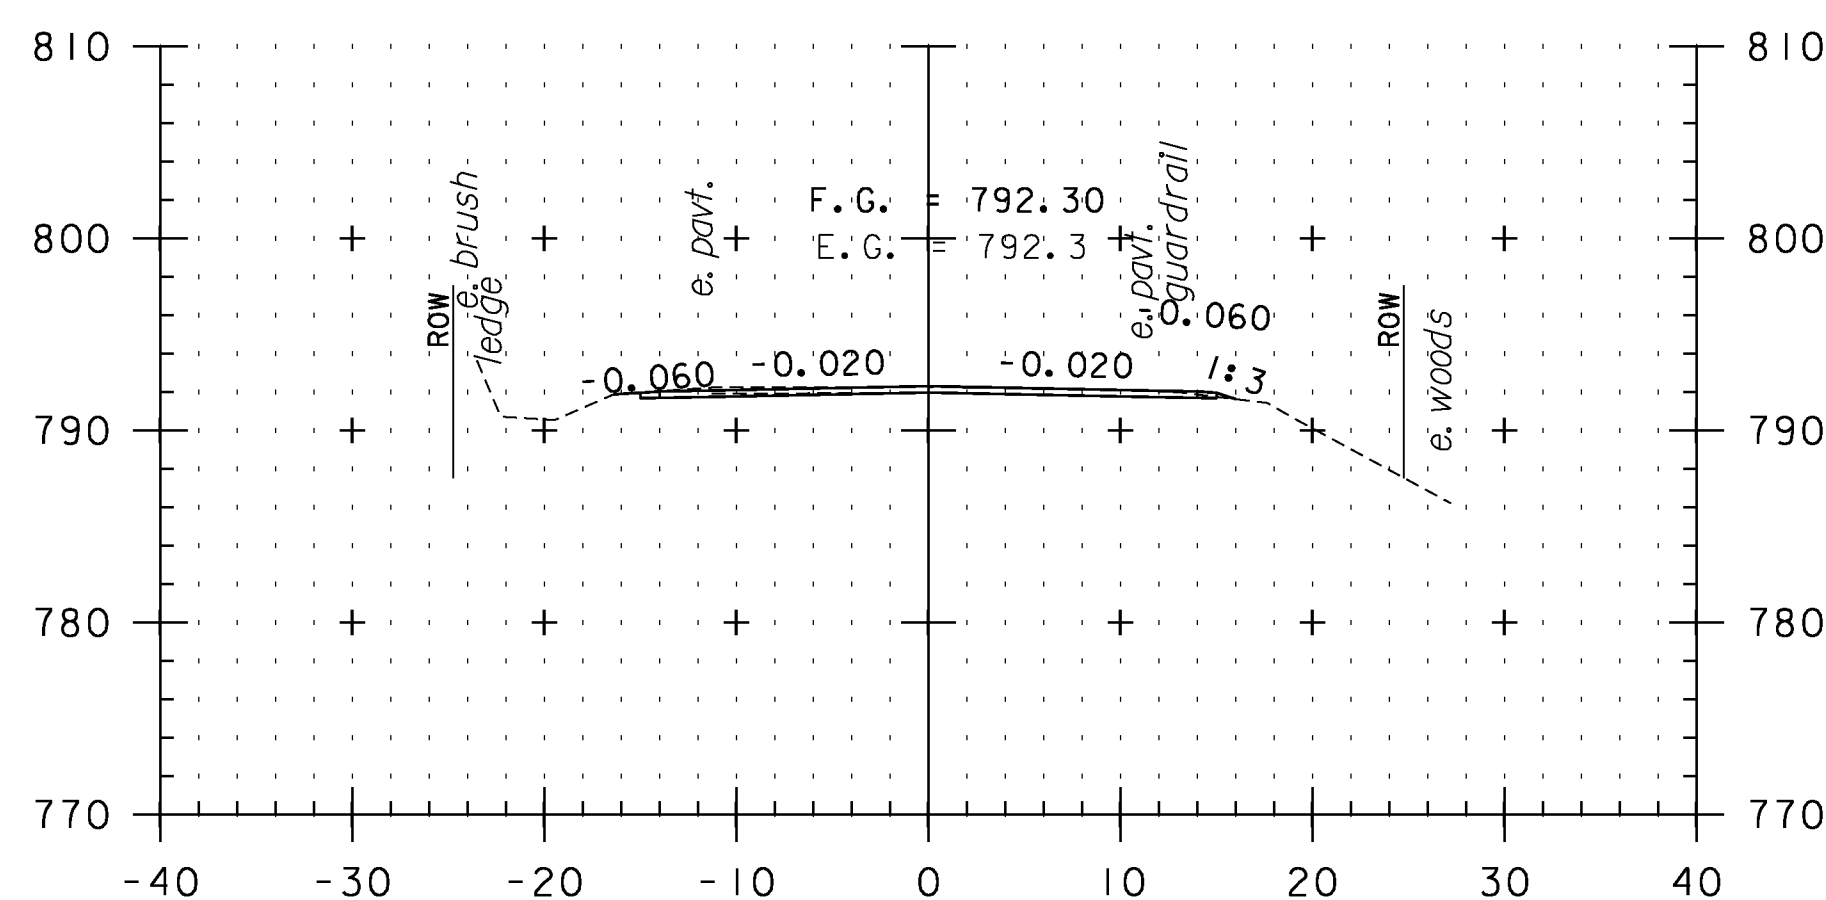


386+50

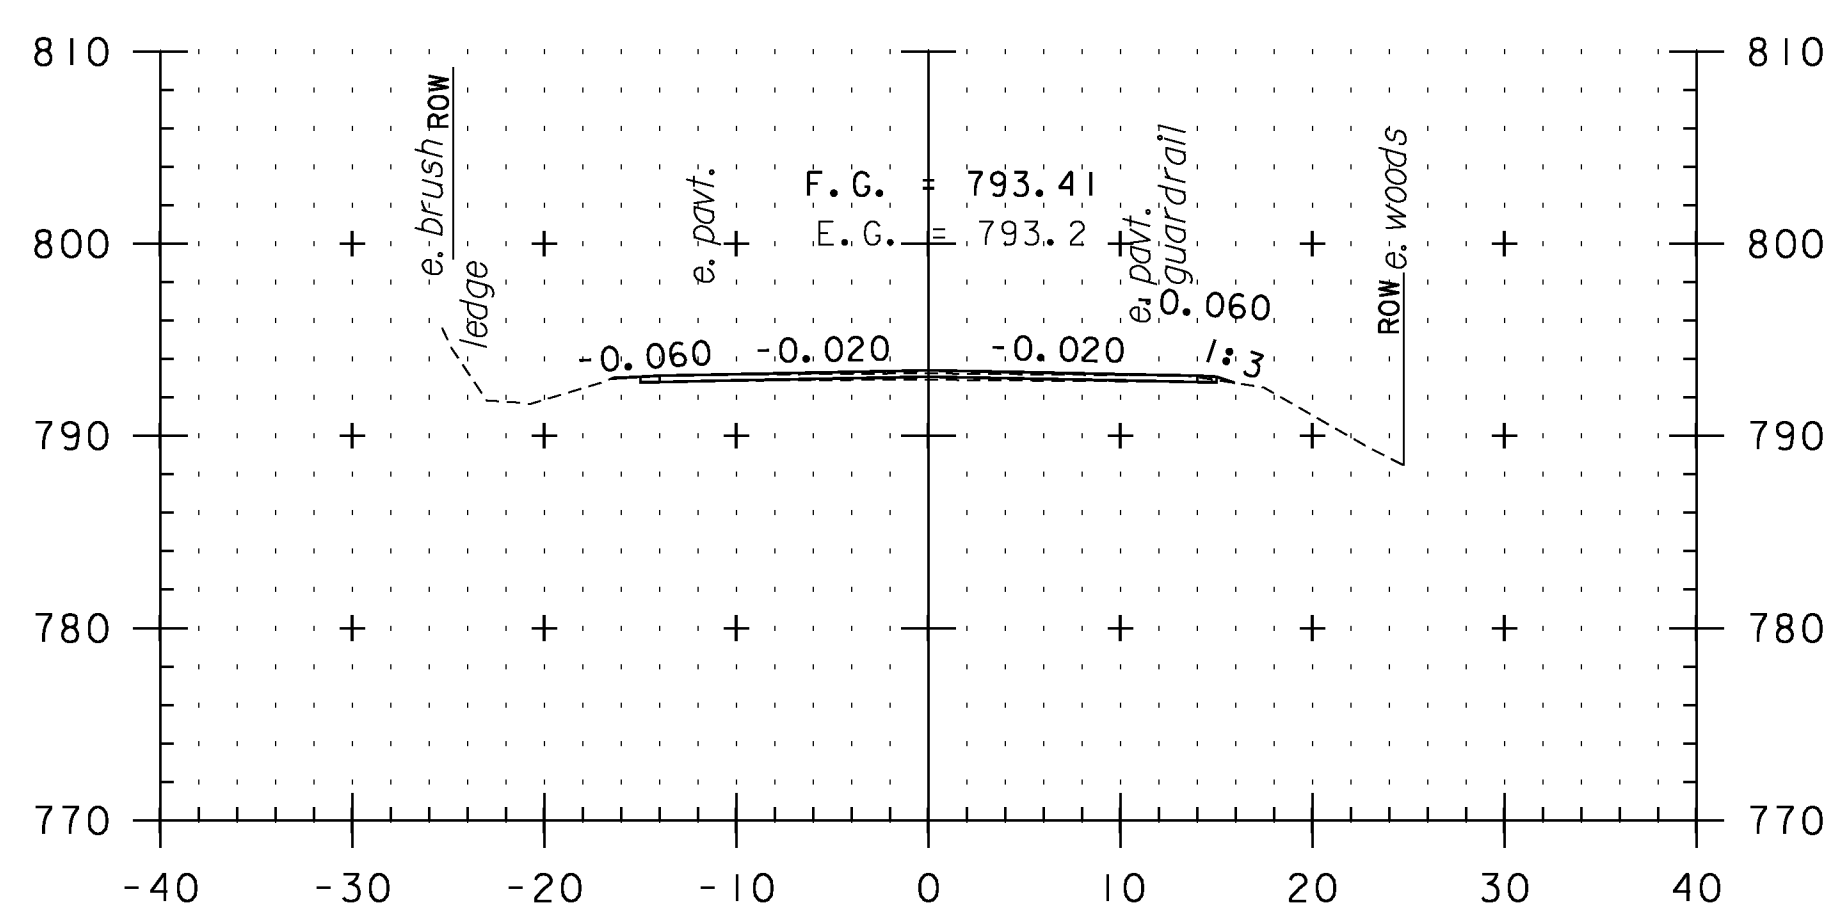


386+00

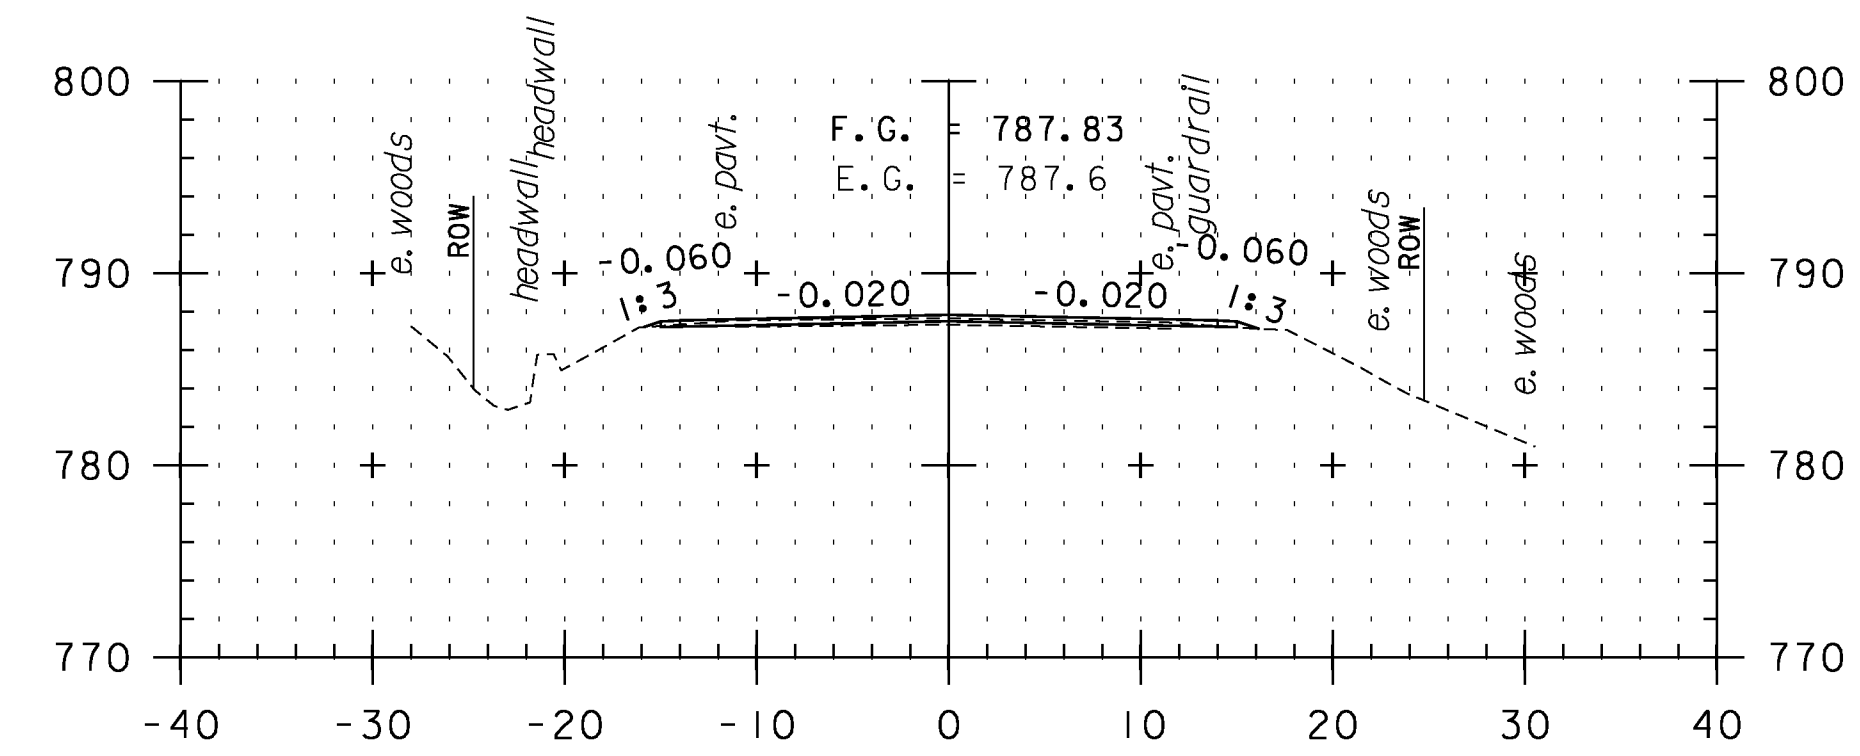

388+50

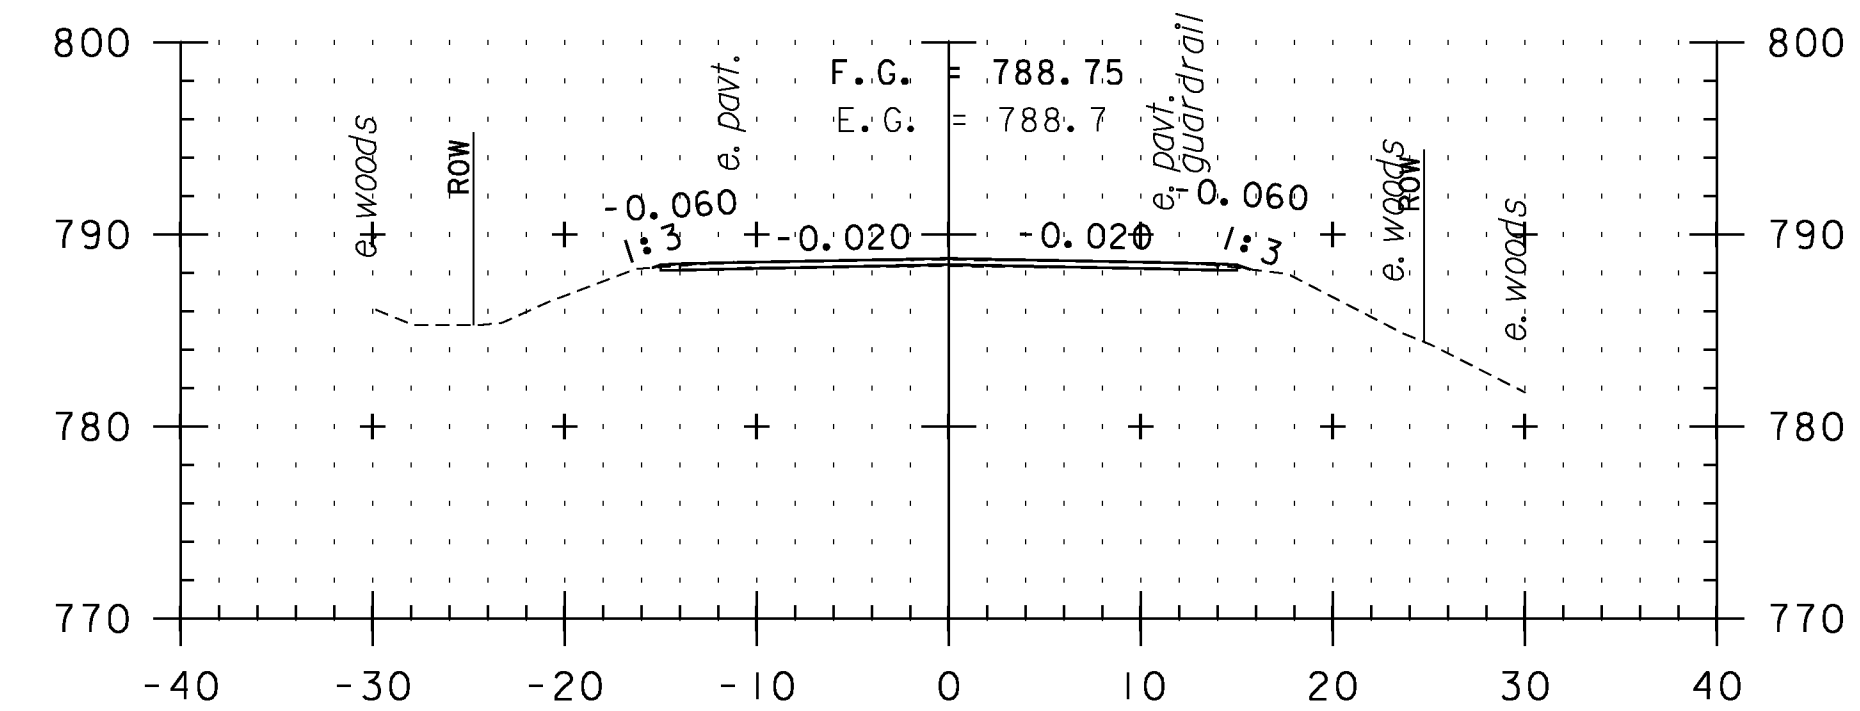

388+00

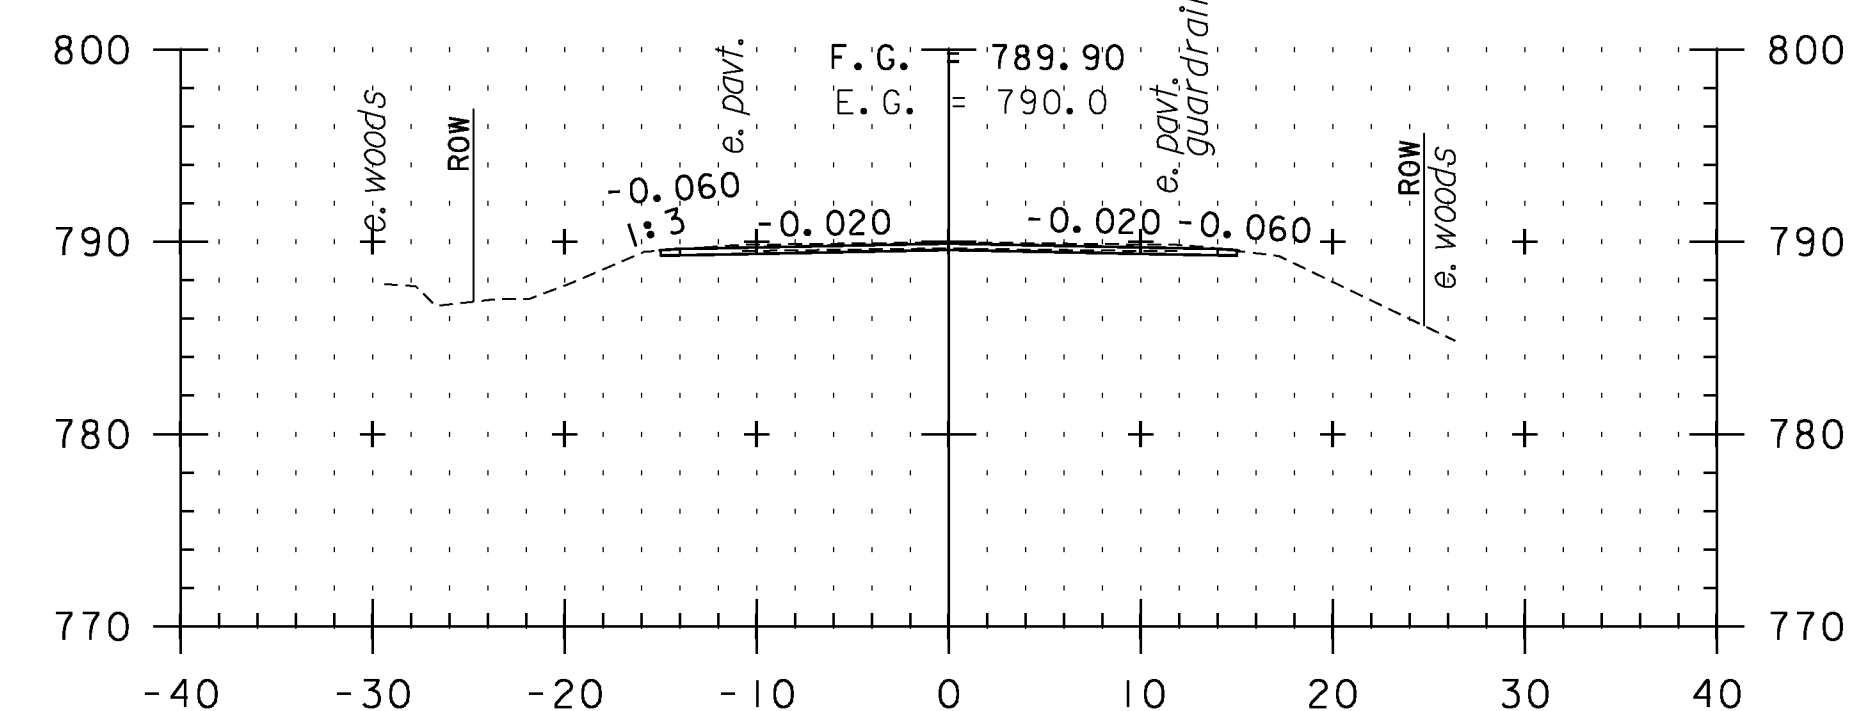

387+50

CROSS SECTION SHEET 47

PROJECT NAME: VERSHIRE-THETFORD

PROJECT NUMBER: STP 2911(I)

FILE NAME: pl0c224.dgn

PLOT DATE: 1/29/2013

PROJECT LEADER: PTS

DRAWN BY: SNG

DESIGNED BY: NLL

CHECKED BY: PTS

IPARM FILE NAME: IOC224_I55

SHEET 155 OF 232

STA. 384+50 TO STA. 388+50

