




390+00

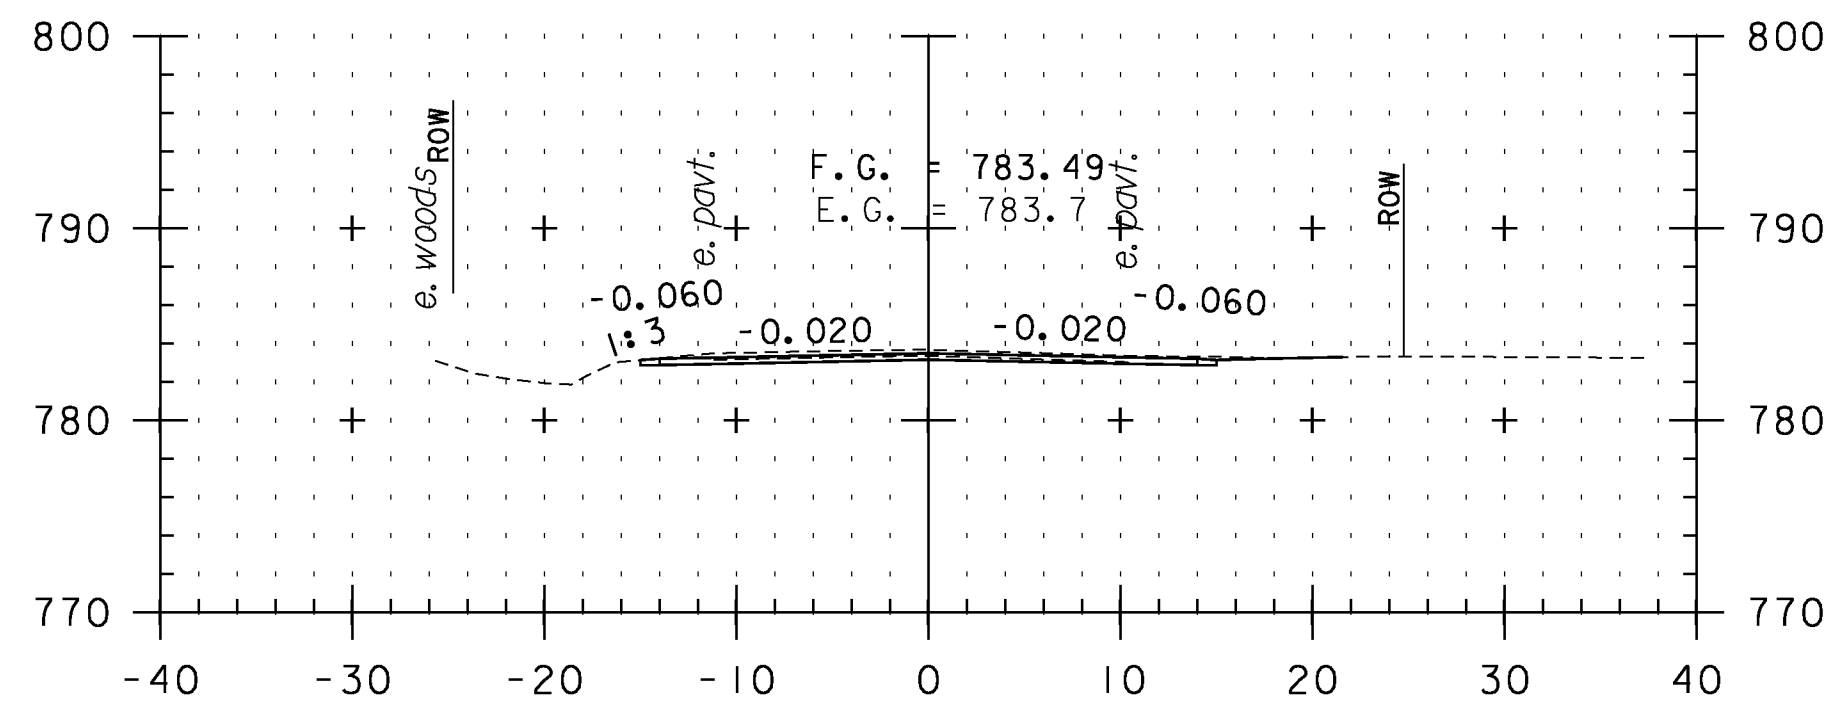


391+50

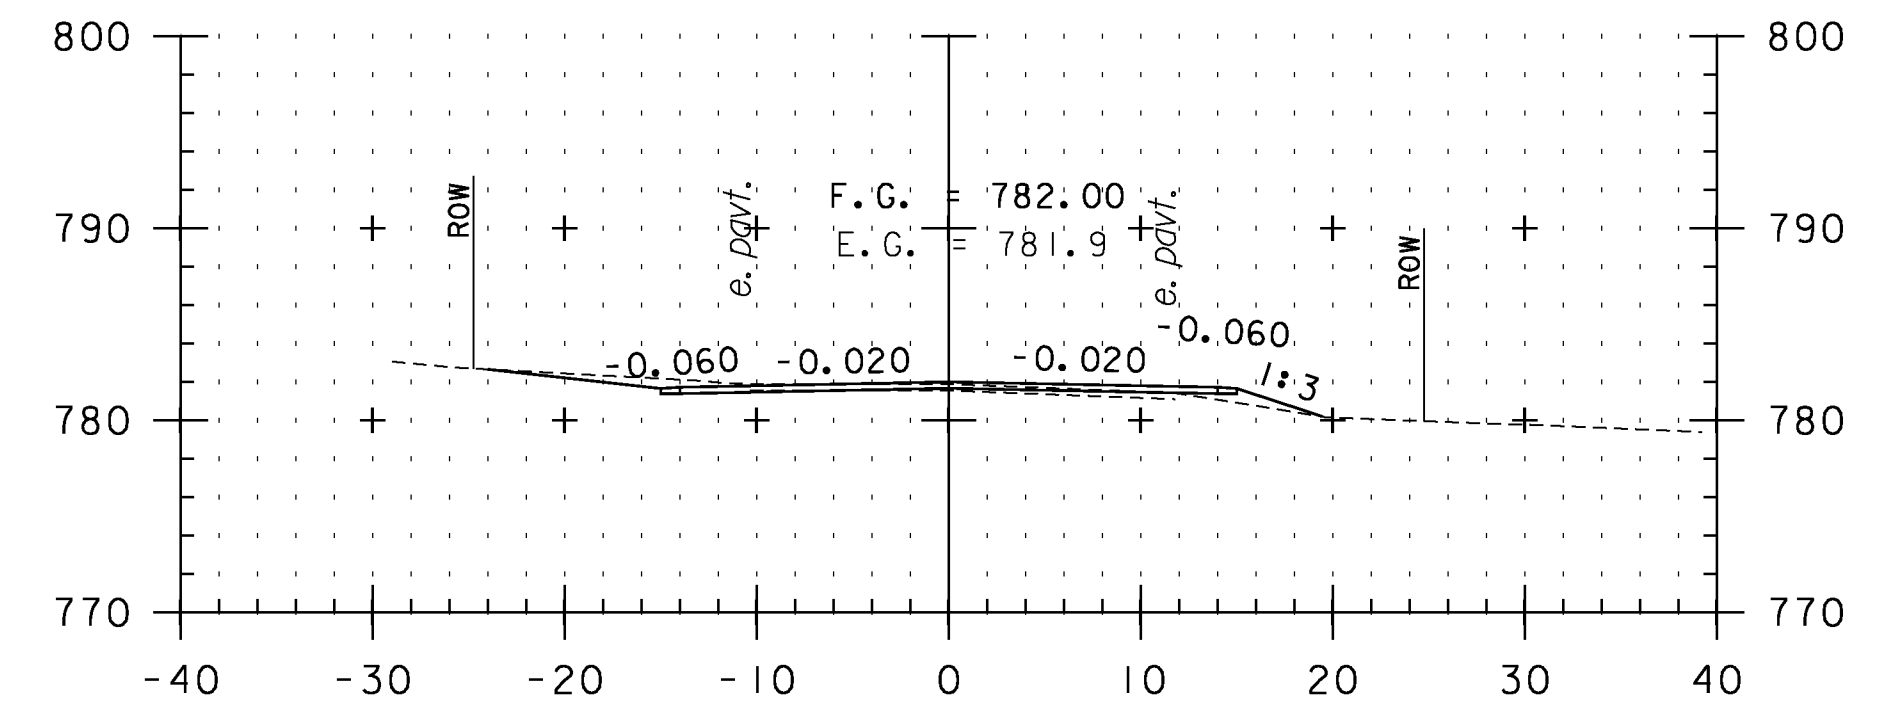


393+00

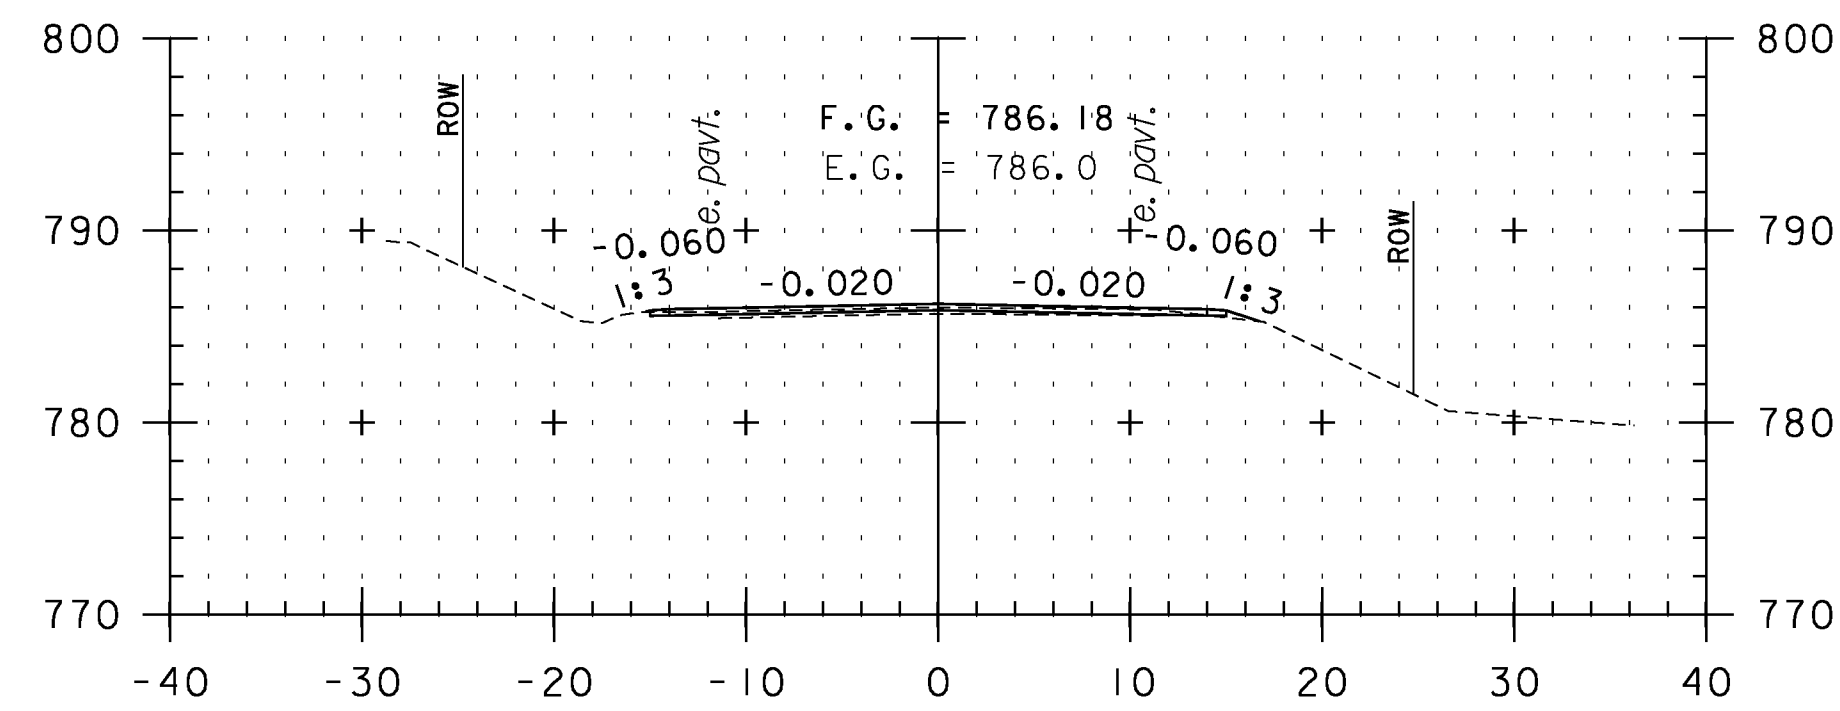


389+50

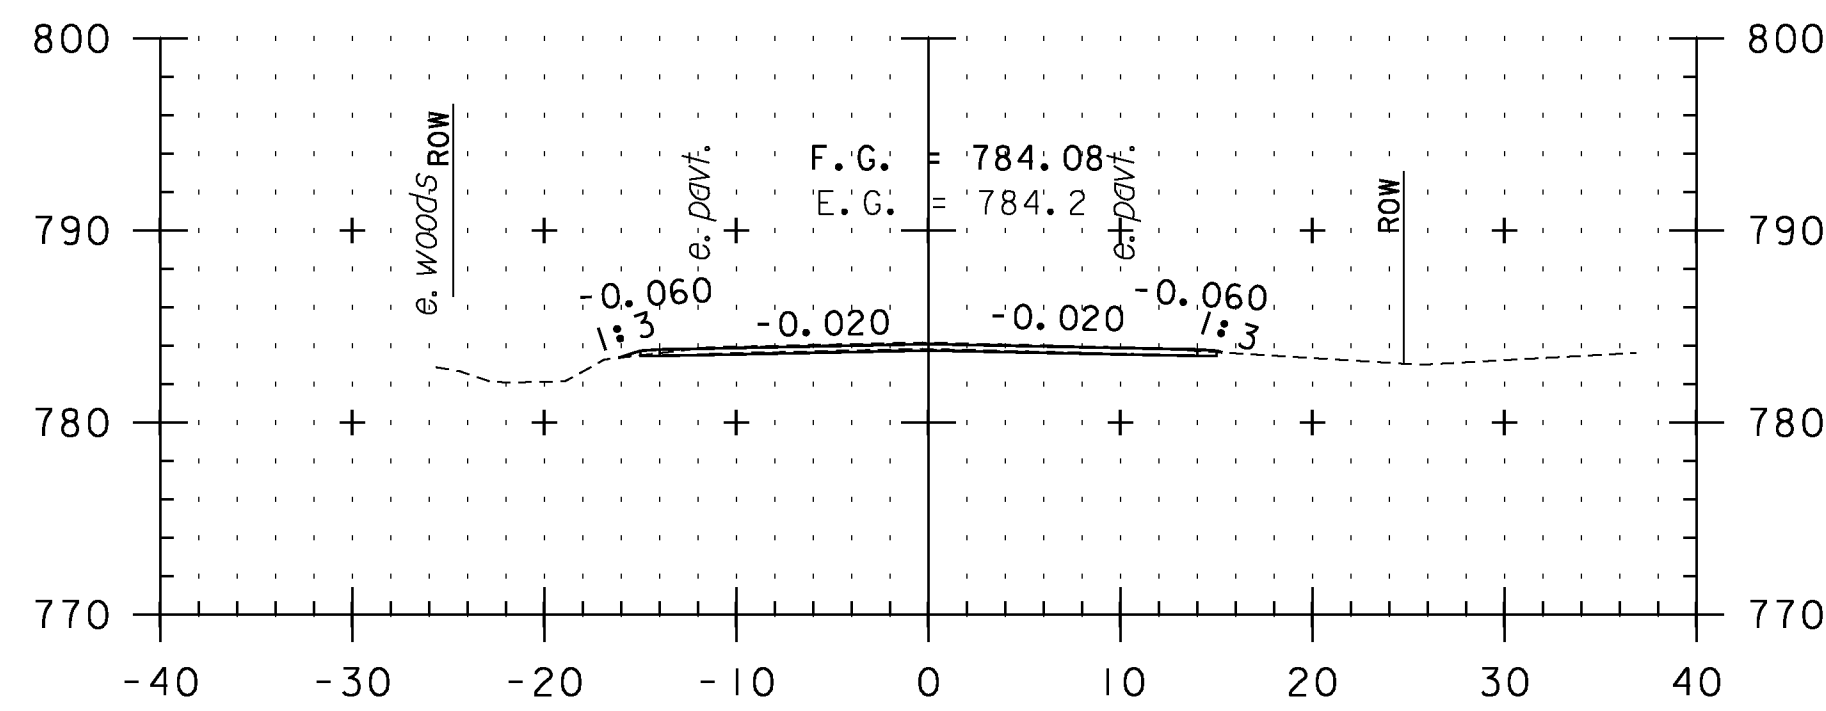


391+00

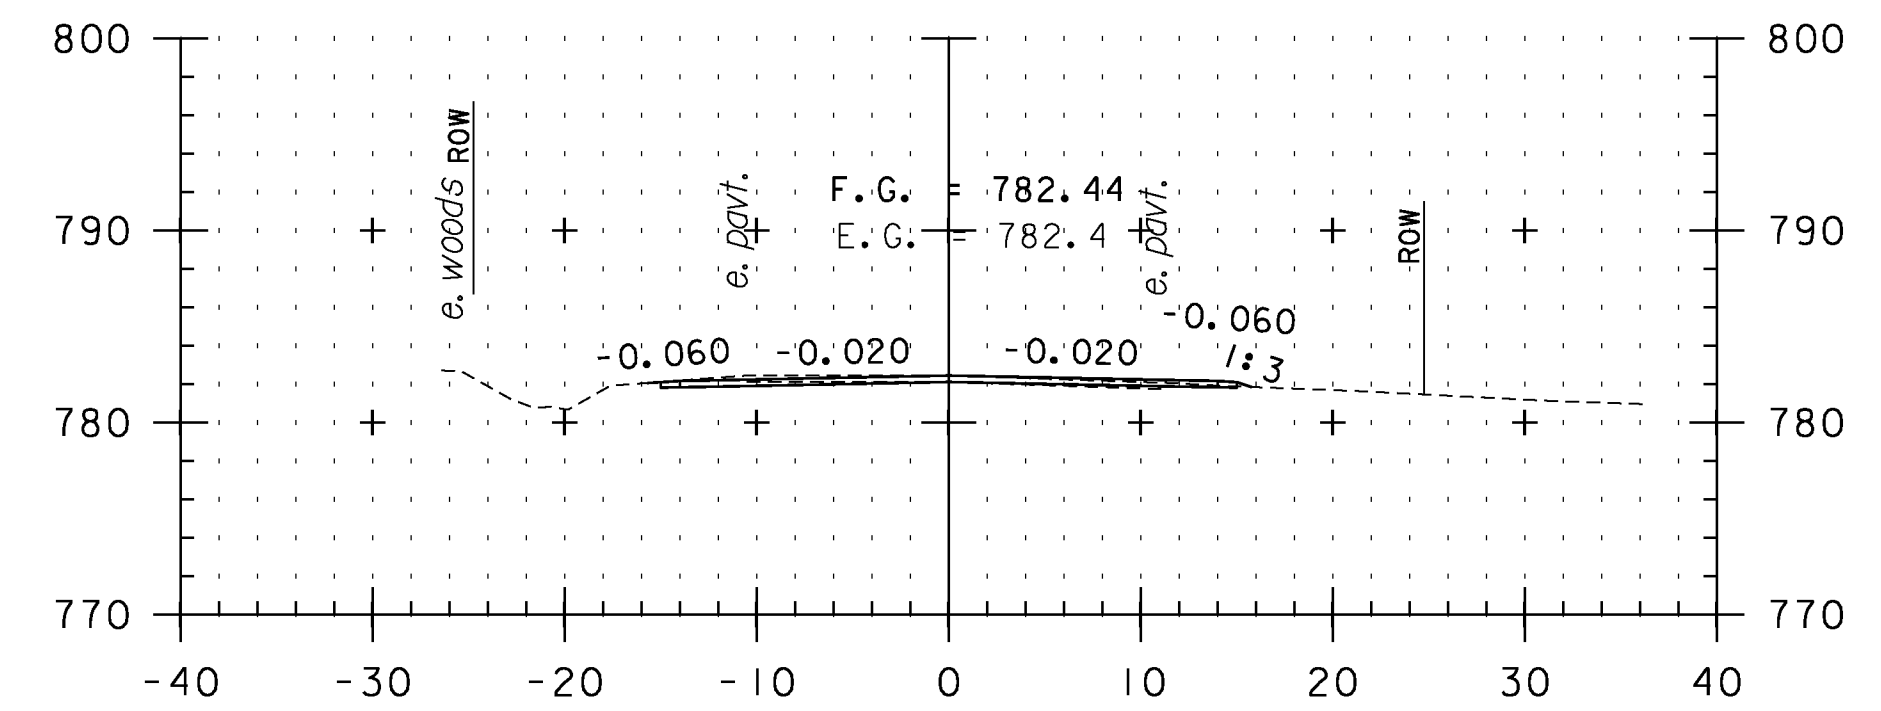


392+50

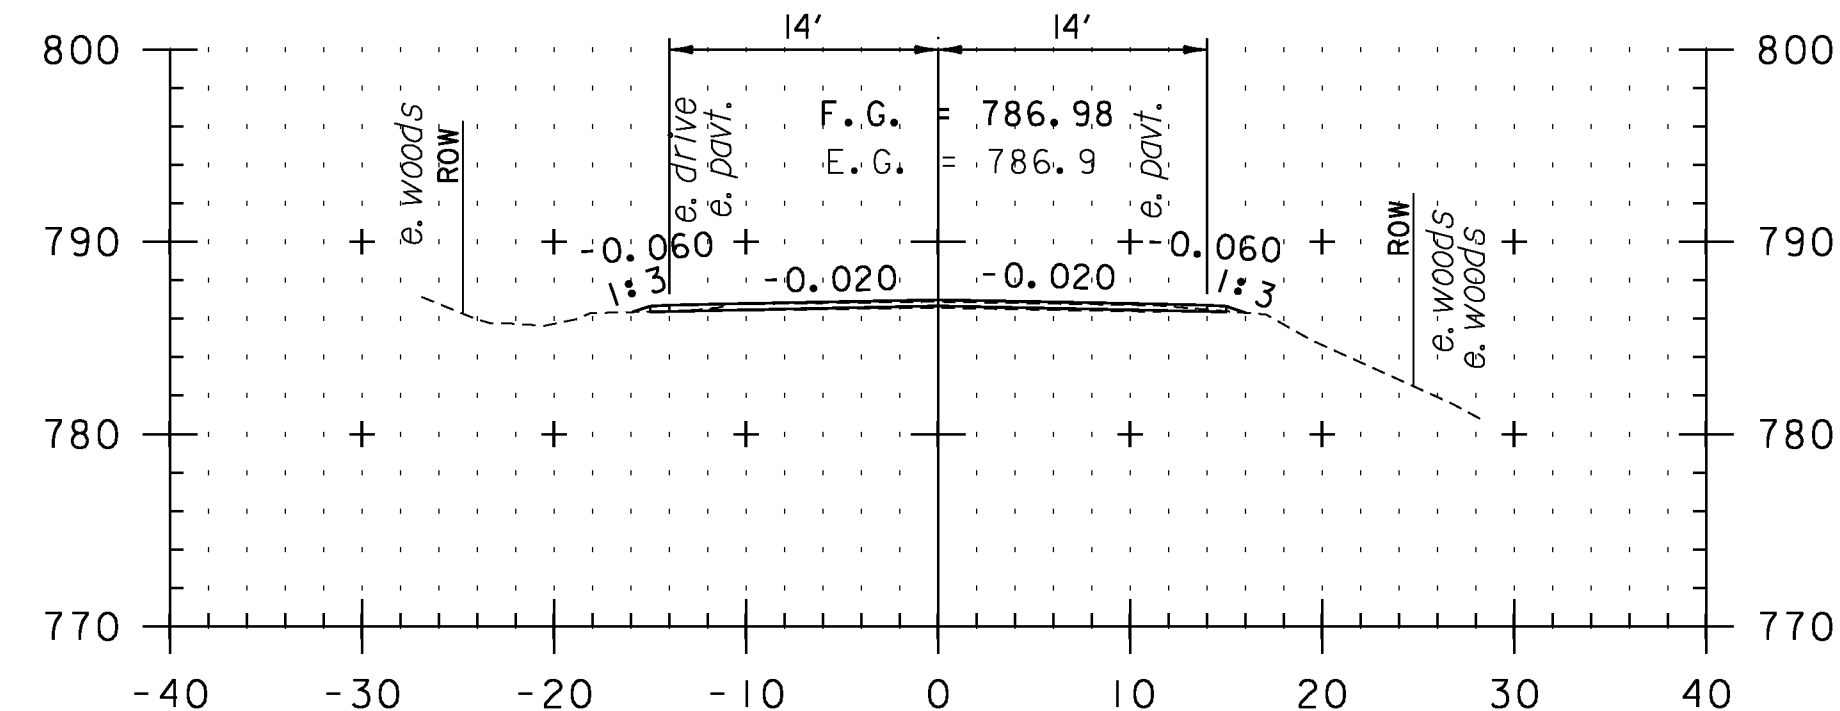

389+00

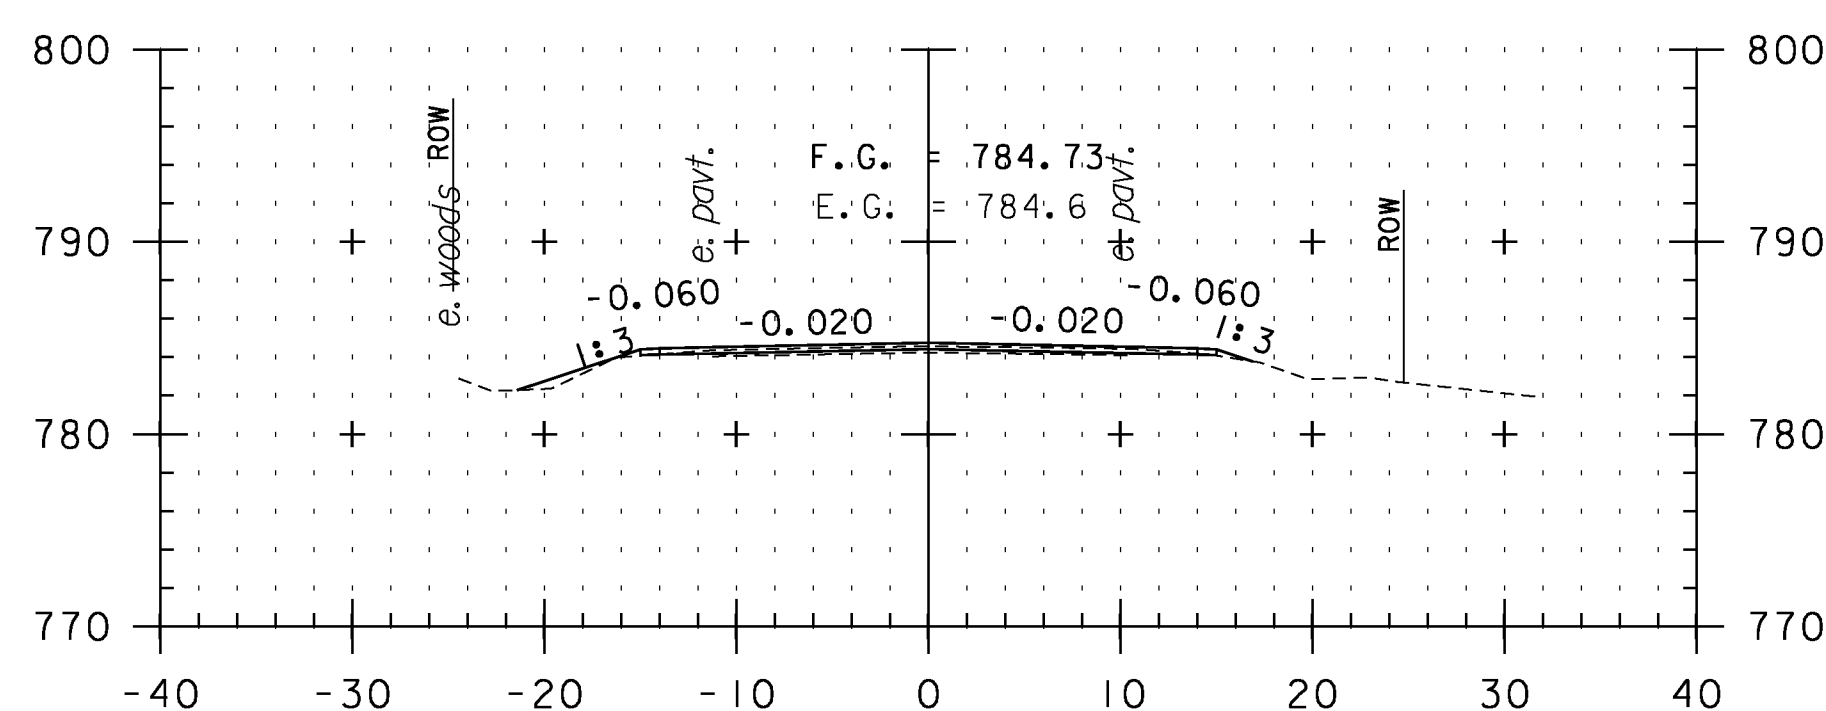


390+50

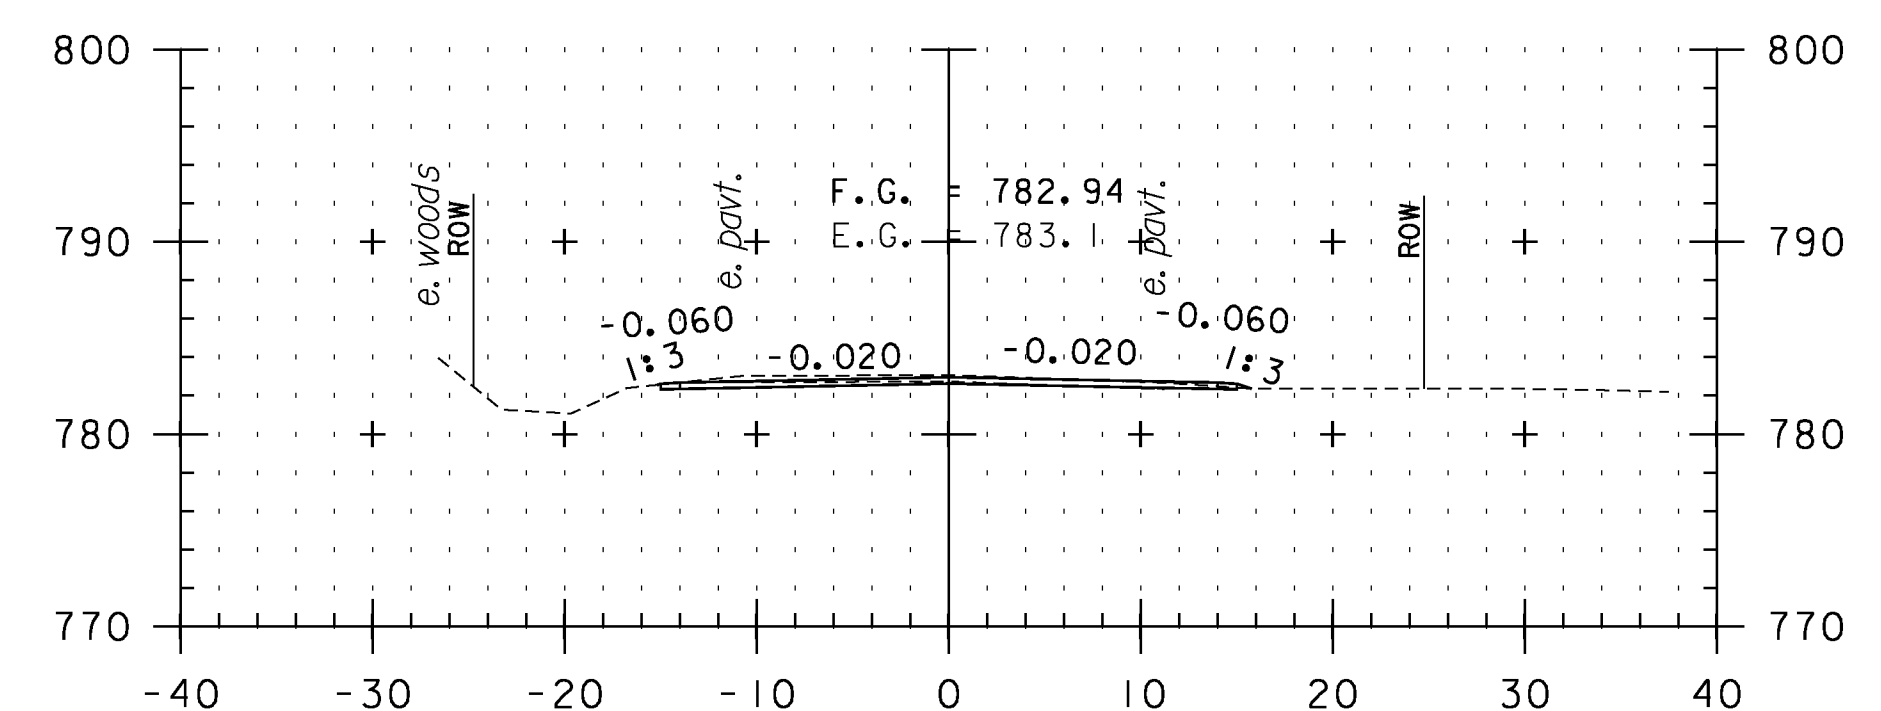

392+00

CROSS SECTION SHEET 48

STA. 389+00 TO STA. 393+00

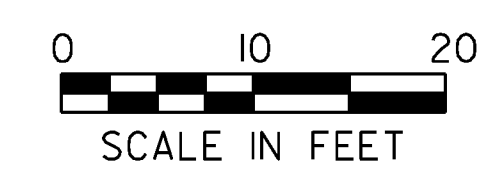

PROJECT NAME: VERSHIRE-THETFORD	PLOT DATE: 1/29/2013
PROJECT NUMBER: STP 2911(I)	DRAWN BY: SNG
FILE NAME: pl0c224.dgn	CHECKED BY: PTS
PROJECT LEADER: PTS	SHEET 156 OF 232
DESIGNED BY: NLL	
IPARM FILE NAME: IOC224_156	