




399+00

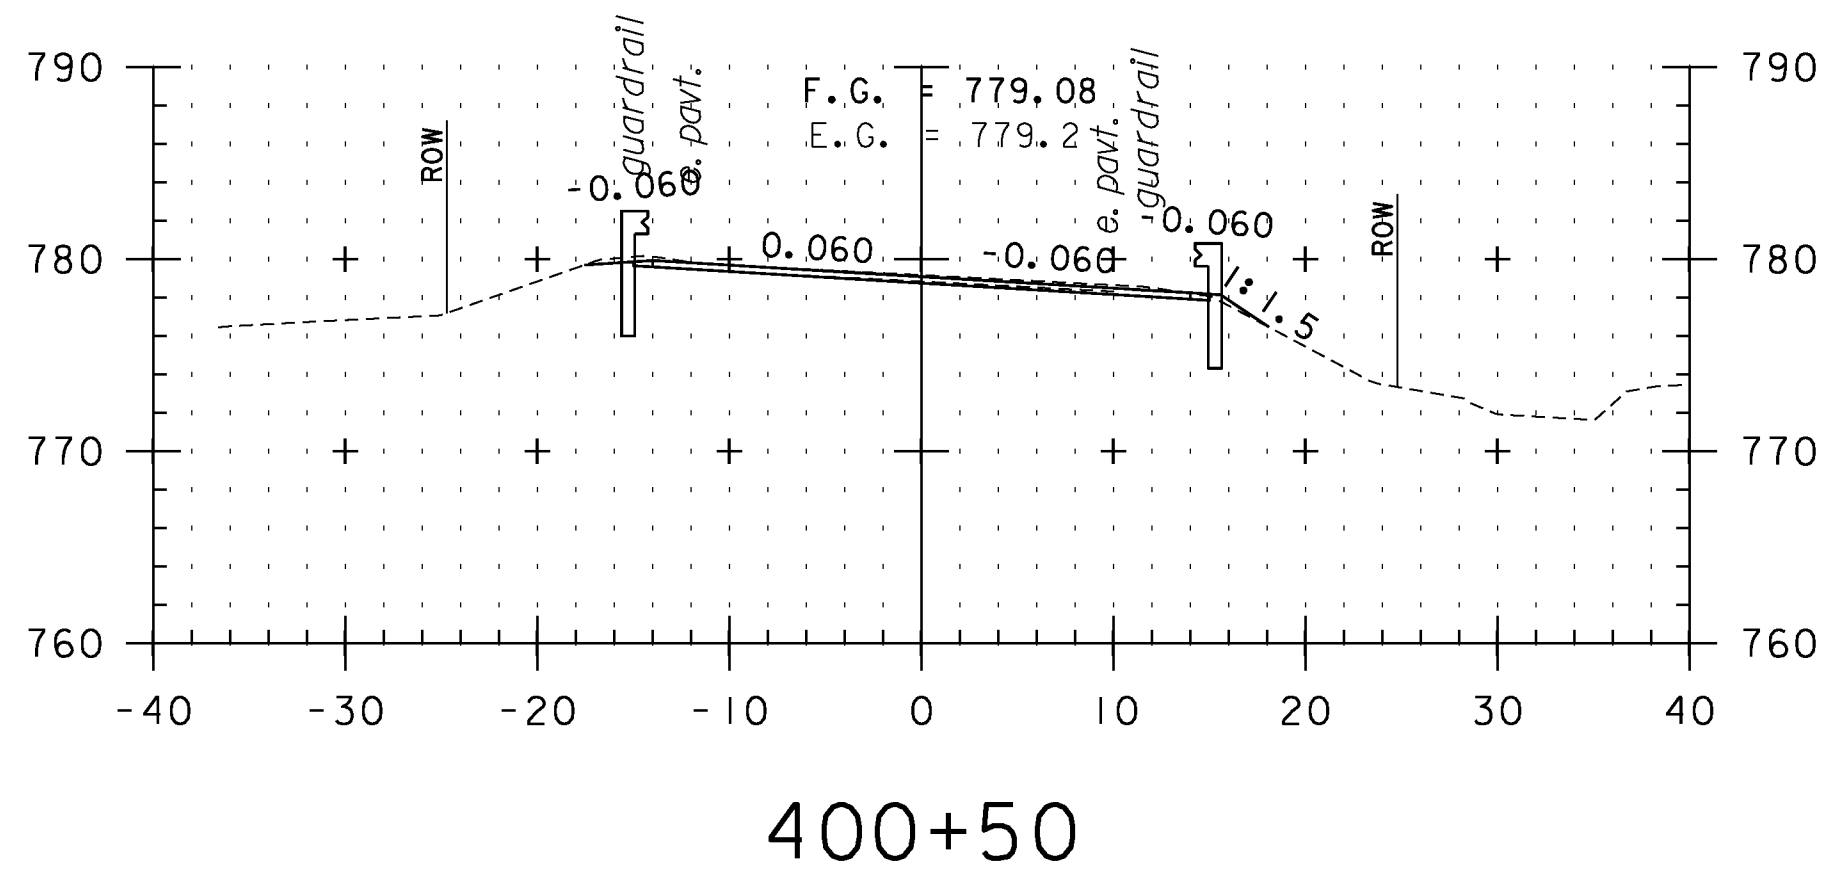


400+50

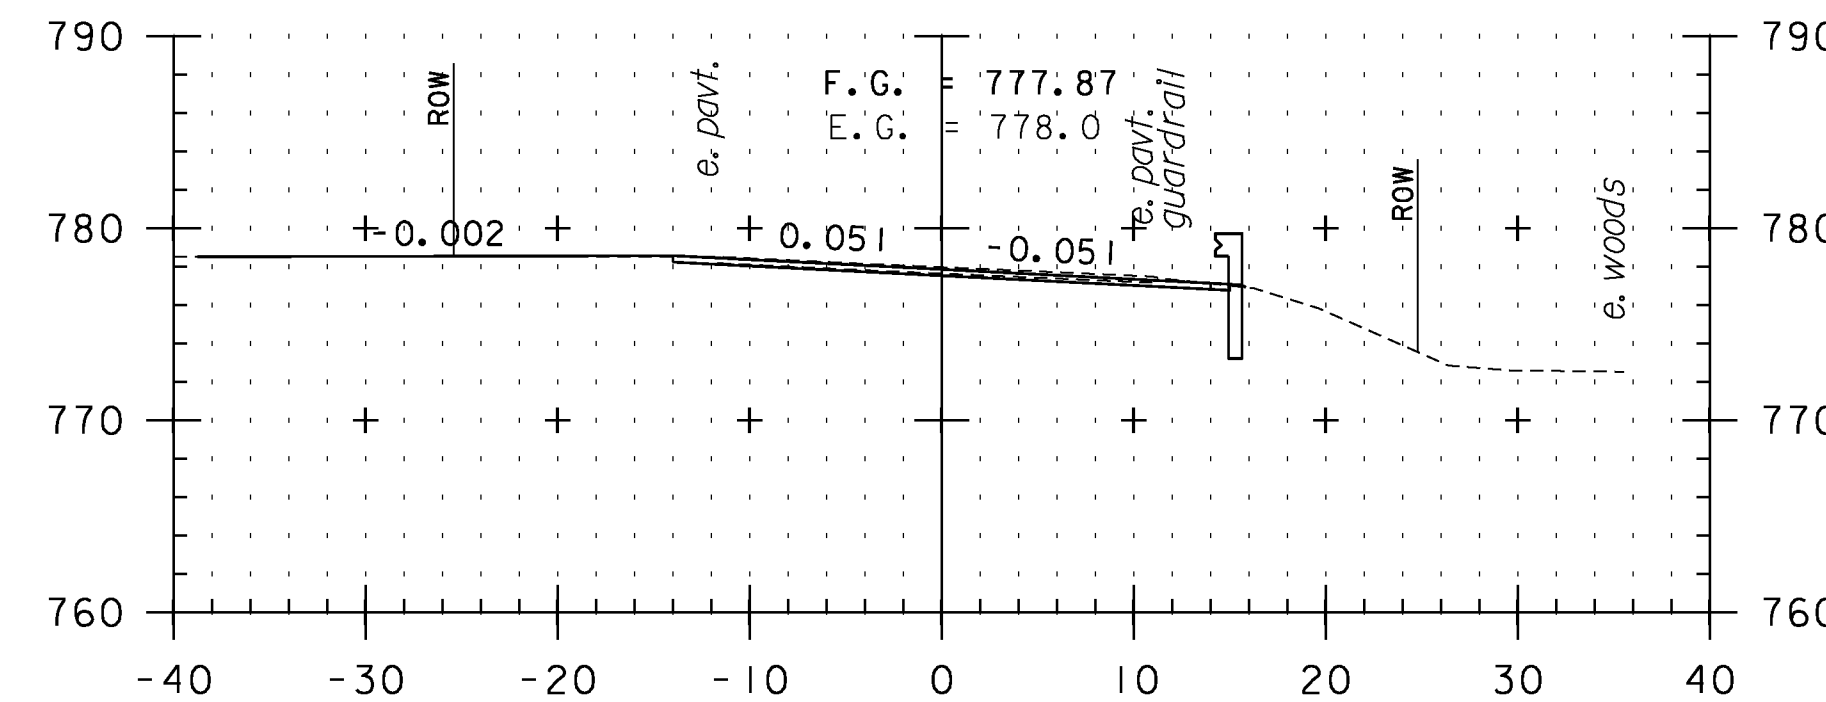


401+31
TH 15

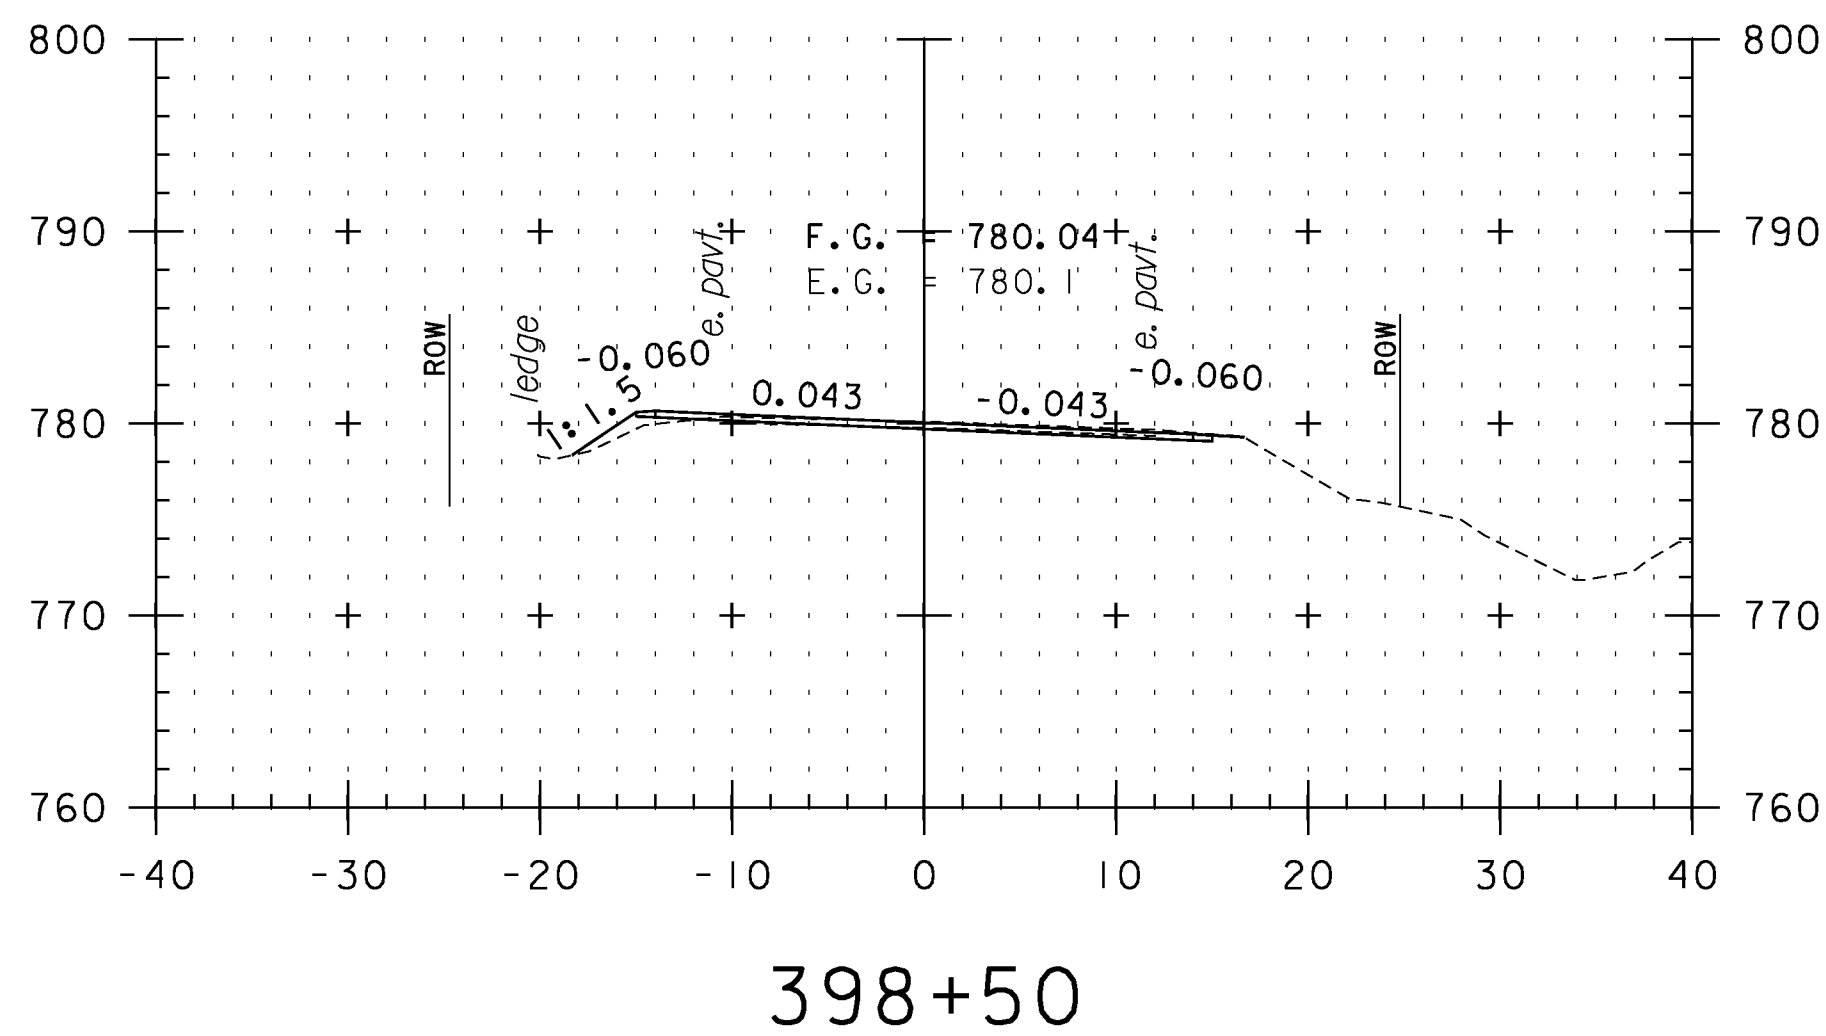


398+50

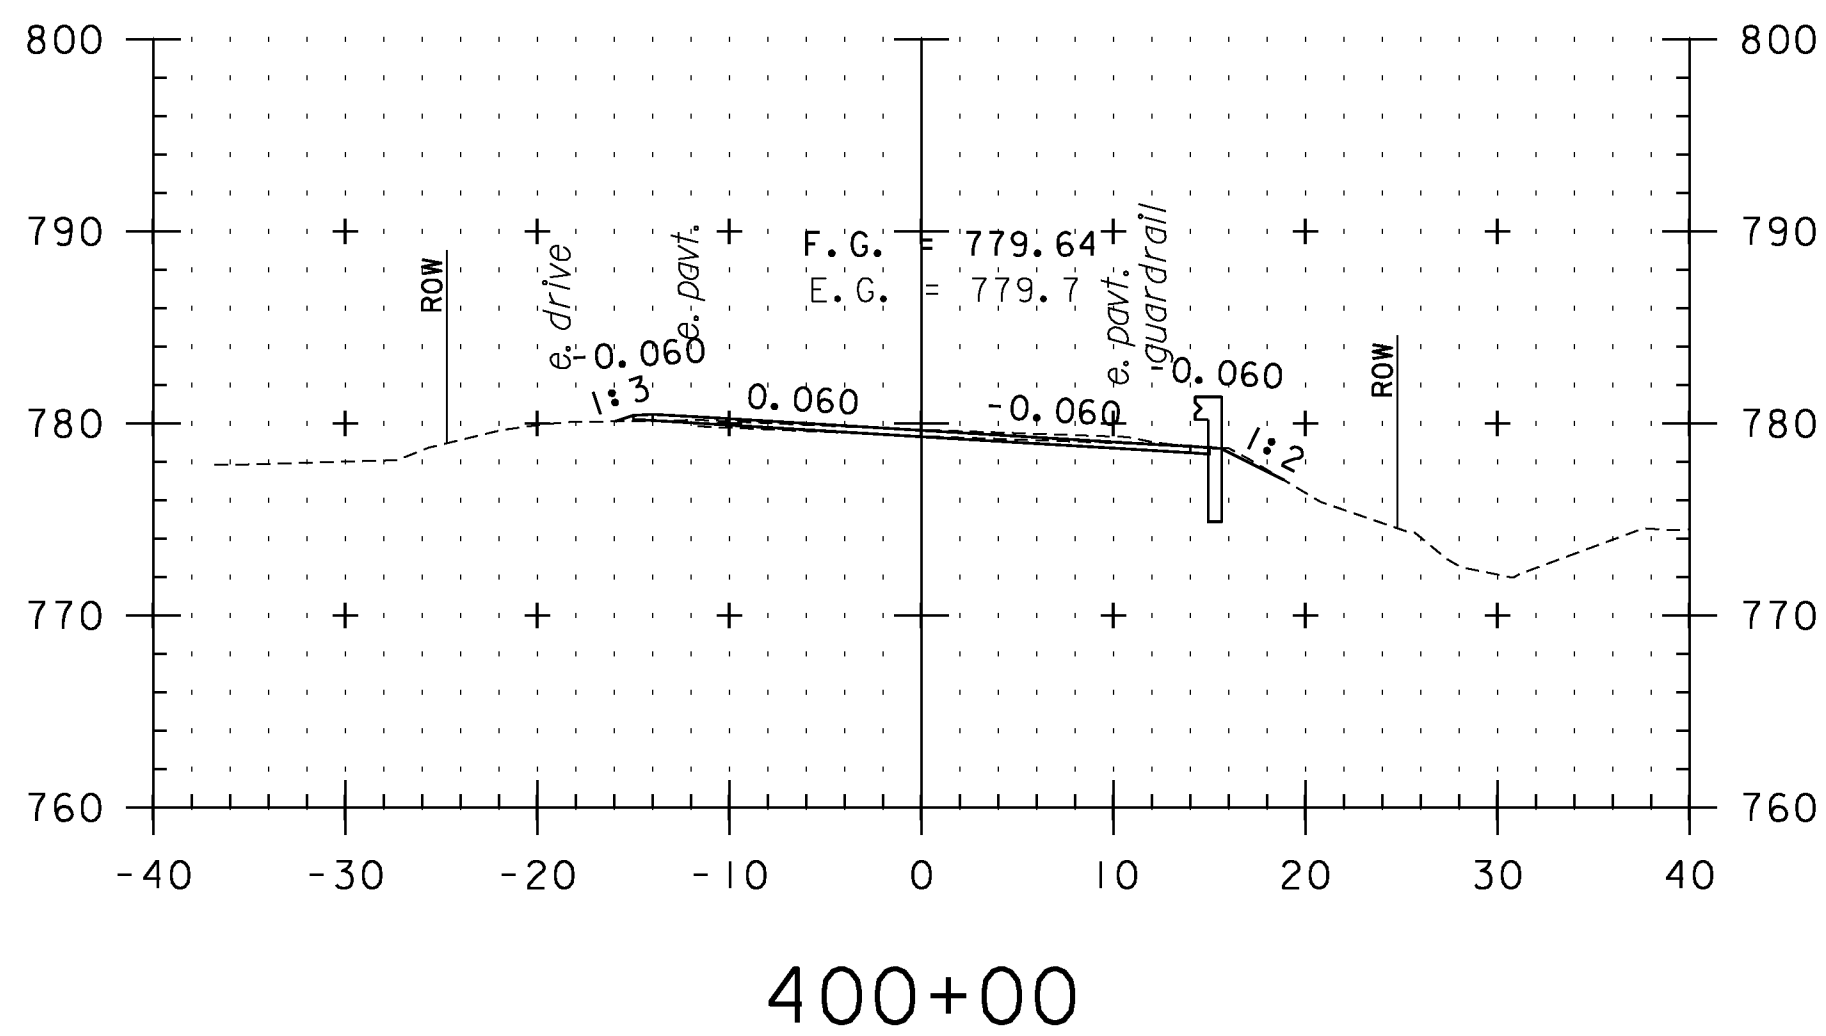


400+00

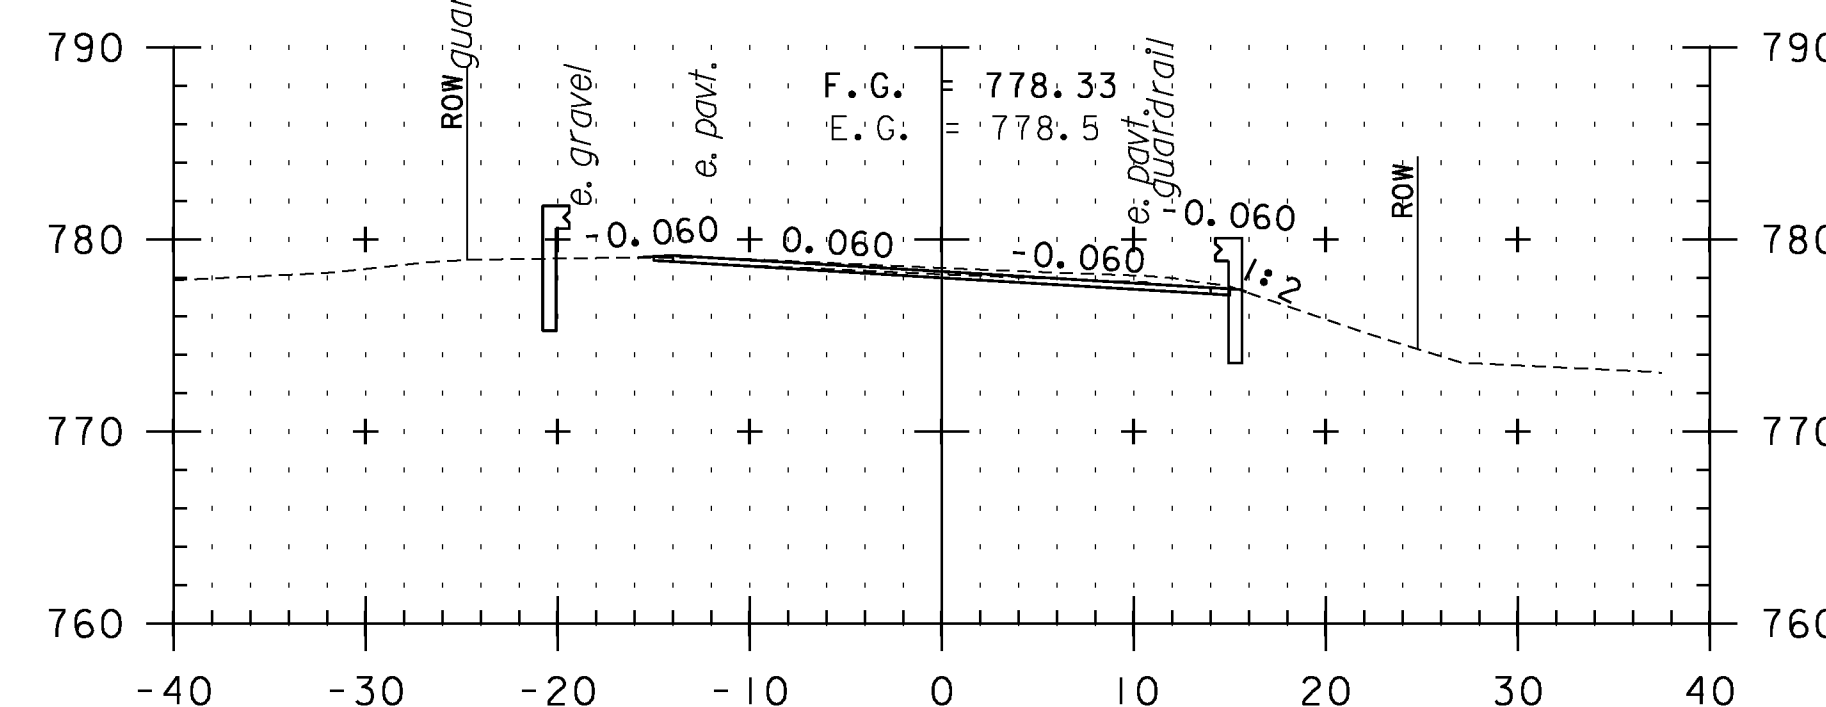


401+00

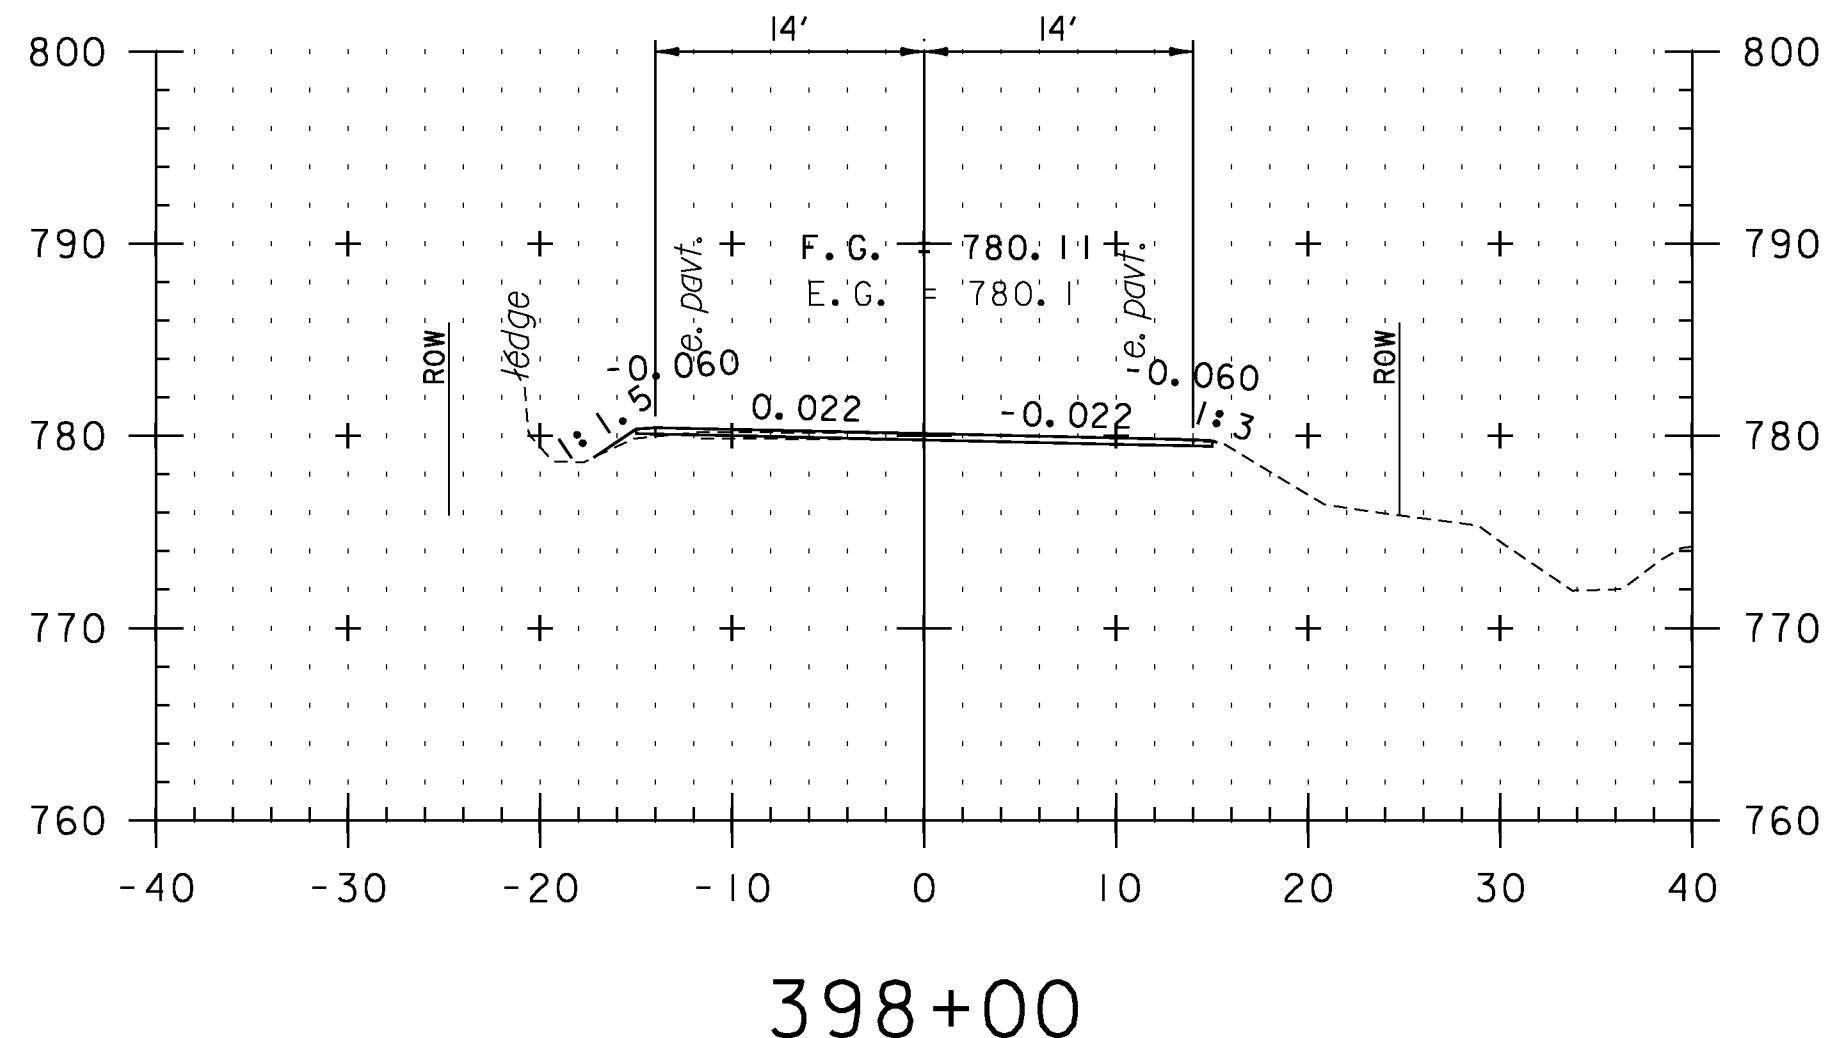

398+00

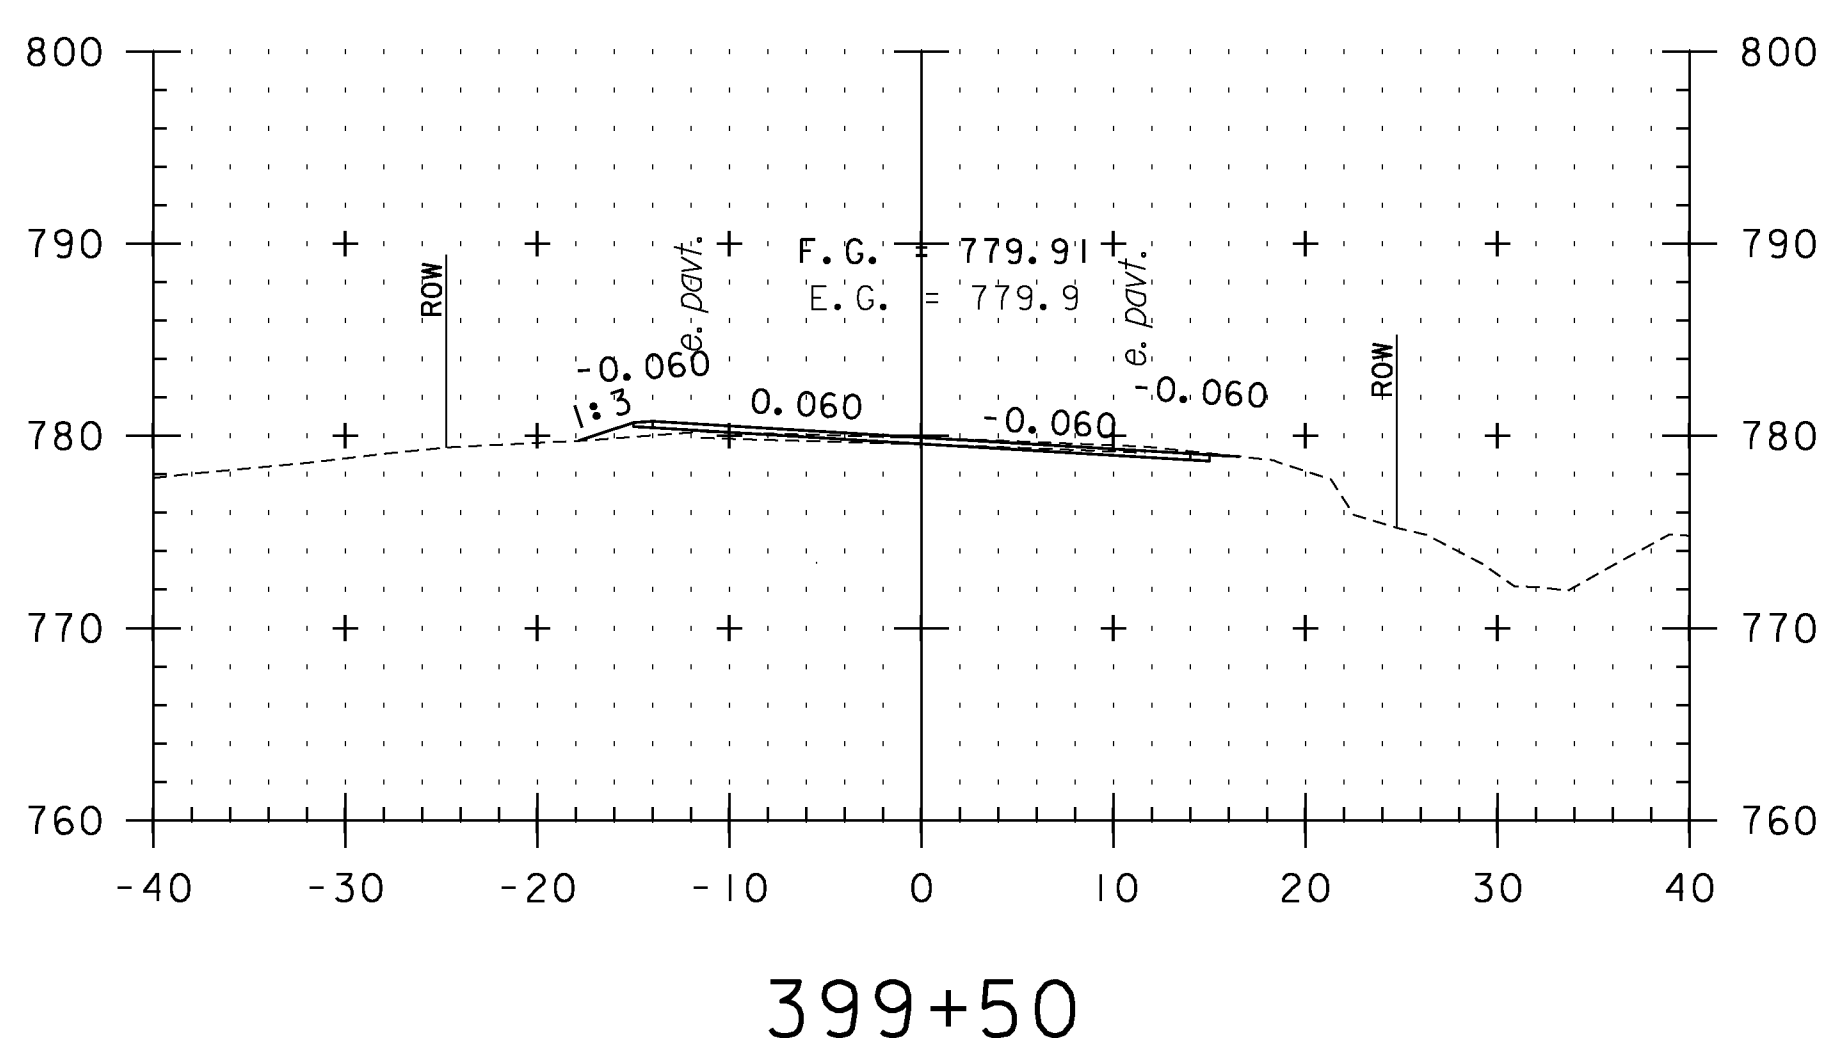


399+50

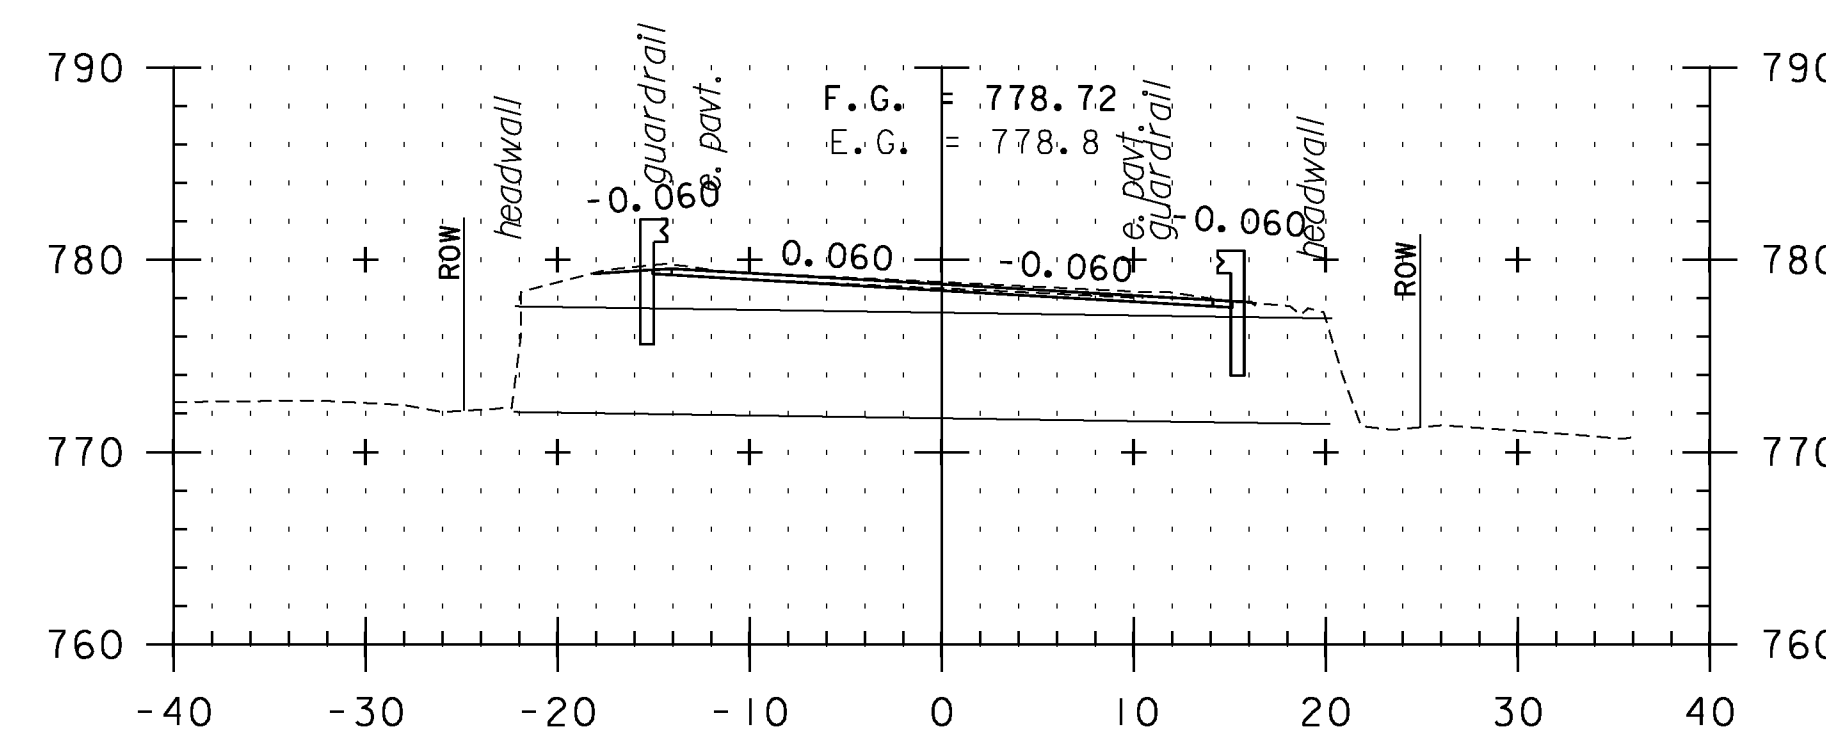

400+75
BRIDGE 21
CROSS SECTION SHEET 50

STA. 398+00 TO STA. 401+31

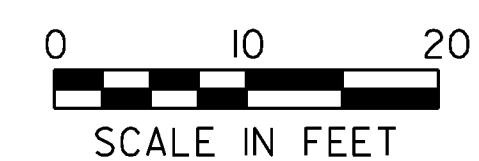

PROJECT NAME: VERSHIRE-THETFORD

PROJECT NUMBER: STP 2911(I)

FILE NAME: pl0c224.dgn

PROJECT LEADER: PTS

DESIGNED BY: NLL

IPARM FILE NAME: IOC224_I58

PLOT DATE: 1/29/2013

DRAWN BY: SNG

CHECKED BY: PTS

SHEET 158 OF 232