




402+16  
BEGIN BRIDGE 22 APPROACH

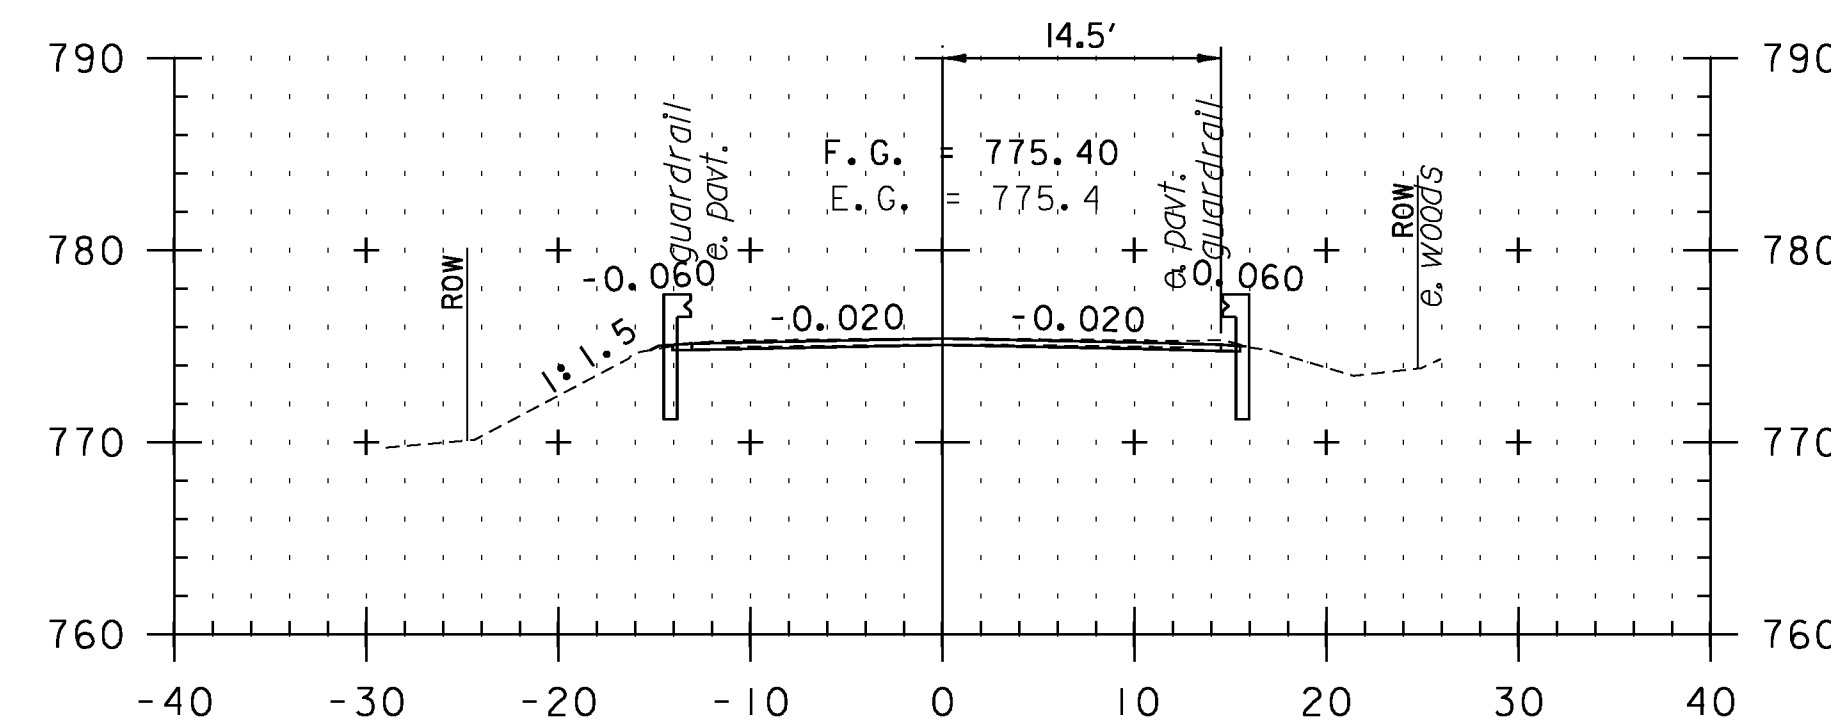


403+00

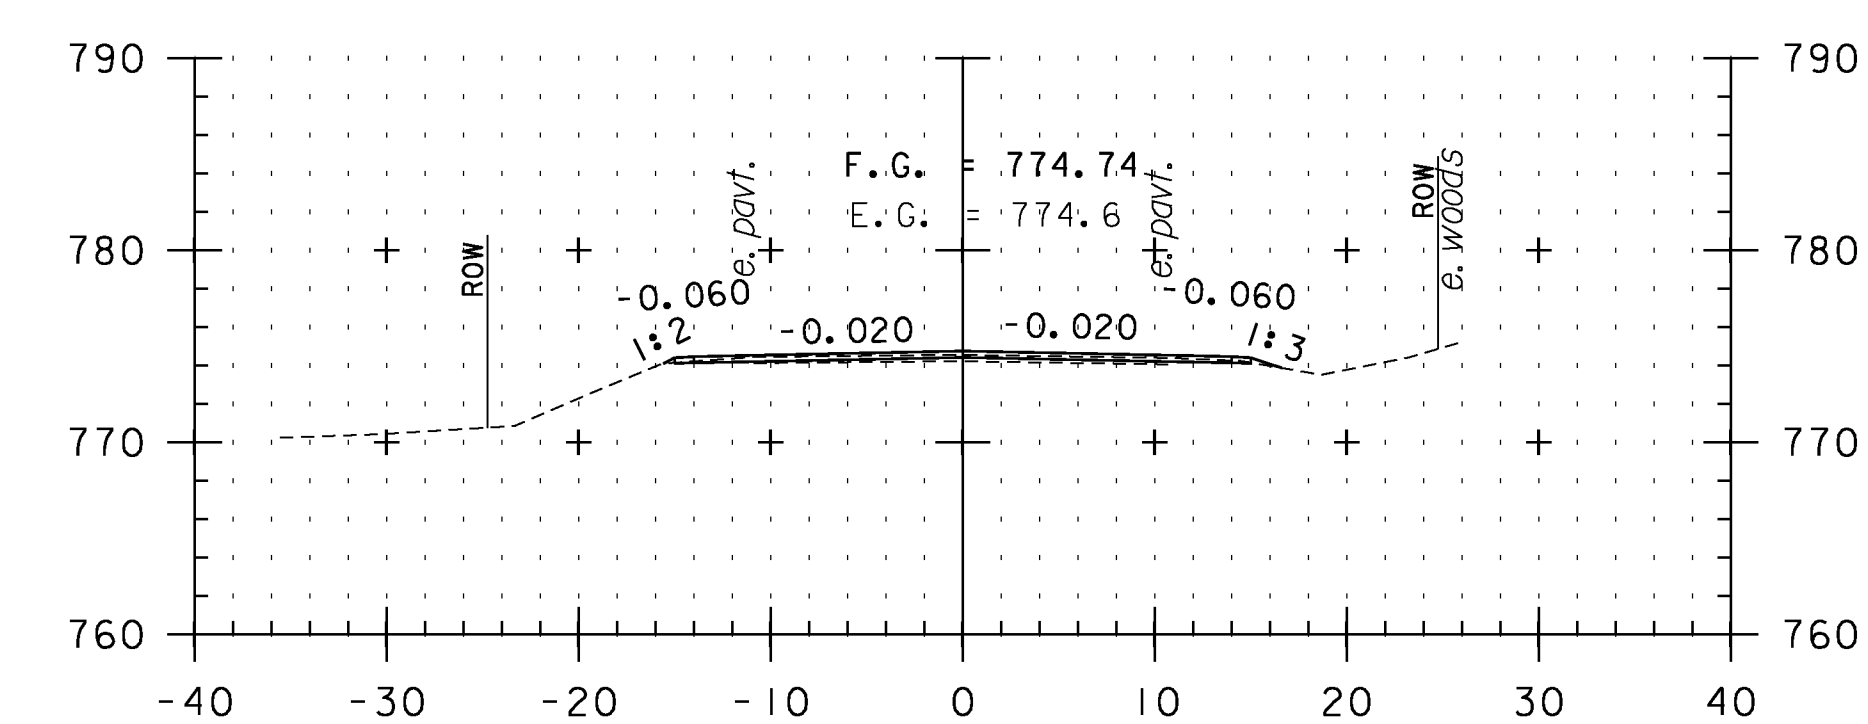


404+50

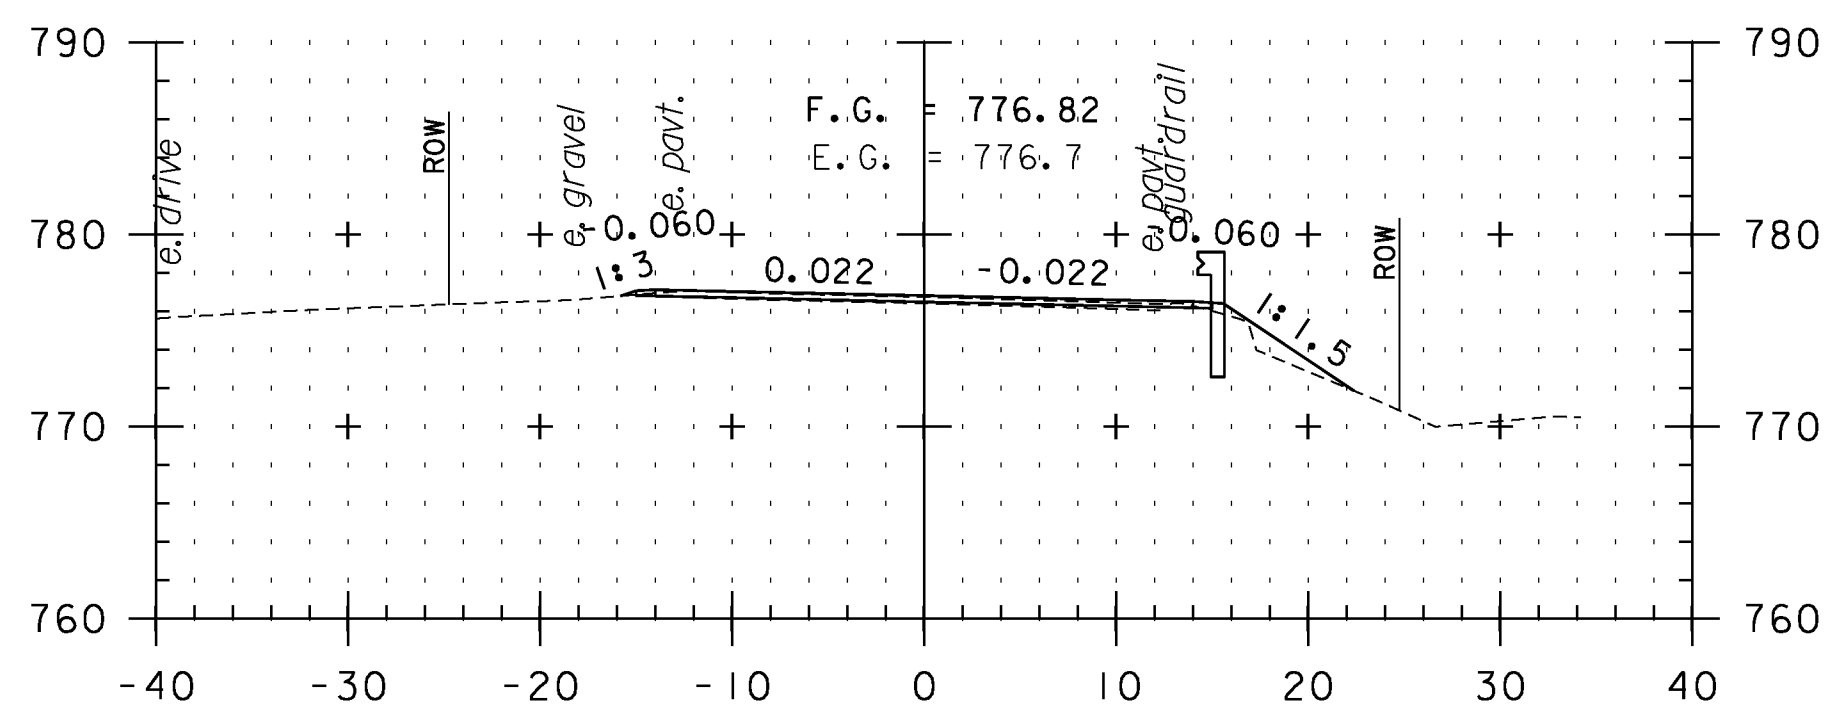


402+00

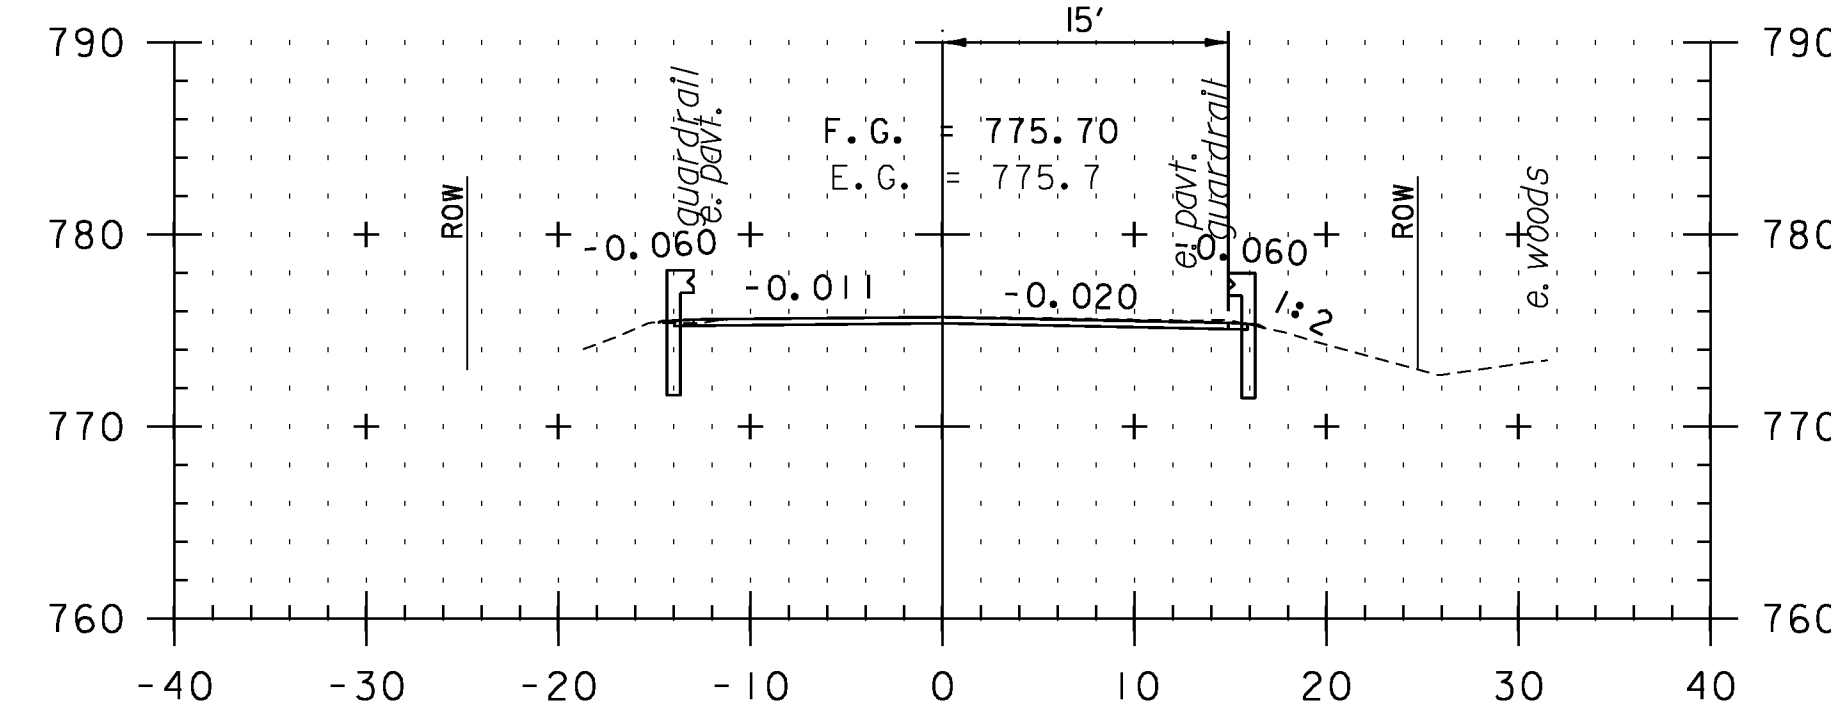


402+75  
END BRIDGE 22 APPROACH

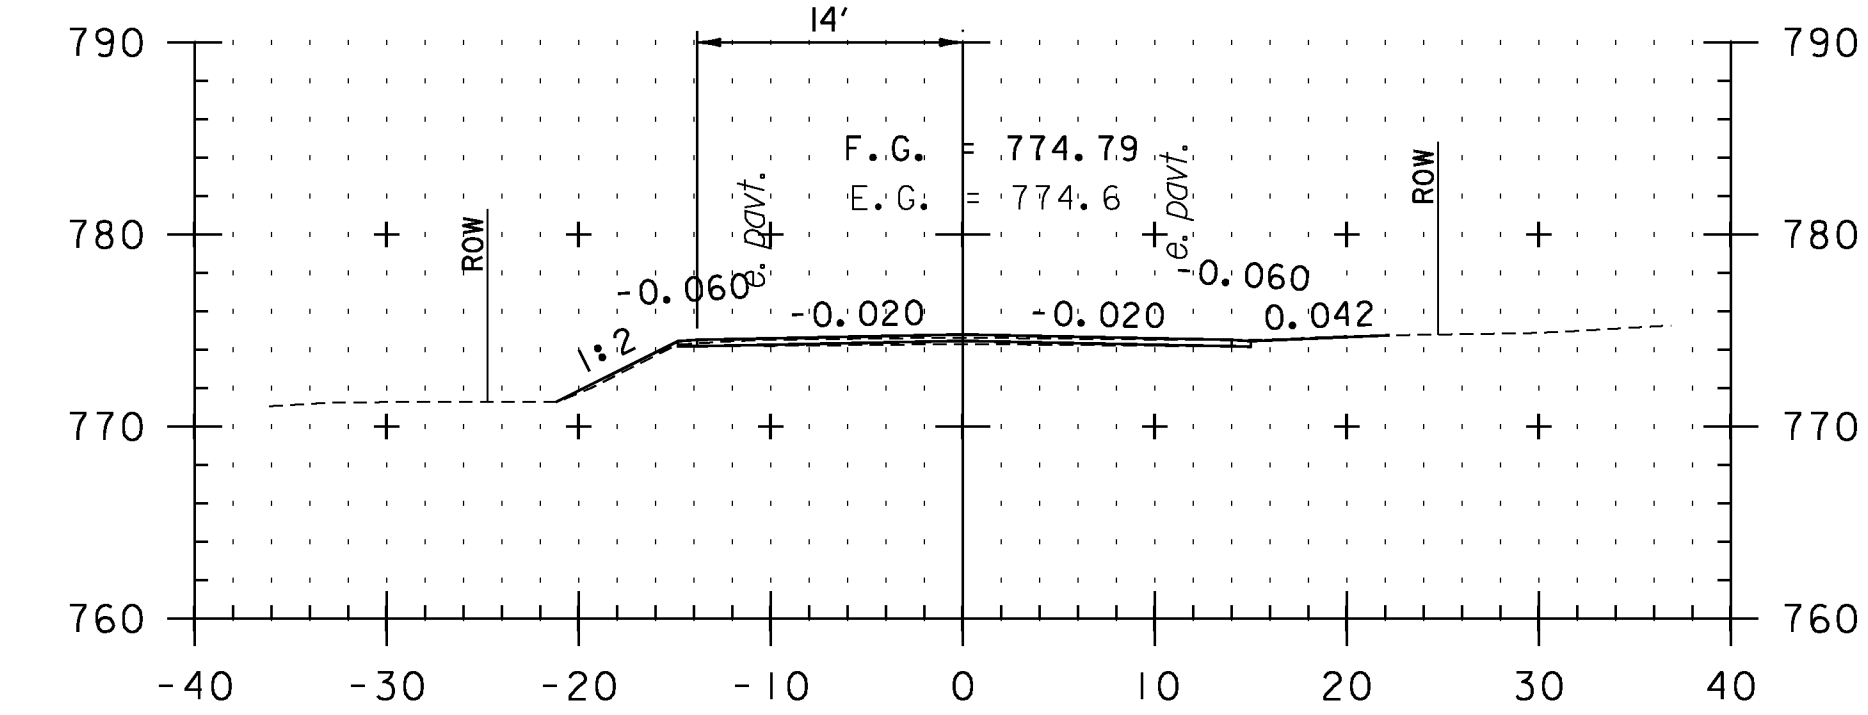


404+00

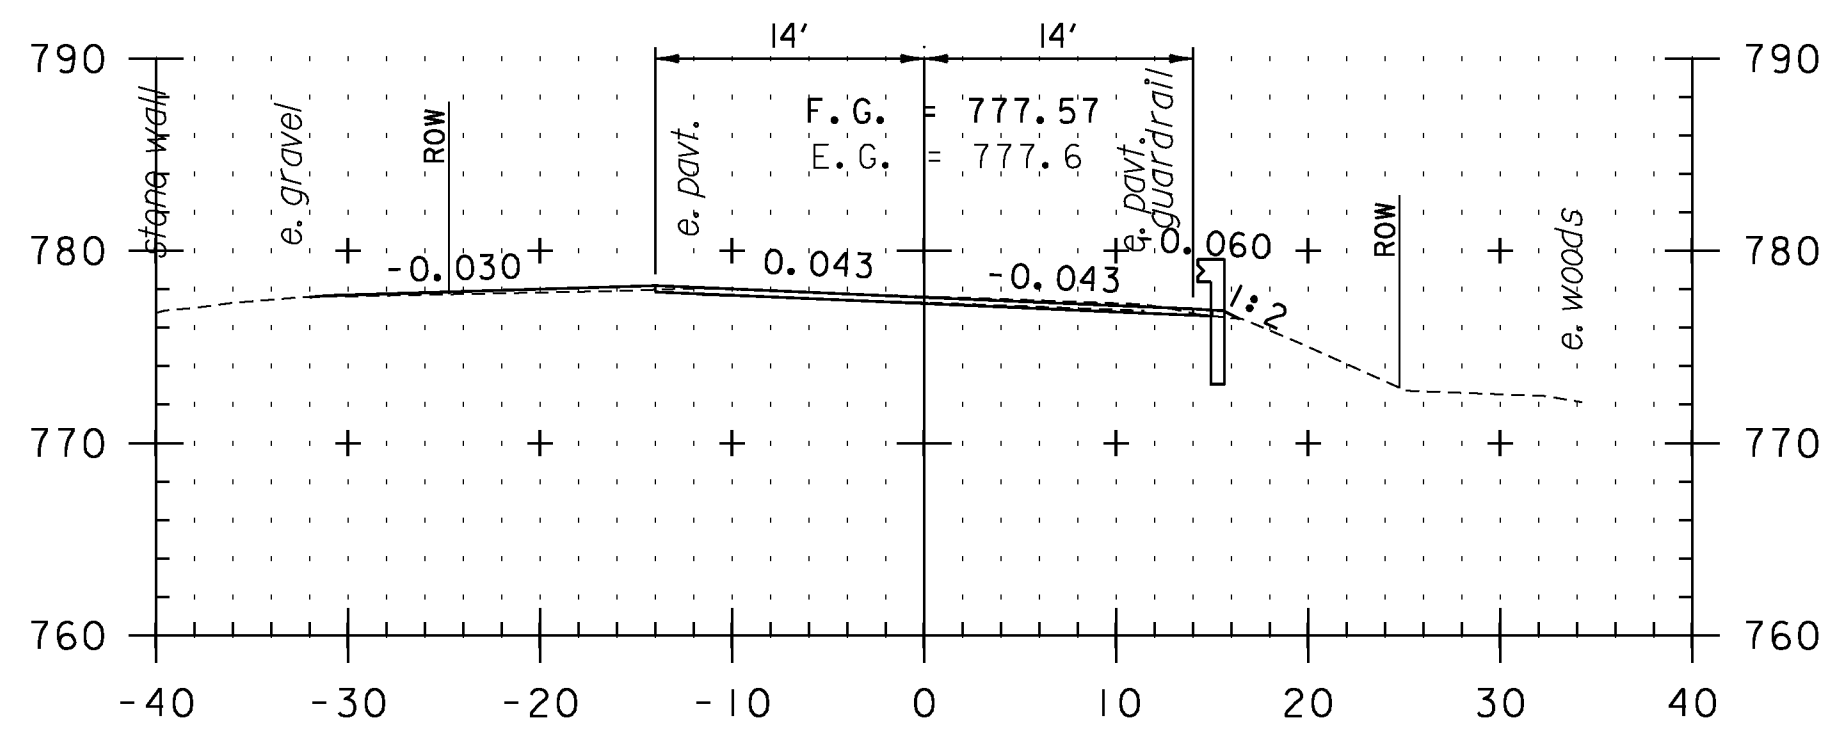

401+50

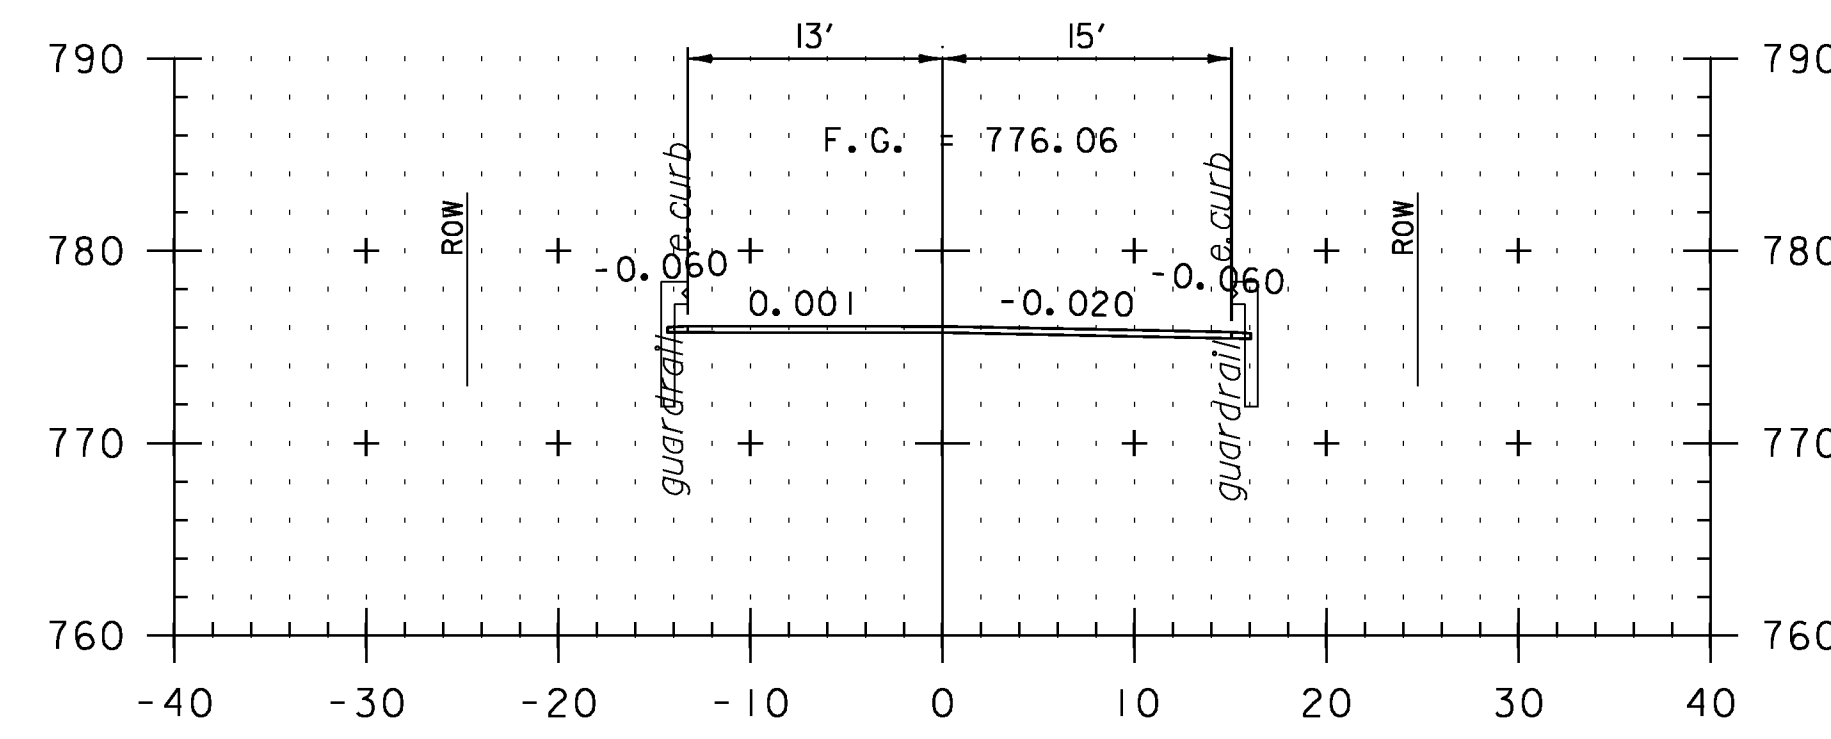


402+50

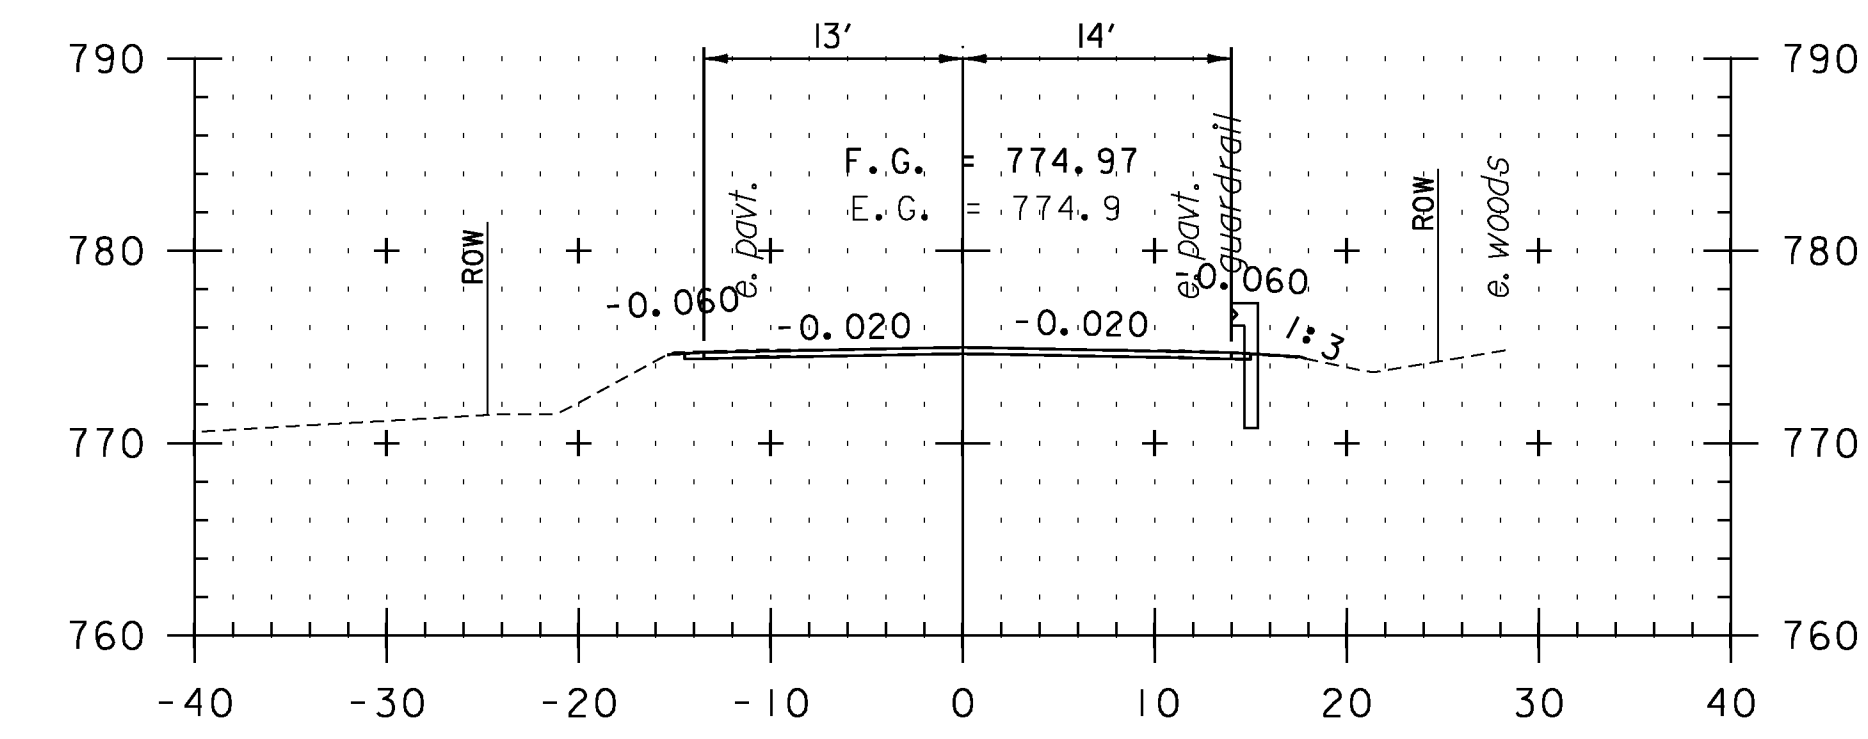

403+50

**CROSS SECTION SHEET 51**

STA. 401+50 TO STA. 404+50

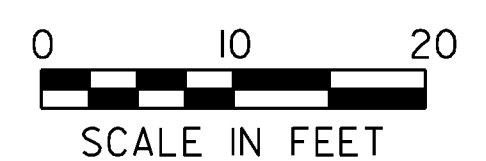

PROJECT NAME: VERSHIRE-THETFORD	PLOT DATE: 1/29/2013
PROJECT NUMBER: STP 2911(I)	DRAWN BY: SNG
FILE NAME: pl0c224.dgn	CHECKED BY: PTS
PROJECT LEADER: PTS	SHEET 159 OF 232
DESIGNED BY: NLL	
IPARM FILE NAME: IOC224_159	