




F2+00

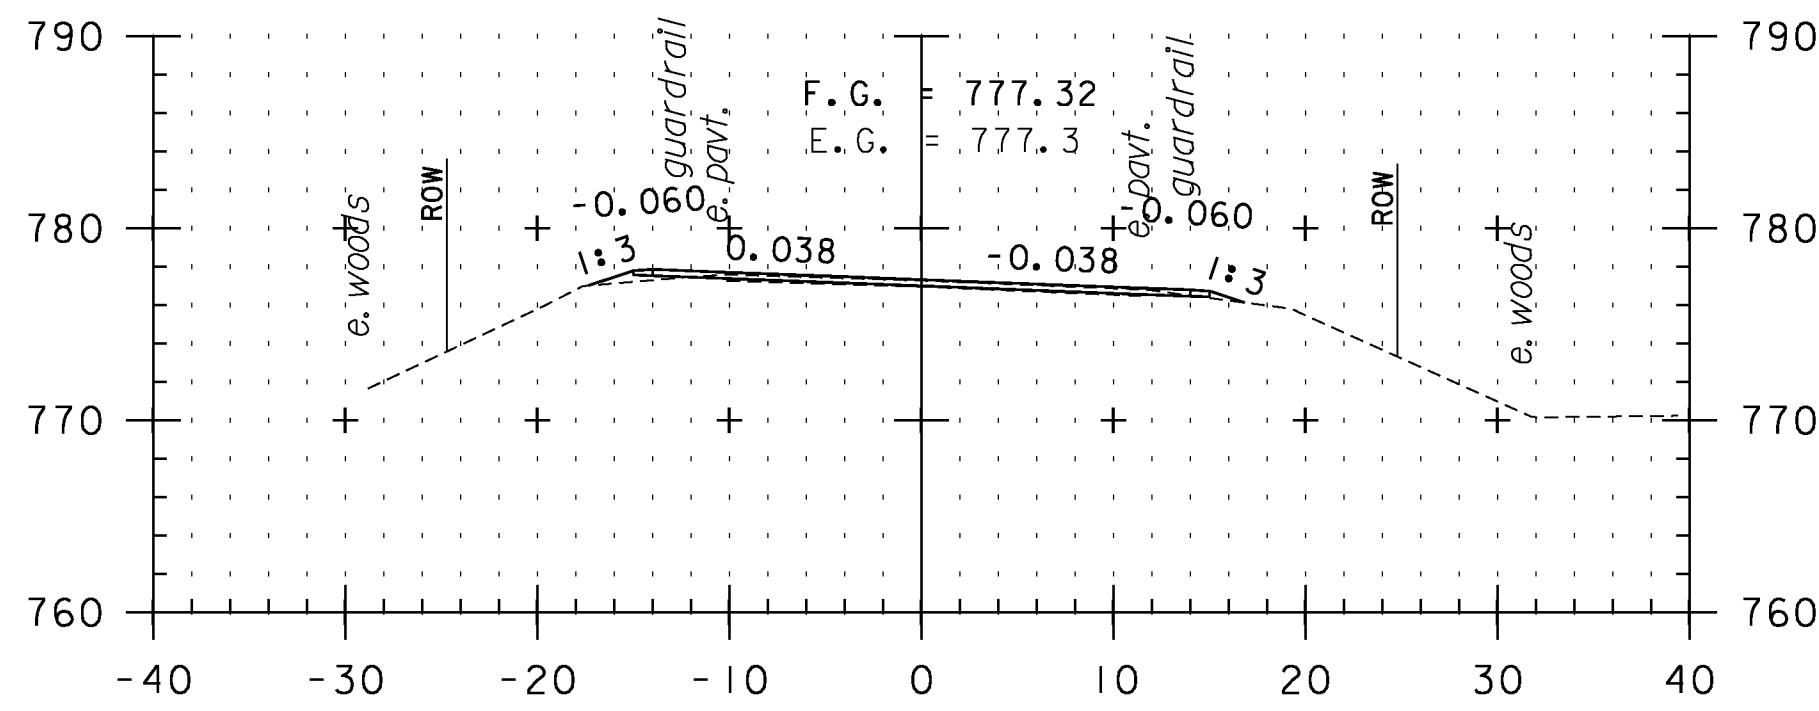


F3+50

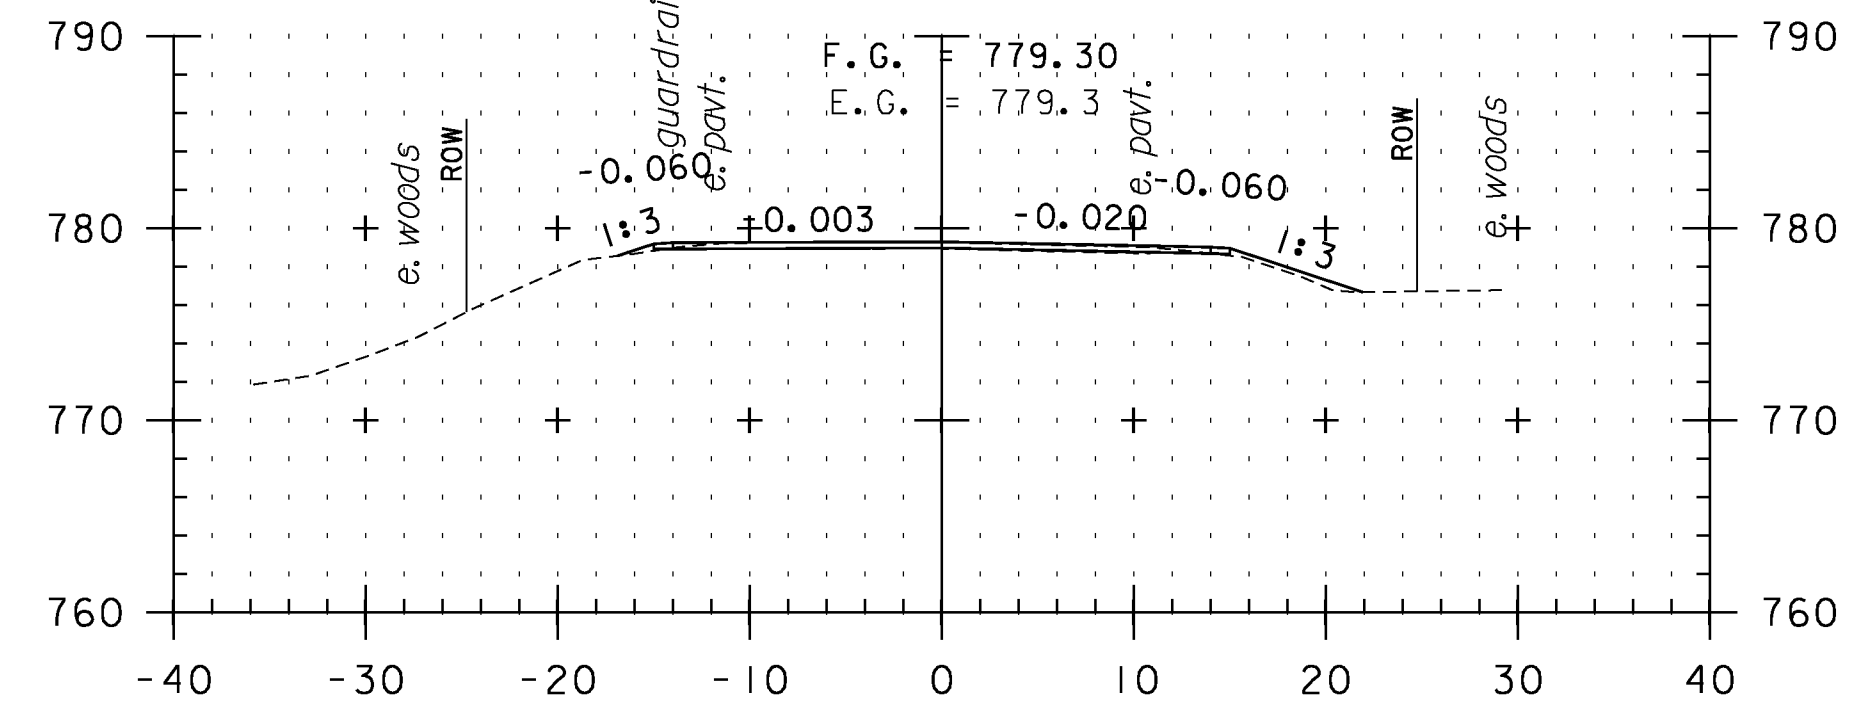


F5+00

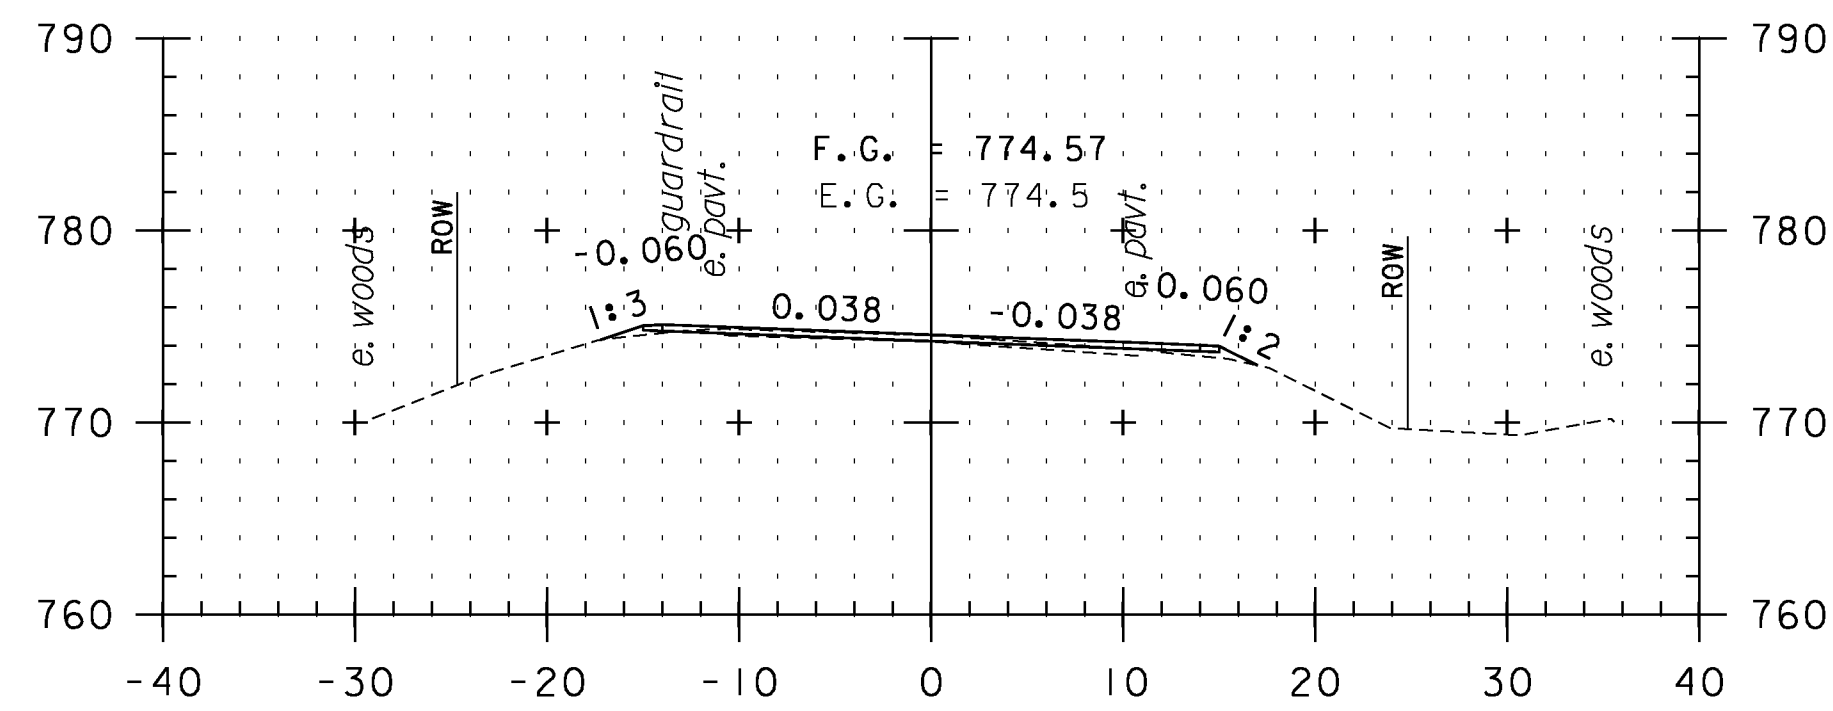


F1+50

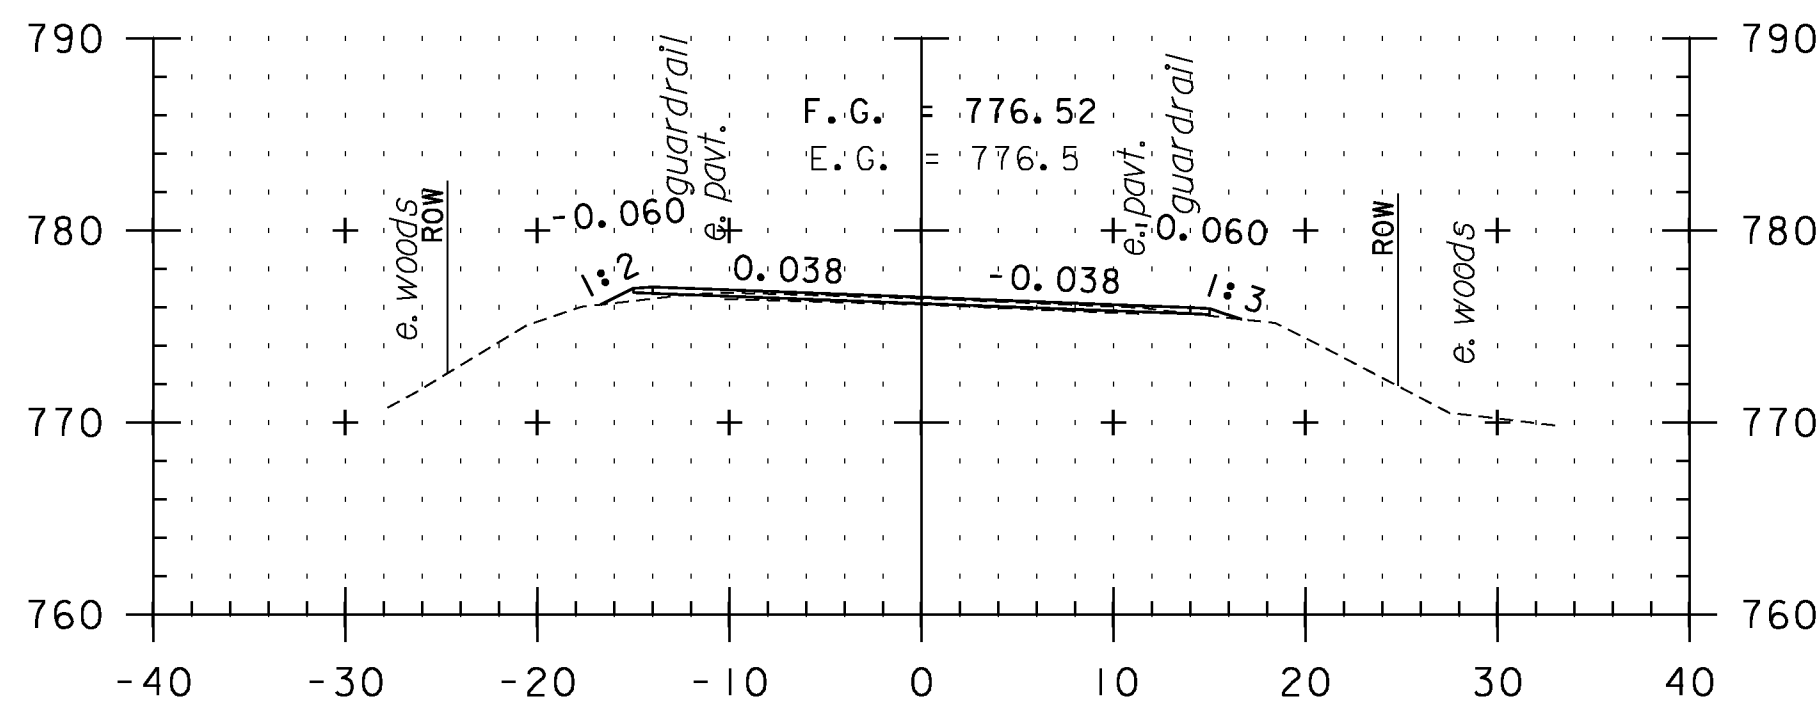


F3+00

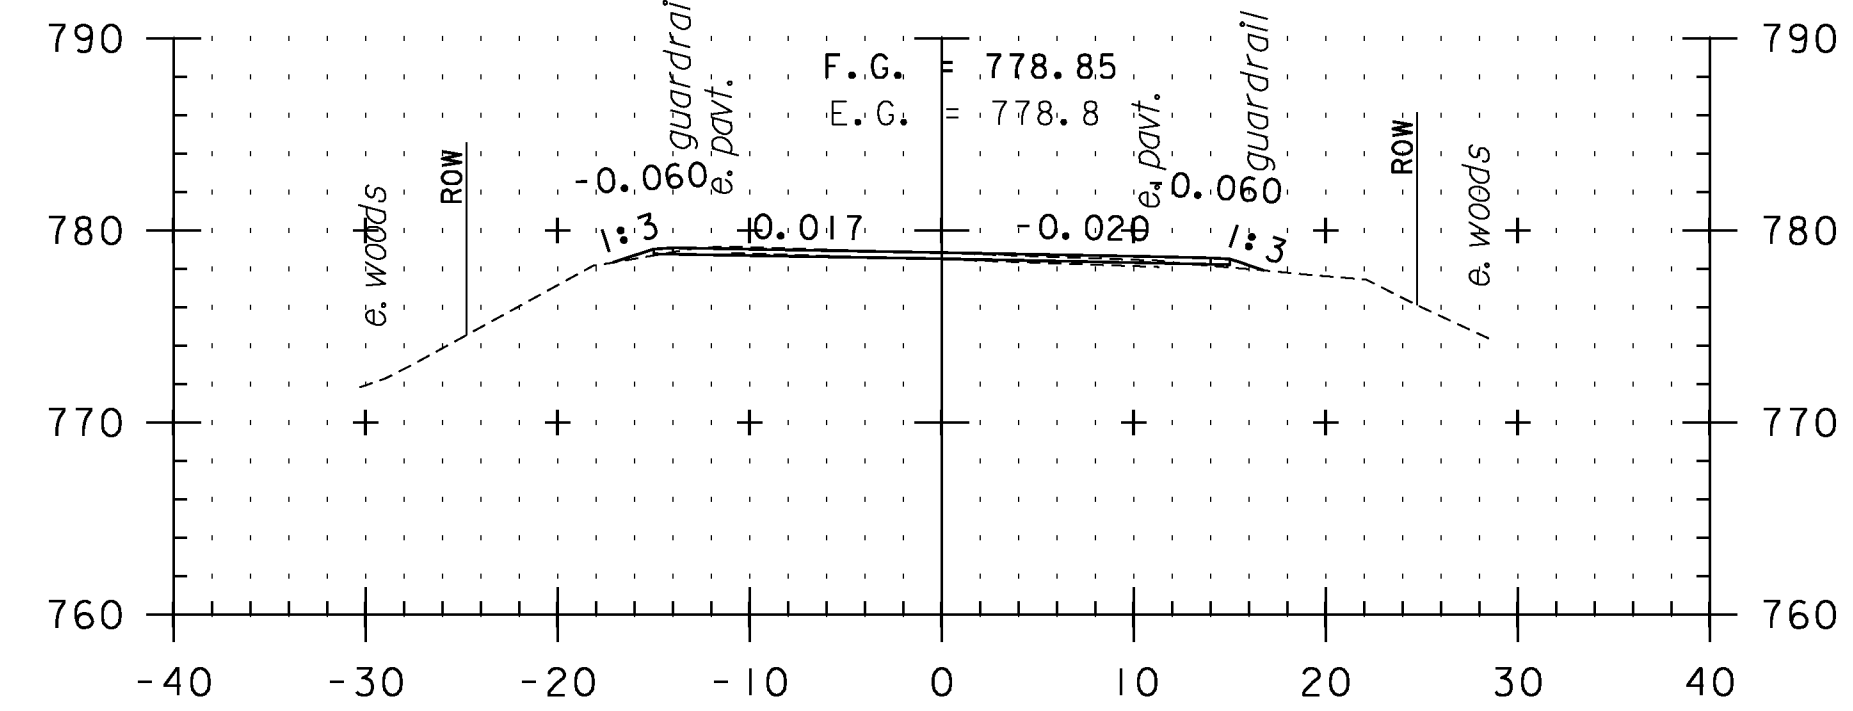


F4+50

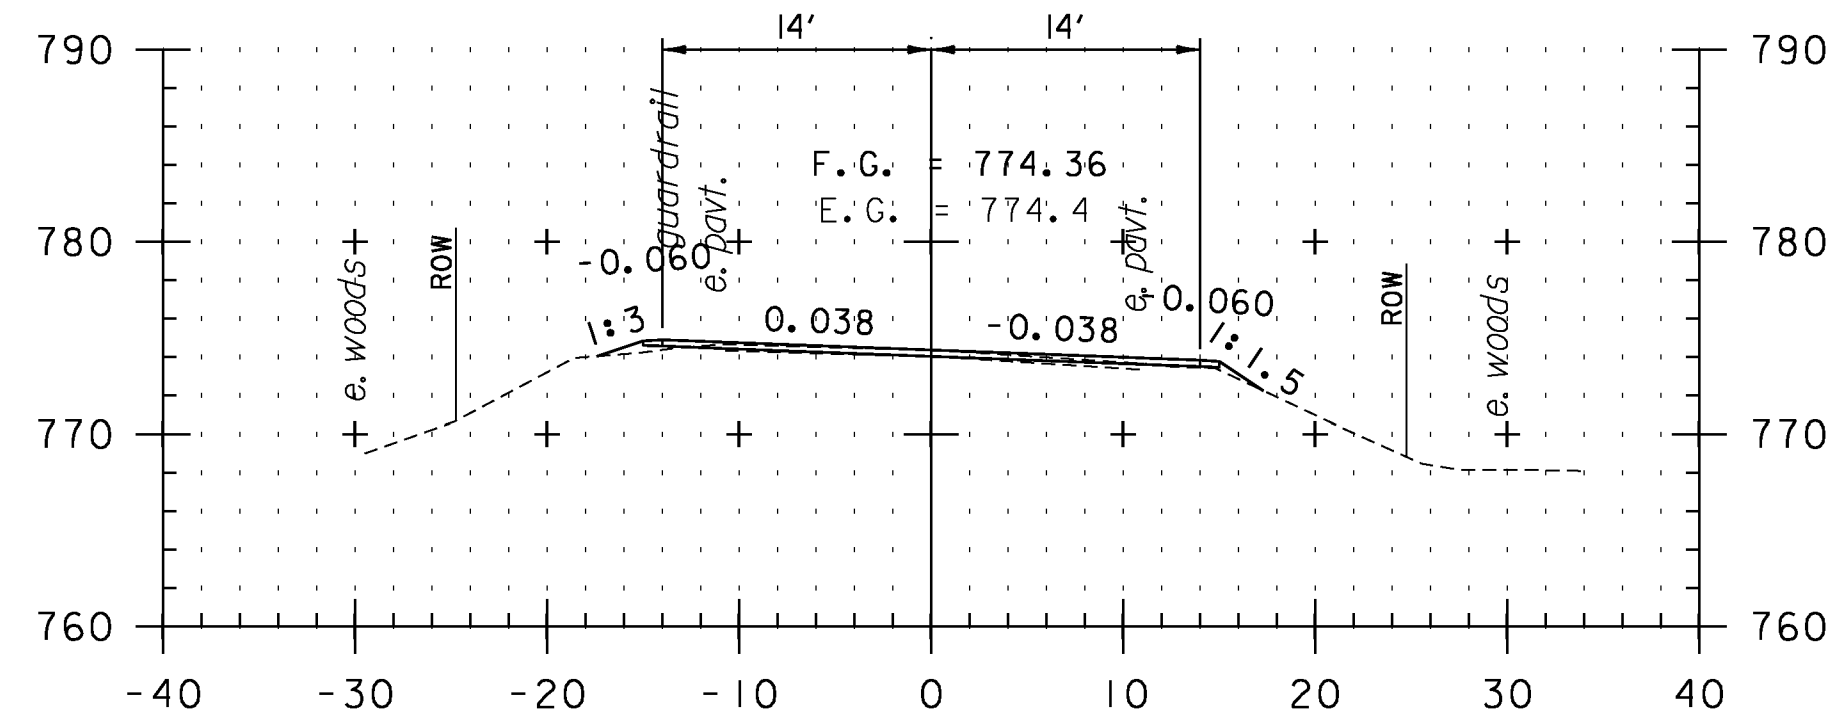

F1+00

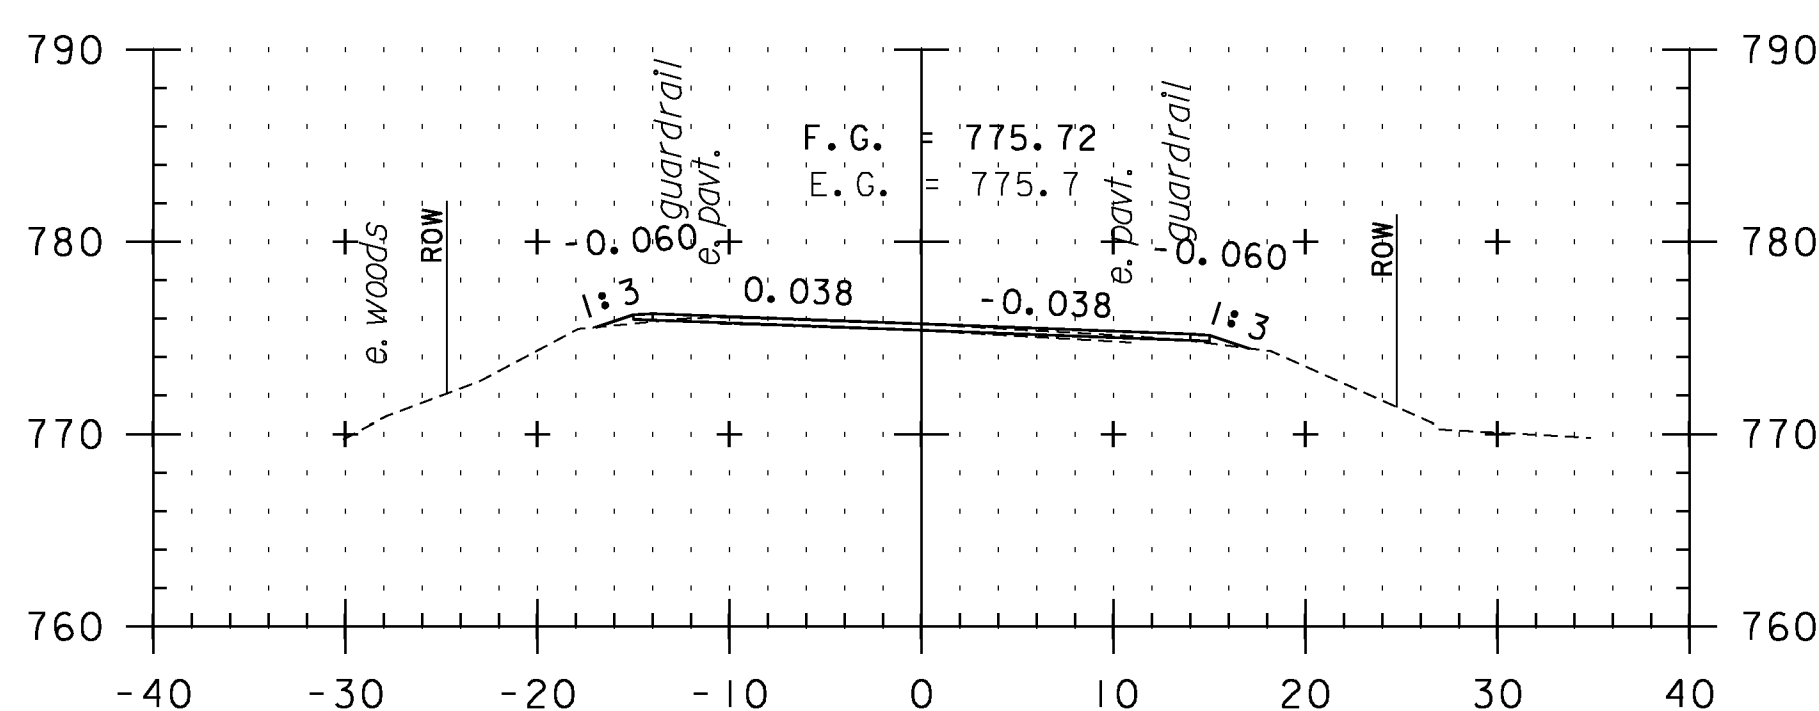

F2+50

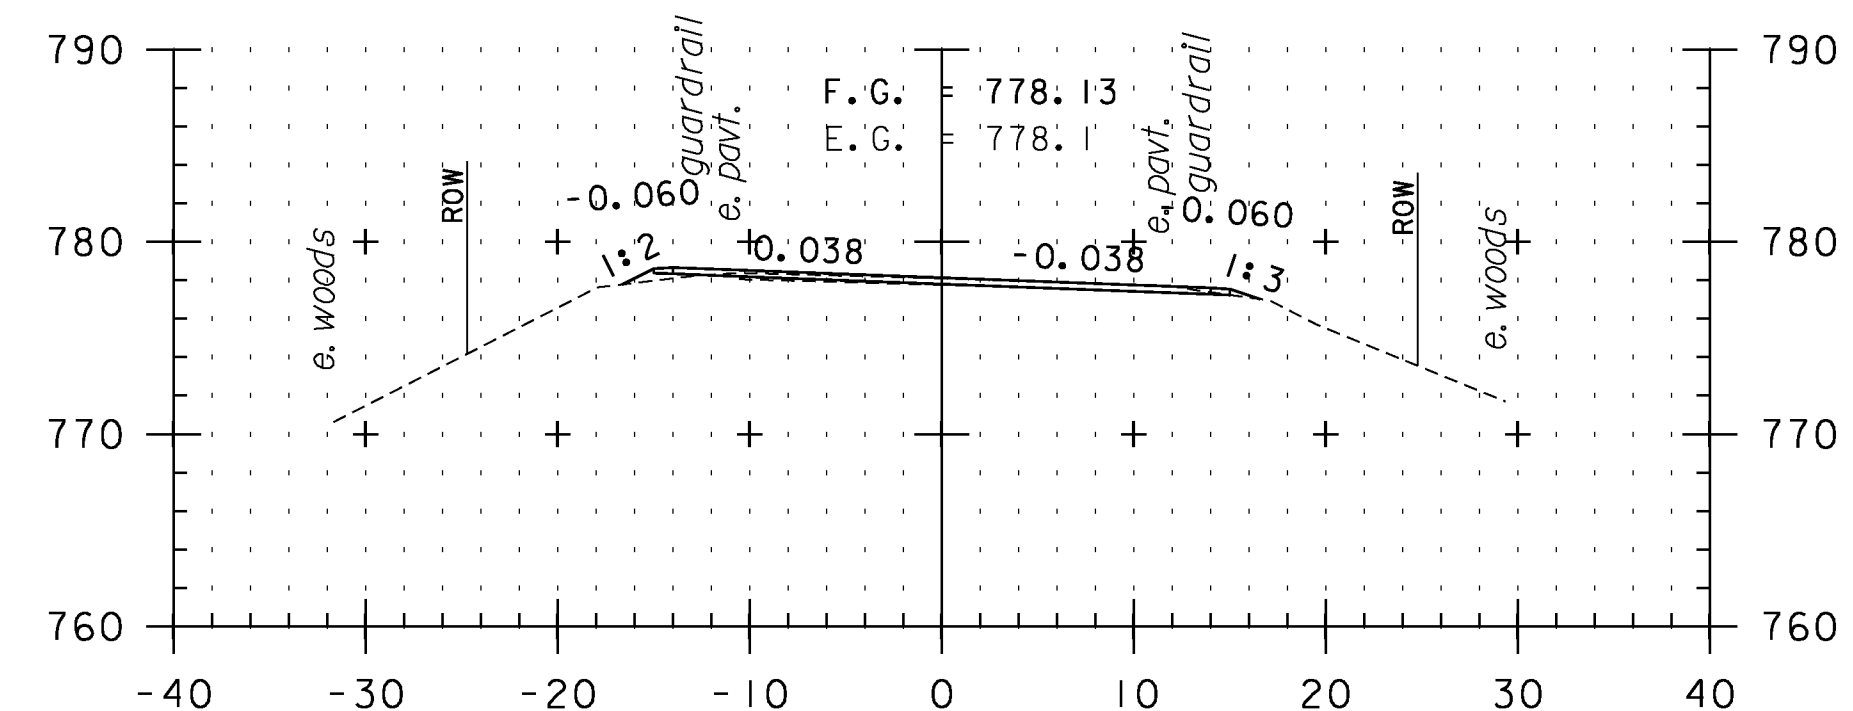

F4+00

CROSS SECTION SHEET 53

STA. F1+00 TO STA. F5+00



PROJECT NAME: VERSHIRE-THETFORD	PLOT DATE: 1/29/2013
PROJECT NUMBER: STP 2911(I)	DRAWN BY: SNG
FILE NAME: pl0c224.dgn	CHECKED BY: PTS
PROJECT LEADER: PTS	SHEET 161 OF 232
DESIGNED BY: NULL	
IPARM FILE NAME: IOC224_161	