




F6+00

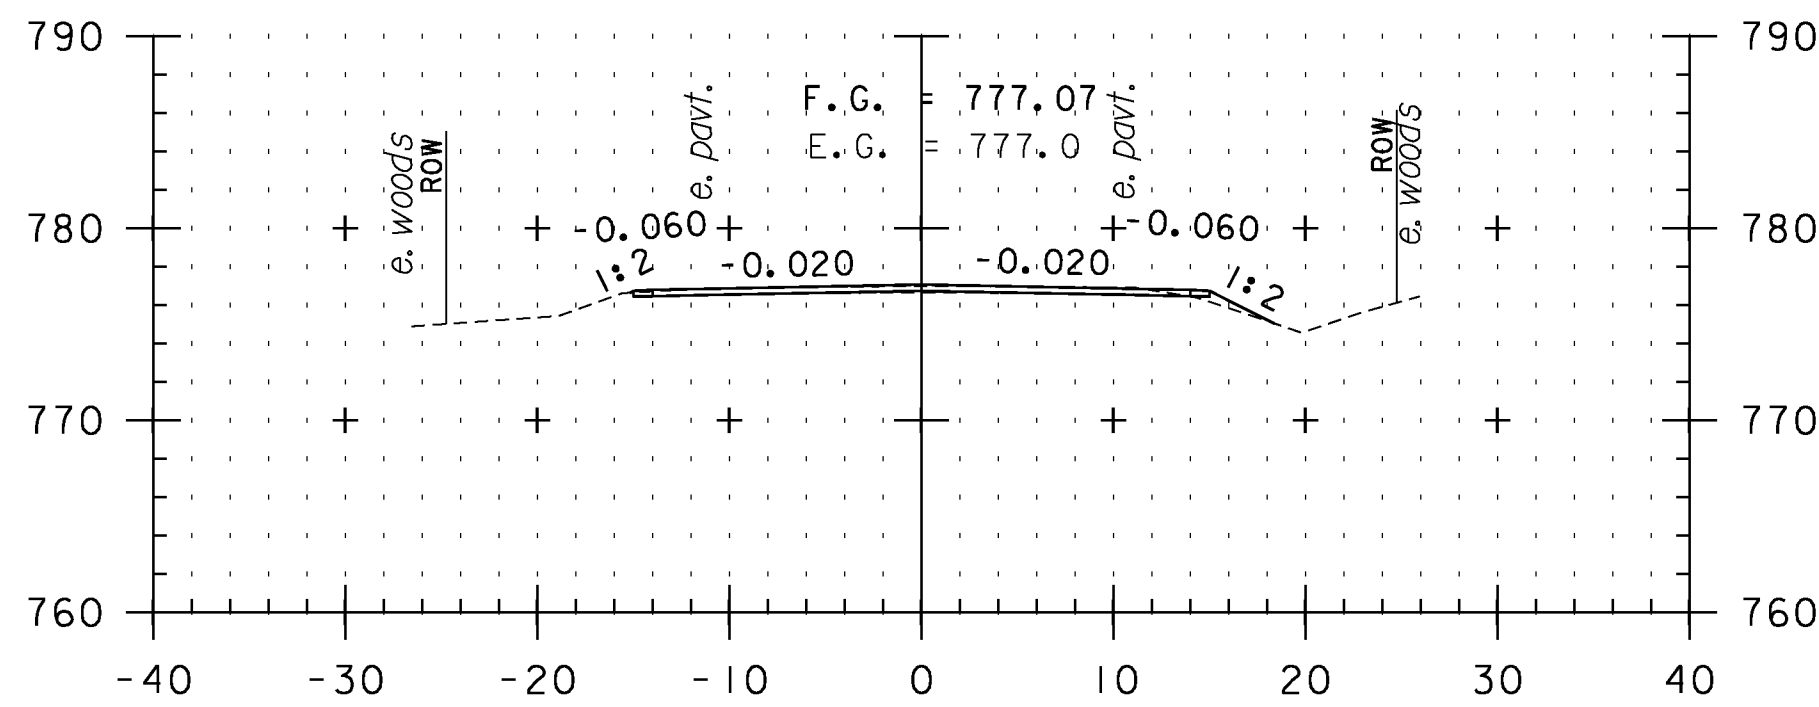


F7+50

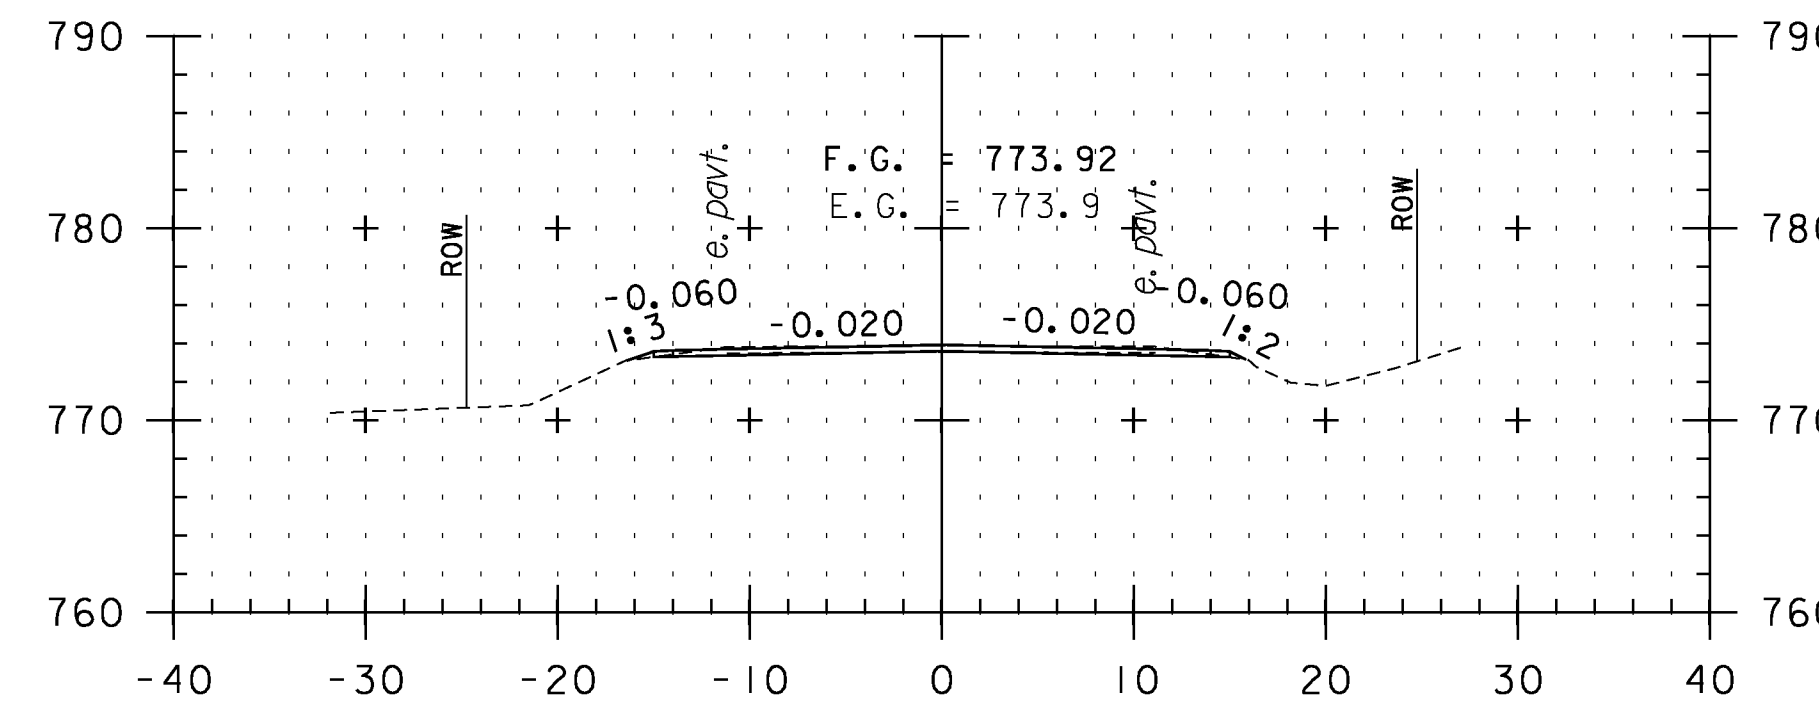


F9+00

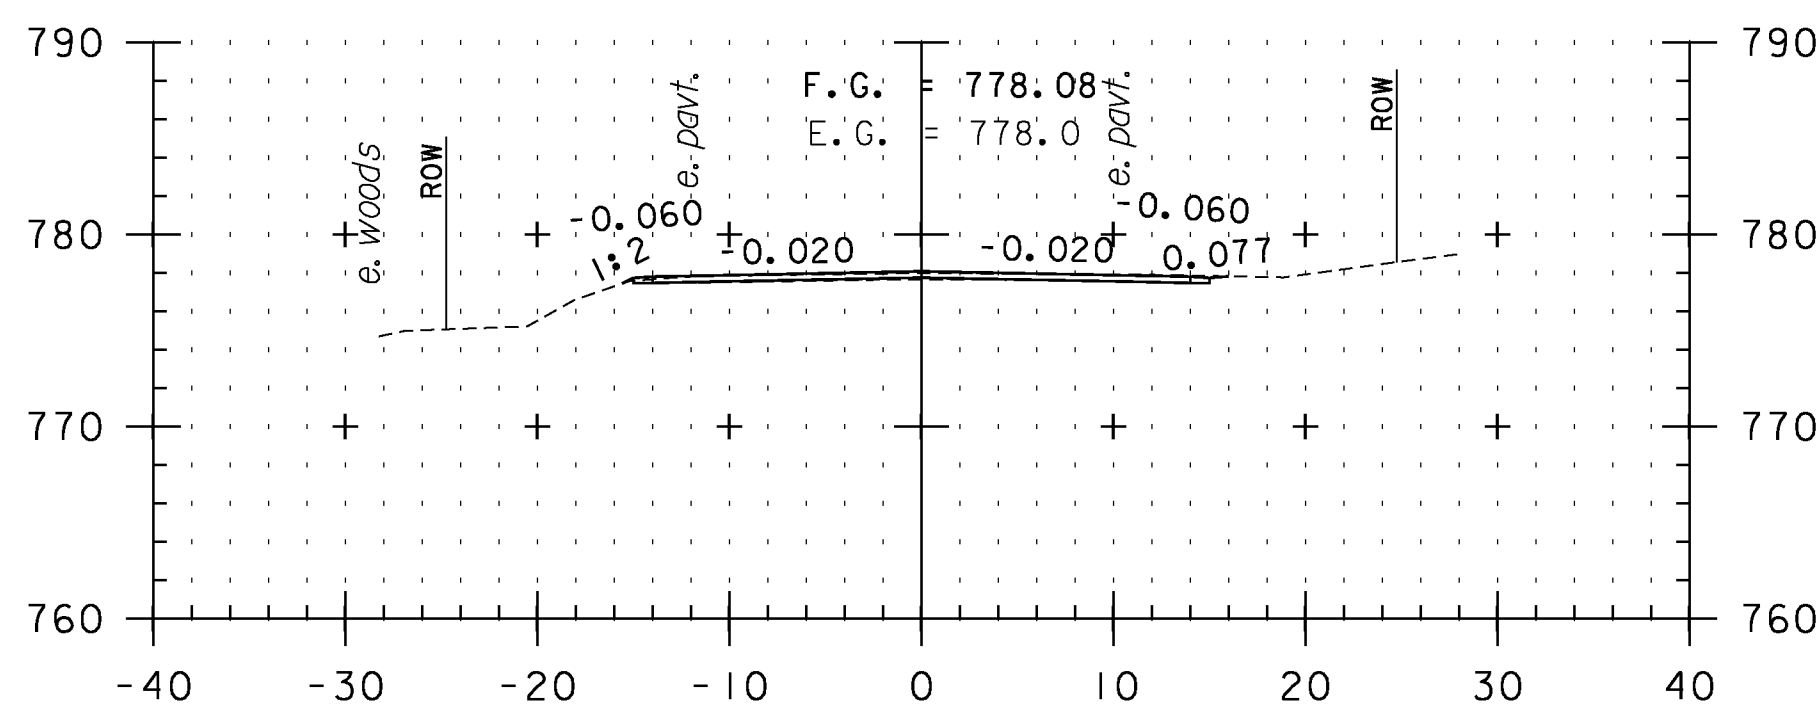


F7+00

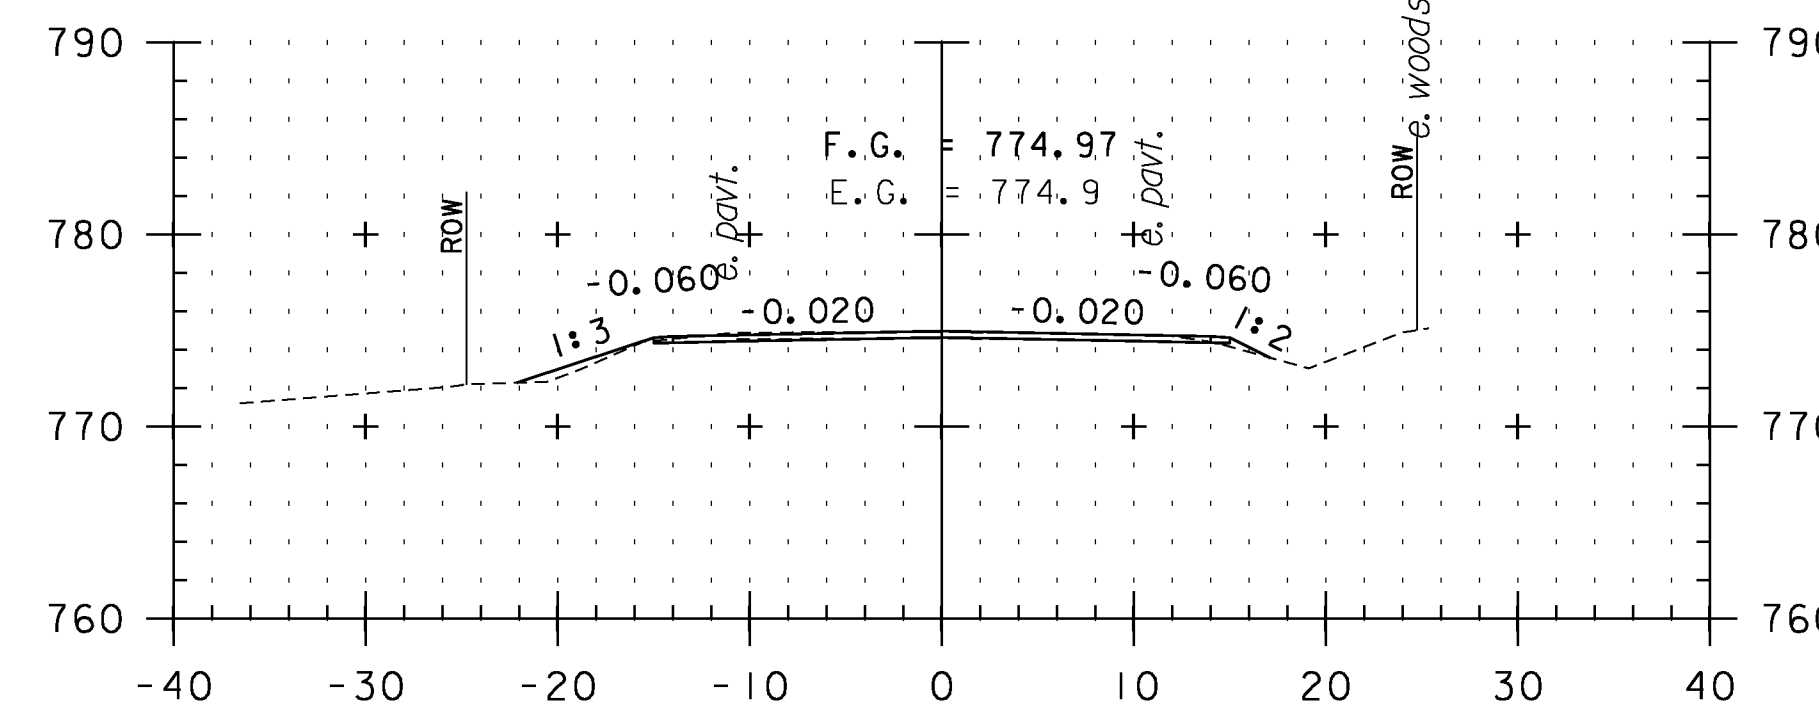


F8+50

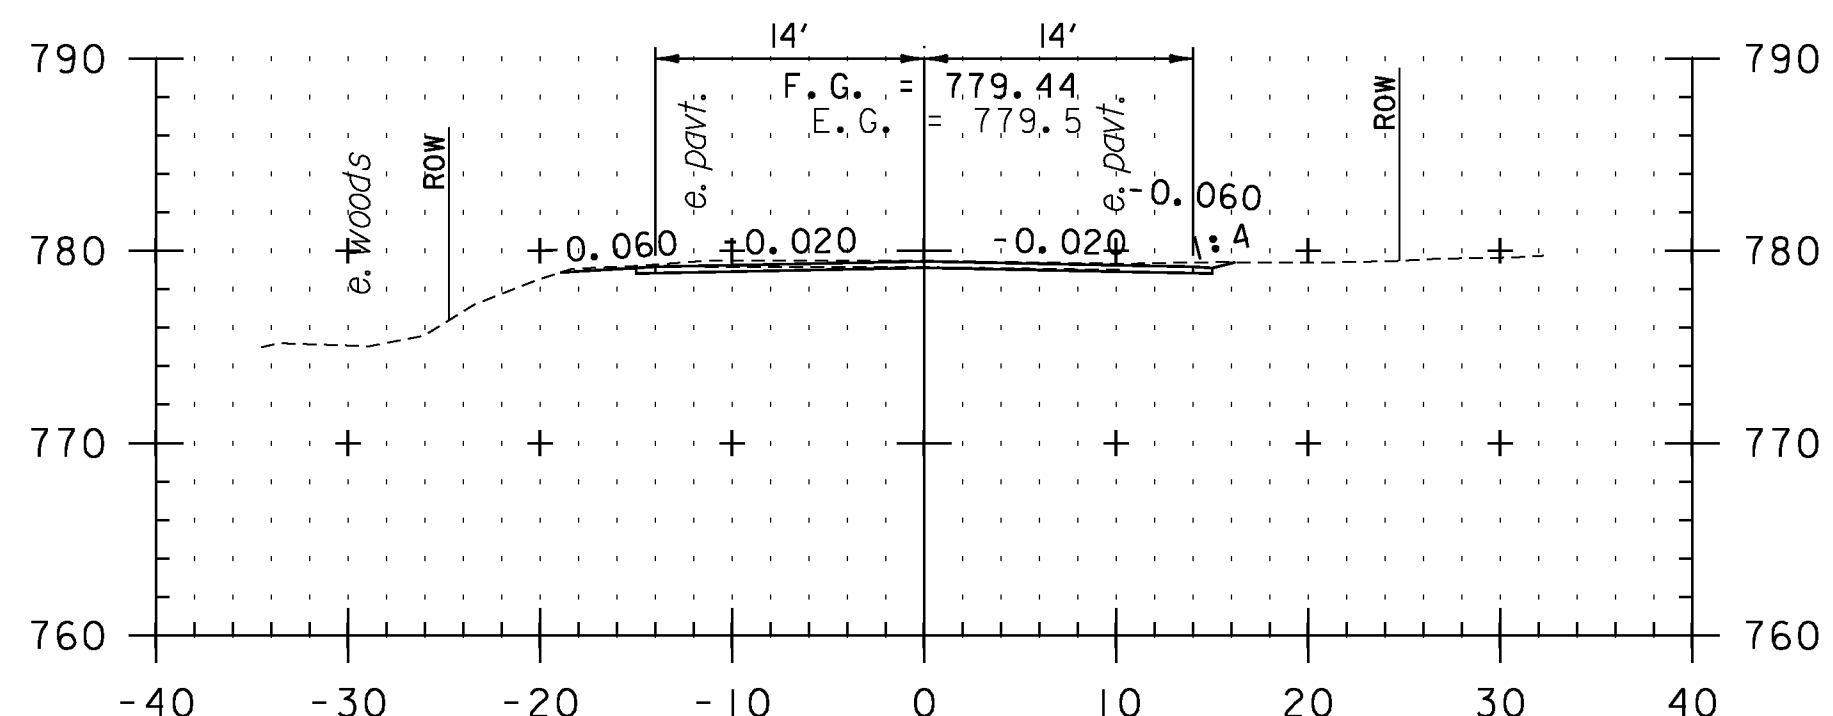

F5+50

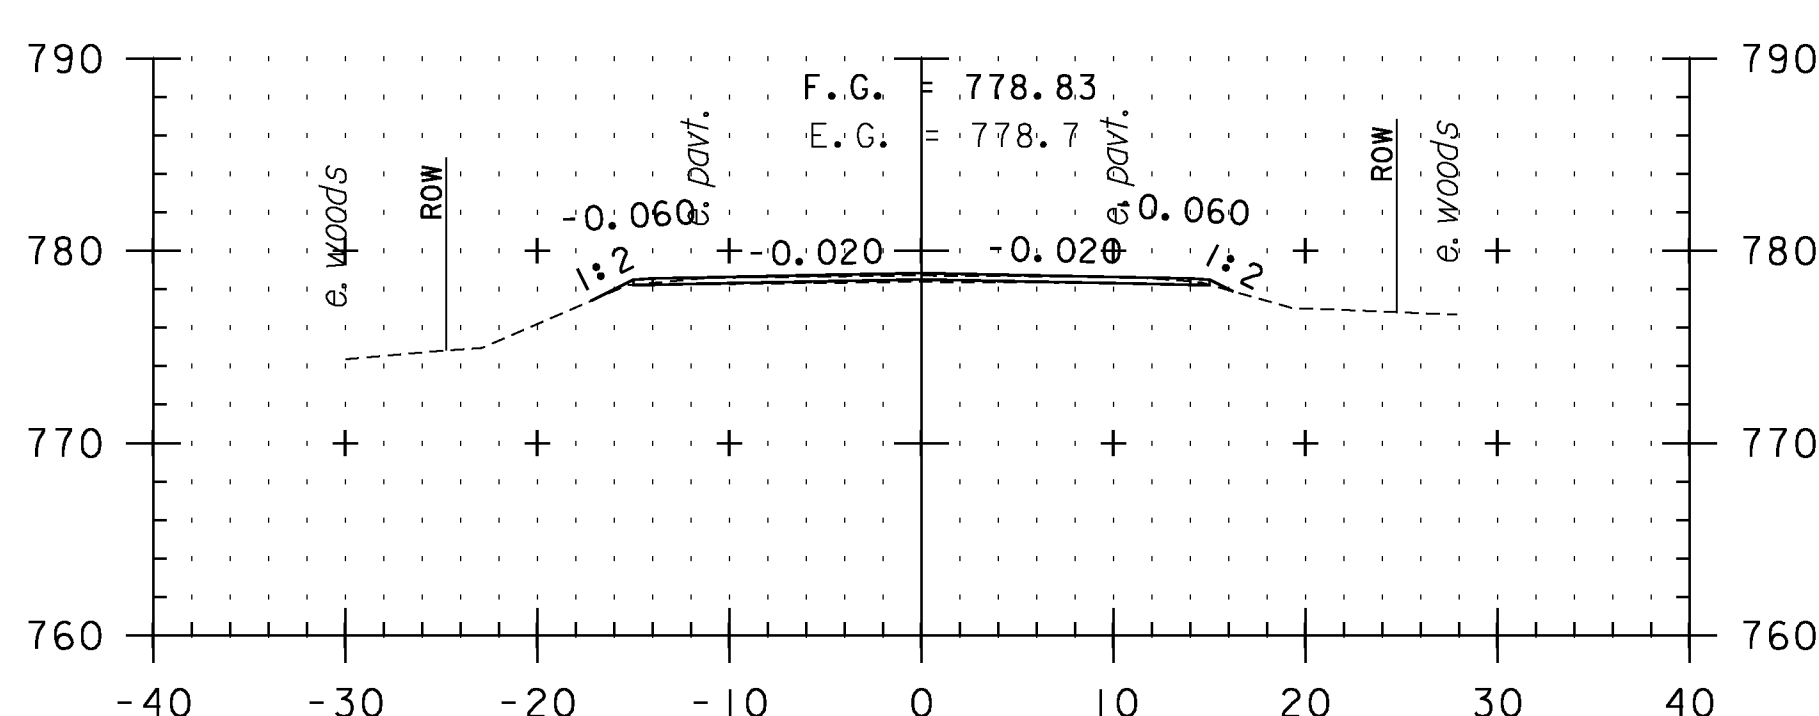


F6+50

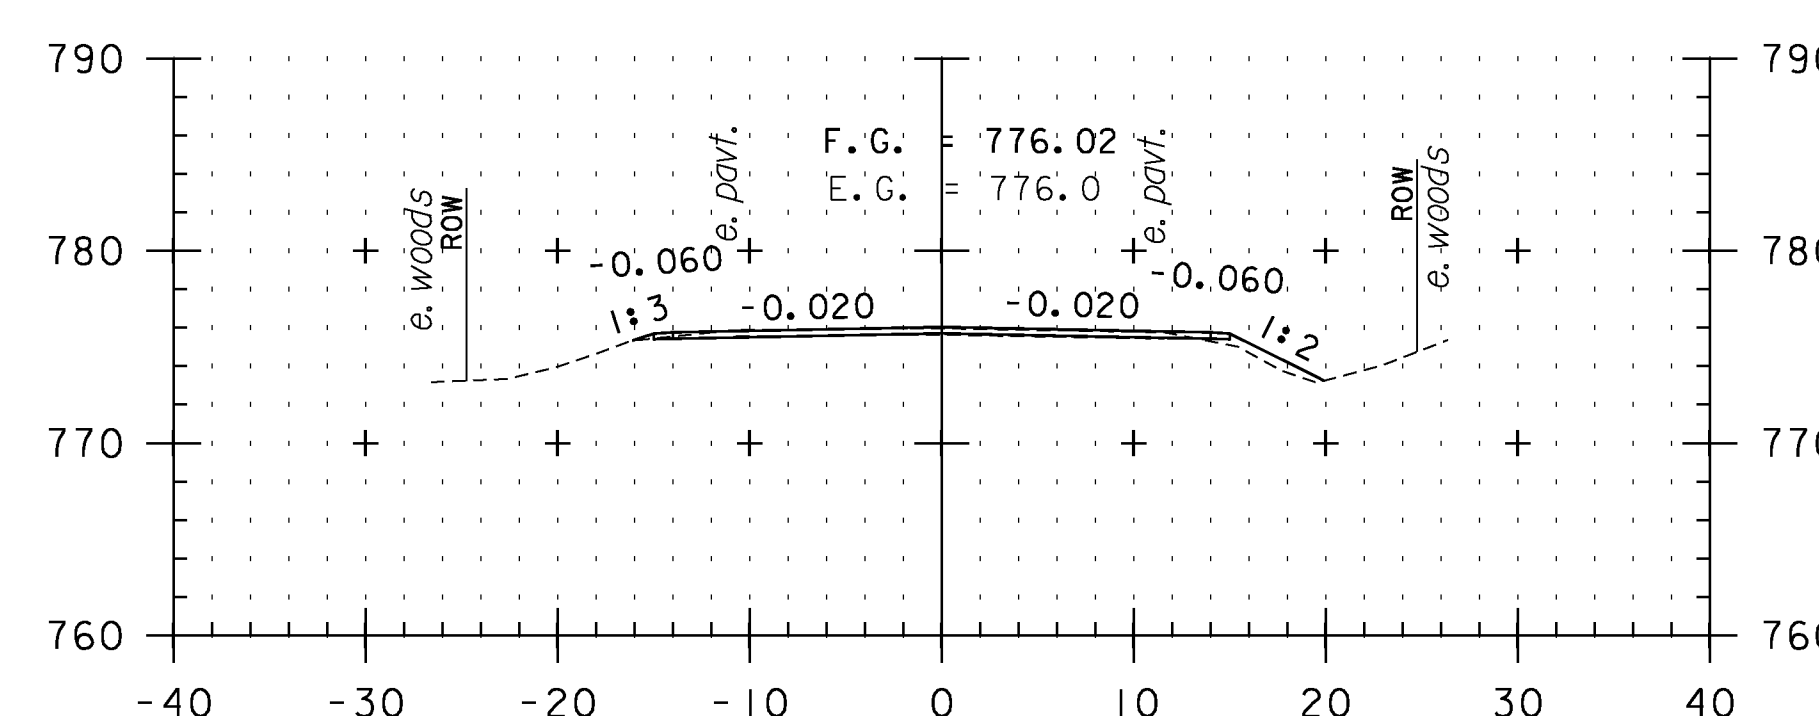

F8+00

**CROSS SECTION SHEET 54**

STA. F5+50 TO STA. F9+00

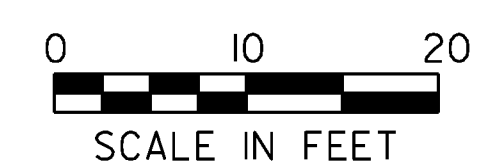

PROJECT NAME: VERSHIRE-THETFORD	PLOT DATE: 1/29/2013
PROJECT NUMBER: STP 2911(I)	DRAWN BY: SNG
FILE NAME: pl0c224.dgn	CHECKED BY: PTS
PROJECT LEADER: PTS	SHEET 162 OF 232
DESIGNED BY: NLL	
IPARM FILE NAME: IOC224_162	