




F 15+00

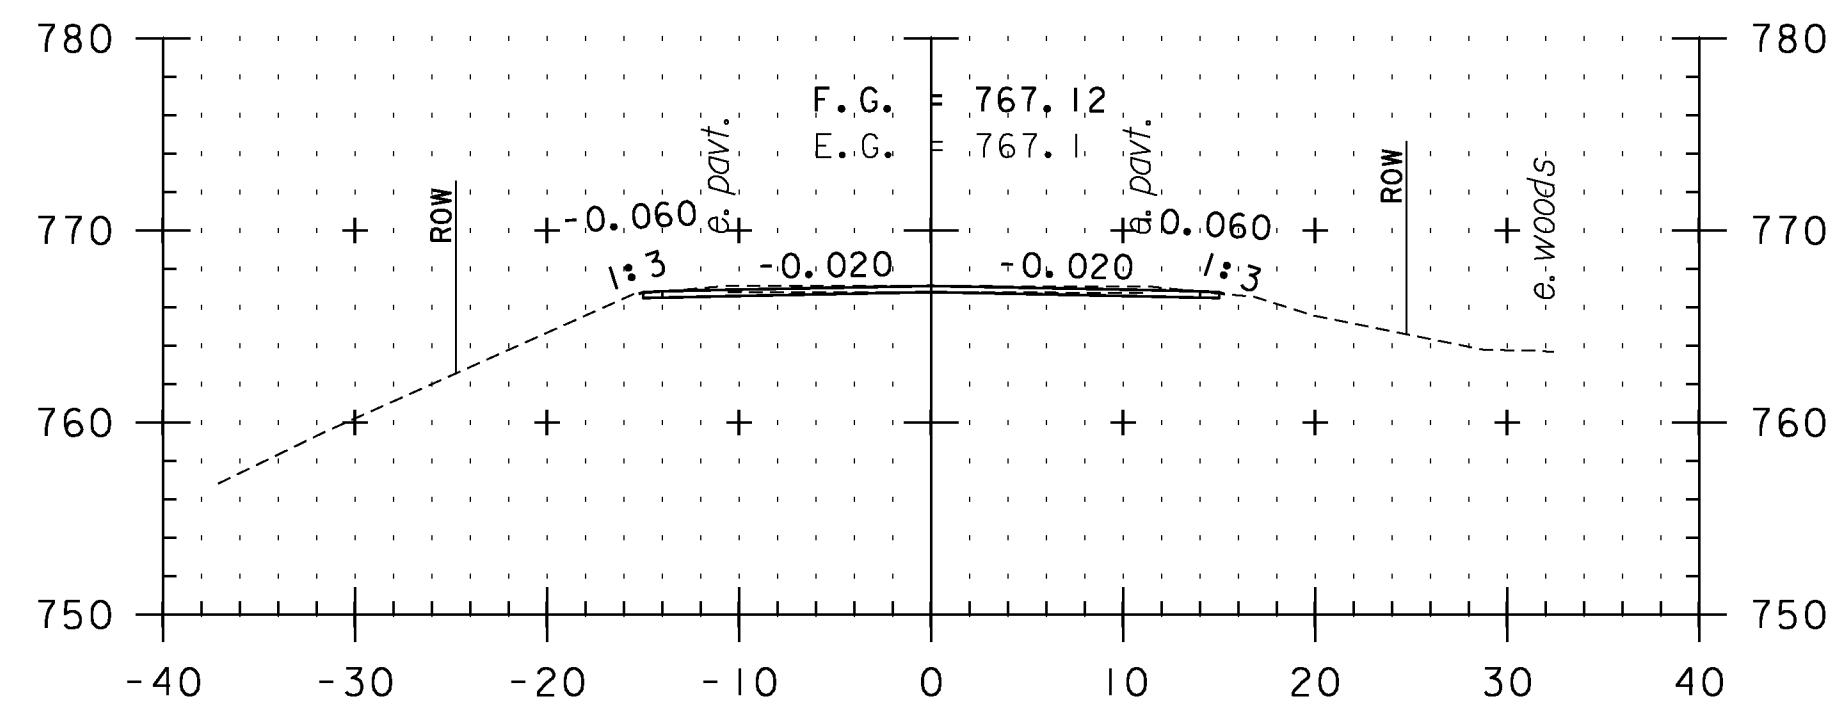


F 14+50

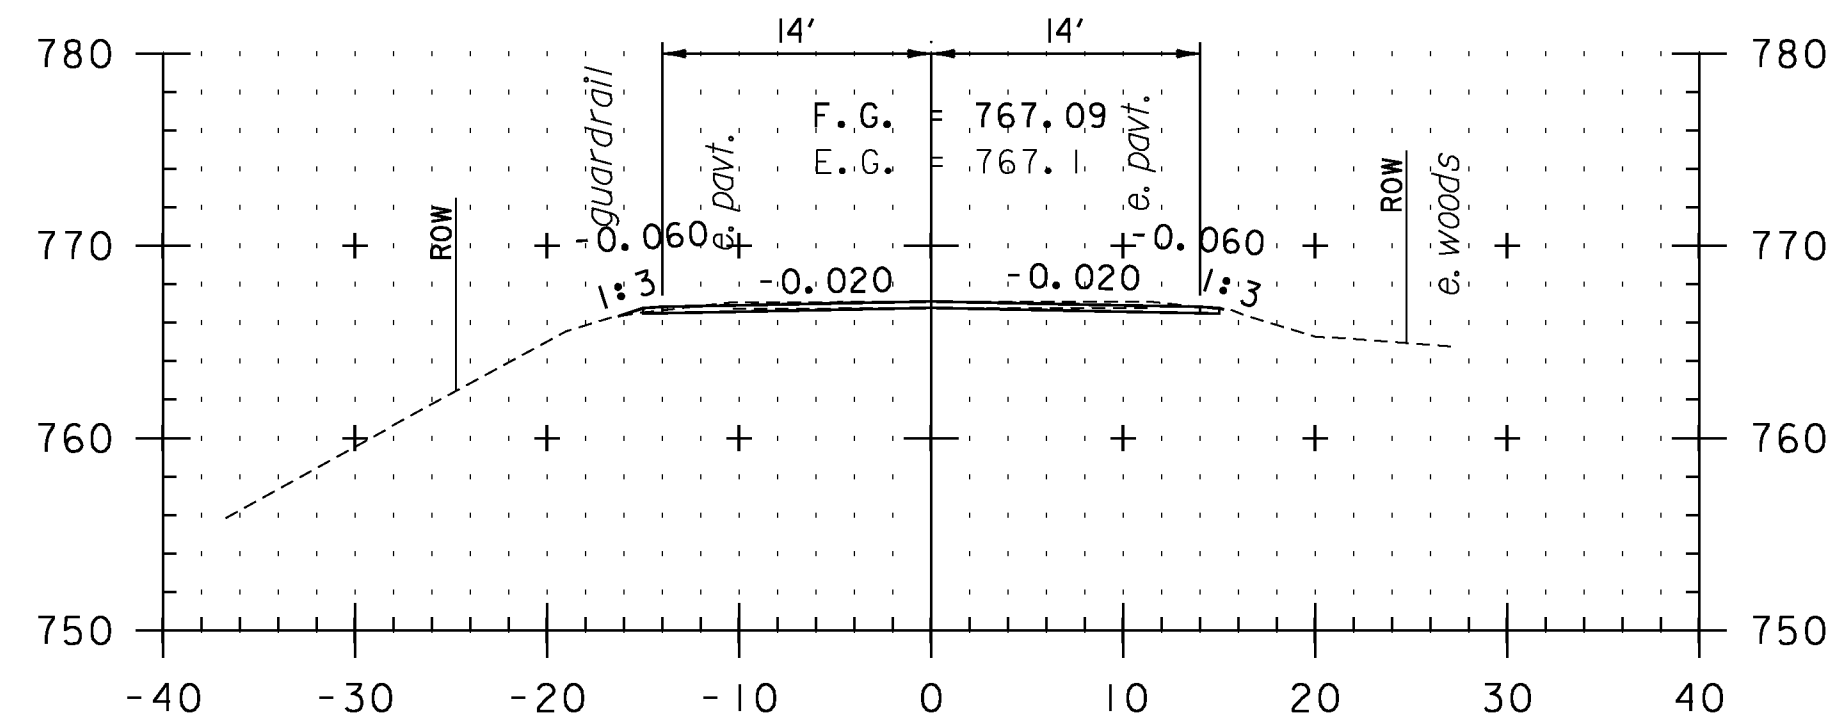


F 14+00

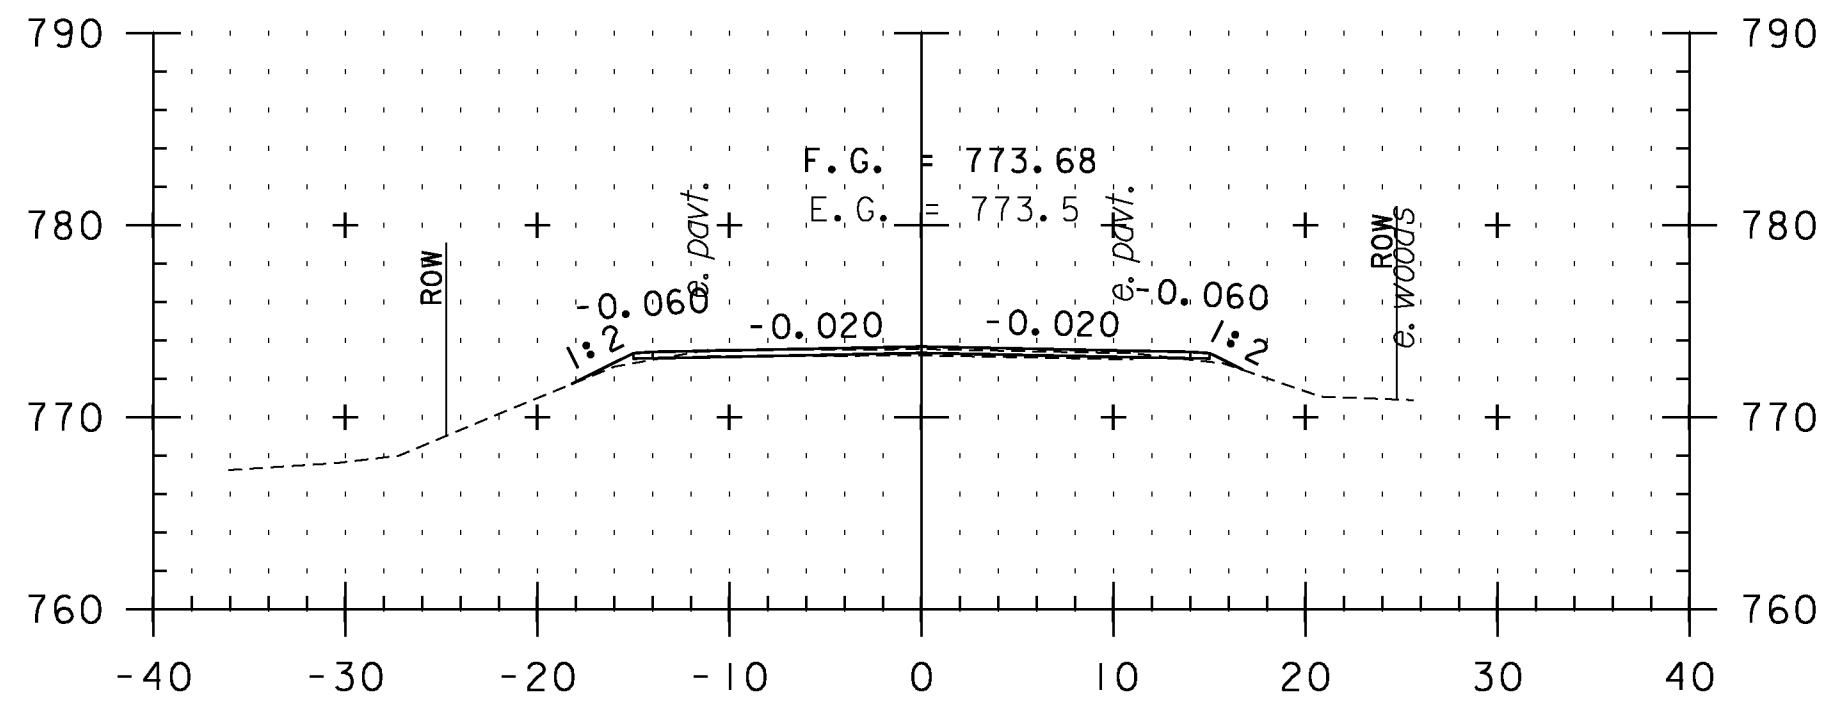


F 16+50

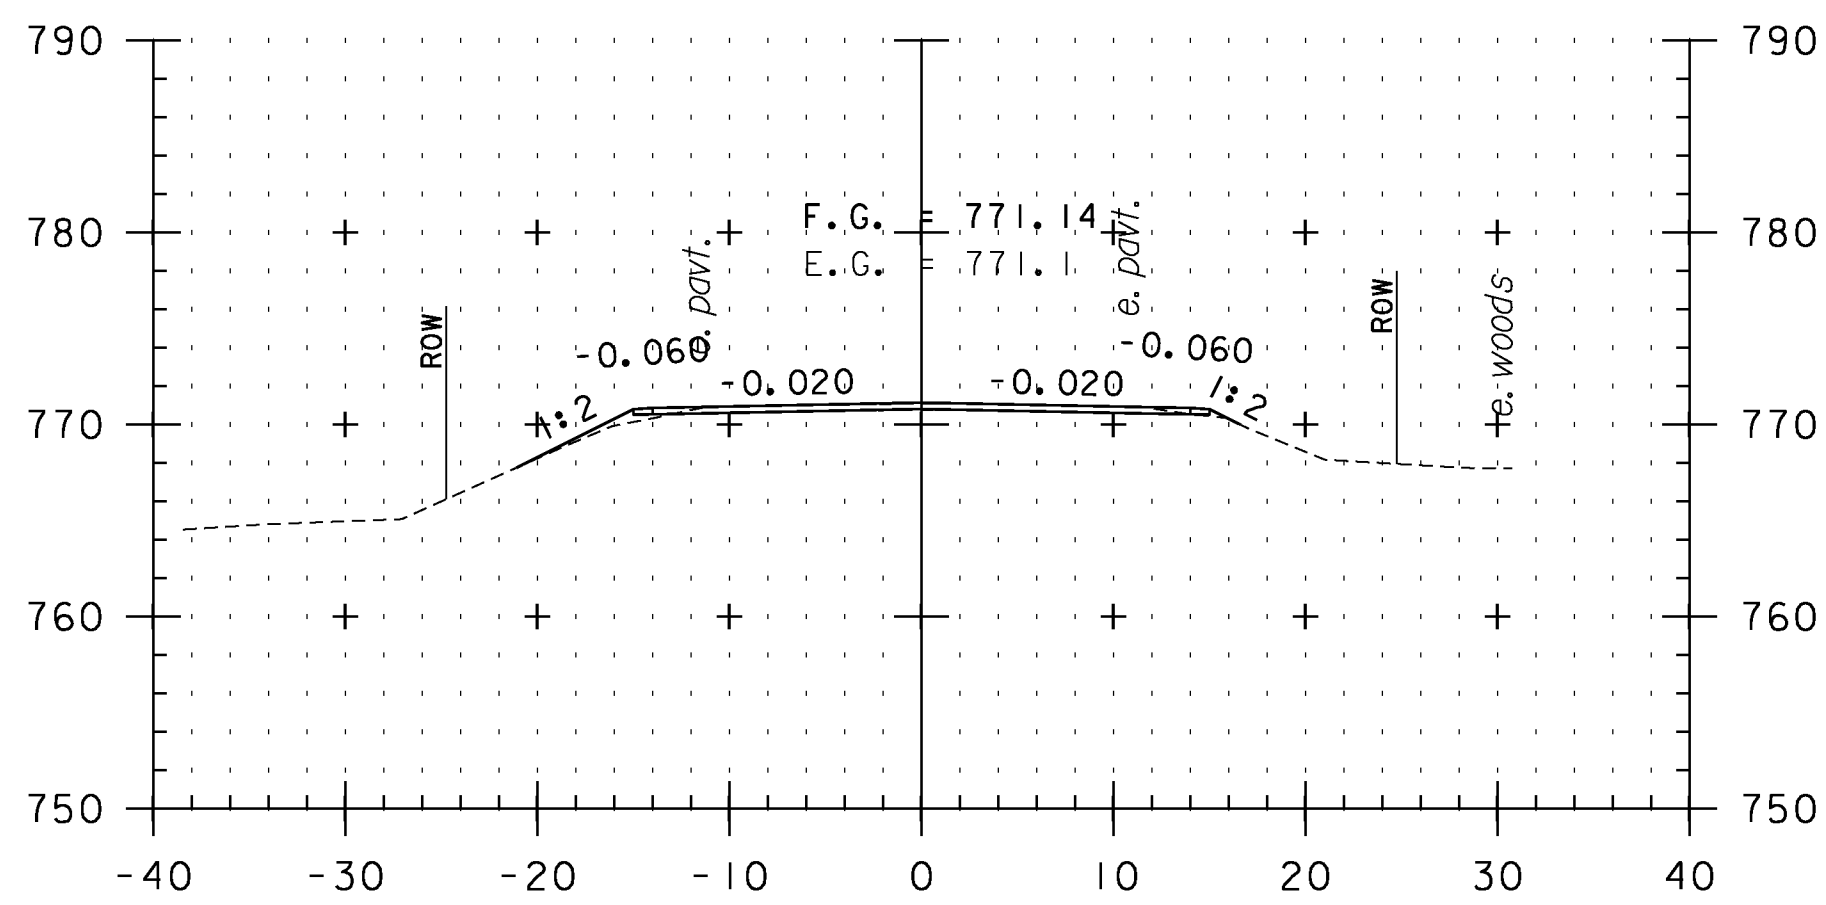


F 16+00

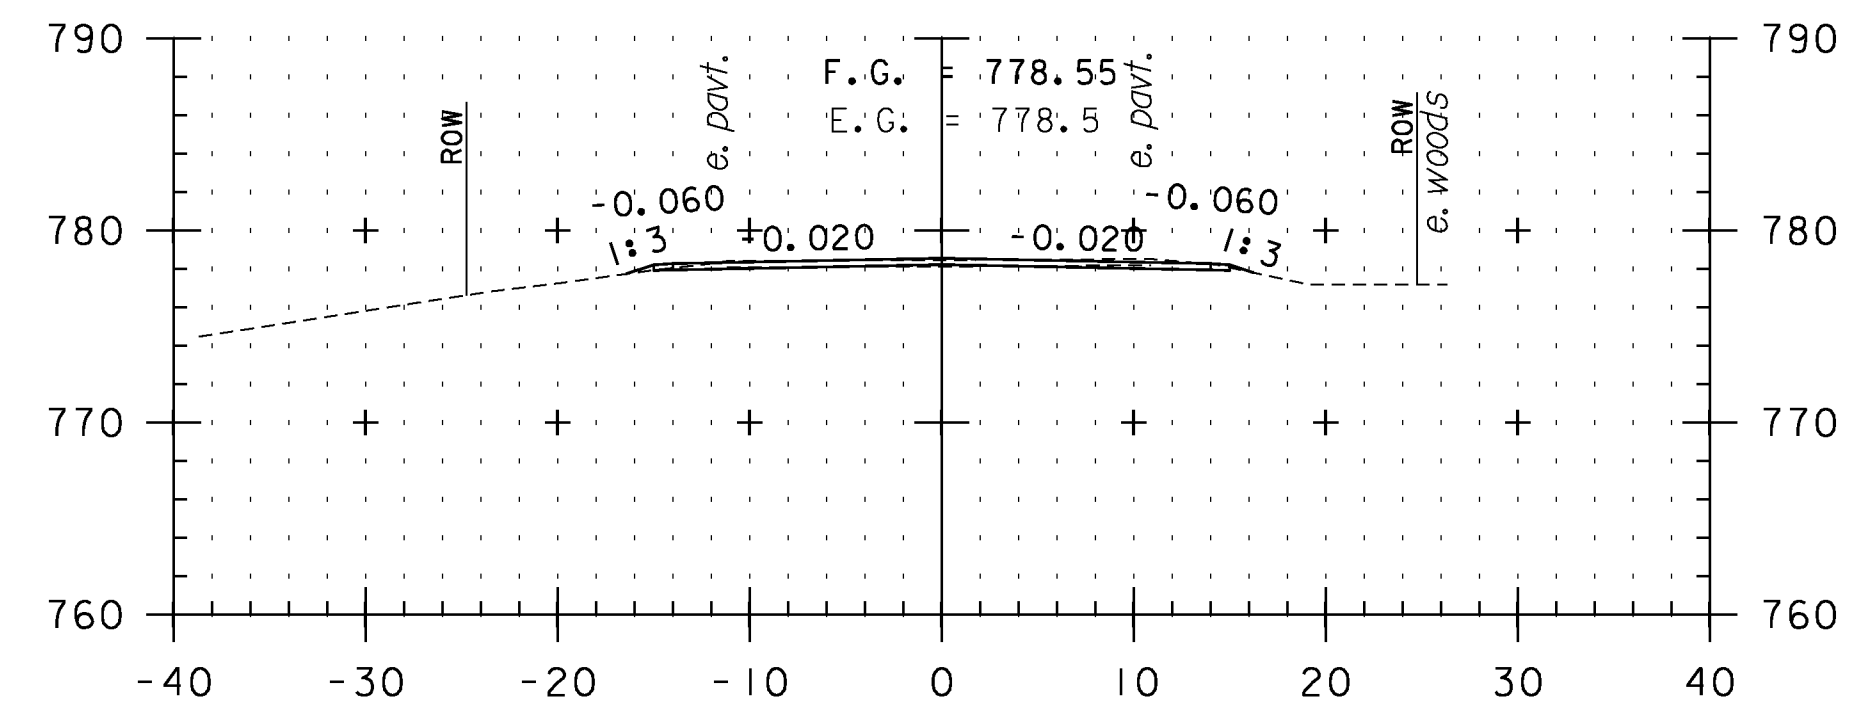

F 17+50

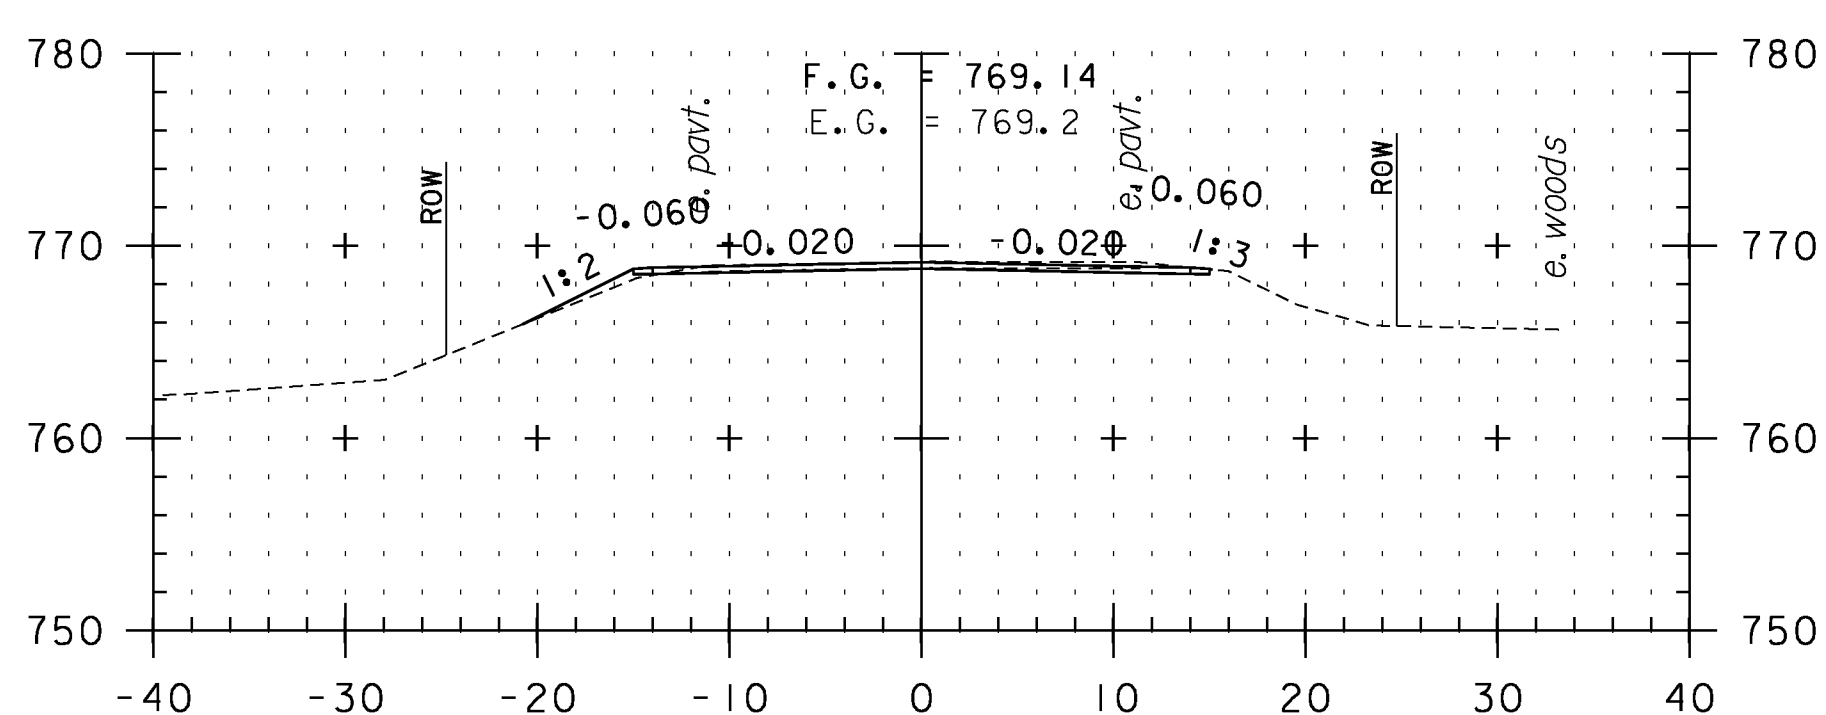


F 15+50

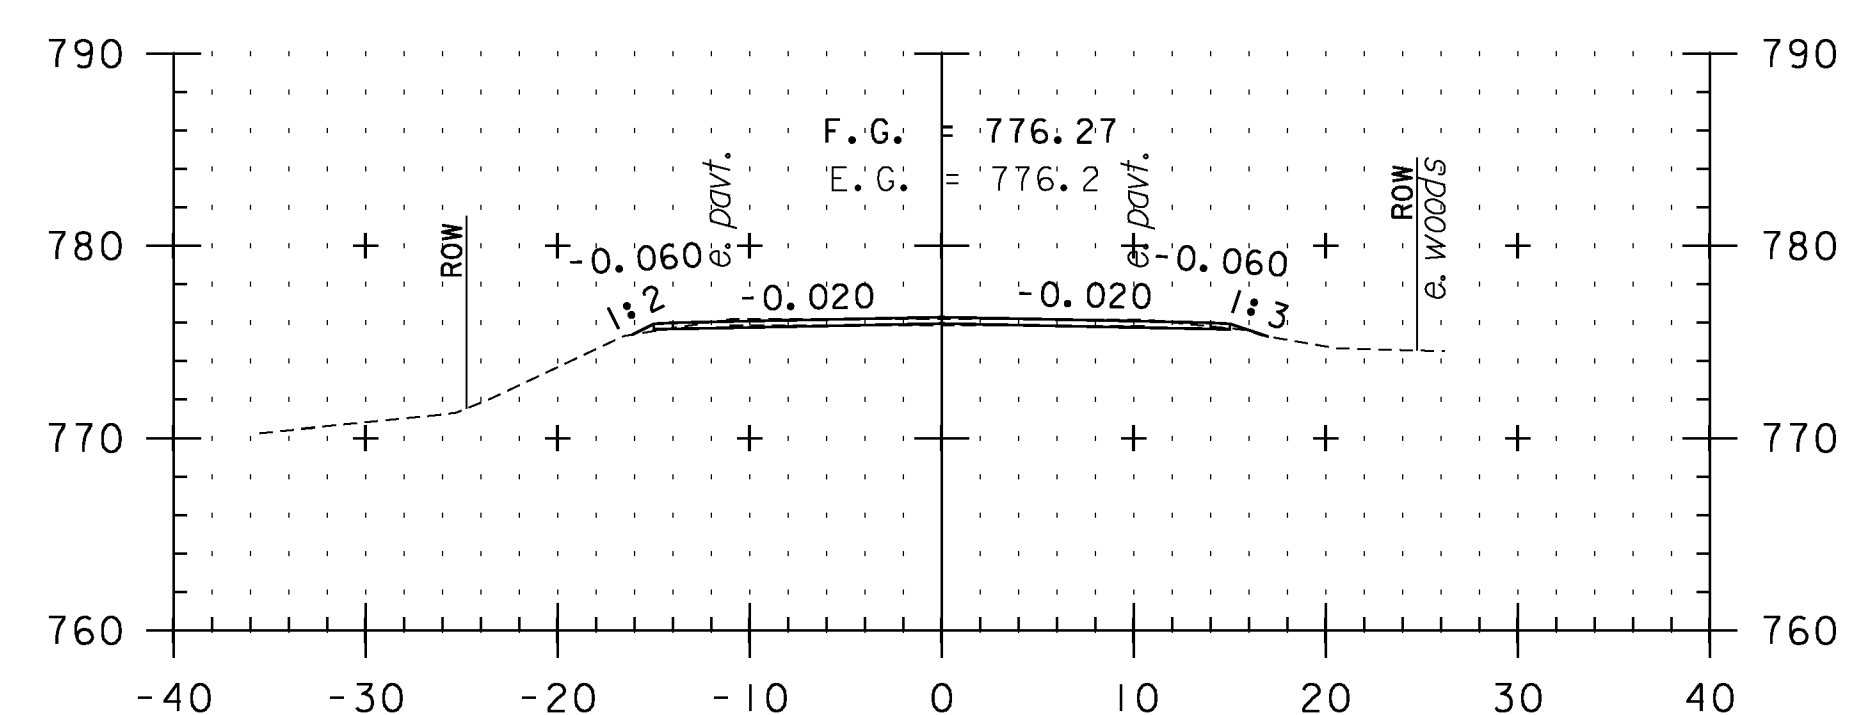

F 17+00

CROSS SECTION SHEET 56

STA. F14+00 TO STA. F17+50

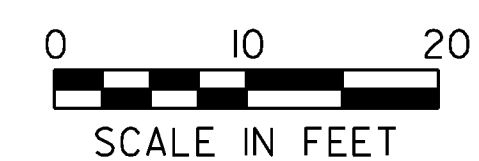

PROJECT NAME: VERSHIRE-THETFORD	PLOT DATE: 1/29/2013
PROJECT NUMBER: STP 2911(I)	DRAWN BY: SNG
FILE NAME: pl0c224.dgn	CHECKED BY: PTS
PROJECT LEADER: PTS	SHEET 164 OF 232
DESIGNED BY: NLL	
IPARM FILE NAME: IOC224_164	