




F19+00

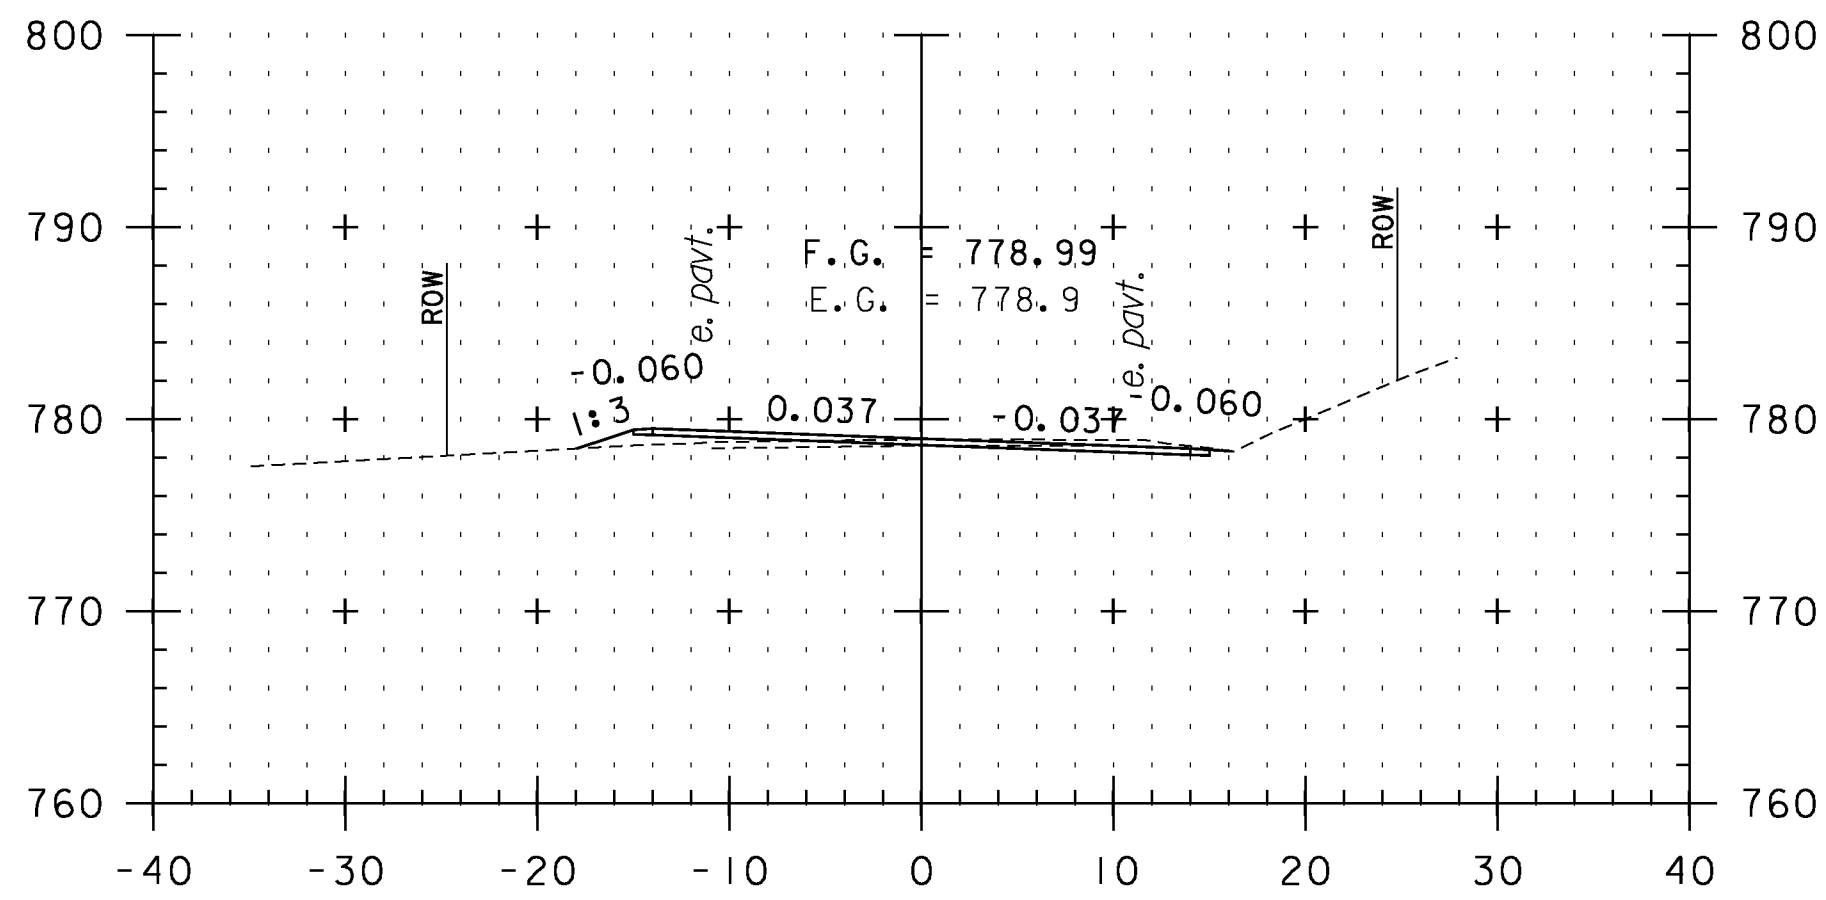


F20+50

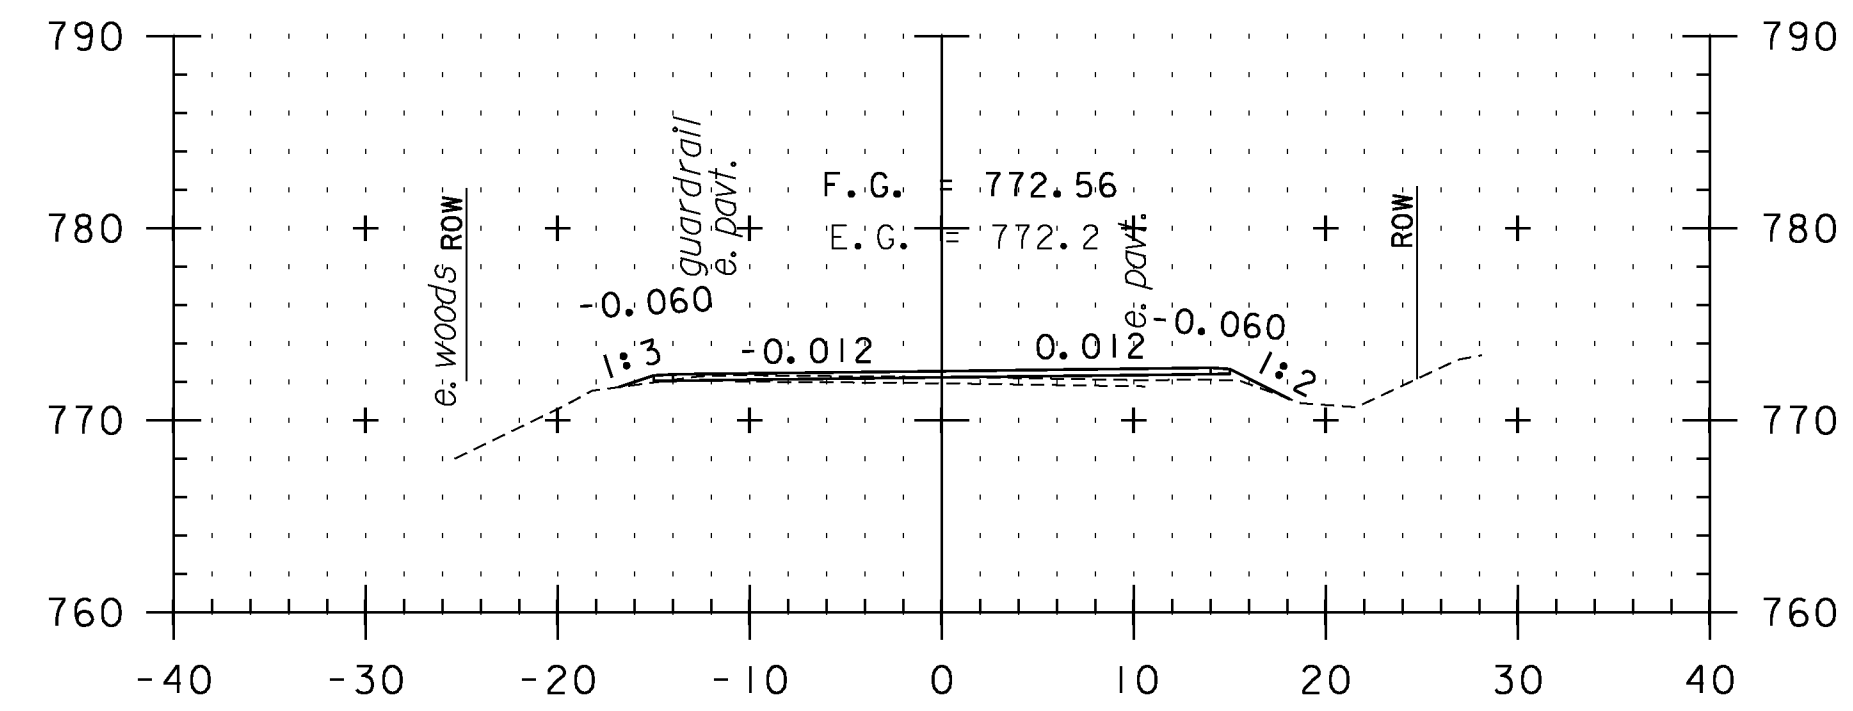


F22+00

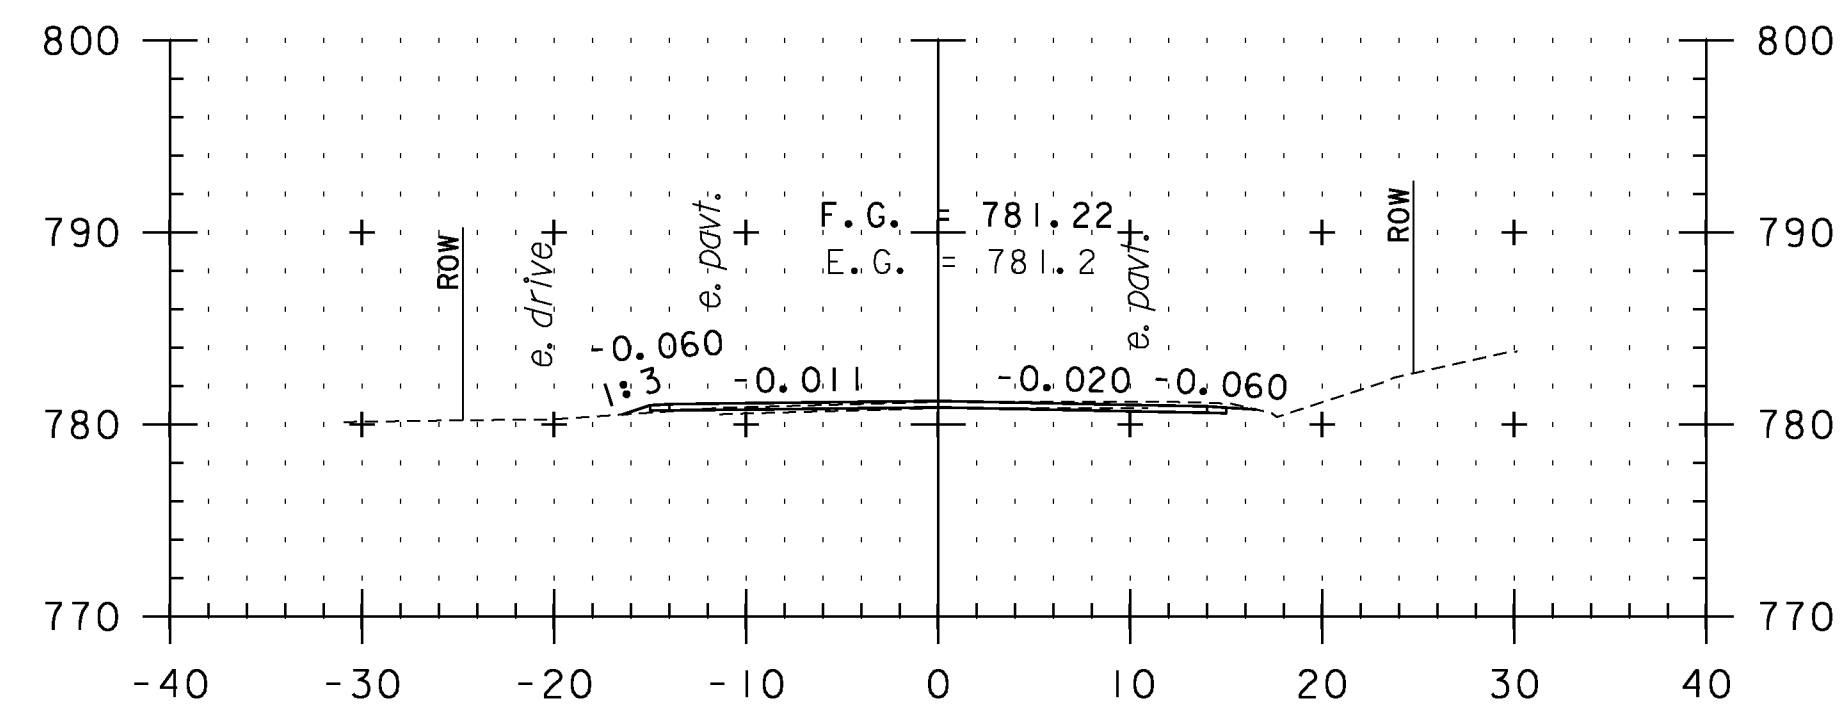


F18+50

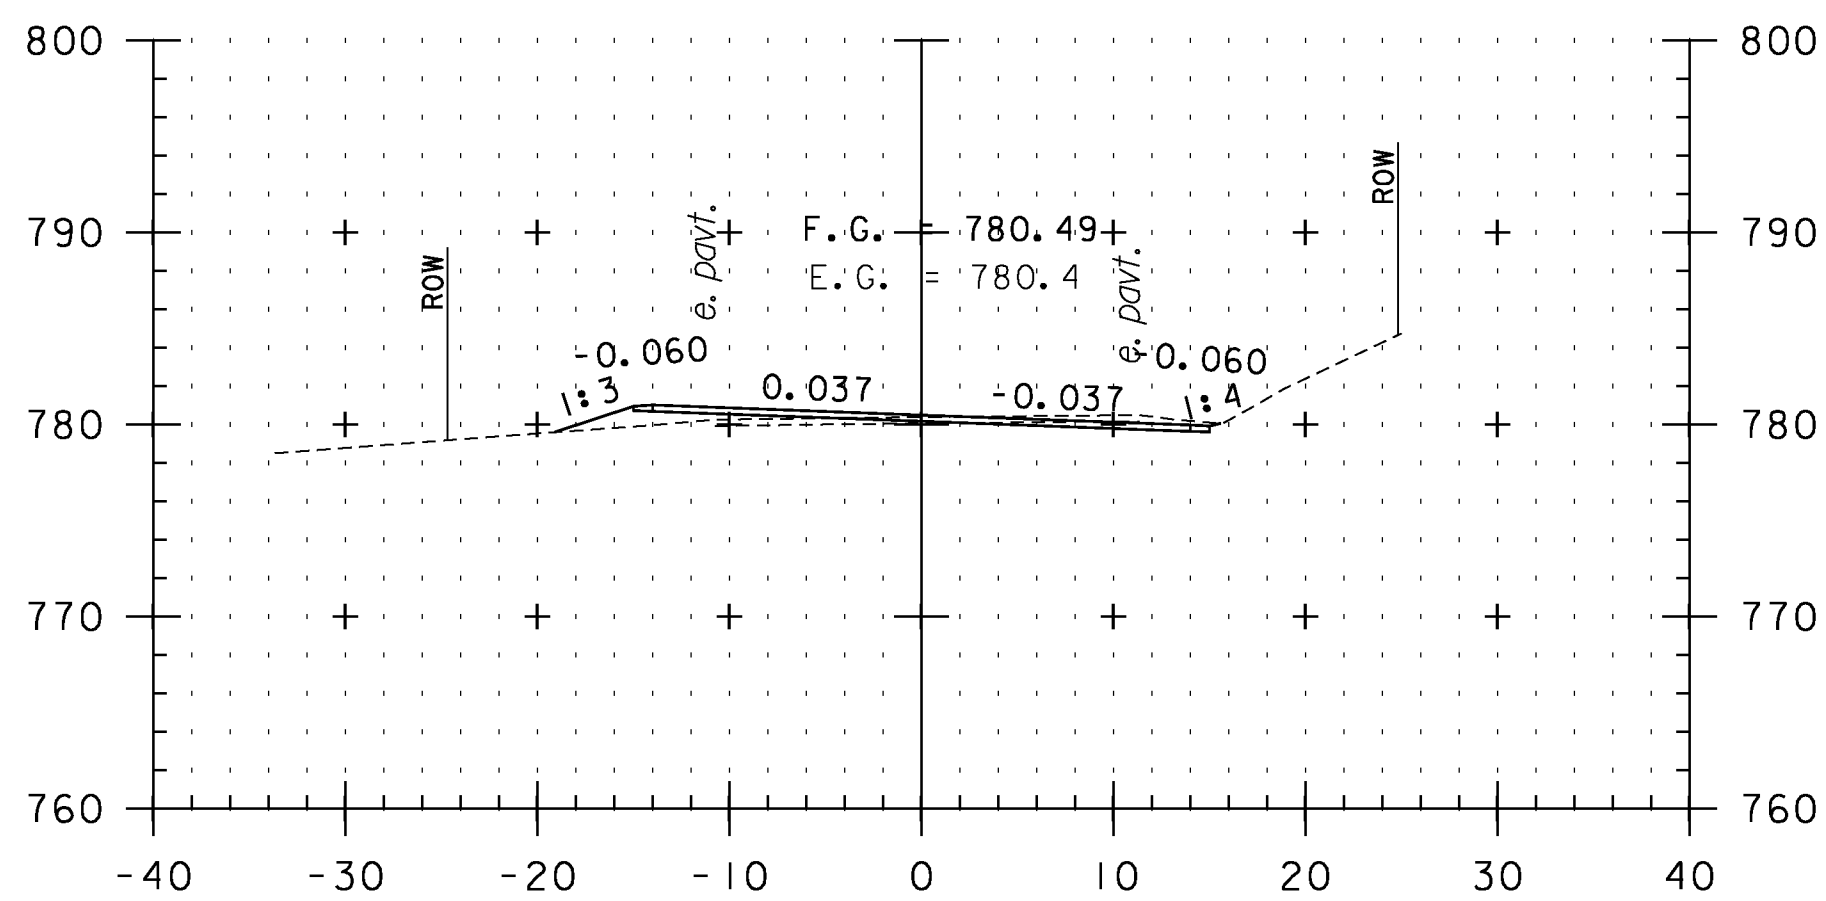


F20+00

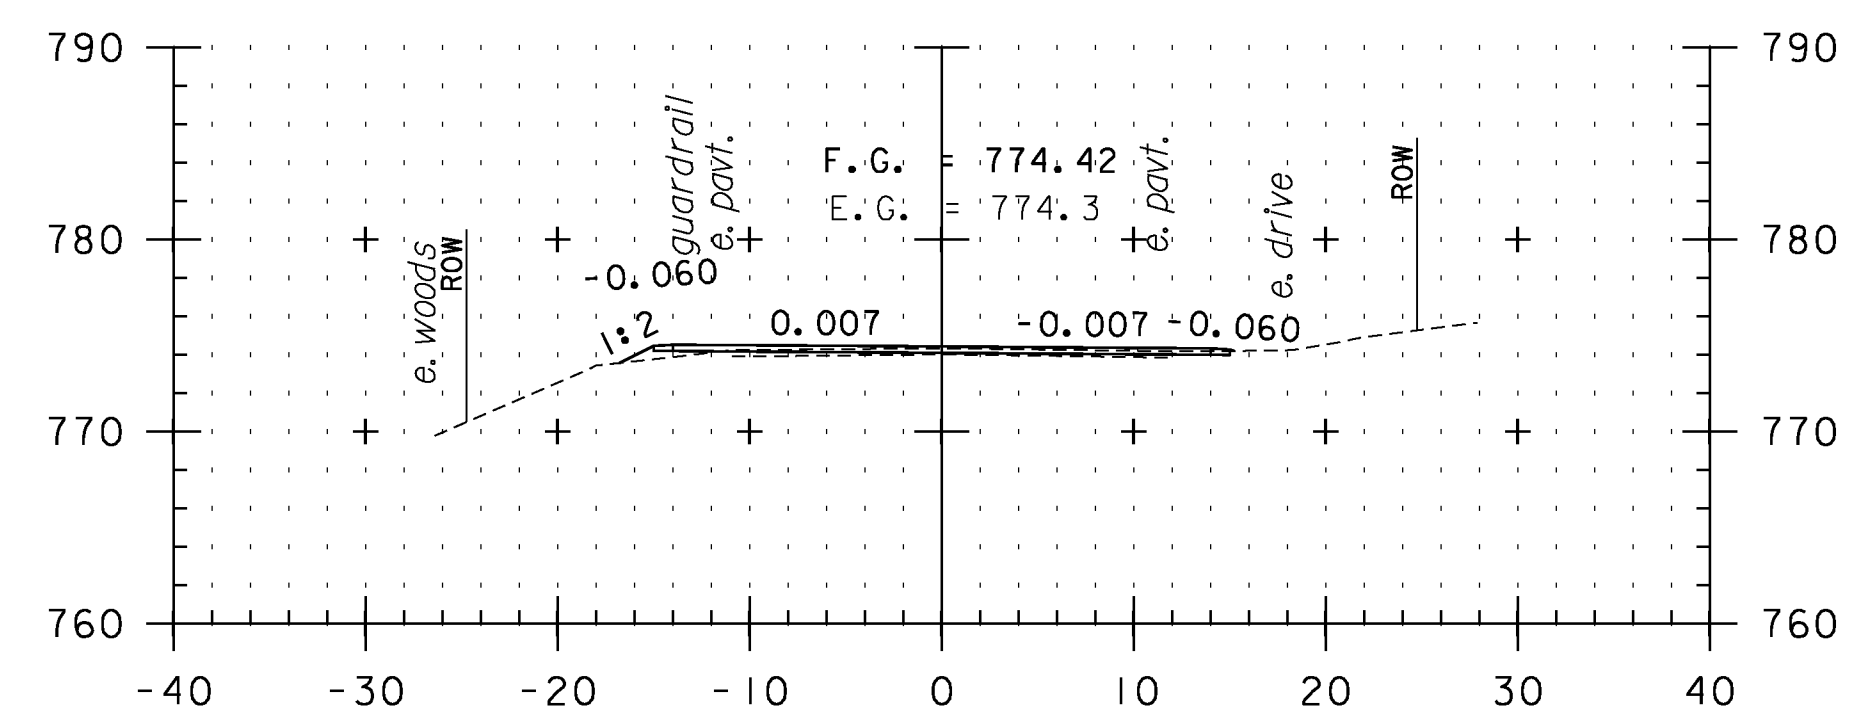


F21+50

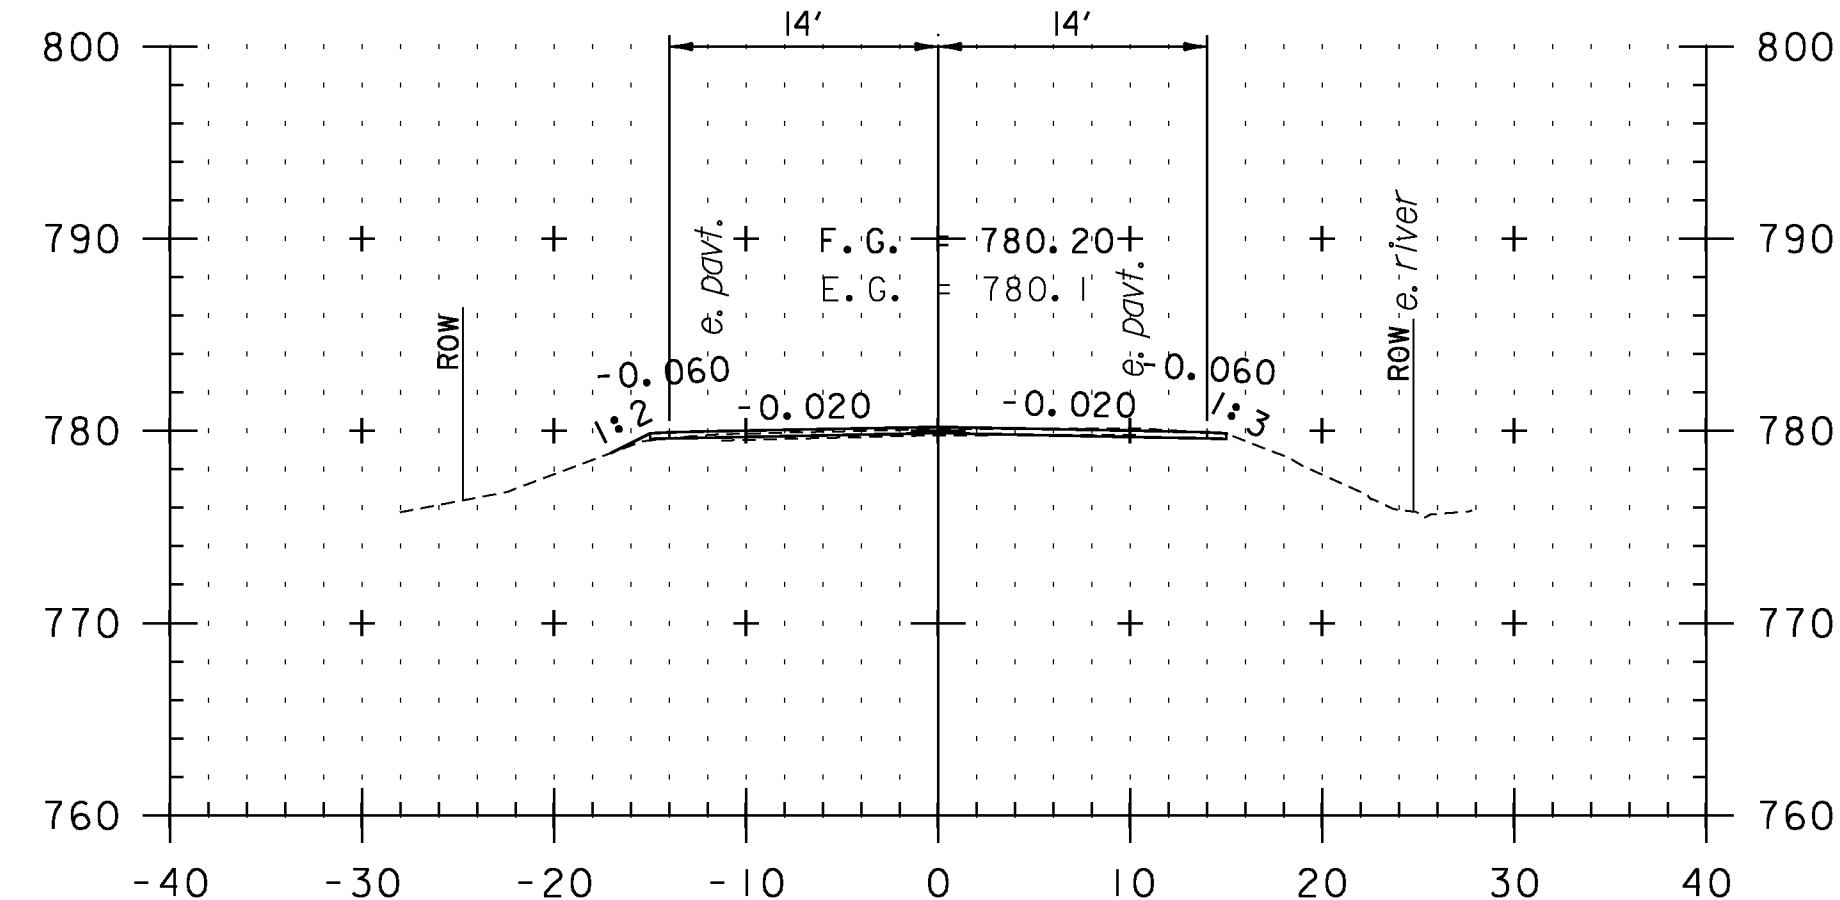

F18+00

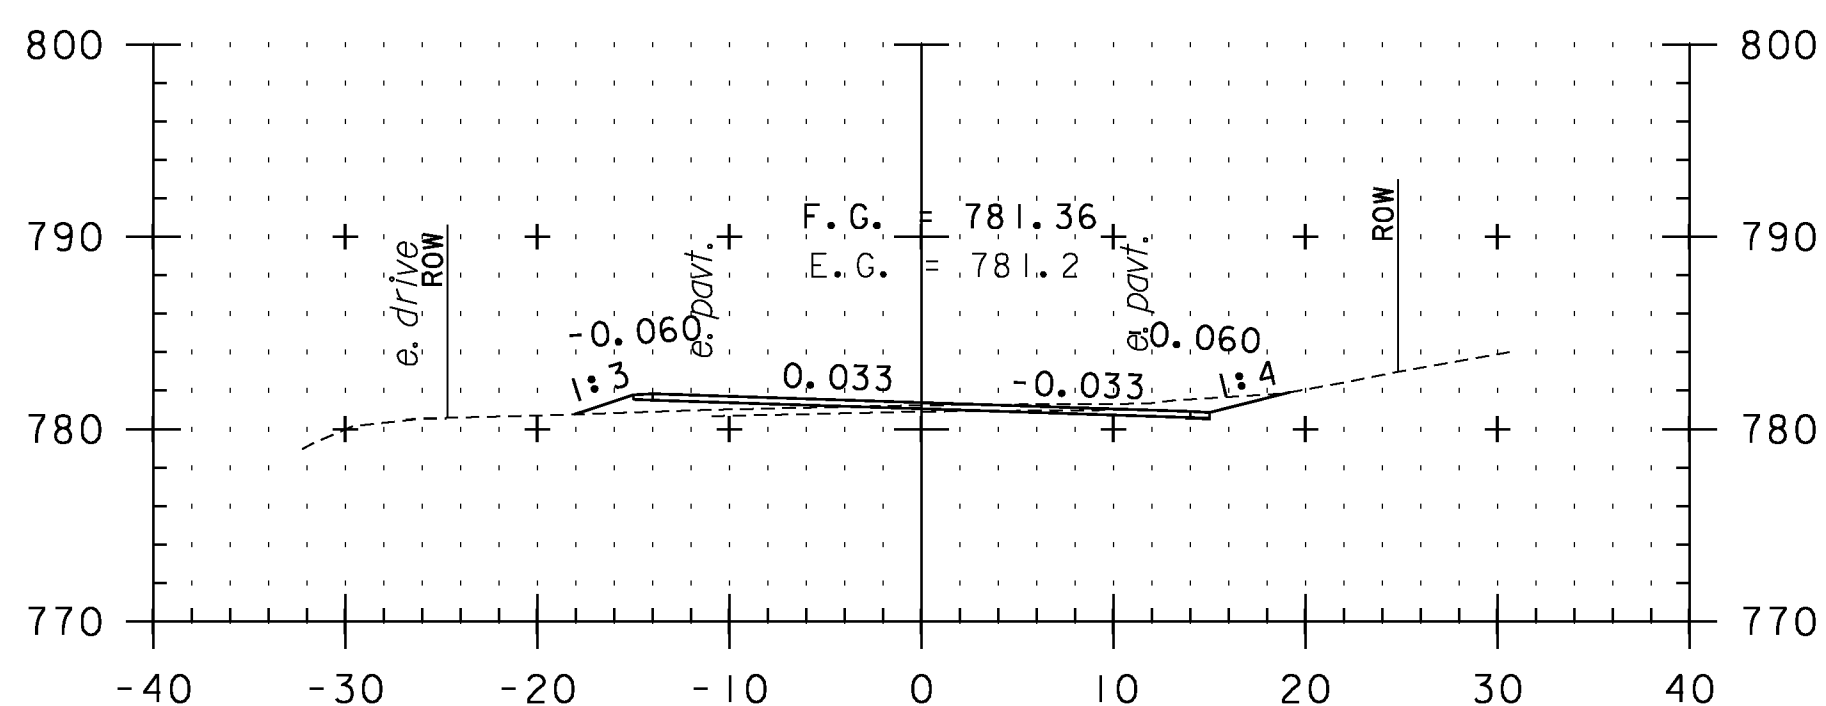

F19+50

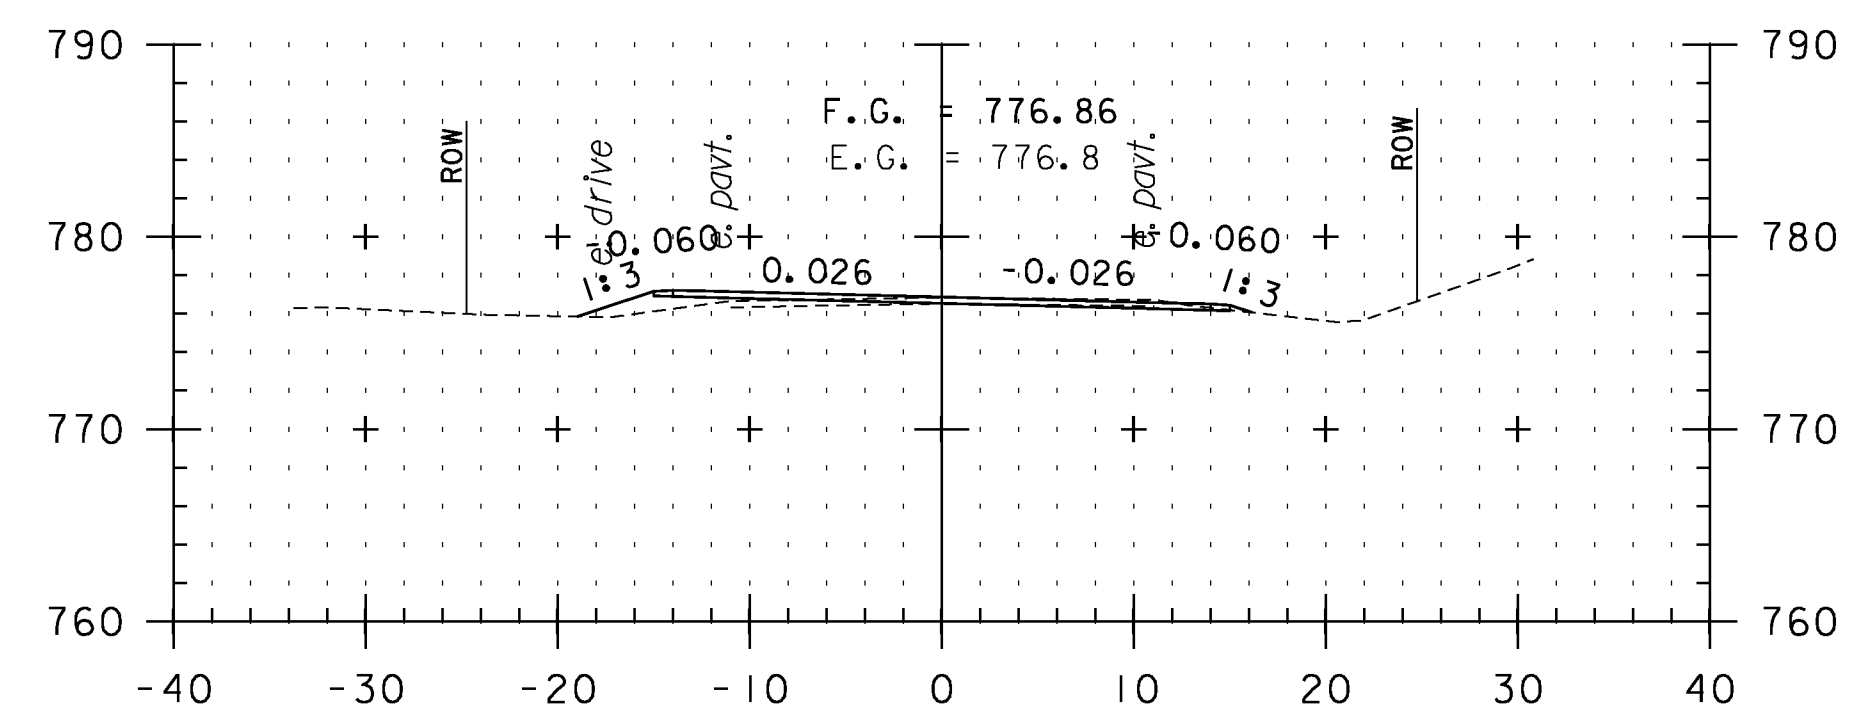

F21+00

CROSS SECTION SHEET 57

STA. F18+00 TO STA. F22+00



PROJECT NAME: VERSHIRE-THETFORD	PLOT DATE: 1/29/2013
PROJECT NUMBER: STP 2911(I)	DRAWN BY: SNG
FILE NAME: pl0c224.dgn	CHECKED BY: PTS
PROJECT LEADER: PTS	SHEET 165 OF 232
DESIGNED BY: NULL	
IPARM FILE NAME: IOC224_165	