




F23+50

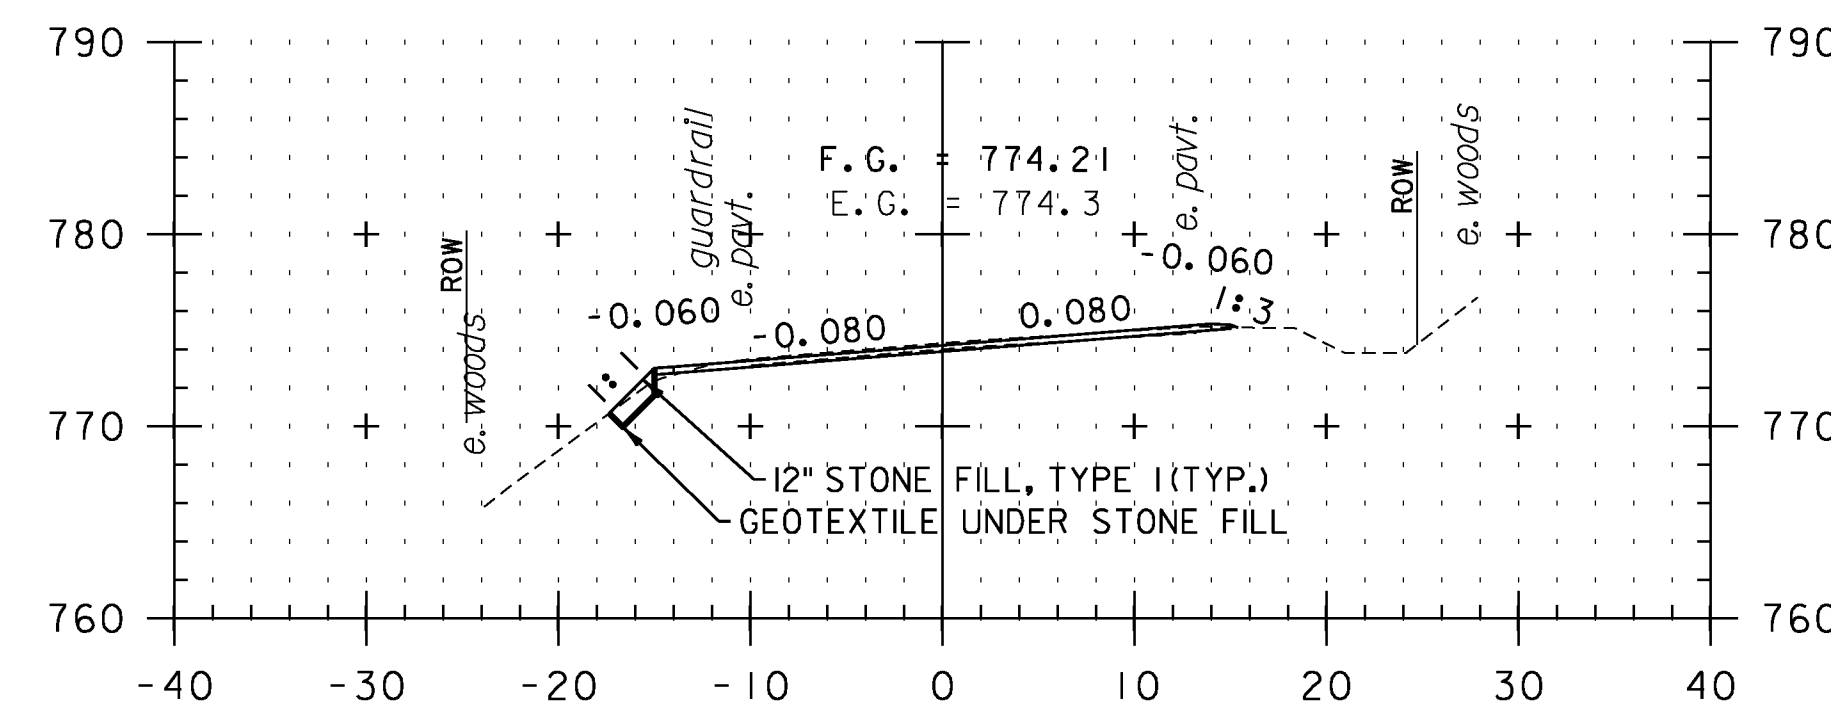


F25+00

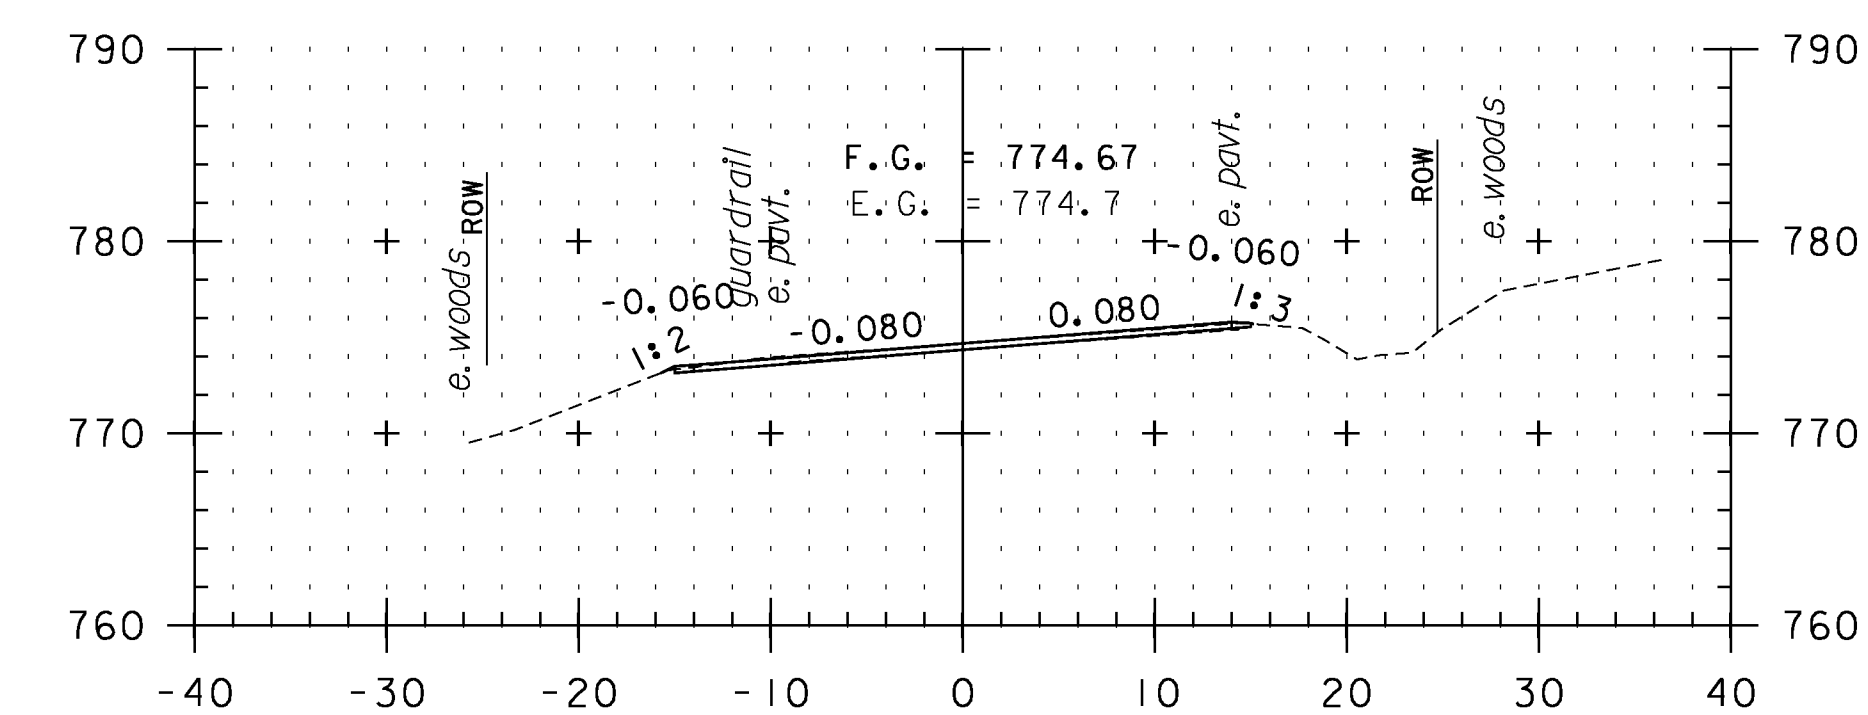


F26+50

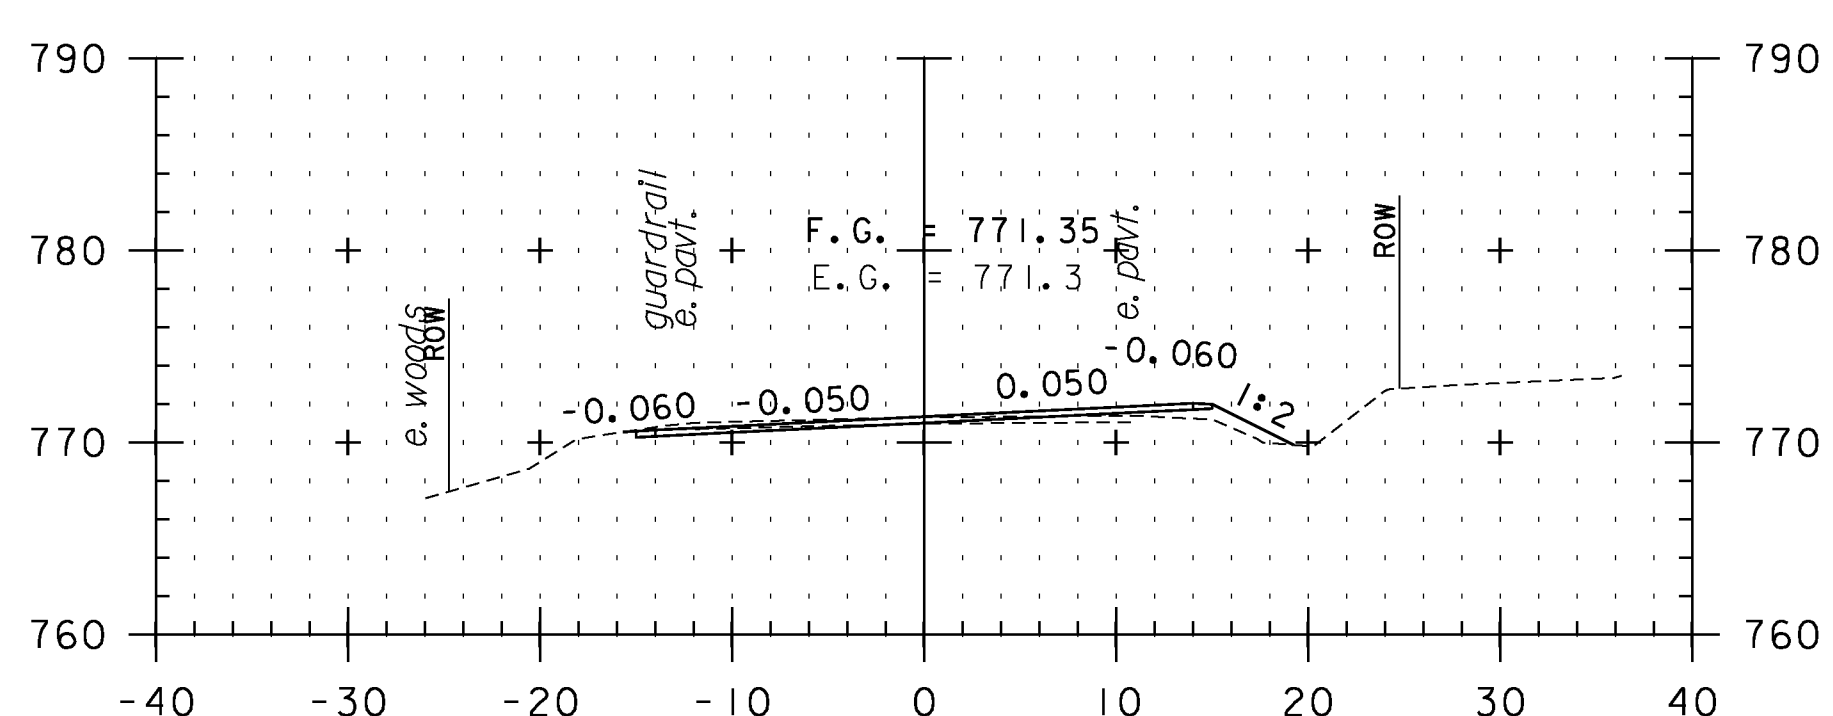


F23+00

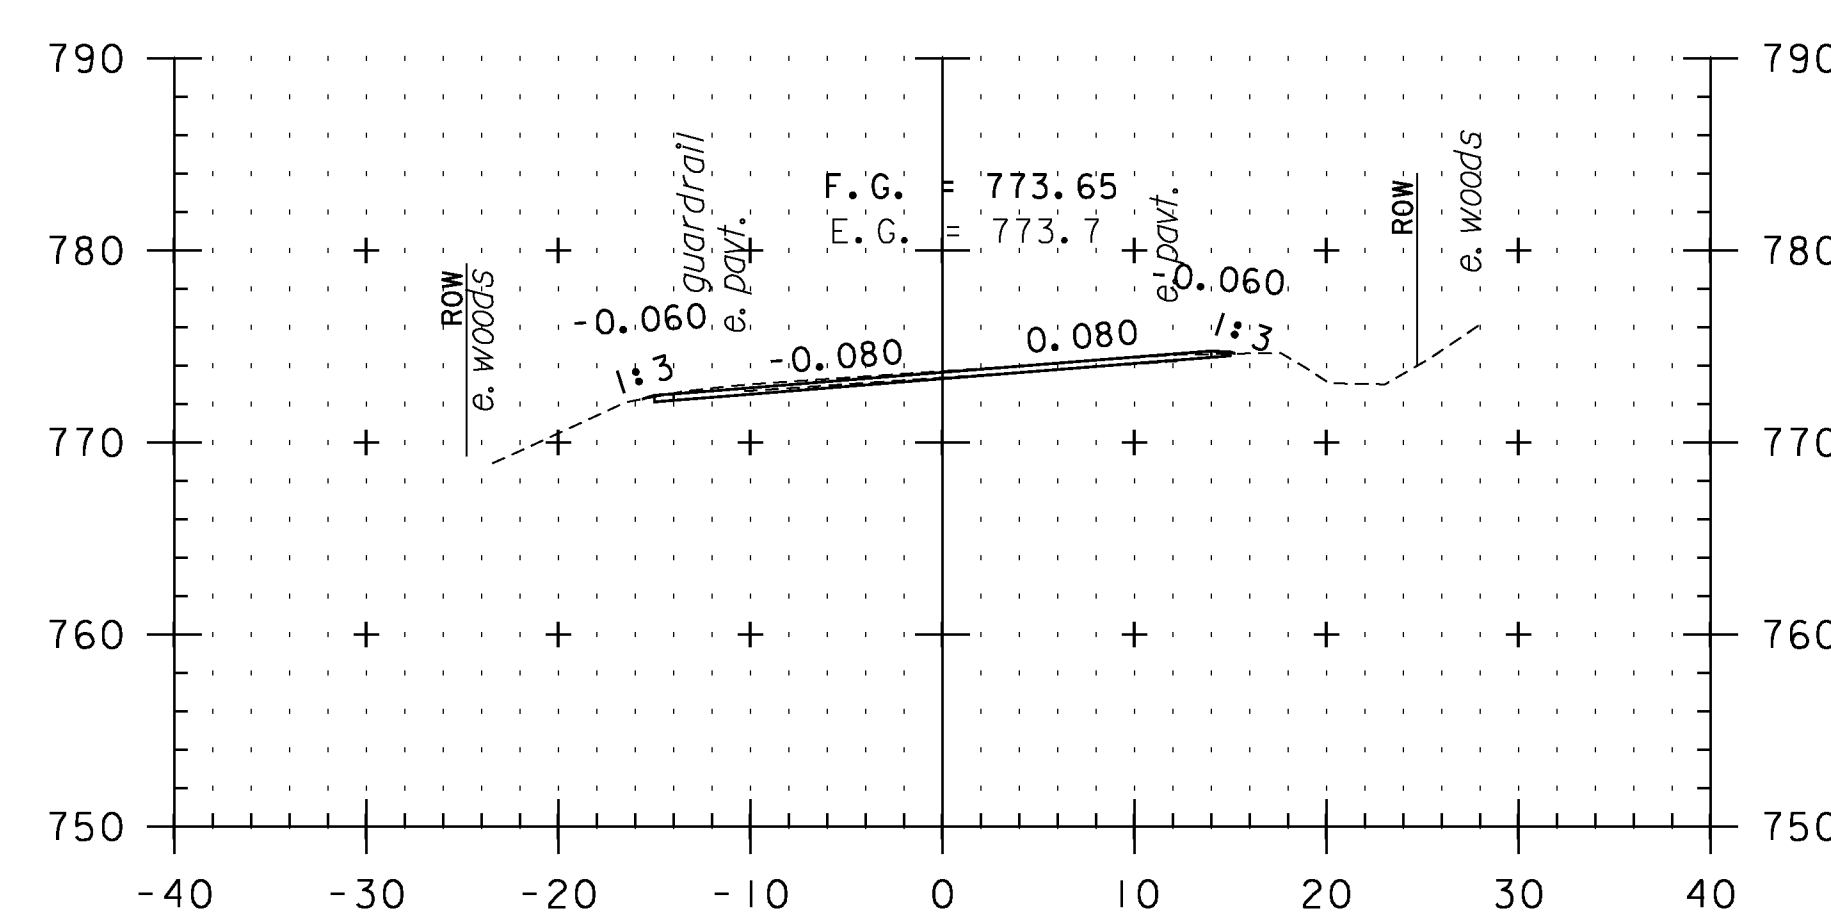


F24+50

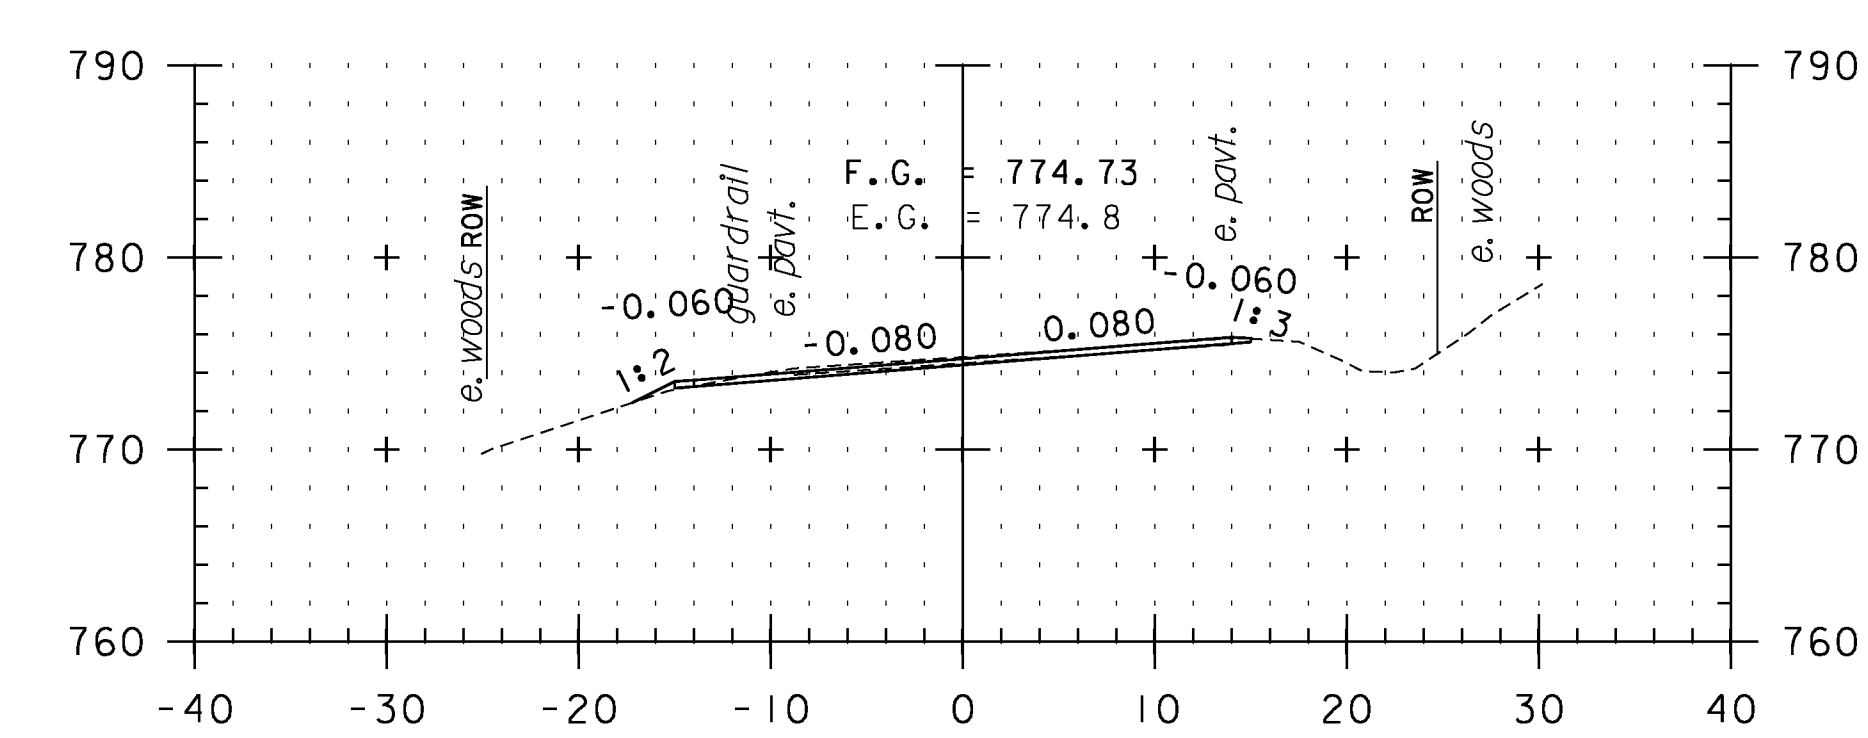


F26+00

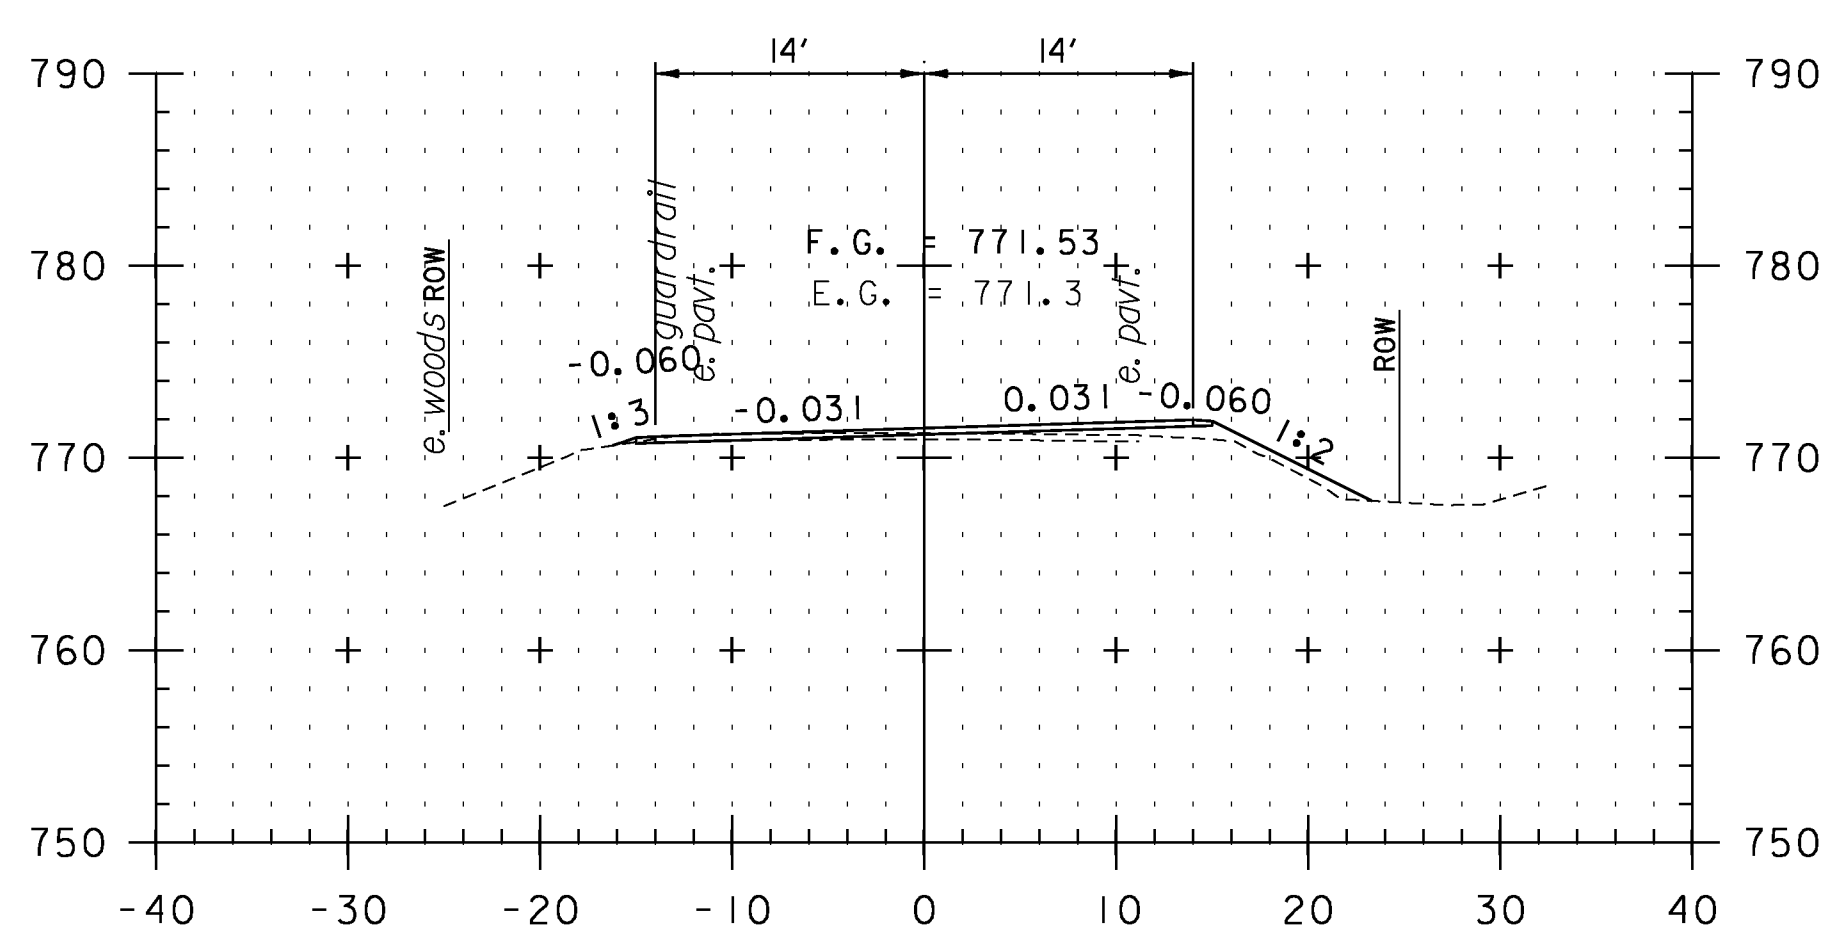

F22+50

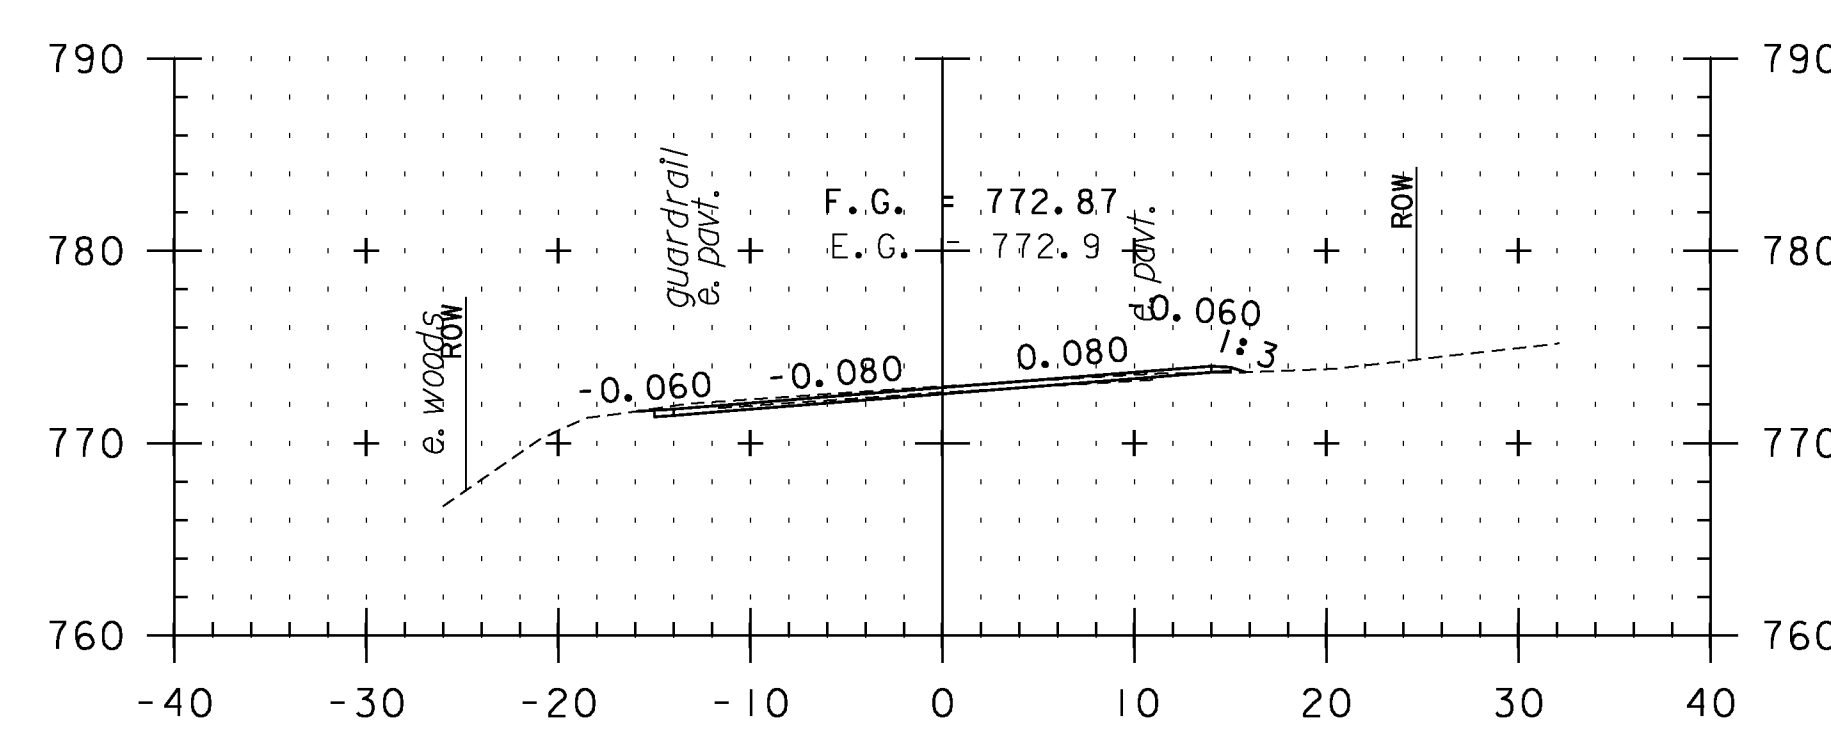


F24+00

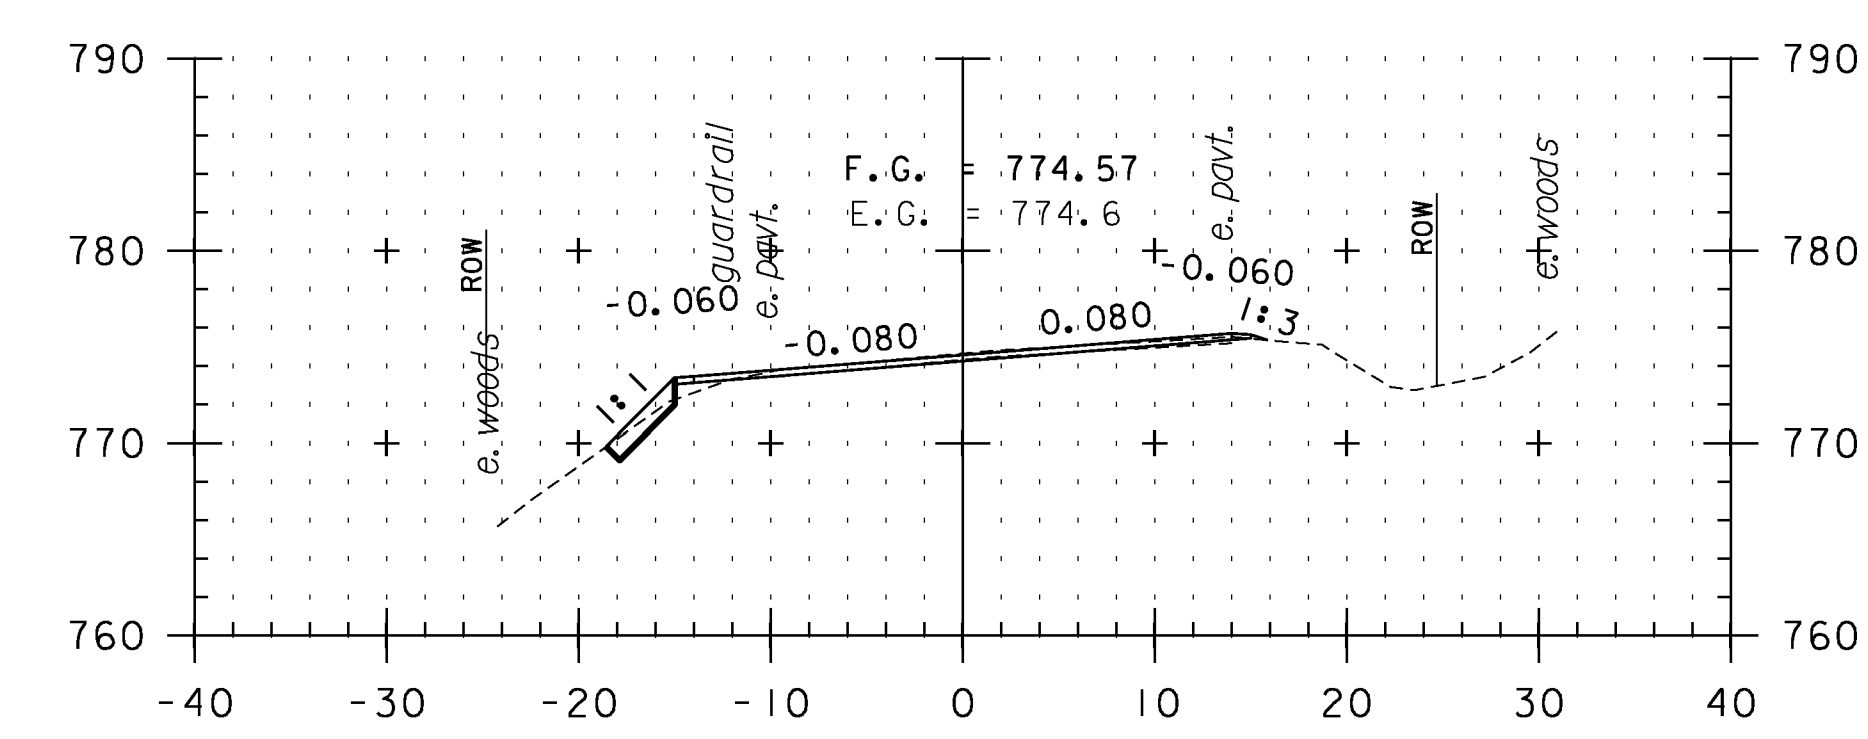

F25+50

CROSS SECTION SHEET 58

STA. F22+50 TO STA. F26+50

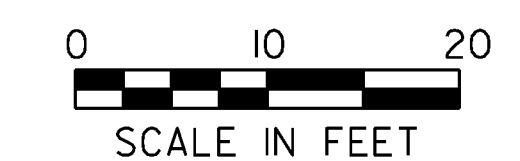

PROJECT NAME: VERSHIRE-THETFORD	PLOT DATE: 1/29/2013
PROJECT NUMBER: STP 2911(I)	DRAWN BY: SNG
FILE NAME: pl0c224.dgn	CHECKED BY: PTS
PROJECT LEADER: PTS	SHEET 166 OF 232
DESIGNED BY: NULL	
IPARM FILE NAME: IOC224_166	