




F28+00

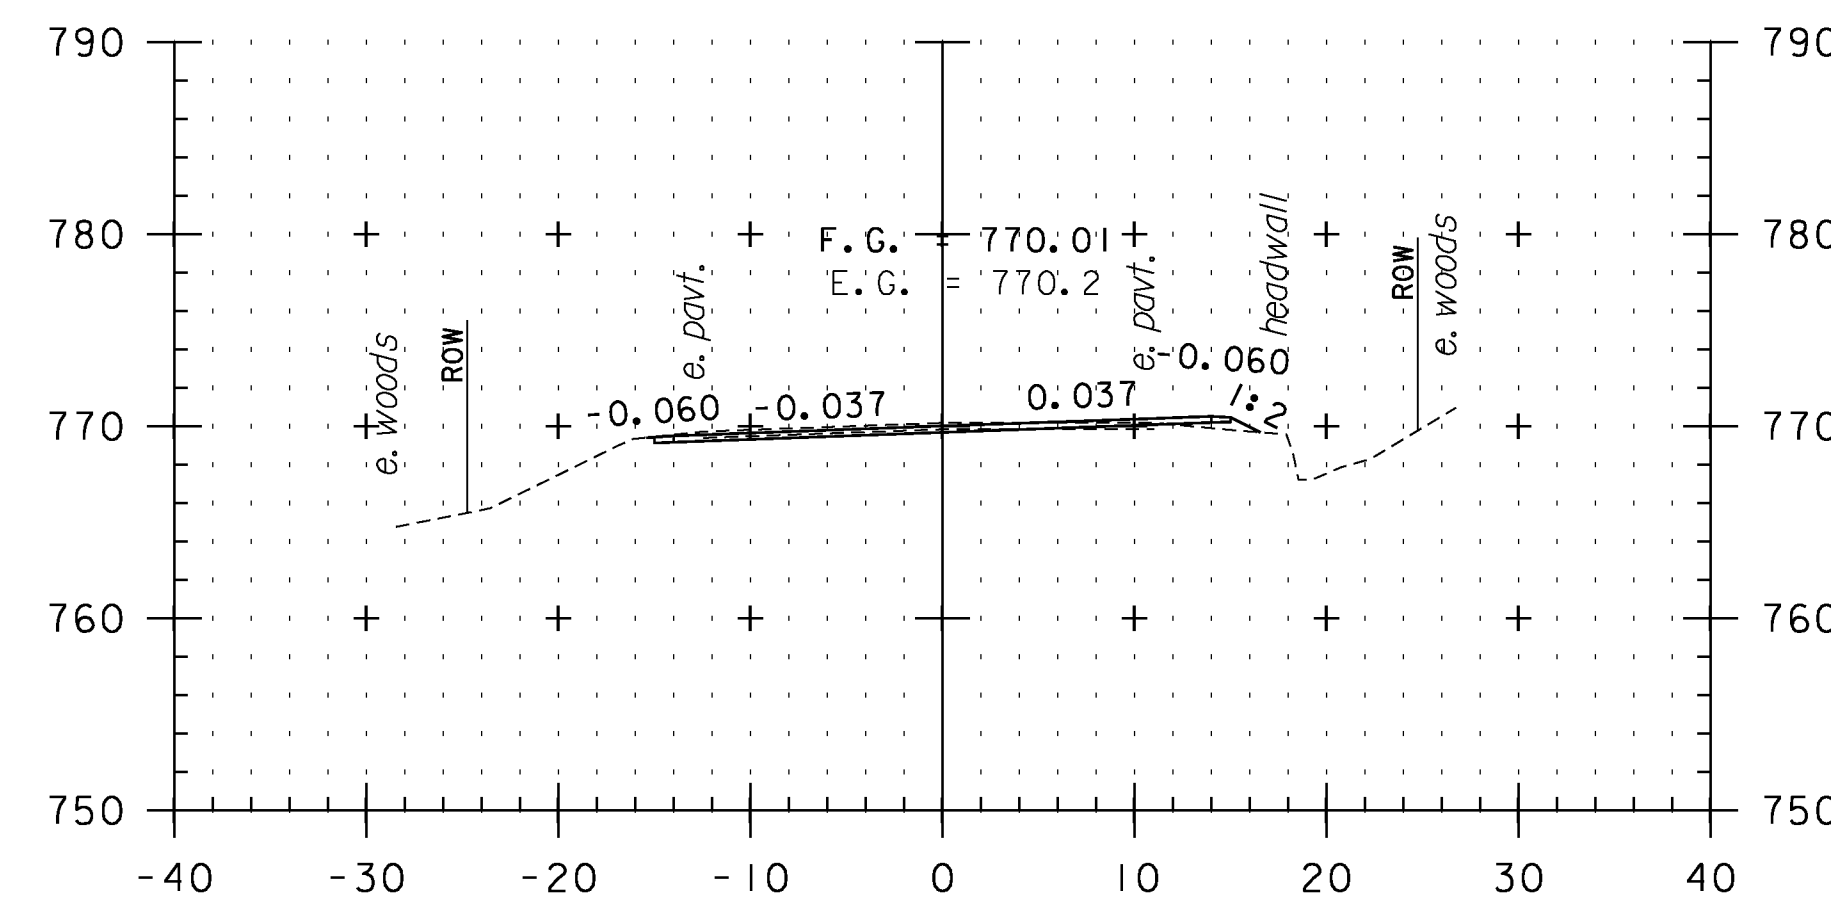


F29+50

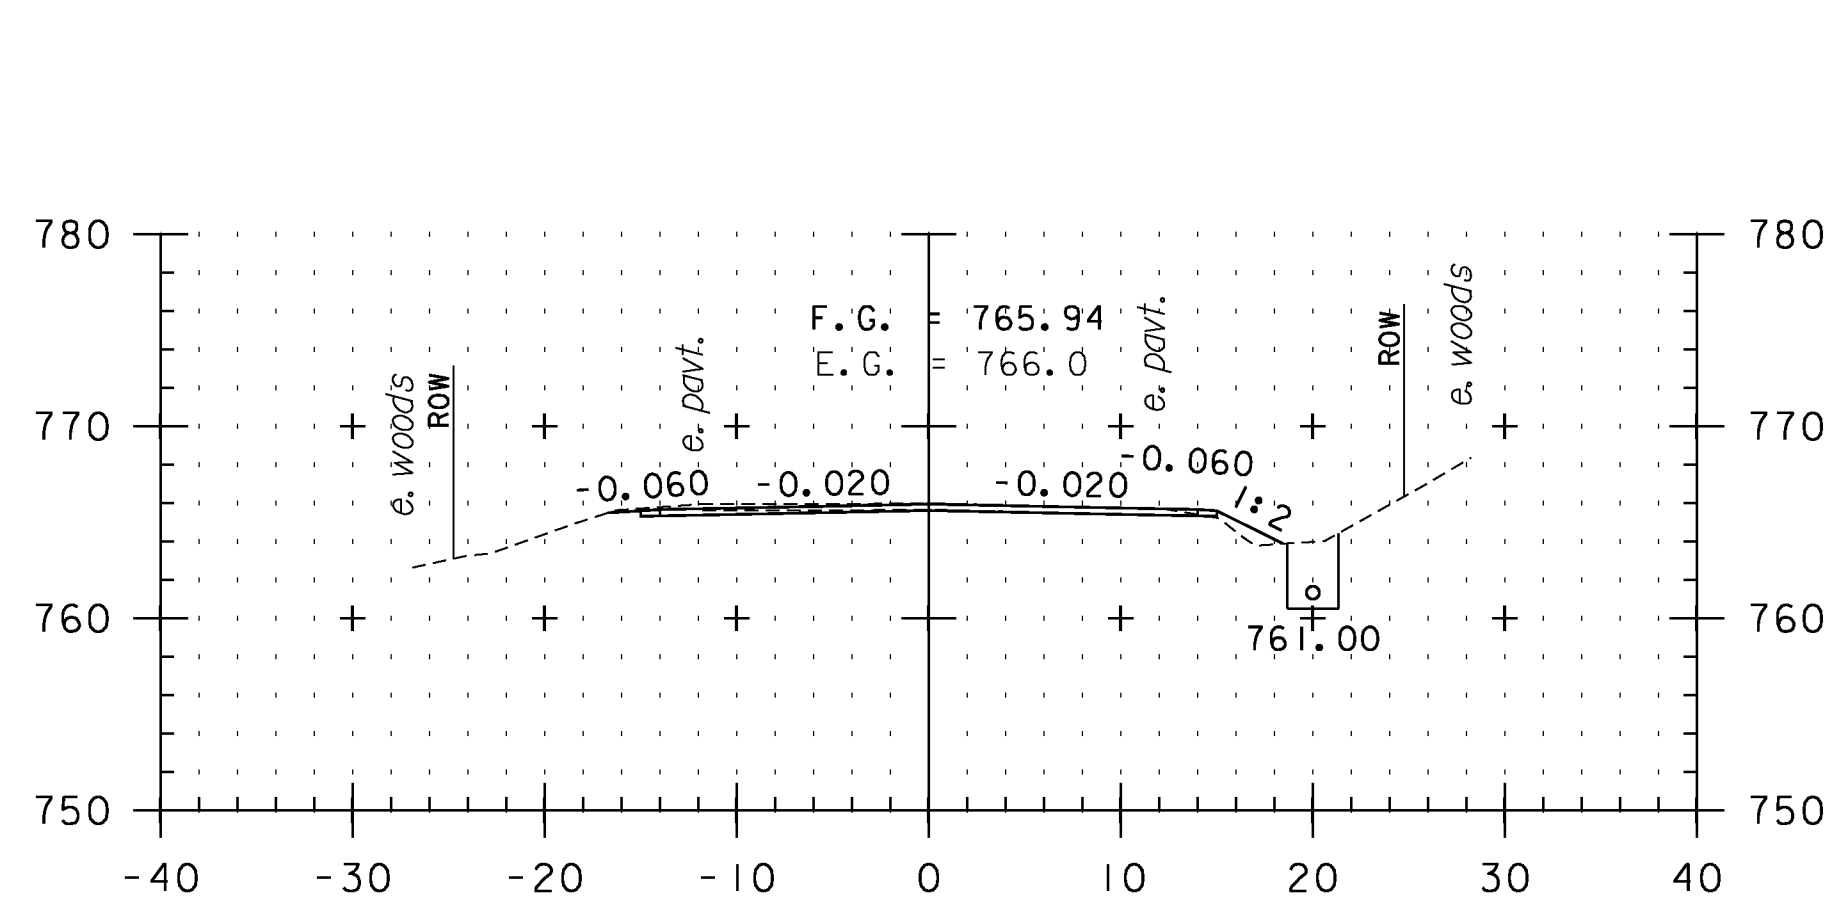


F31+00

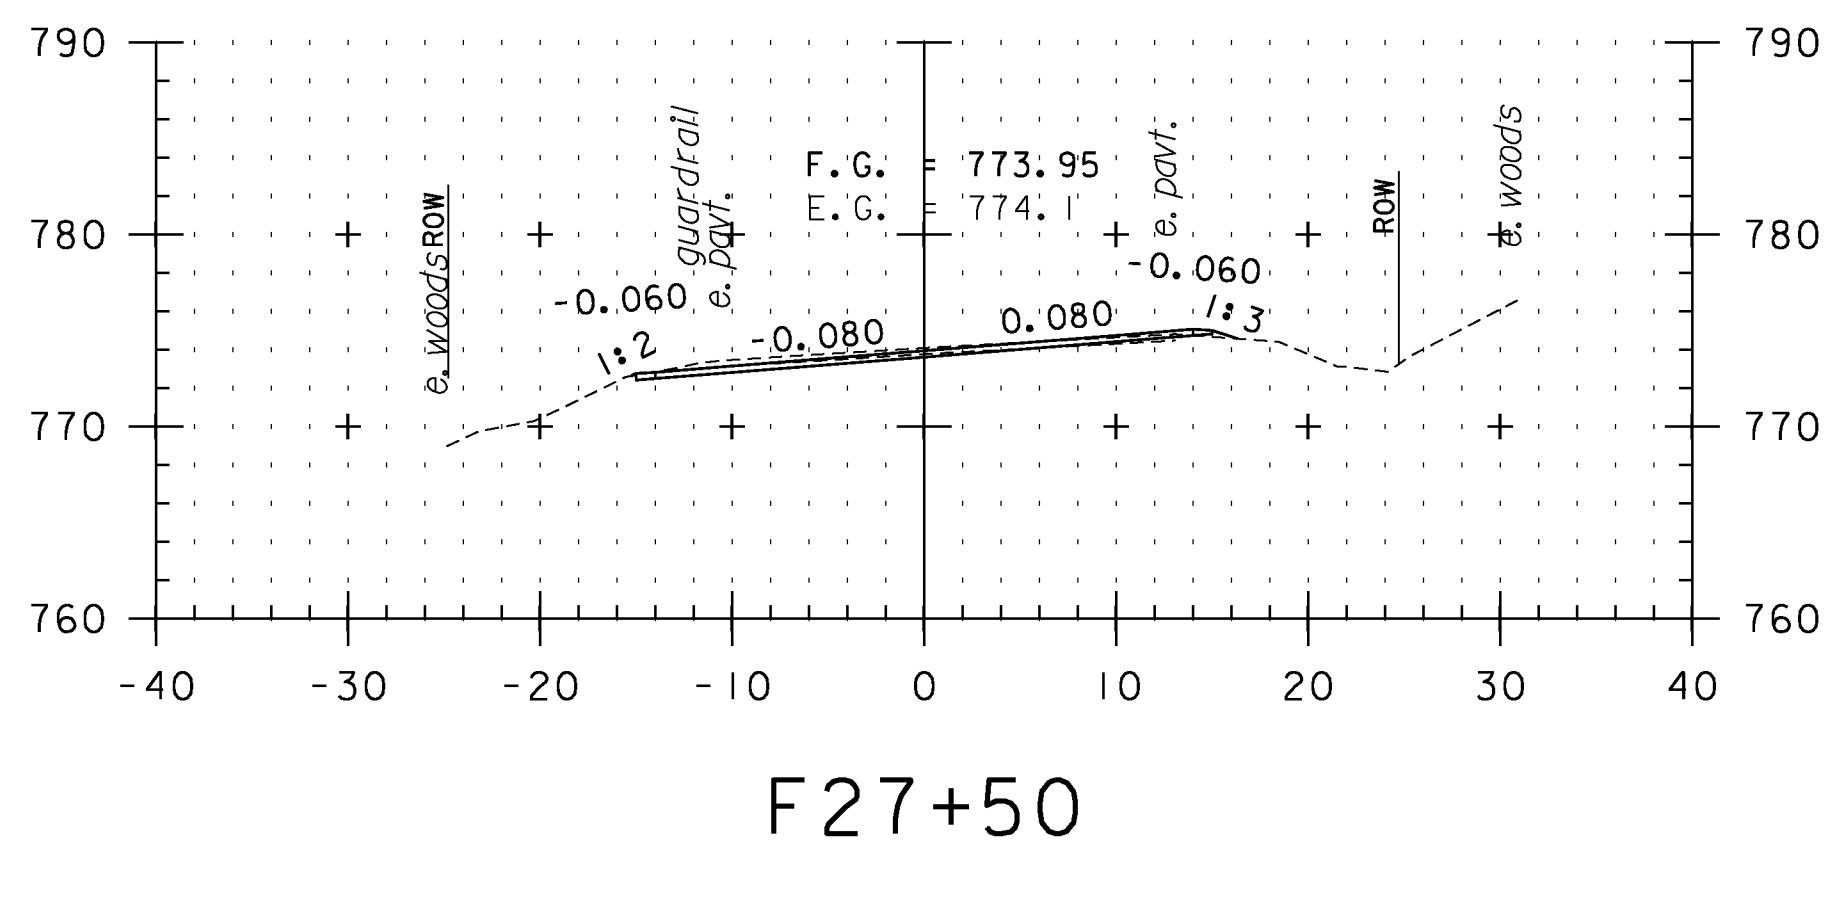


F27+50

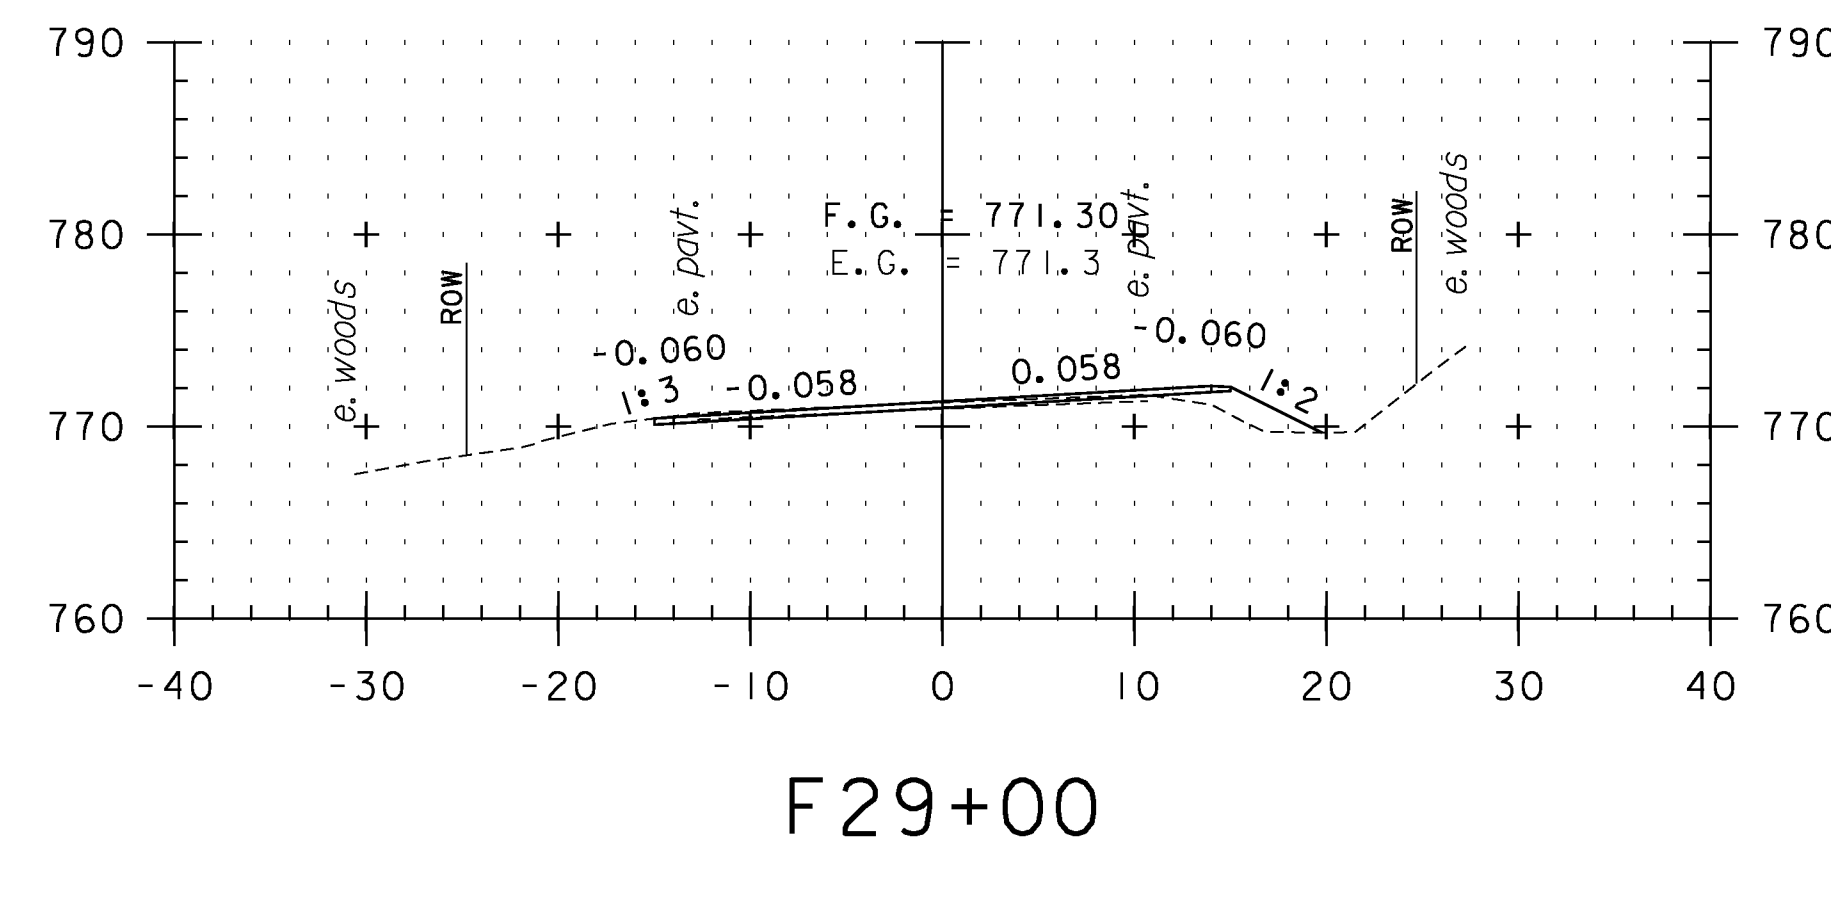


F29+00

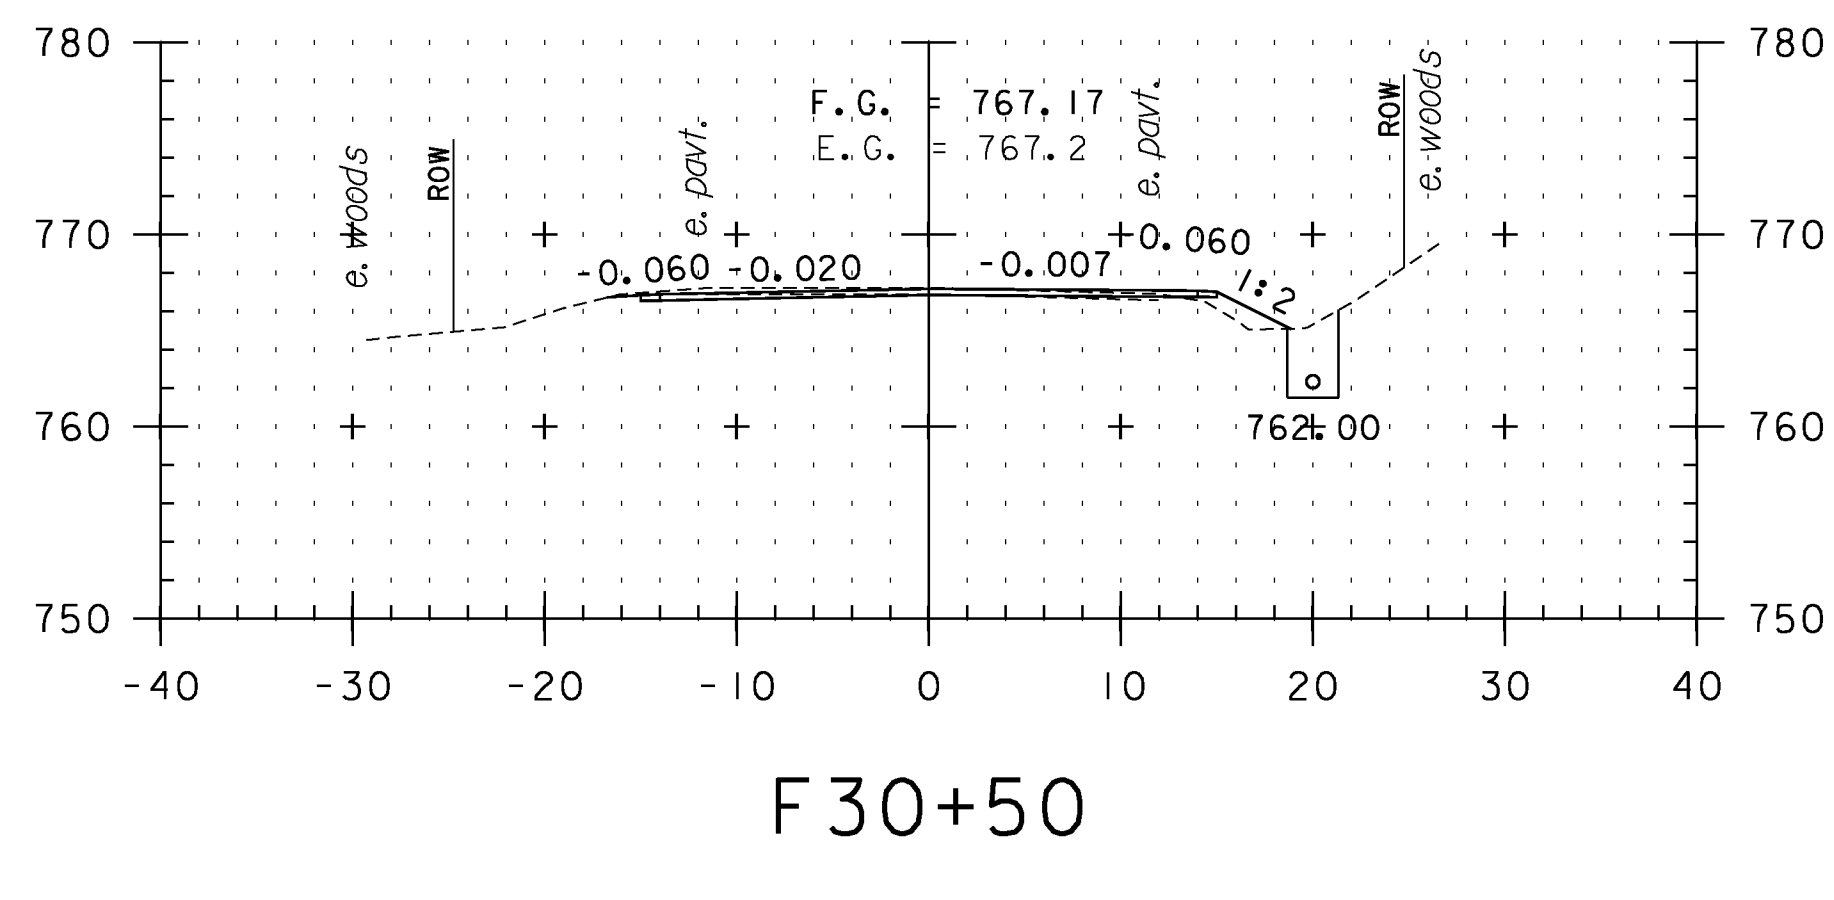


F30+50

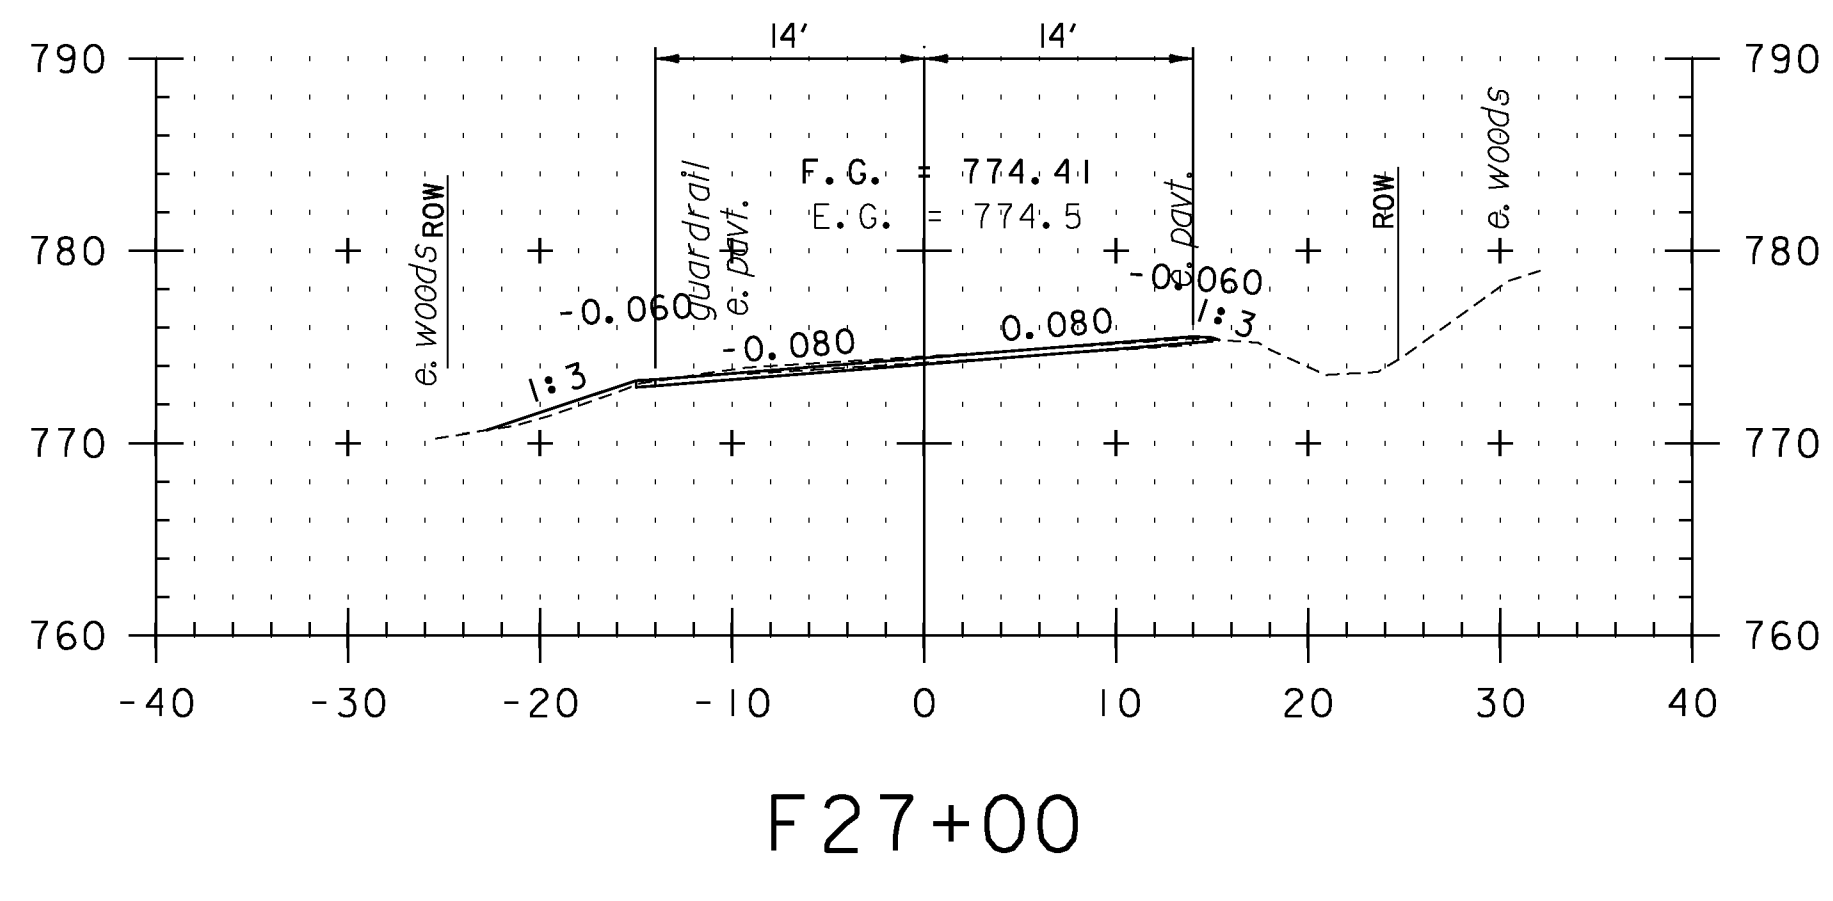

F27+00

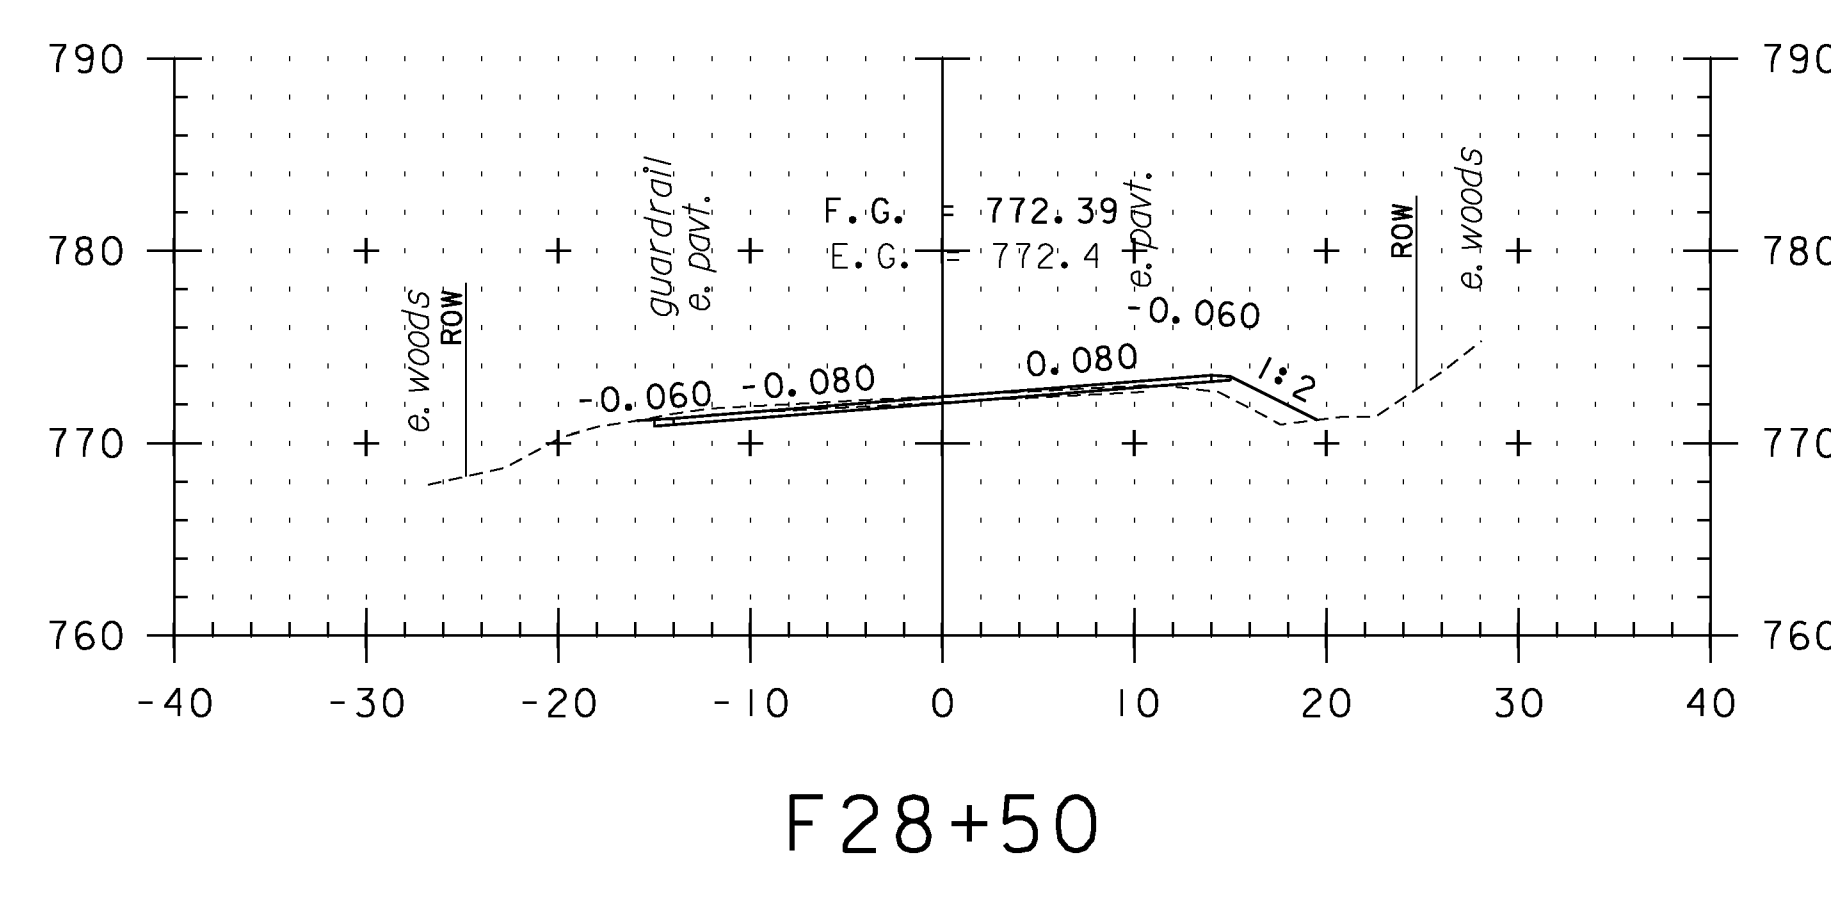


F28+50

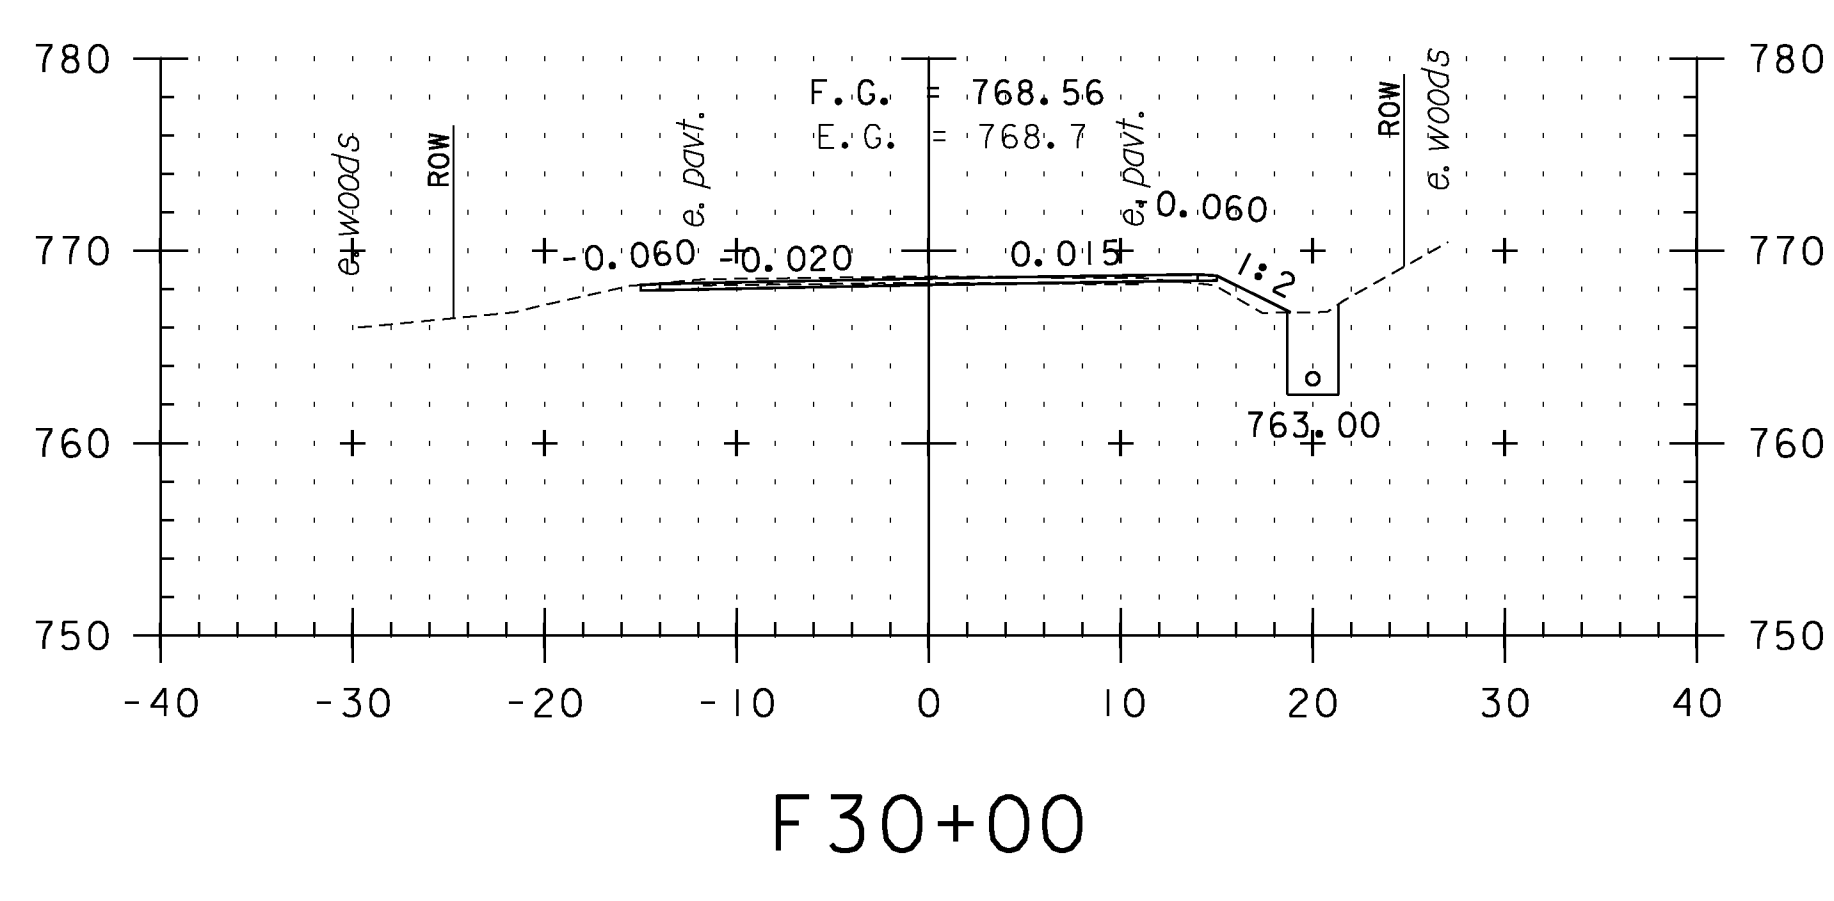

F30+00

CROSS SECTION SHEET 59

STA. F27+00 TO STA. F31+00

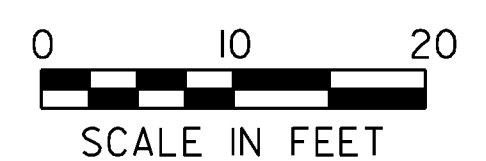

PROJECT NAME: VERSHIRE-THETFORD	
PROJECT NUMBER: STP 2911(I)	
FILE NAME: pl0c224.dgn	PLOT DATE: 1/29/2013
PROJECT LEADER: PTS	DRAWN BY: SNG
DESIGNED BY: NLL	CHECKED BY: PTS
IPARM FILE NAME: IOC224_I67	SHEET 167 OF 232