




F41+50

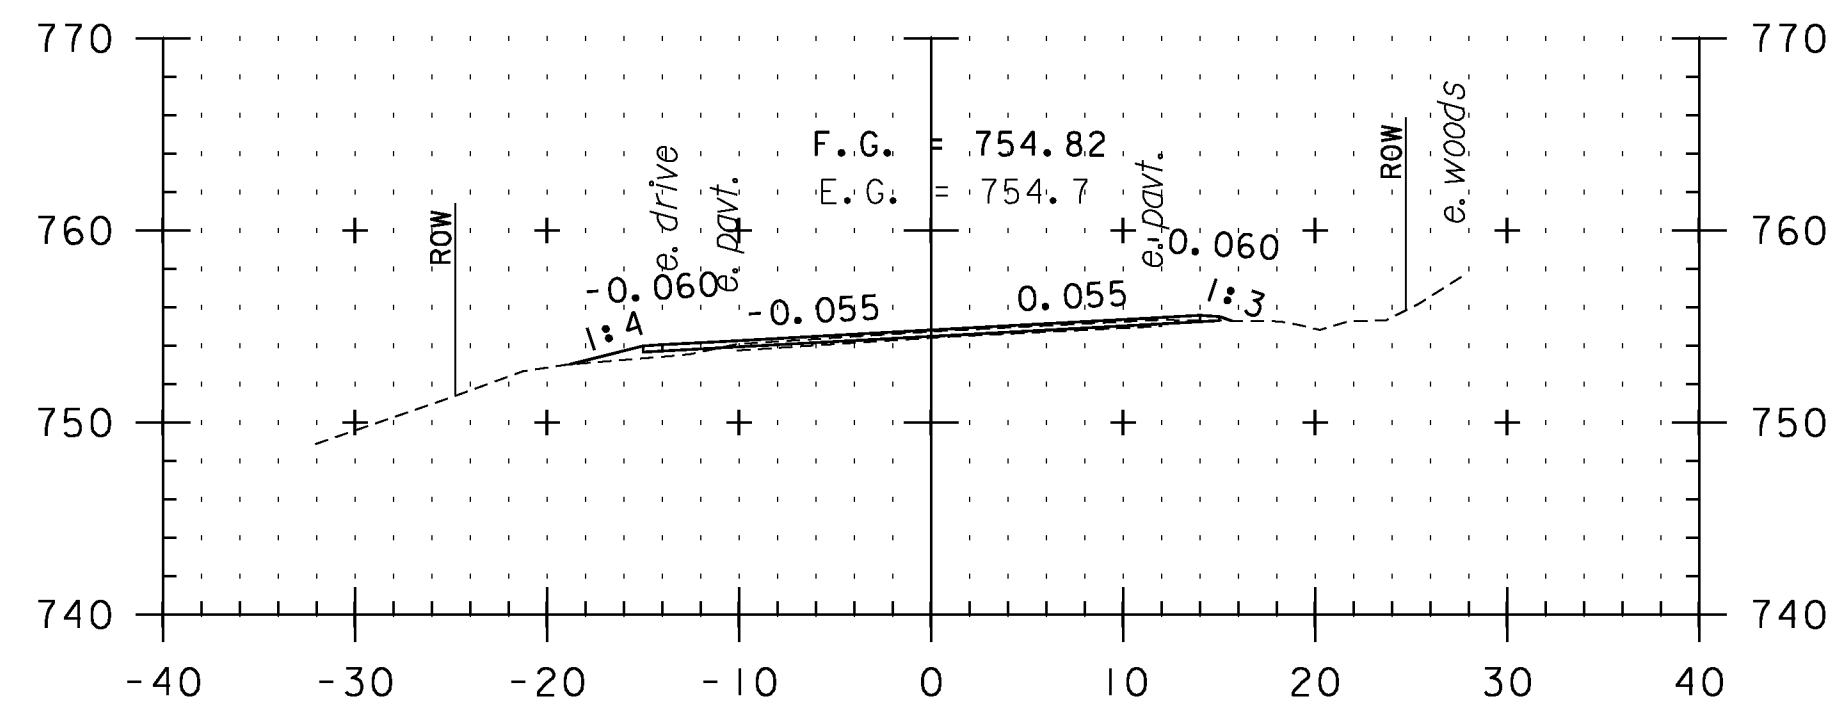


F41+00

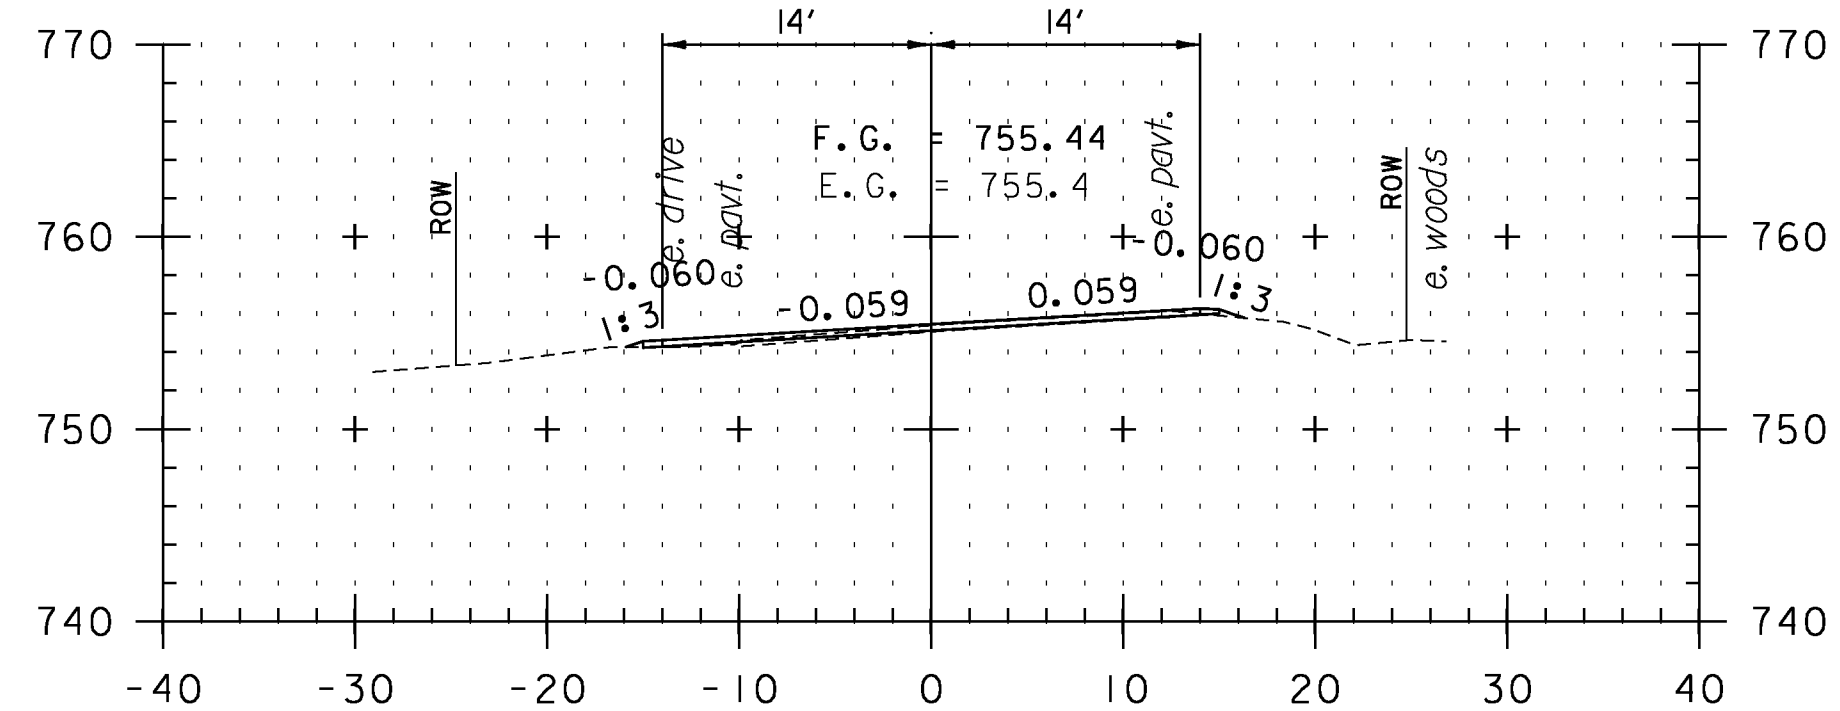


F40+50

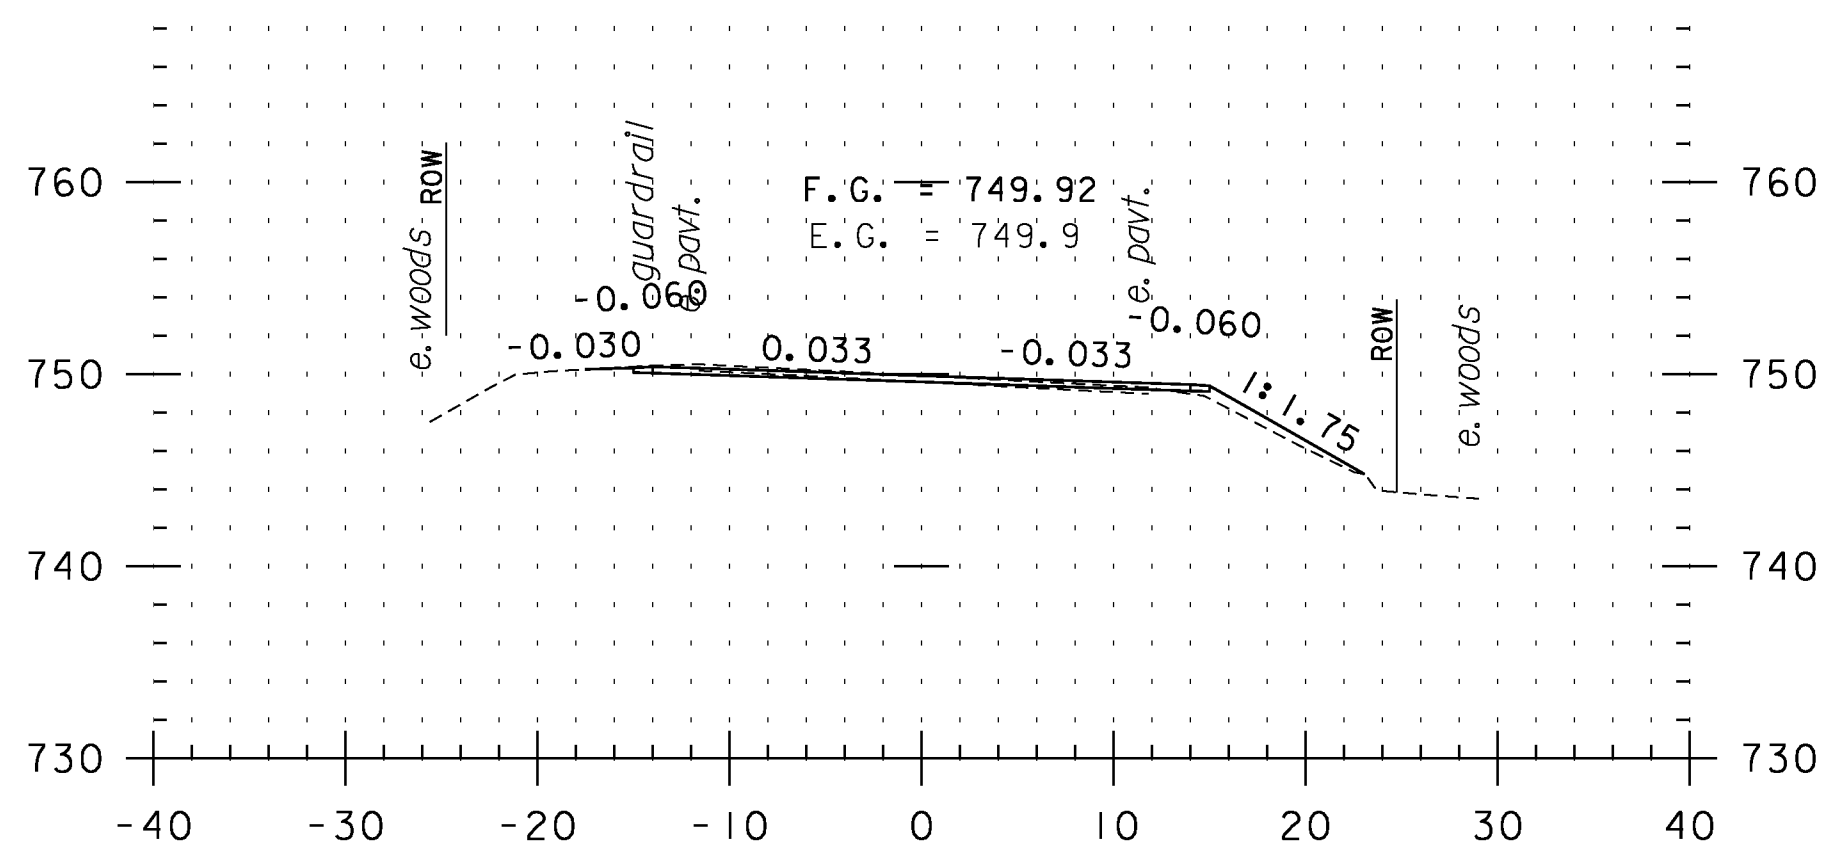


F43+00

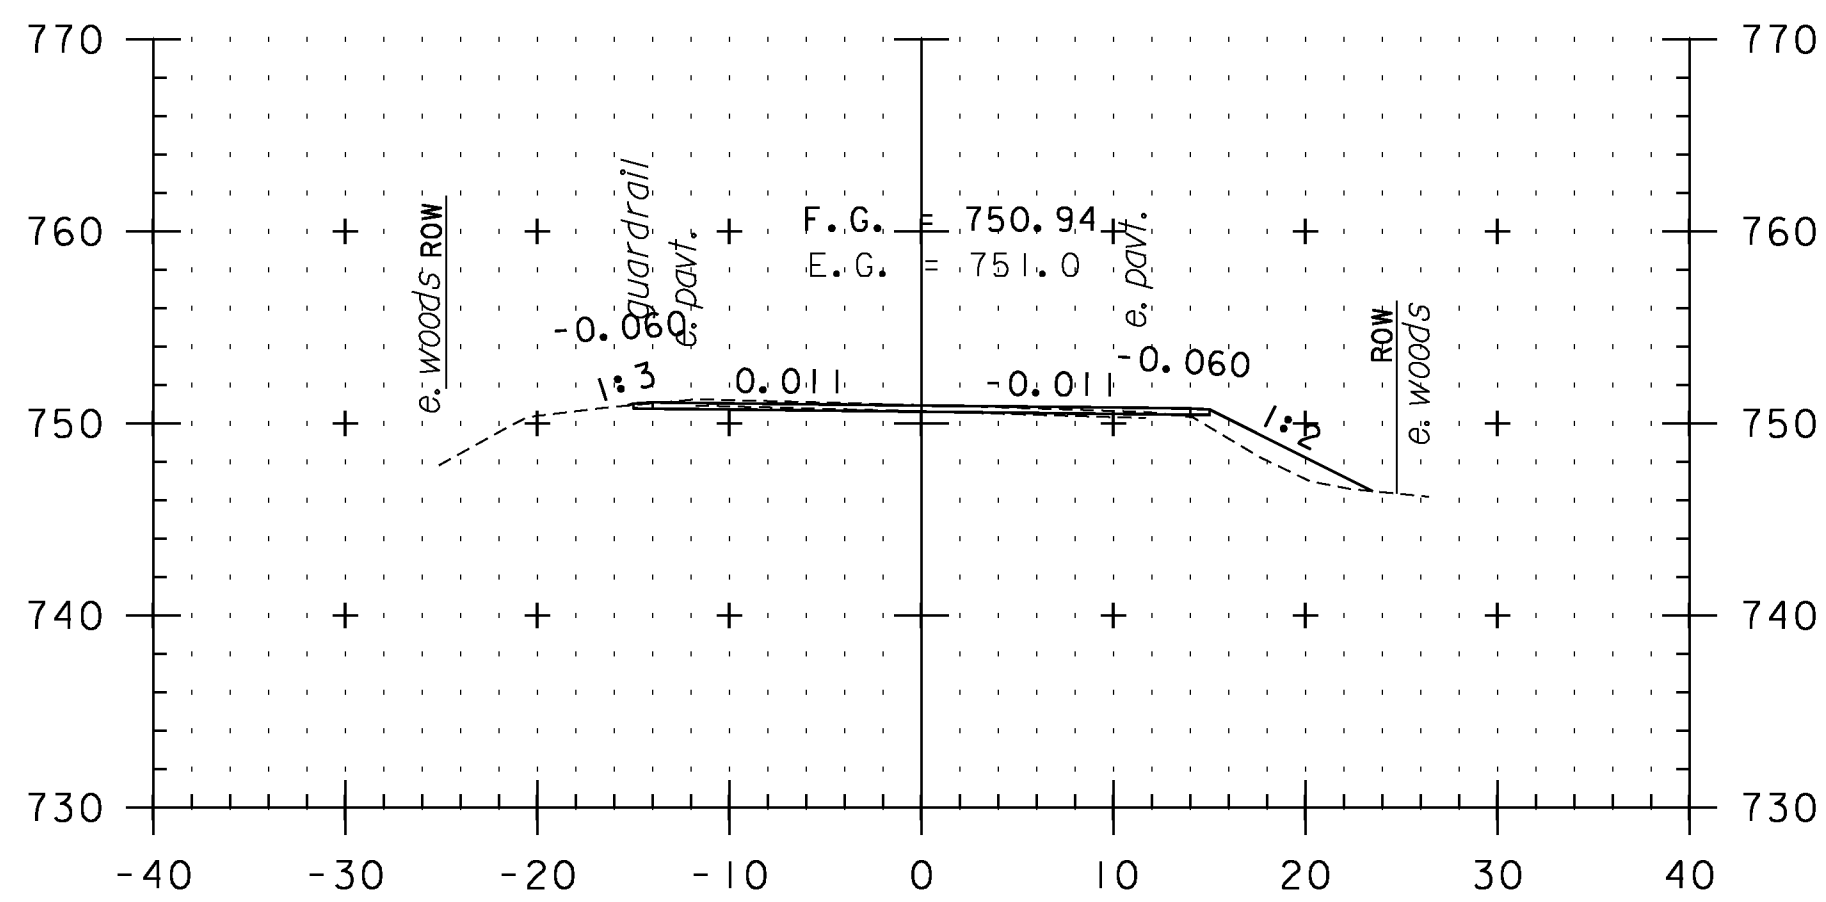


F42+50

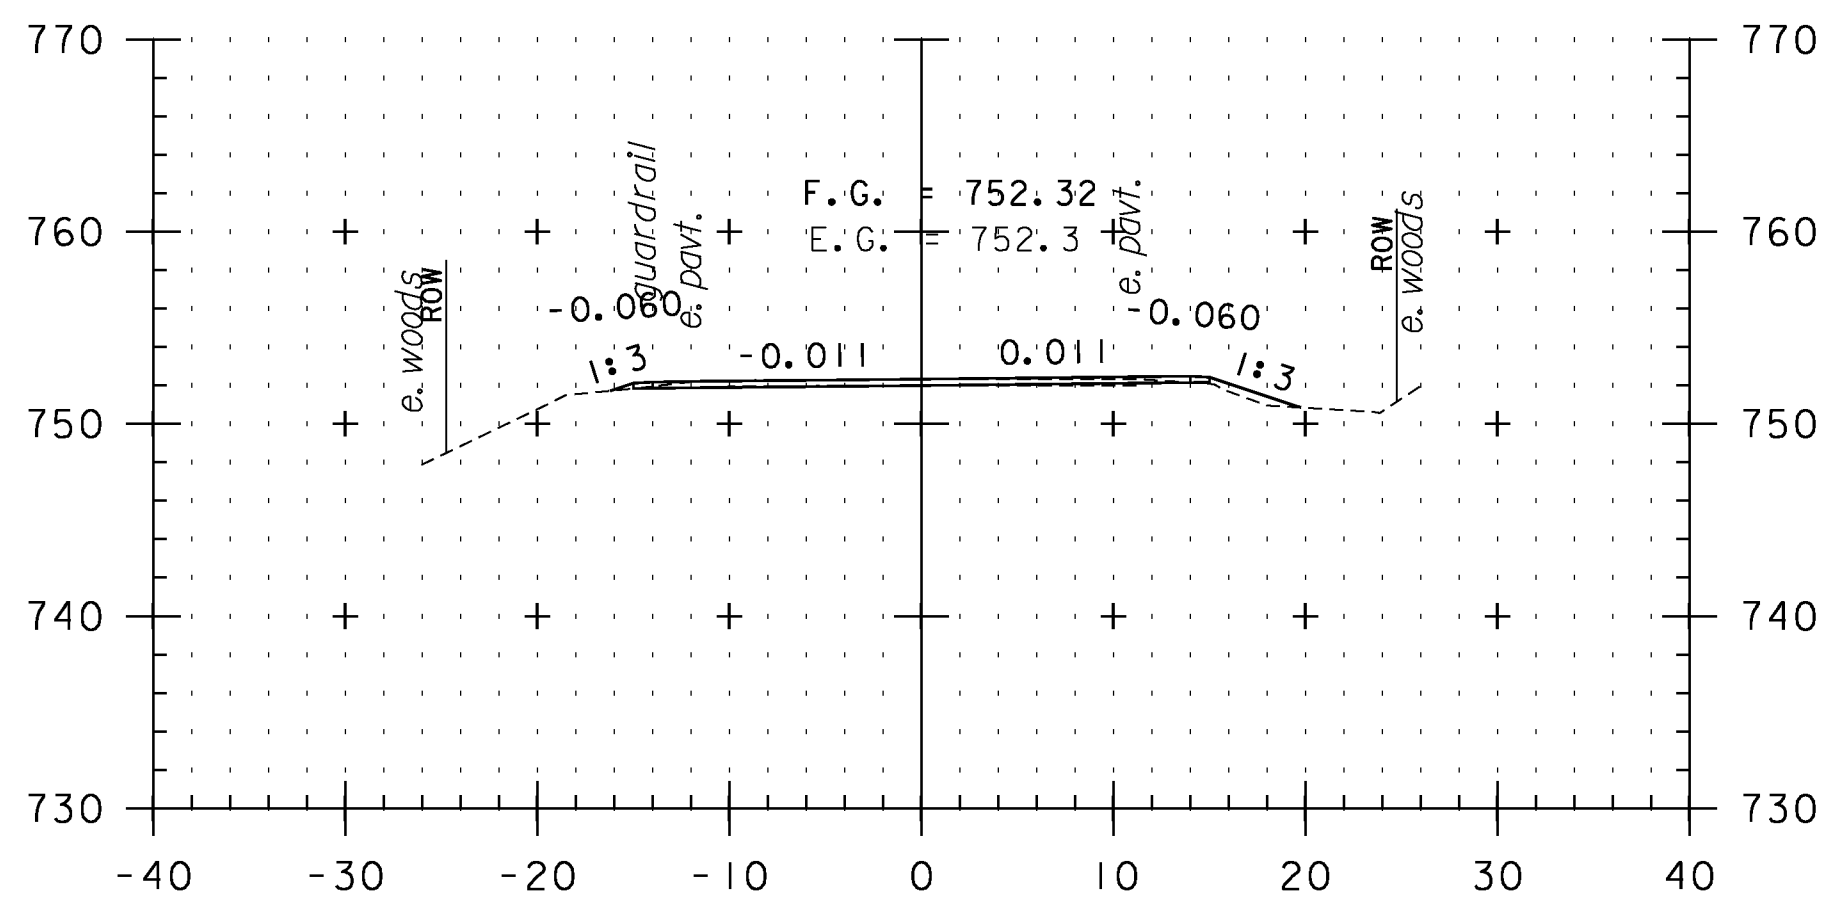


F42+00

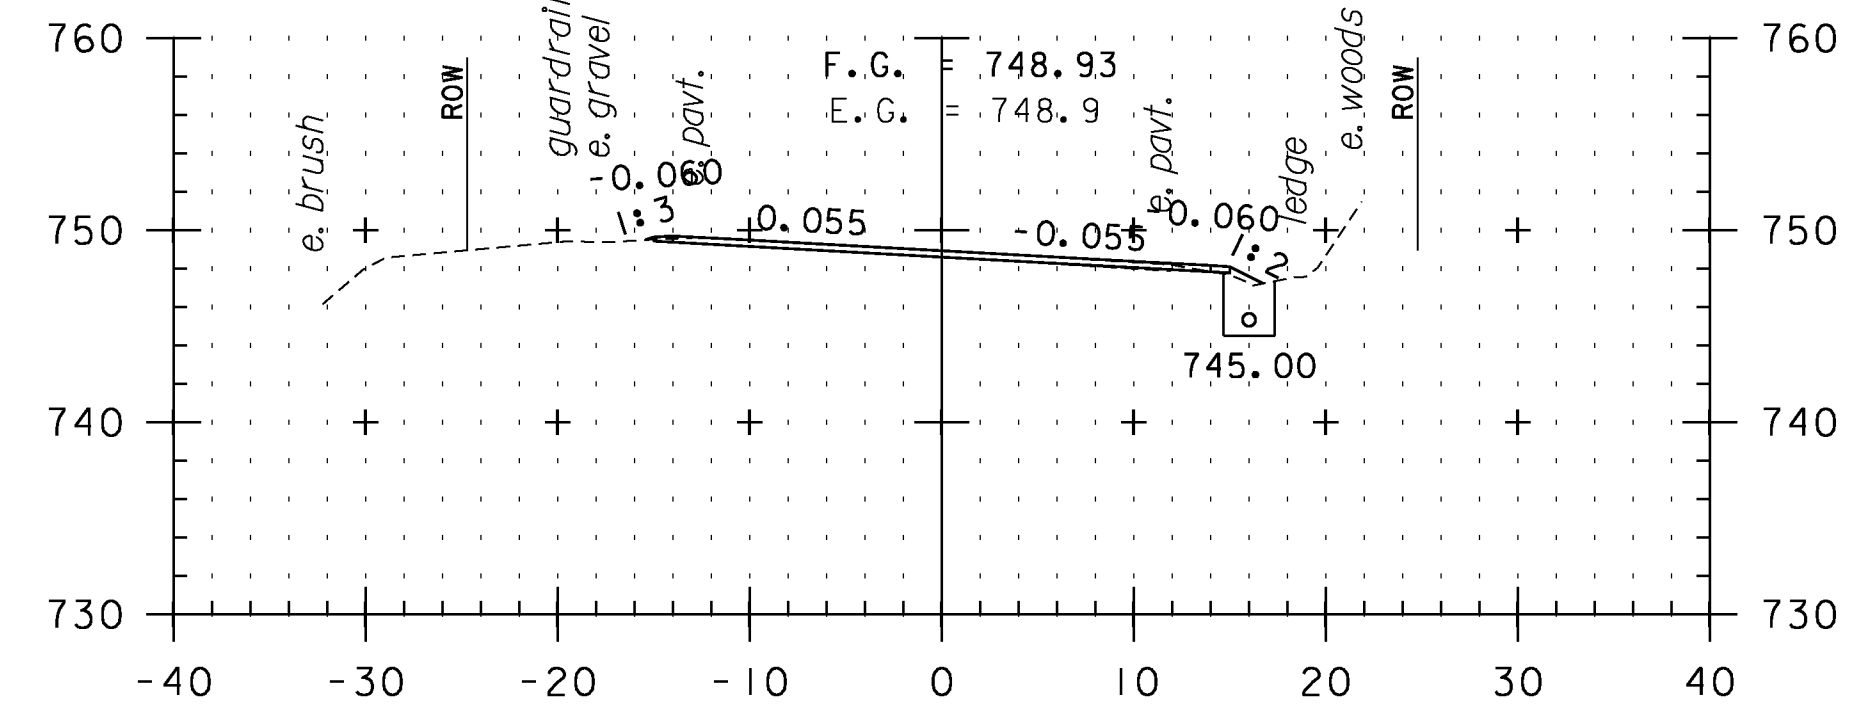

F44+50

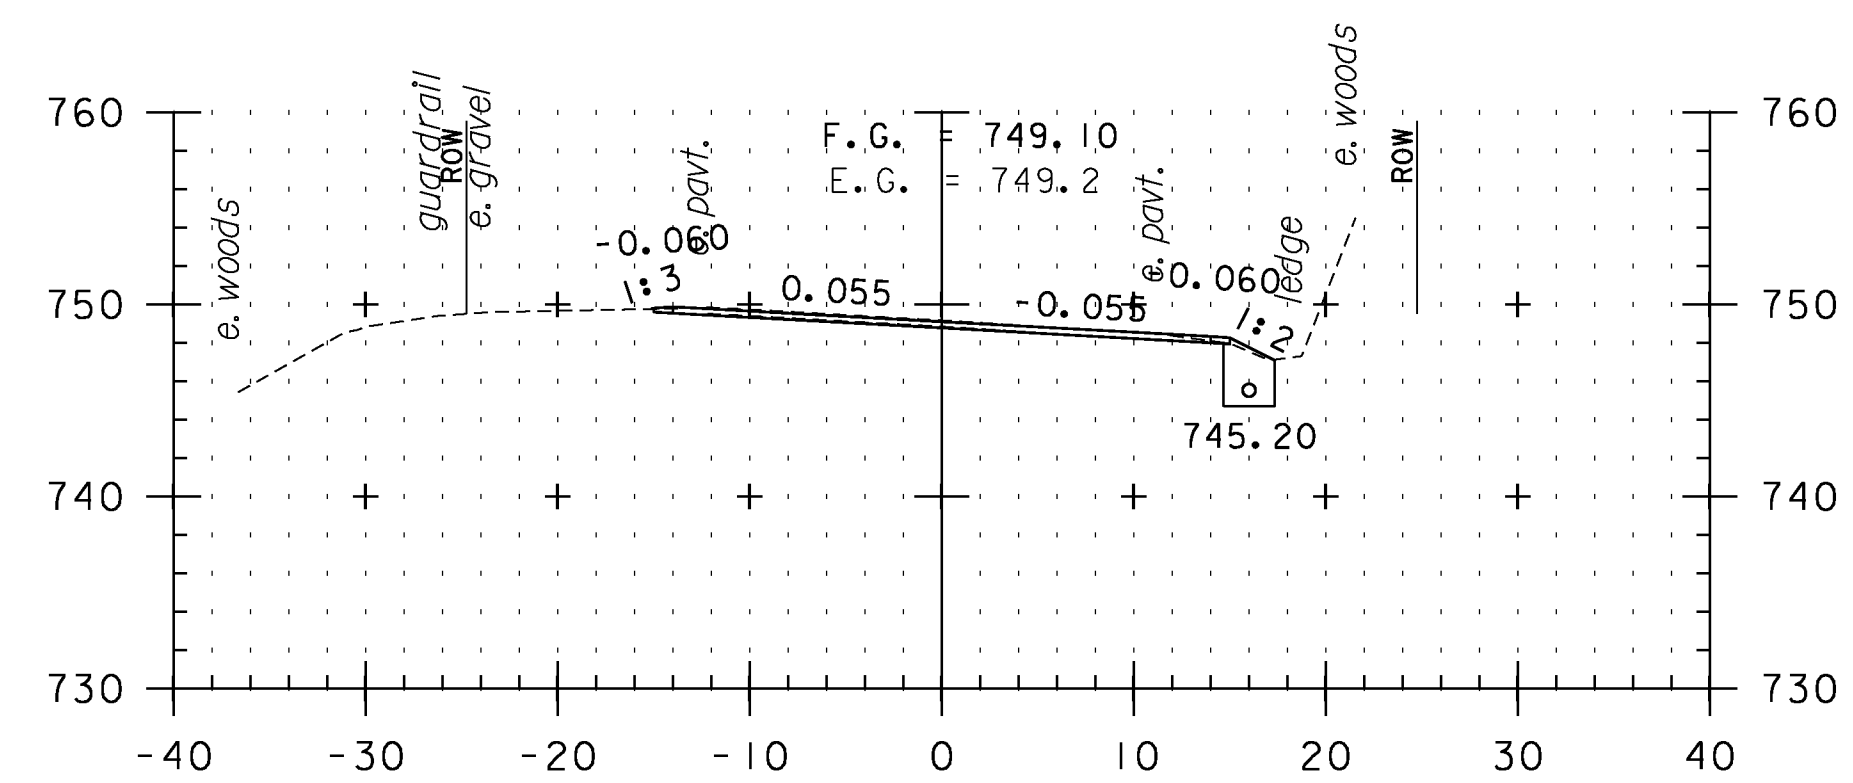

F44+00

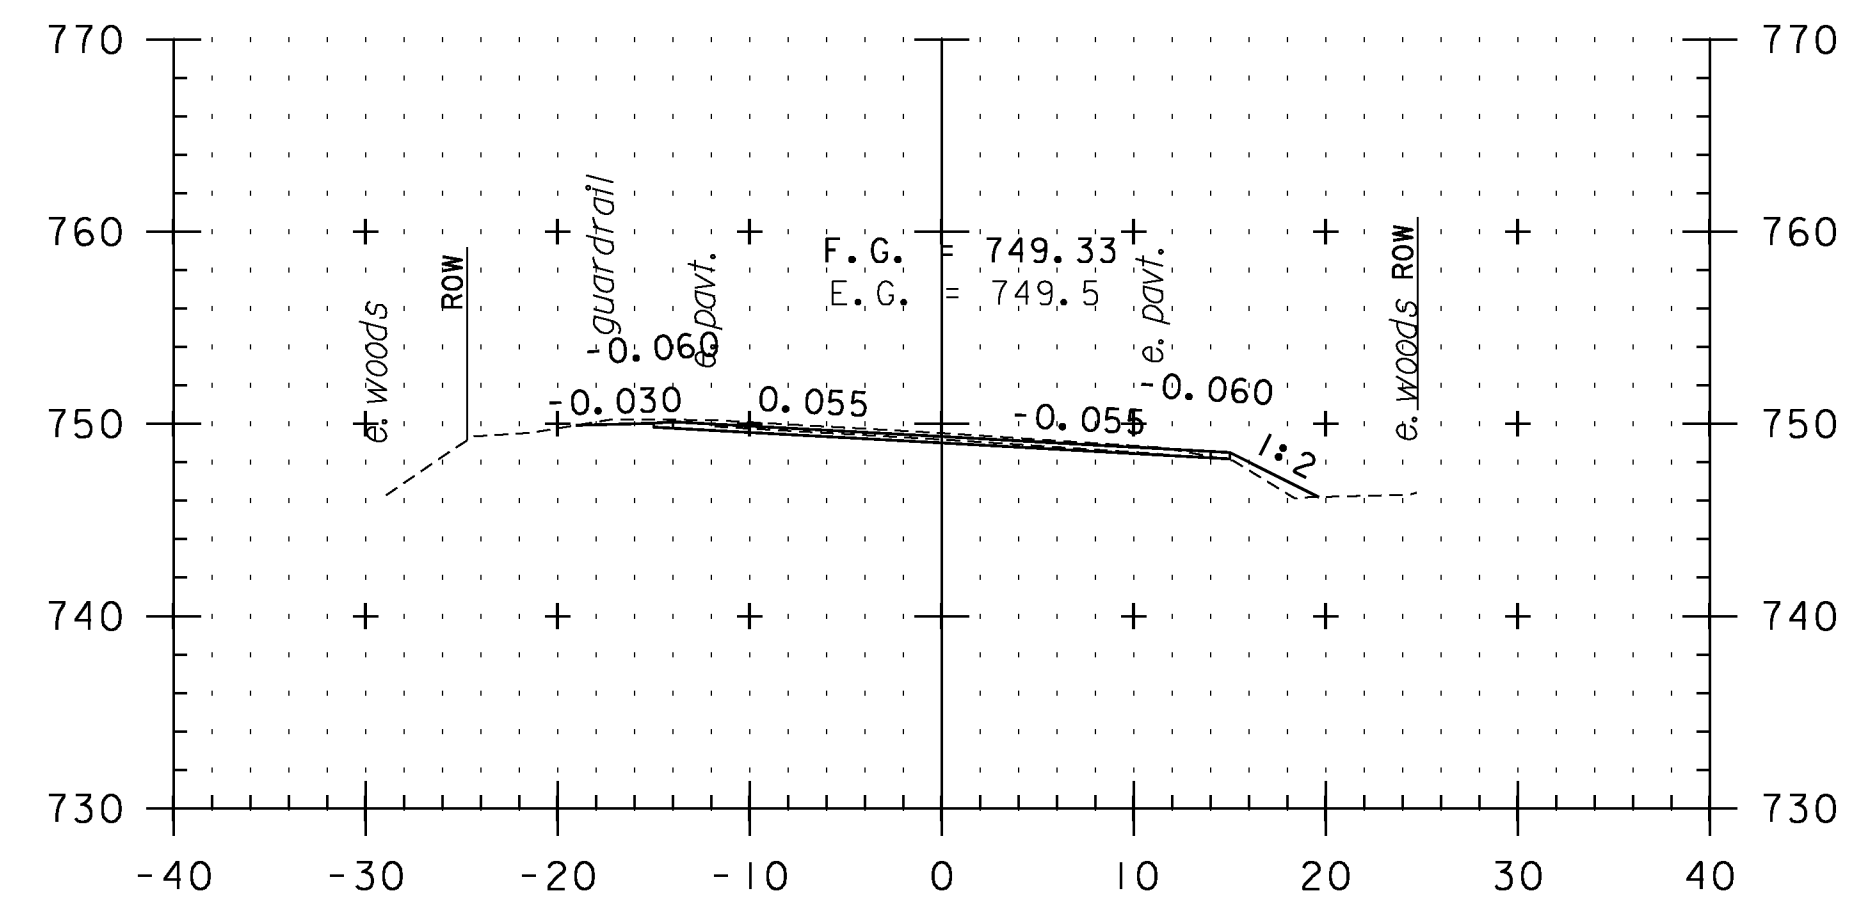

F43+50

CROSS SECTION SHEET 62

PROJECT NAME: VERSHIRE-THETFORD

PROJECT NUMBER: STP 291(K)

FILE NAME: pl0c224.dgn

PLOT DATE: 1/29/2013

PROJECT LEADER: PTS

DRAWN BY: SNG

DESIGNED BY: NLL

CHECKED BY: PTS

IPARM FILE NAME: IOC224_I70

SHEET 170 OF 232

STA. F40+50 TO STA. F44+50

