




F 46+00

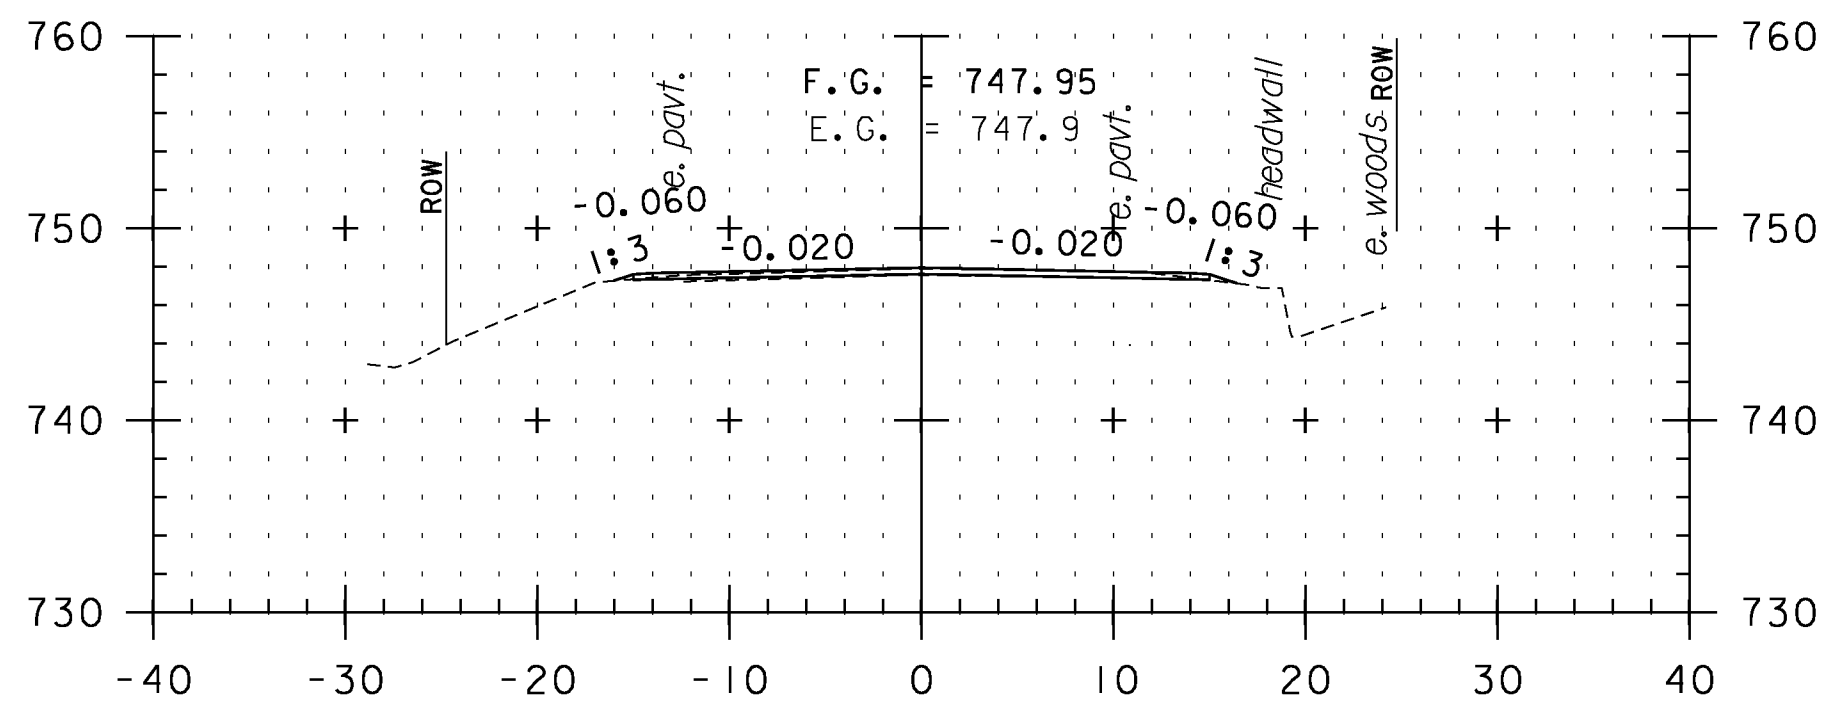


F 47+50

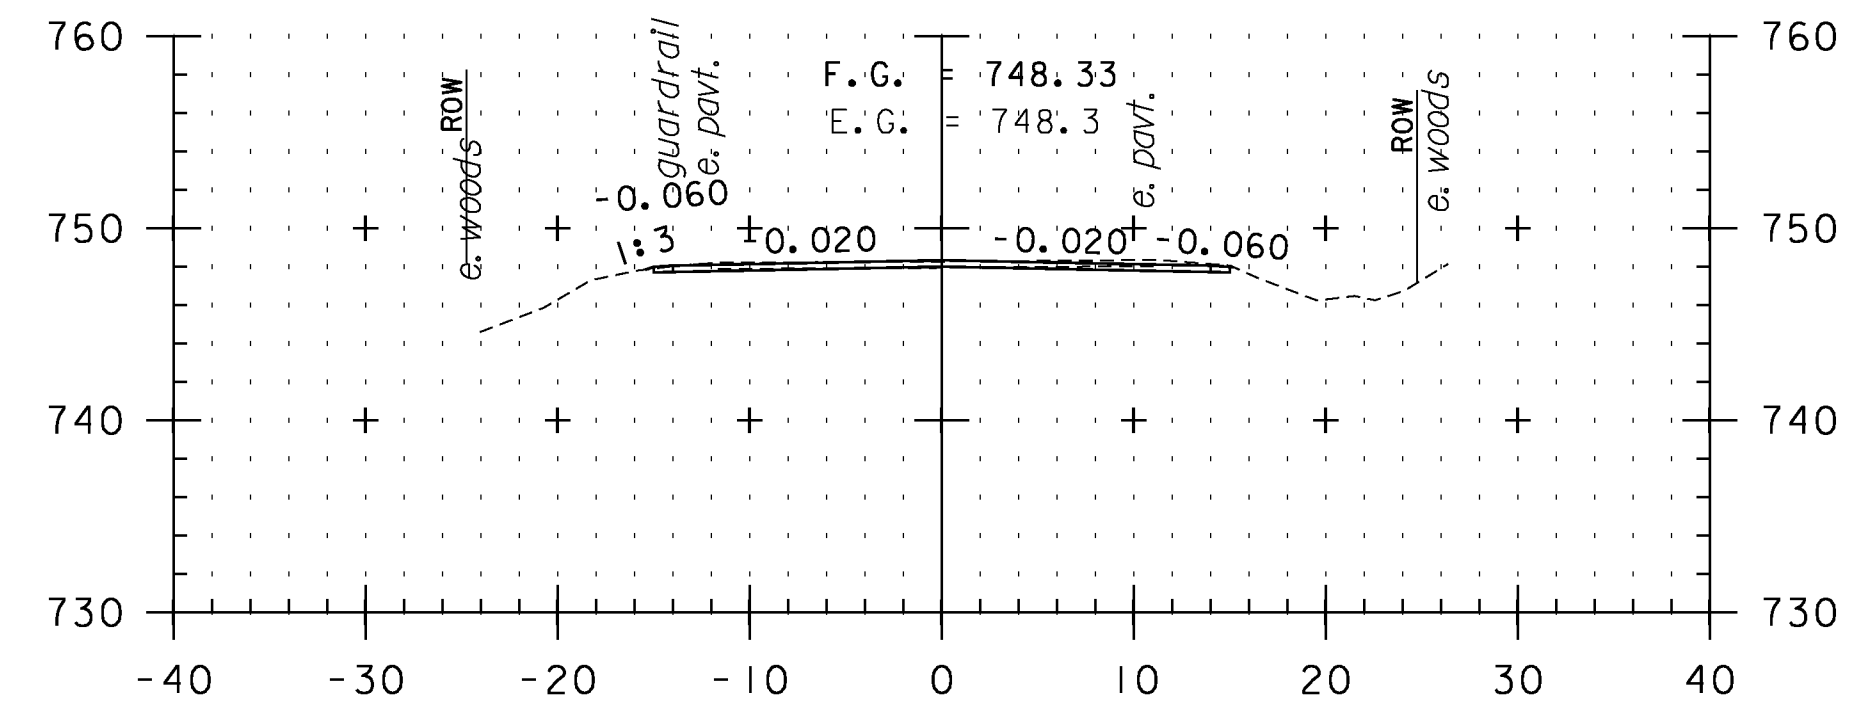


F 49+00

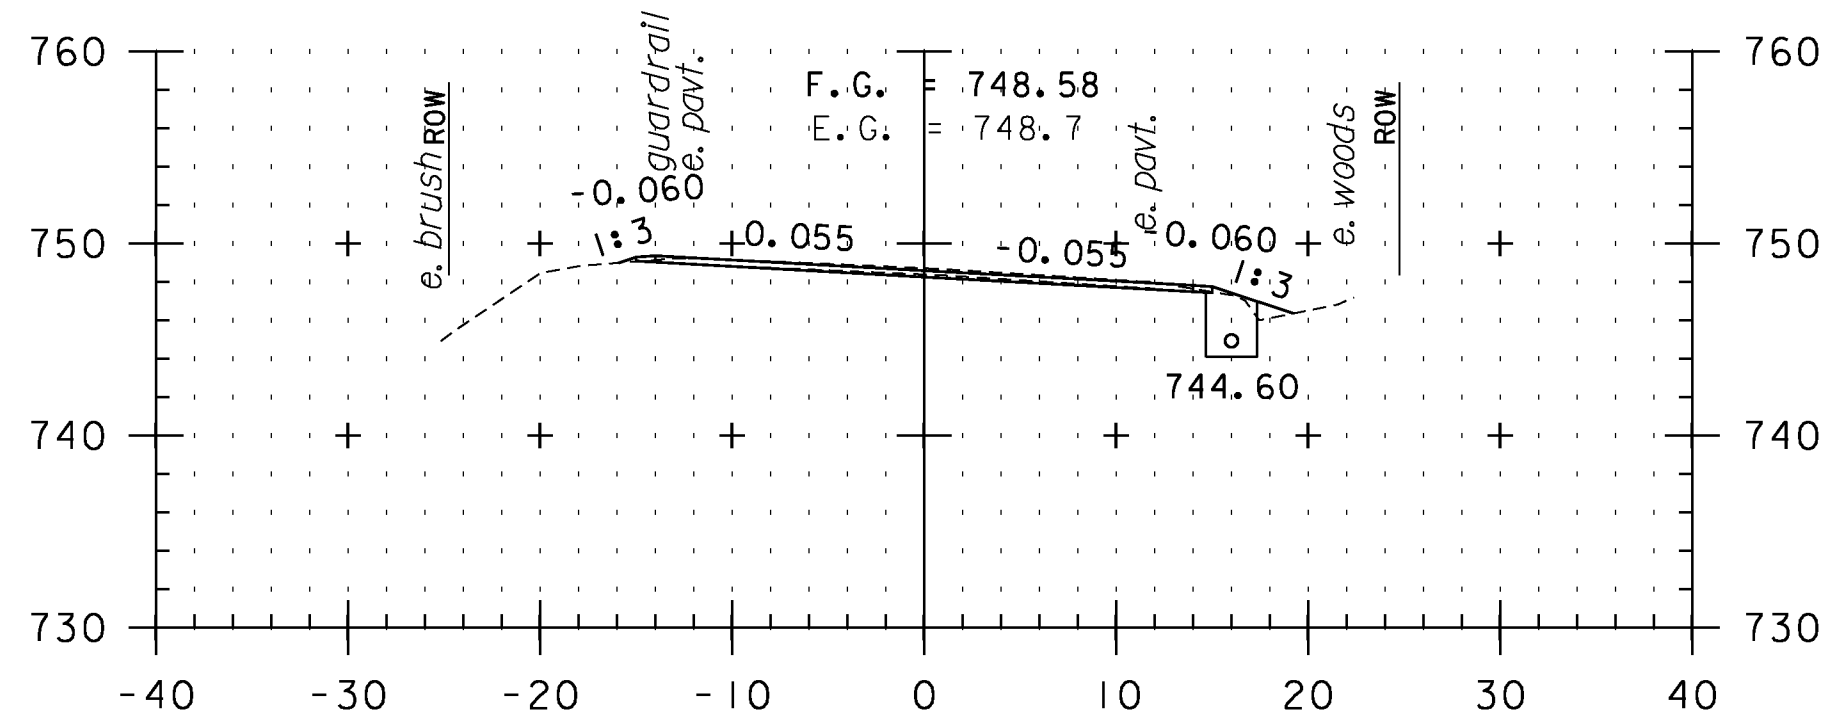


F 45+50

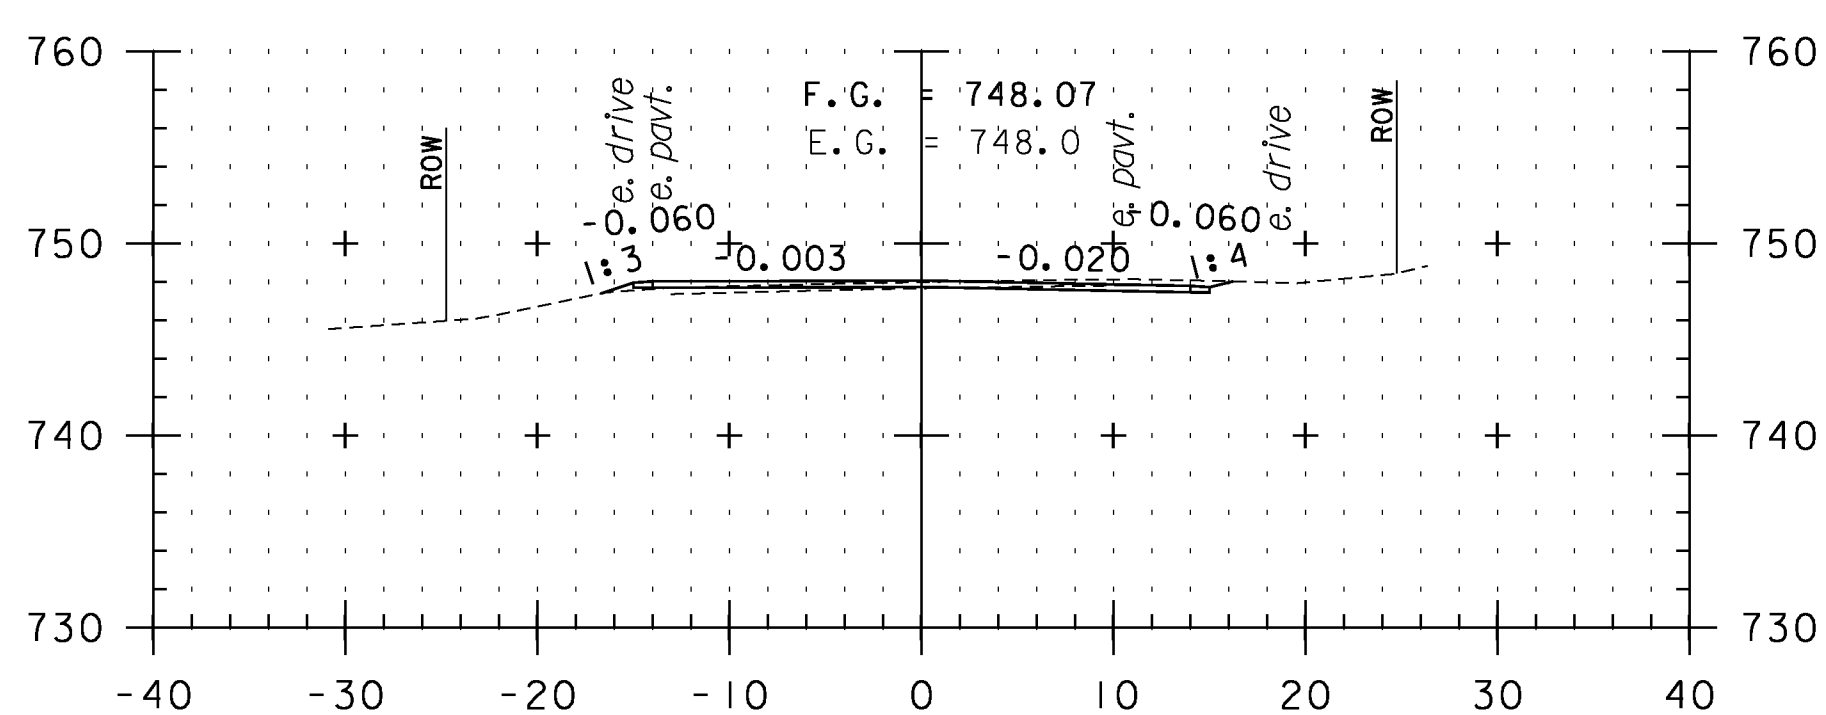


F 47+00

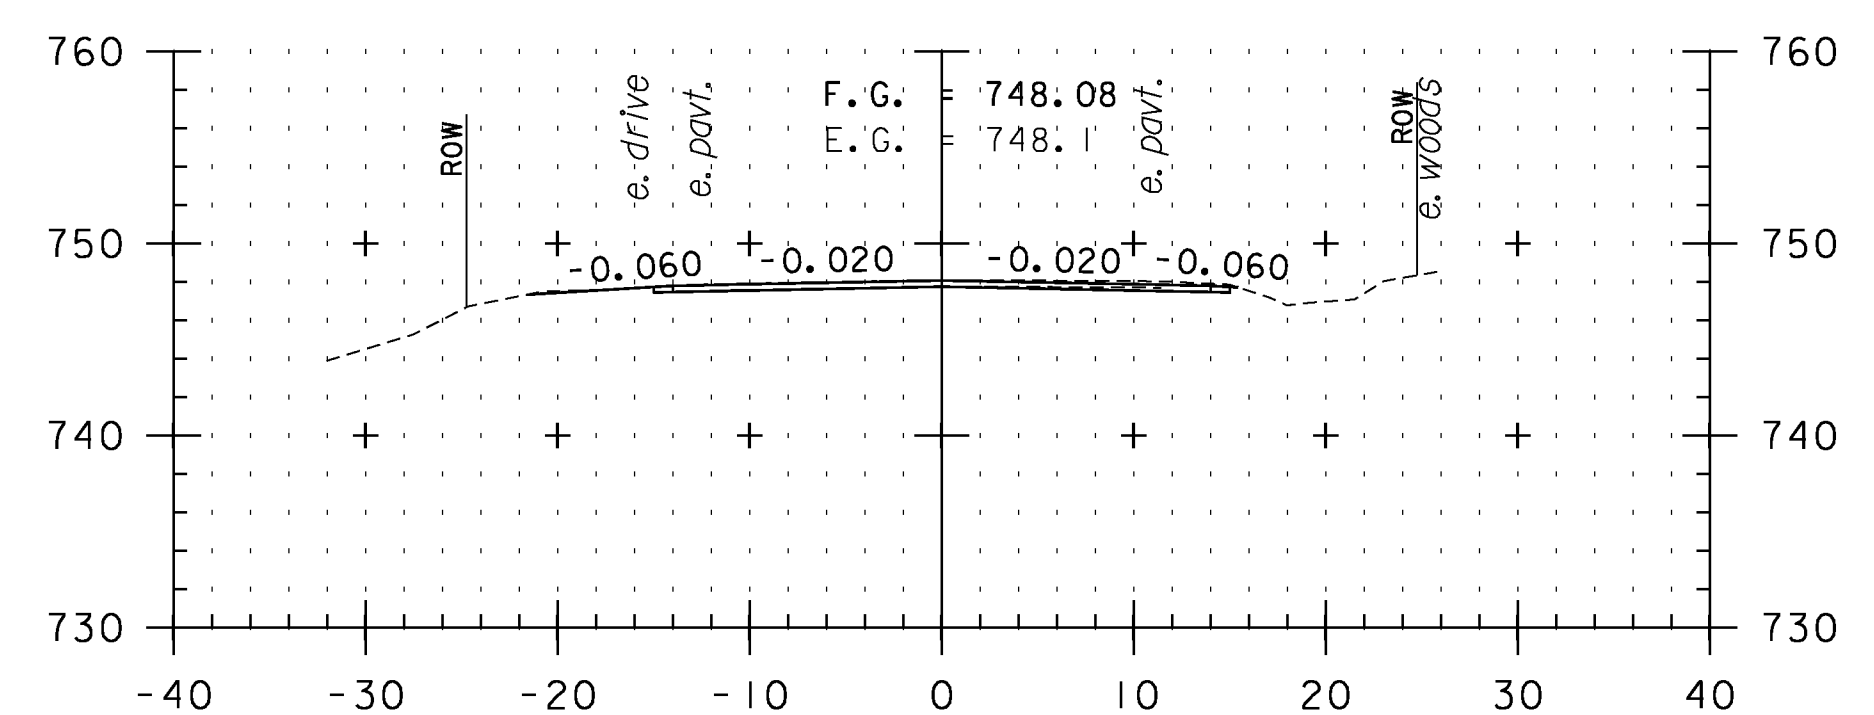


F 48+50

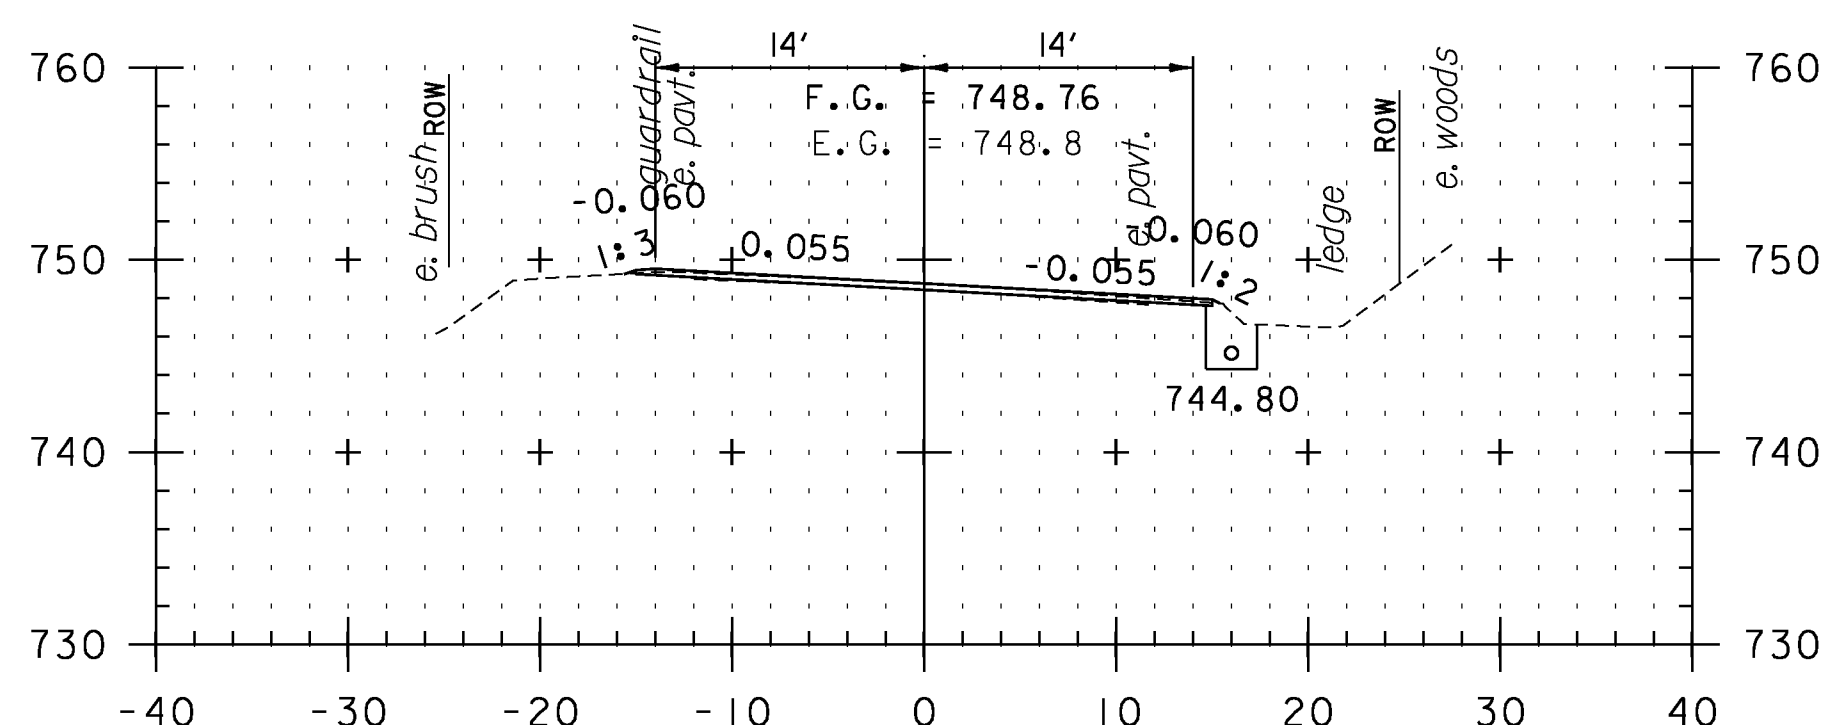

F 45+00

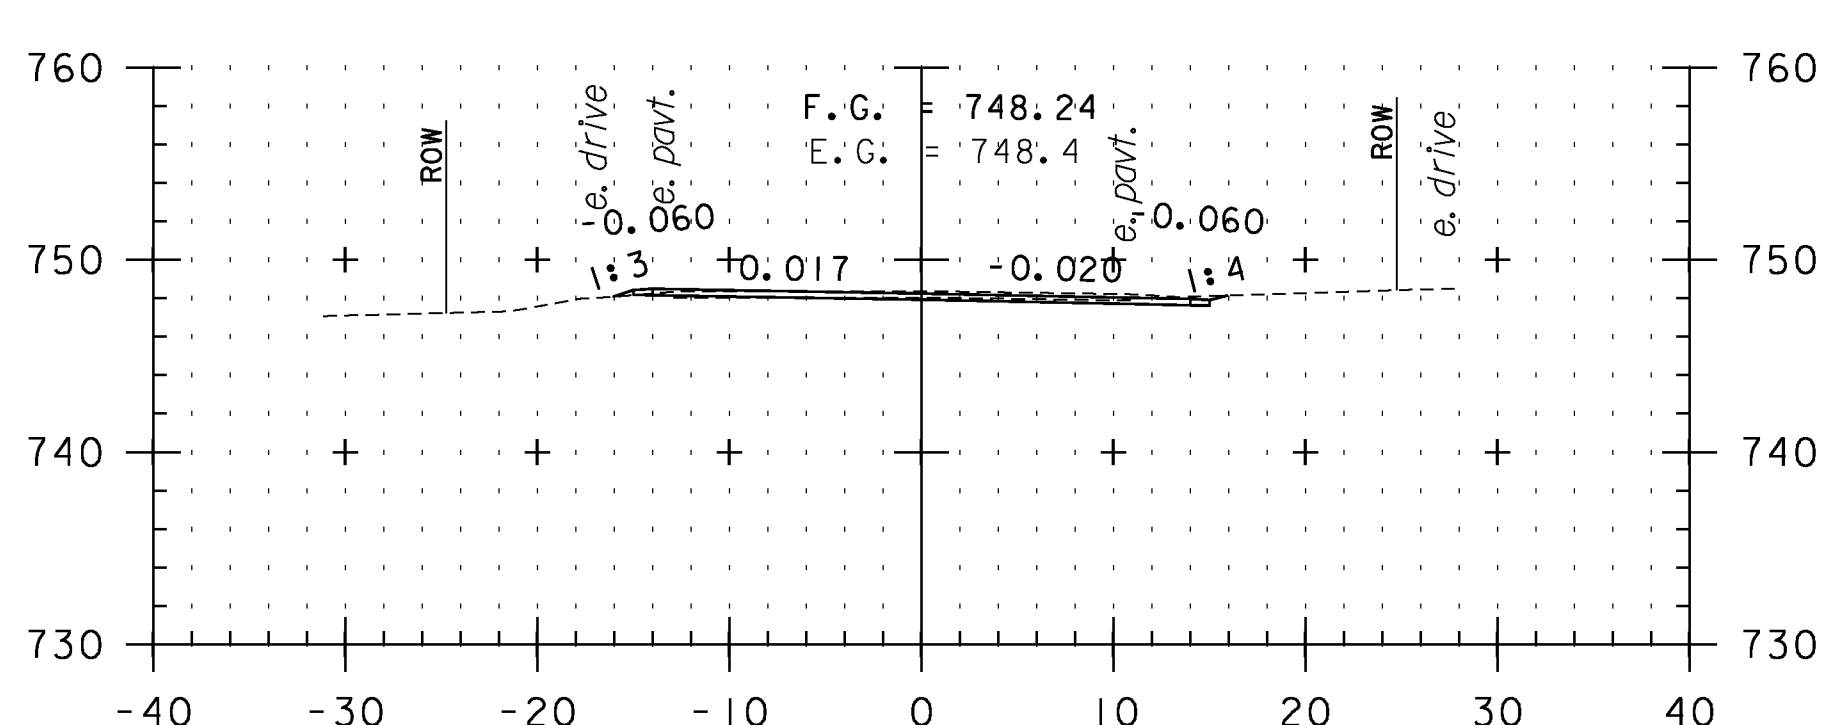

F 46+50

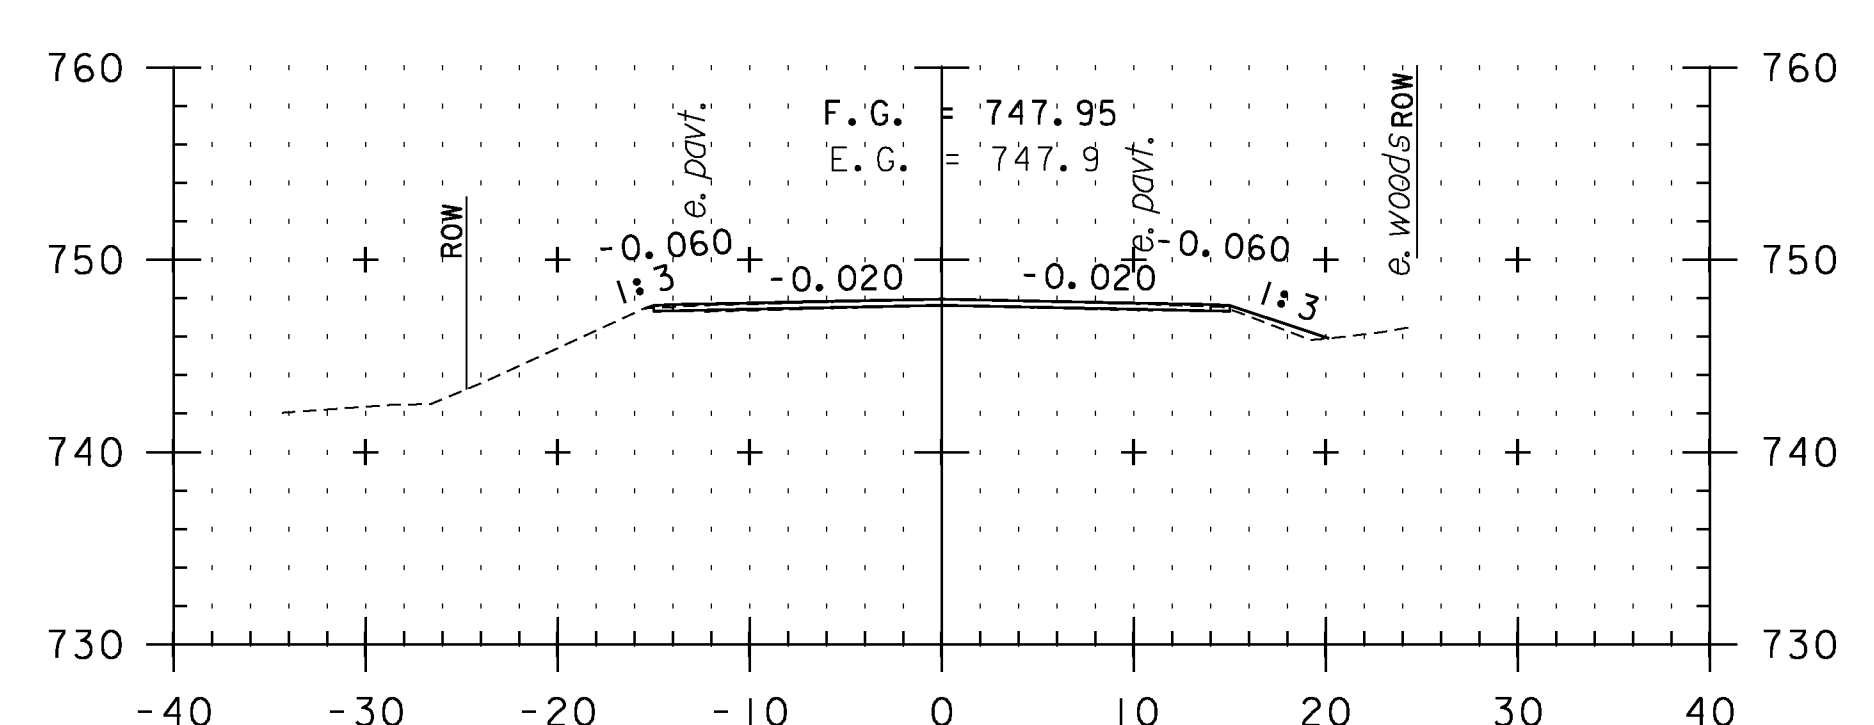

F 48+00

CROSS SECTION SHEET 63

STA. F45+00 TO STA. F49+00



PROJECT NAME: VERSHIRE-THETFORD	PLOT DATE: 1/29/2013
PROJECT NUMBER: STP 2911(I)	DRAWN BY: SNG
FILE NAME: pl0c224.dgn	CHECKED BY: PTS
PROJECT LEADER: PTS	SHEET 171 OF 232
DESIGNED BY: NLL	
IPARM FILE NAME: IOC224_171	