




F50+50

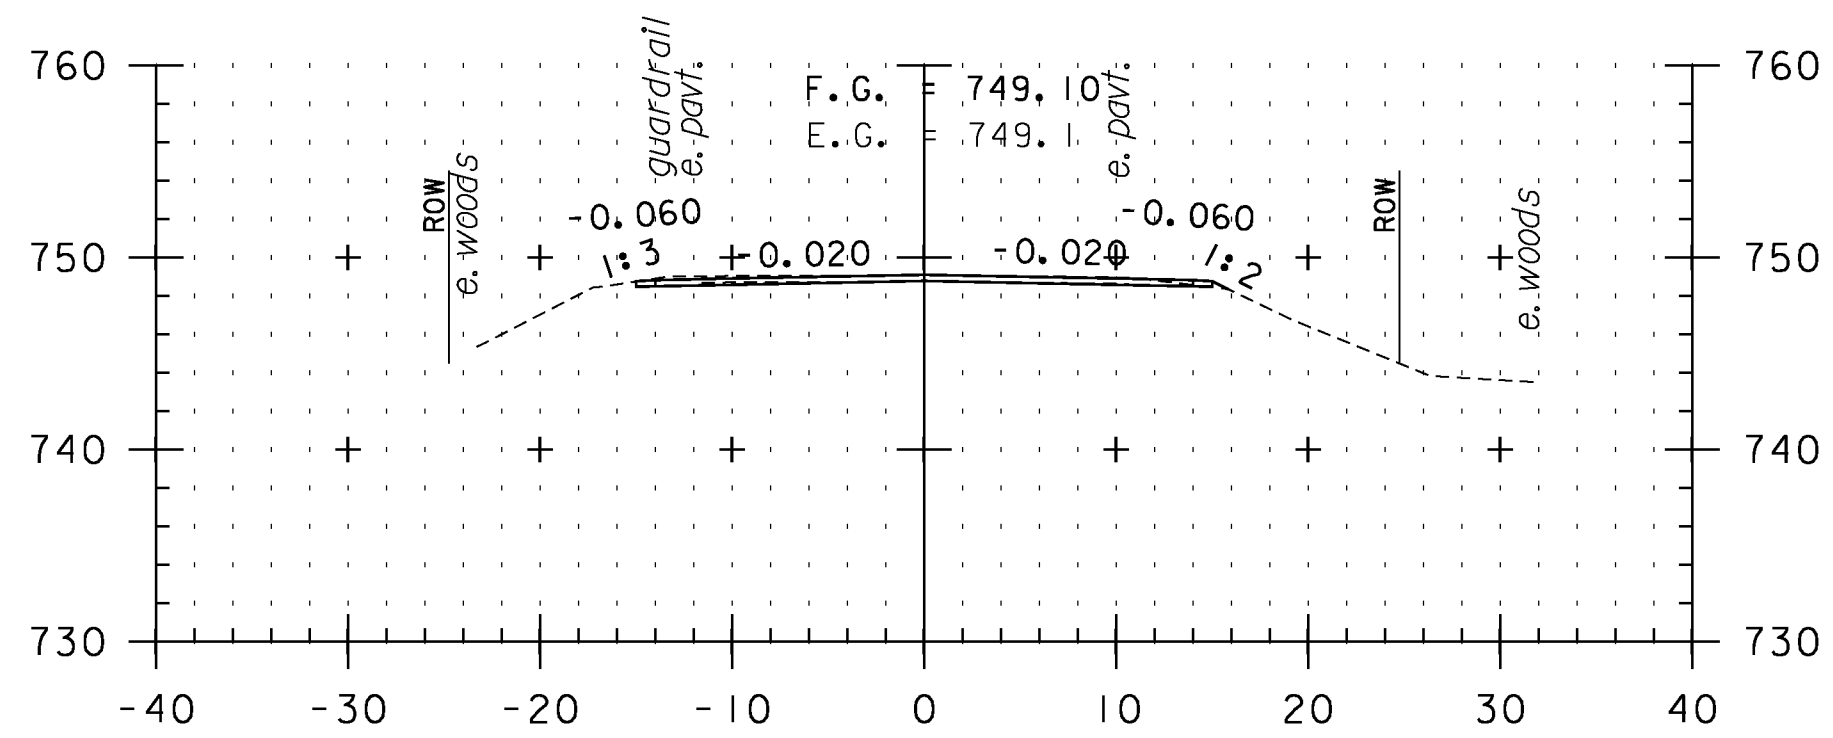


F50+00

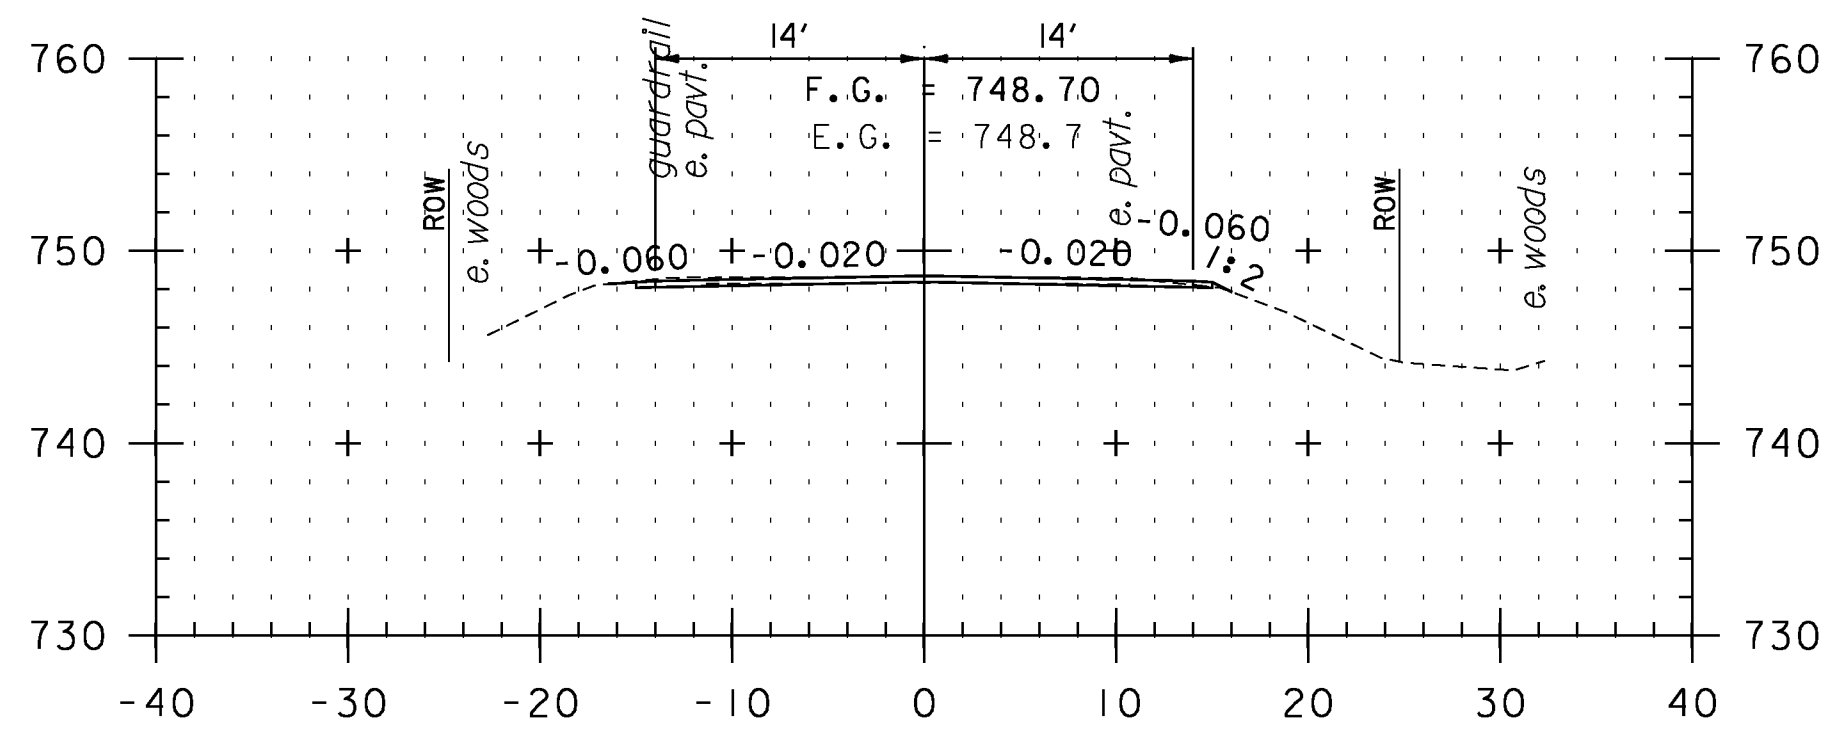


F49+50

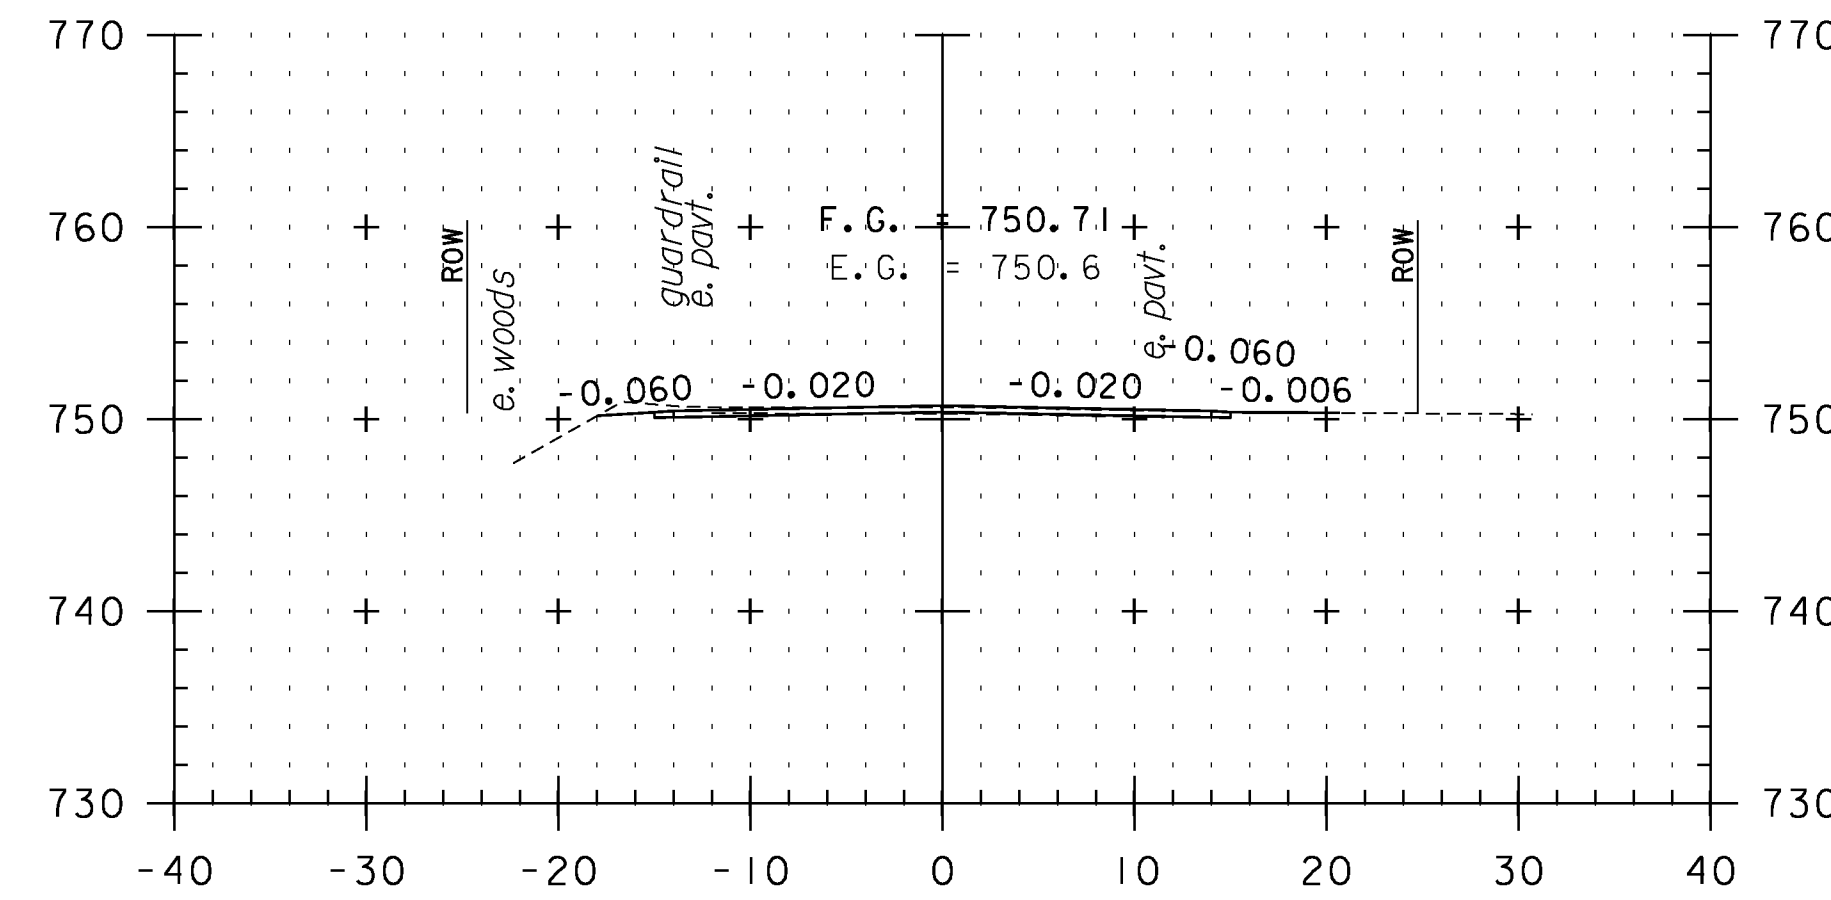


F52+00

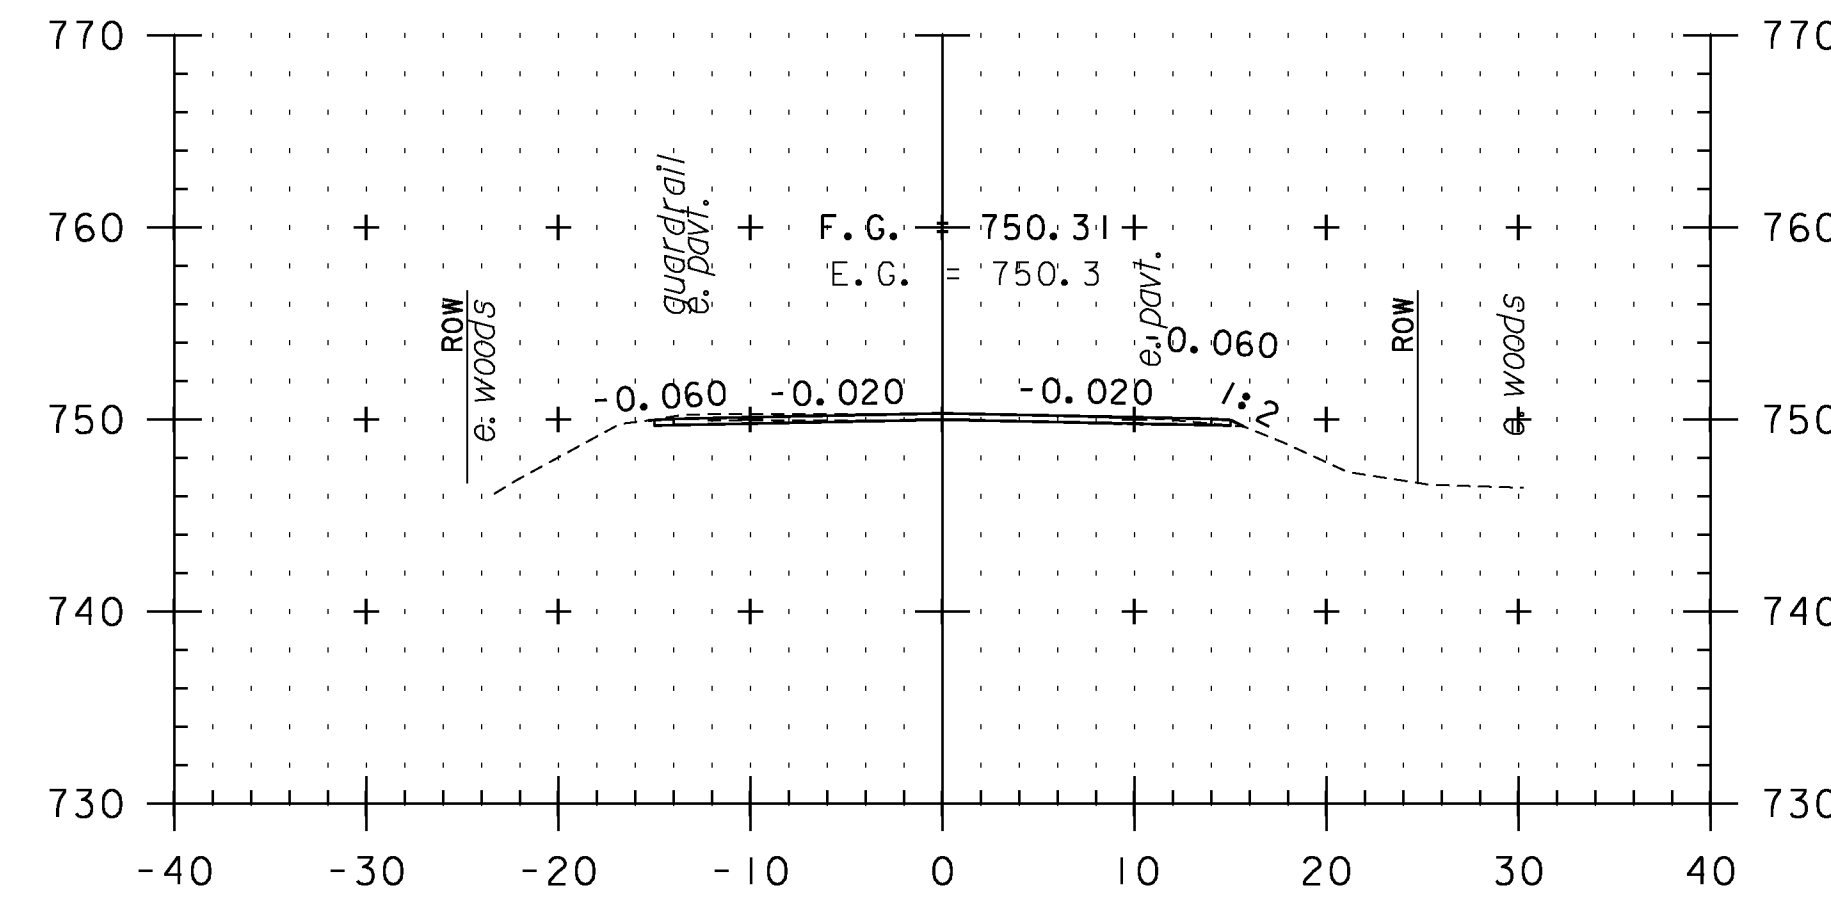


F51+50

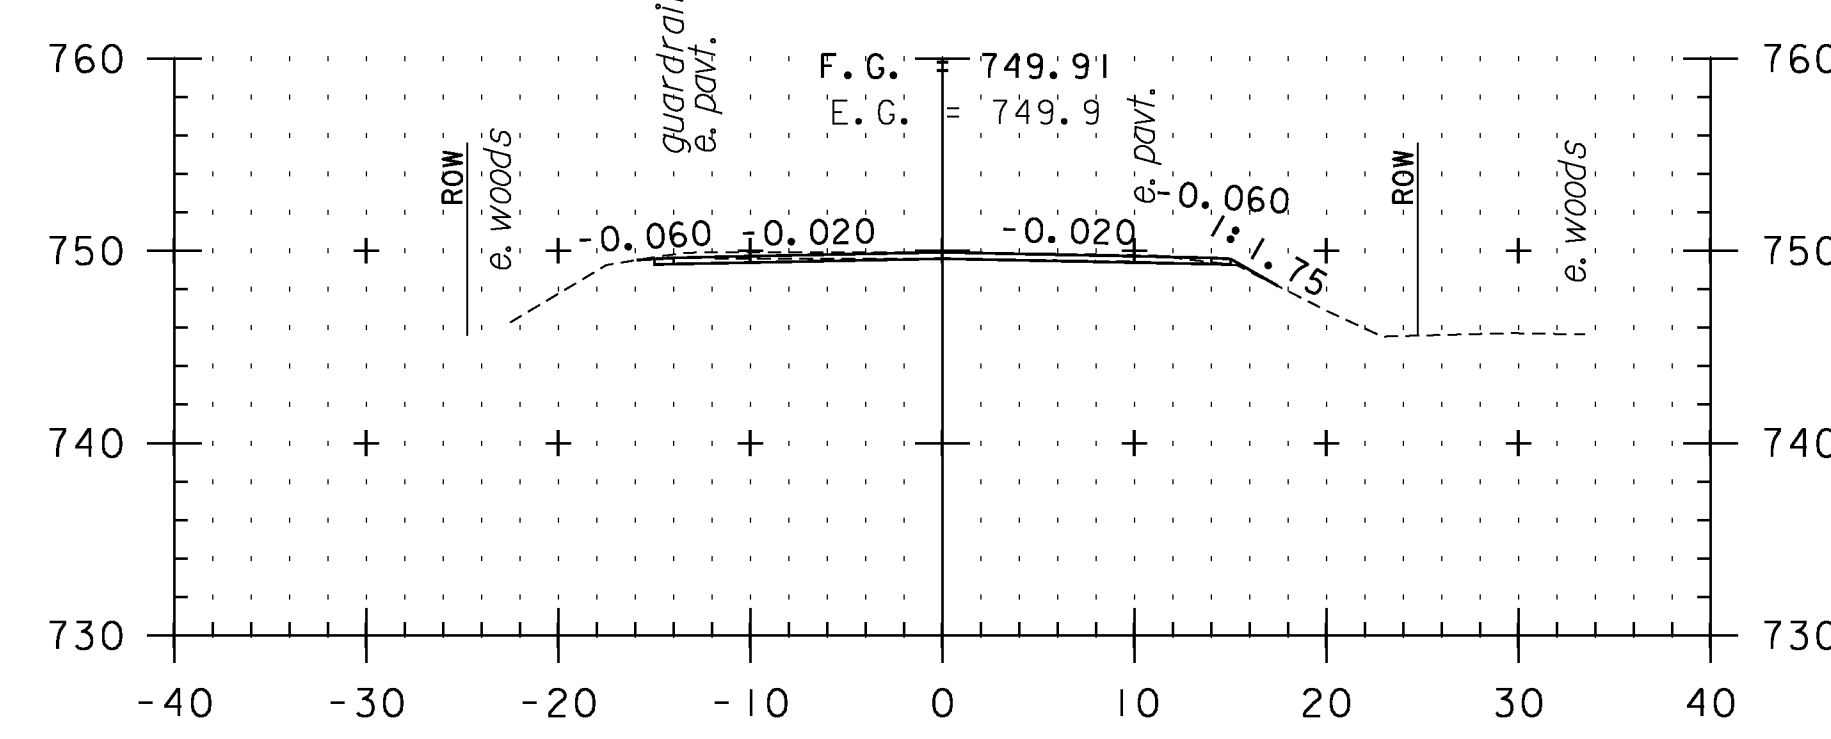


F51+00

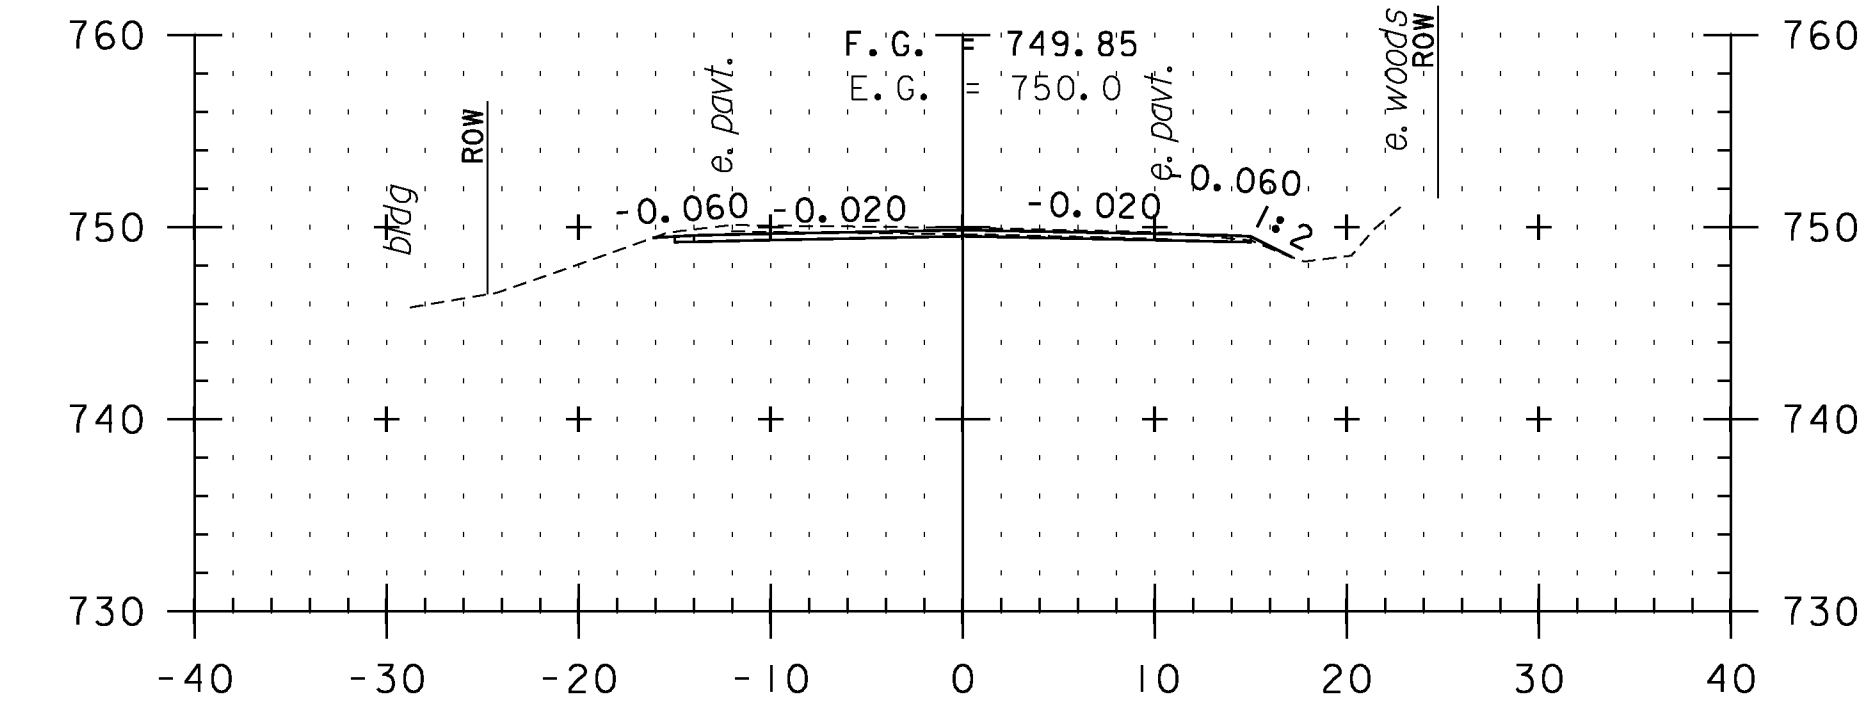

F53+50

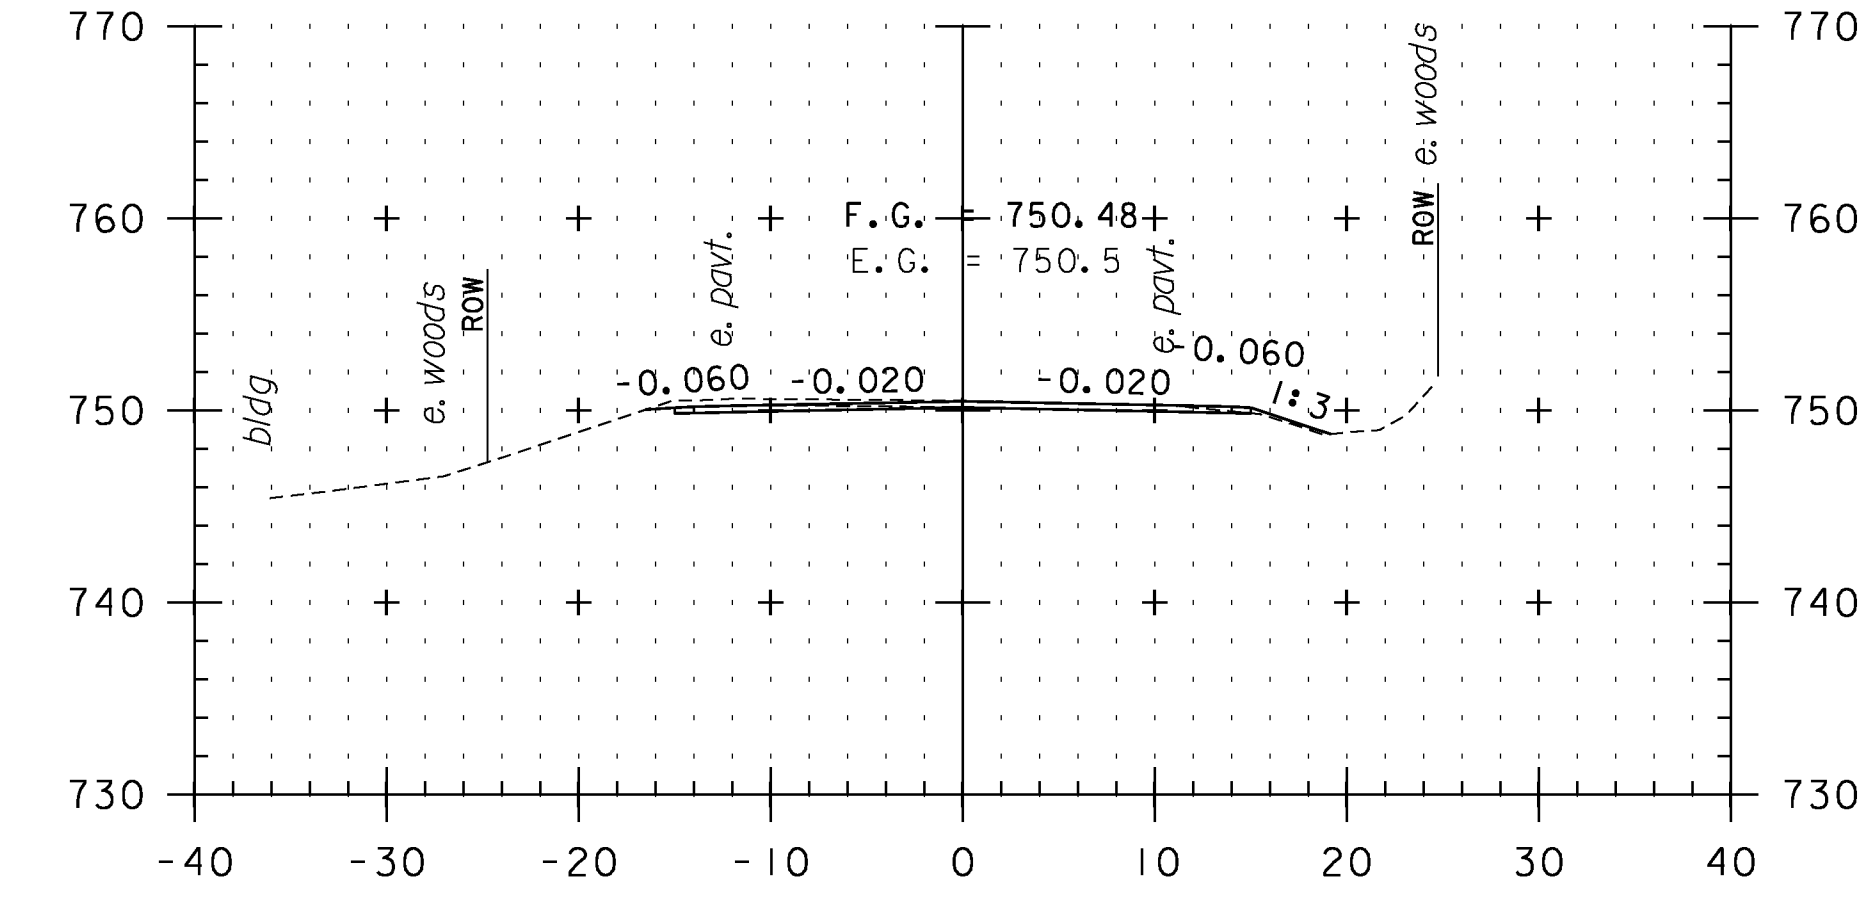


F53+00

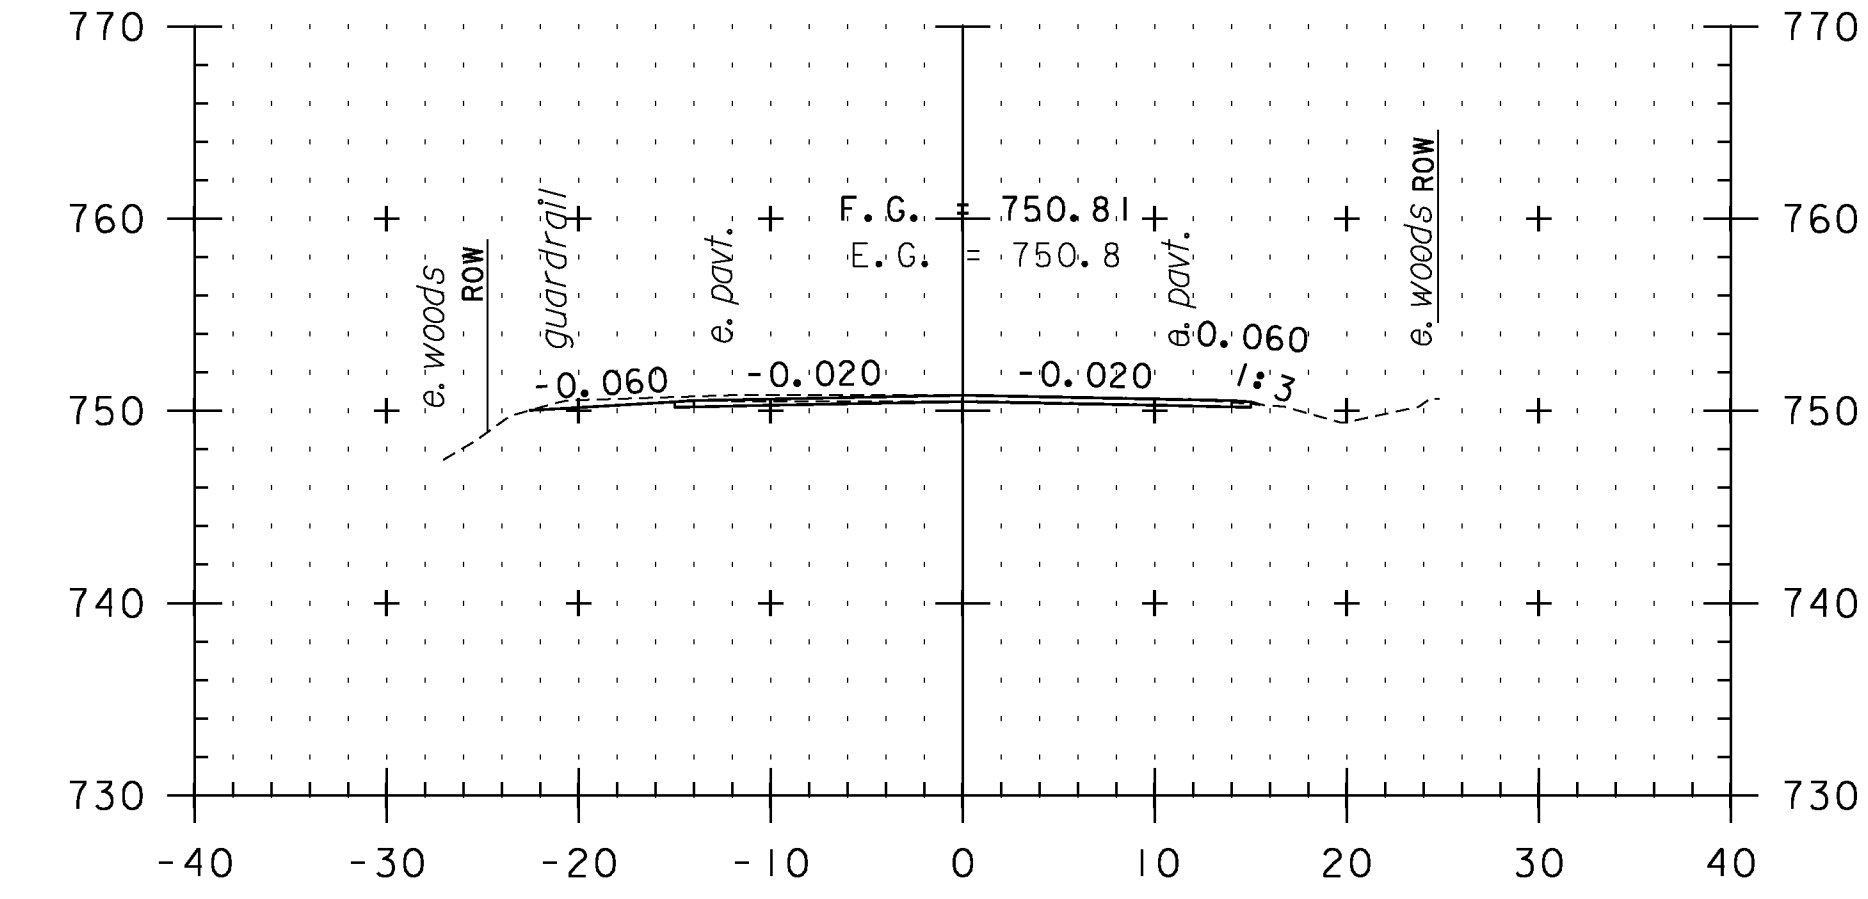

F52+50

CROSS SECTION SHEET 64

STA. F49+50 TO STA. F53+50

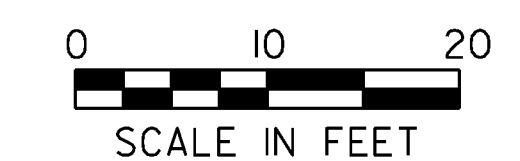

PROJECT NAME: VERSHIRE-THETFORD	
PROJECT NUMBER: STP 2911(I)	
FILE NAME: pl0c224.dgn	PLOT DATE: 1/29/2013
PROJECT LEADER: PTS	DRAWN BY: SNG
DESIGNED BY: NLL	CHECKED BY: PTS
IPARM FILE NAME: IOC224_I72	SHEET 172 OF 232