




F55+00

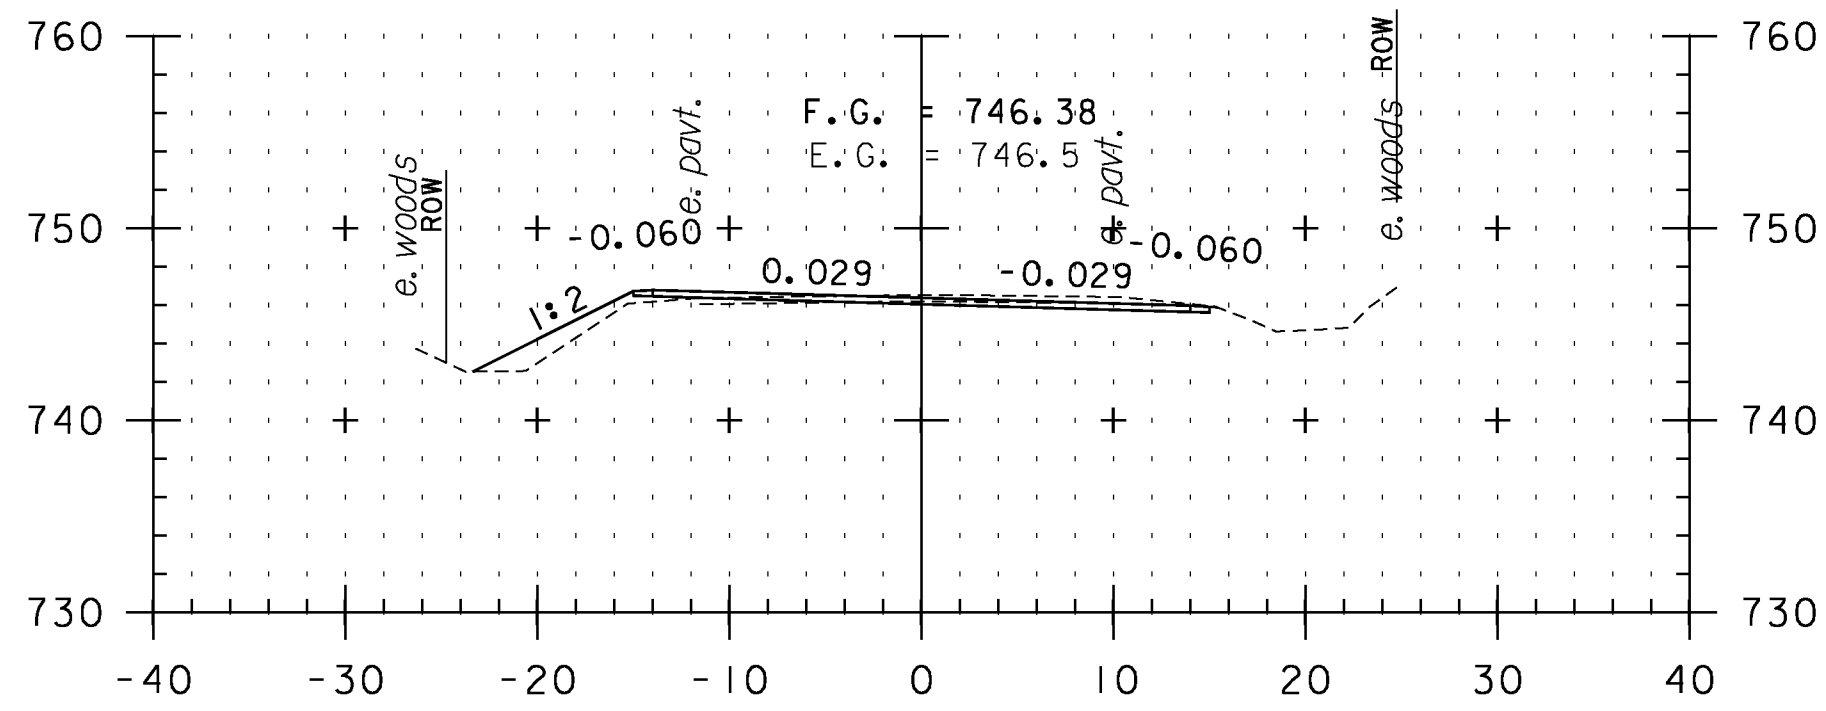


F56+50

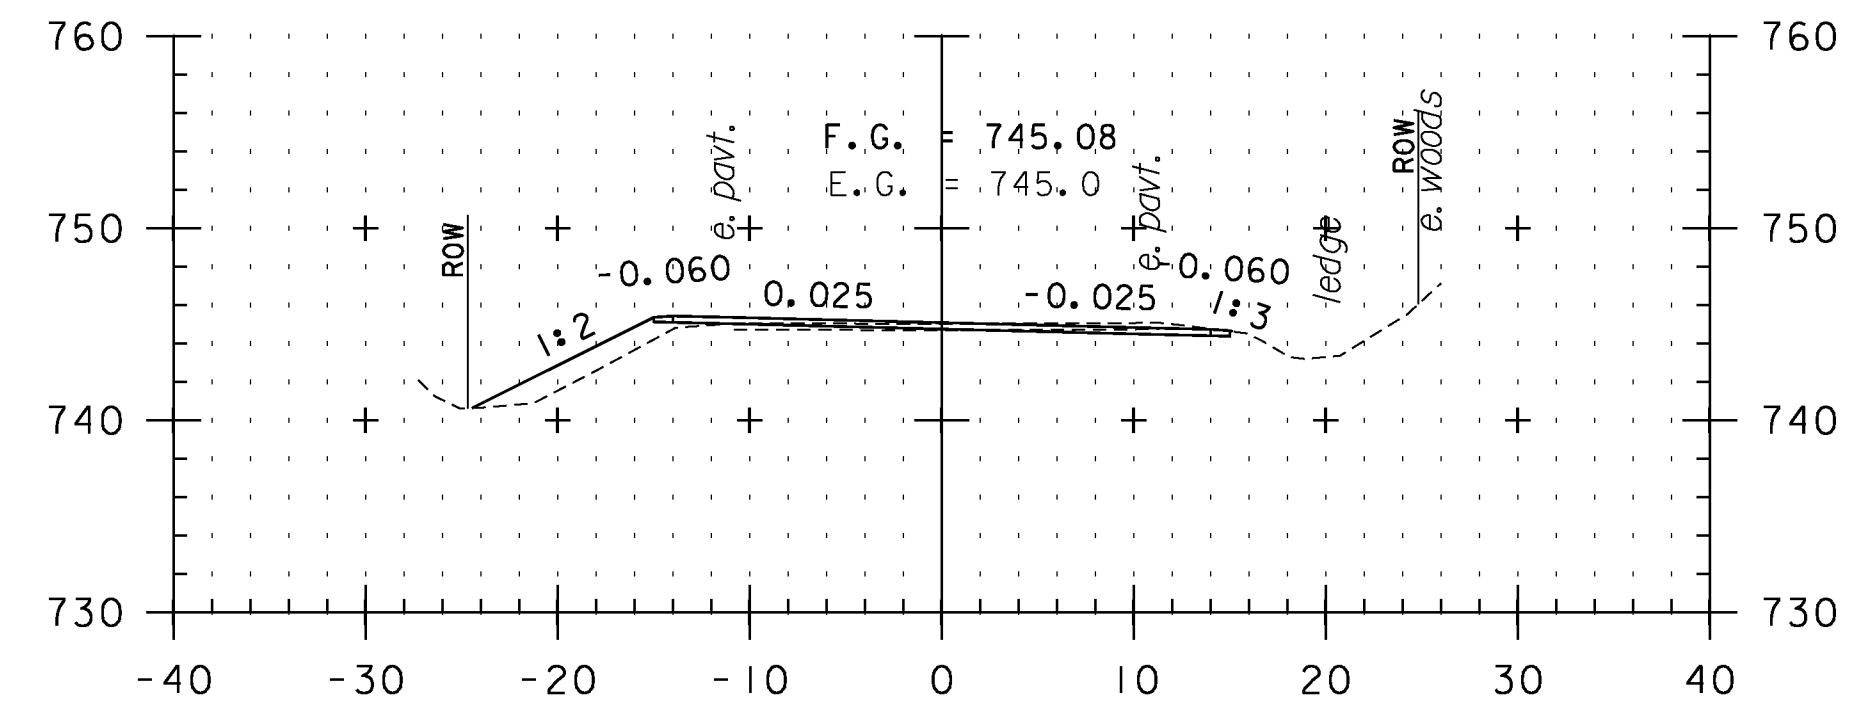


F58+00

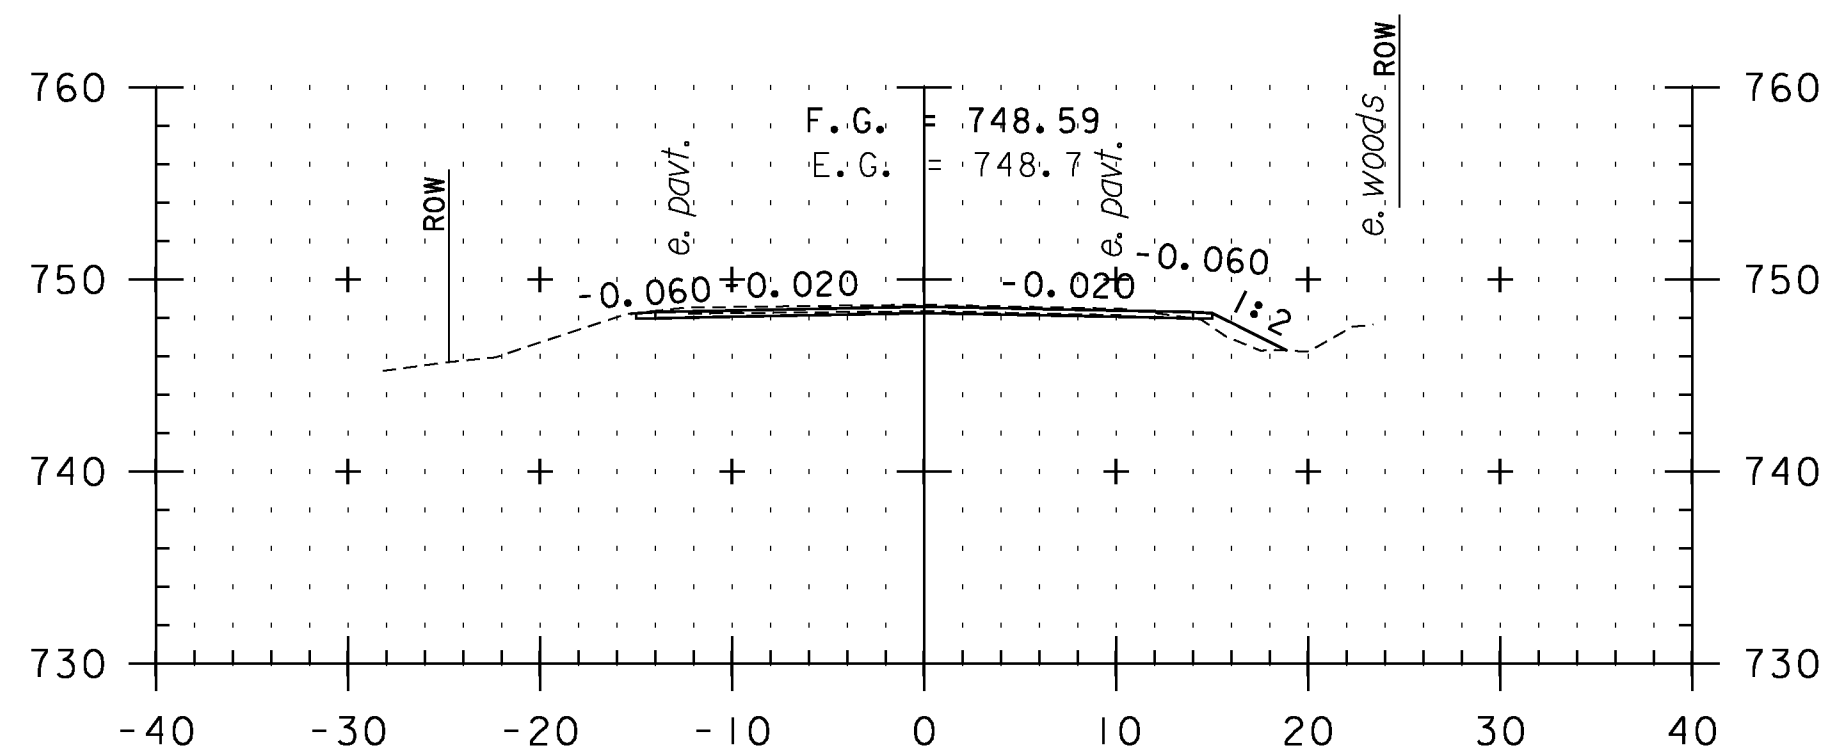


F54+50

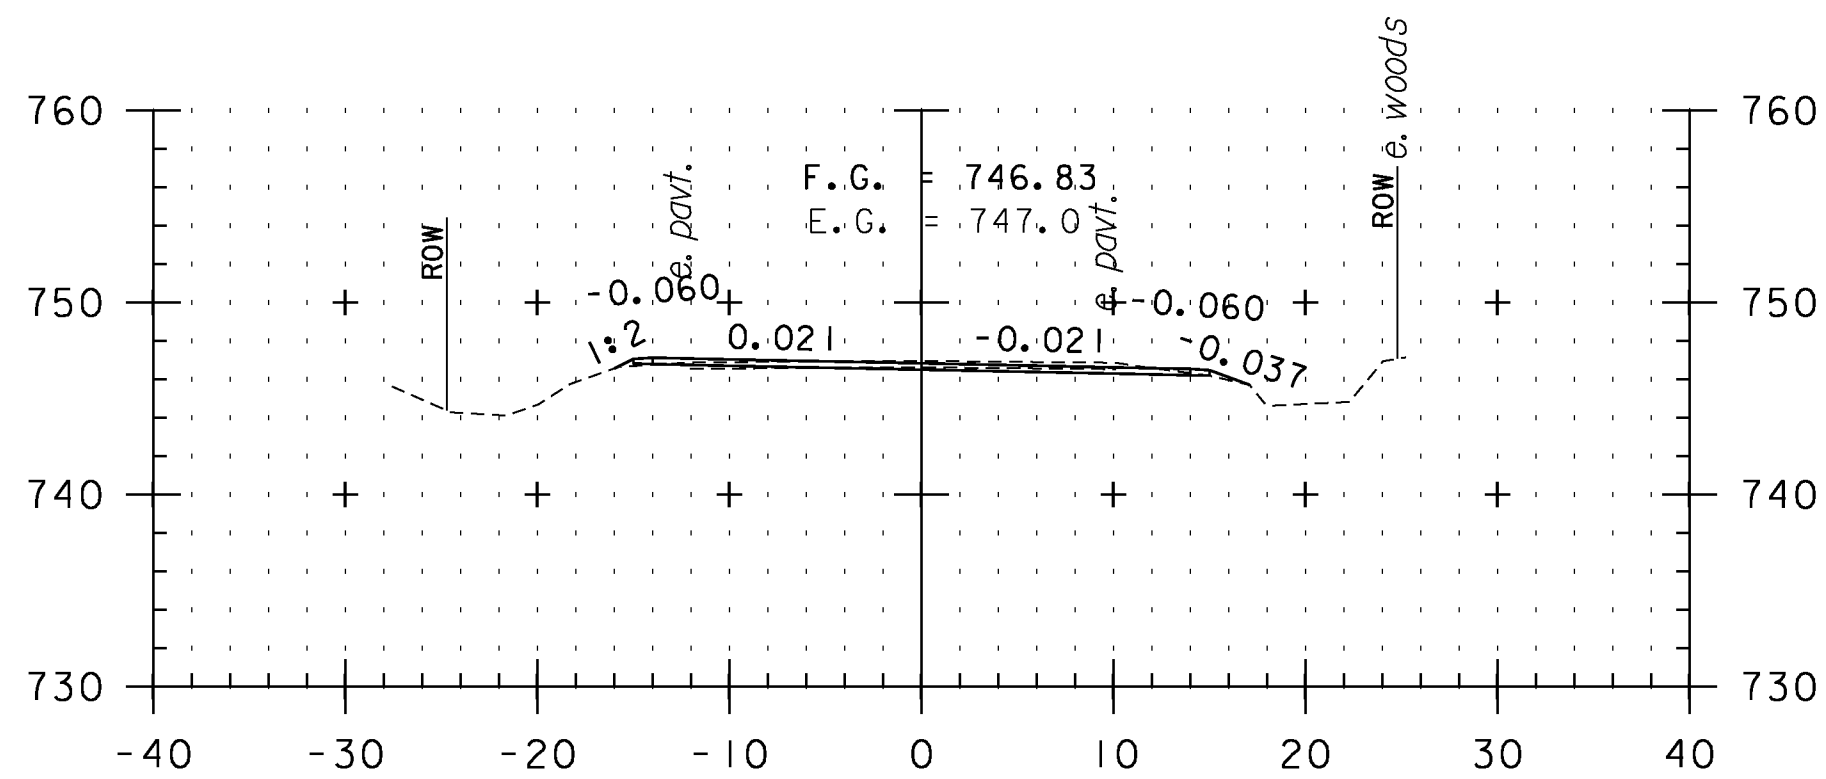


F56+00

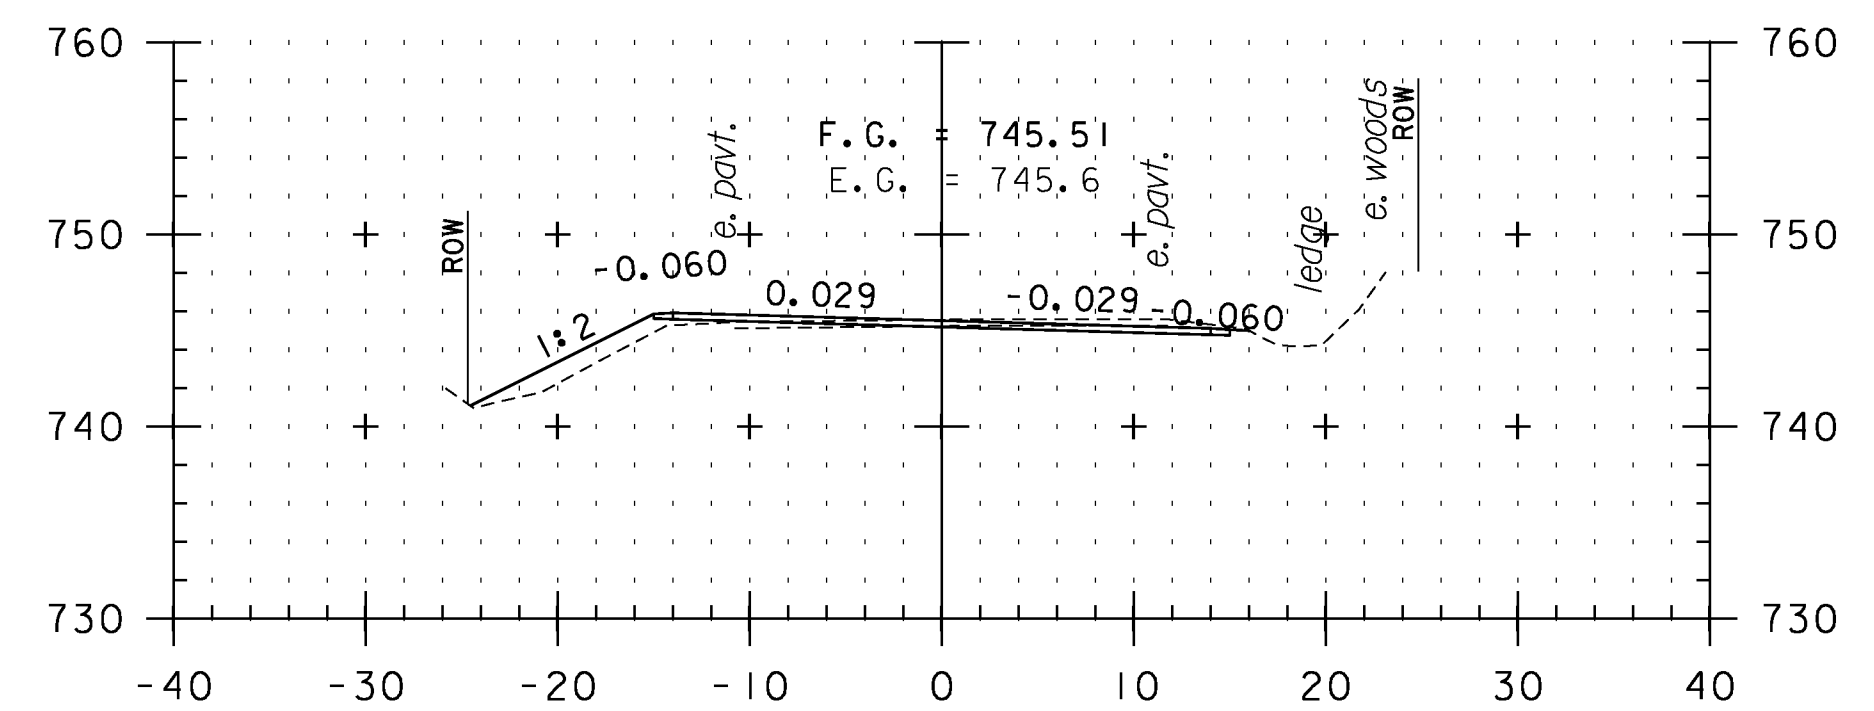


F57+50

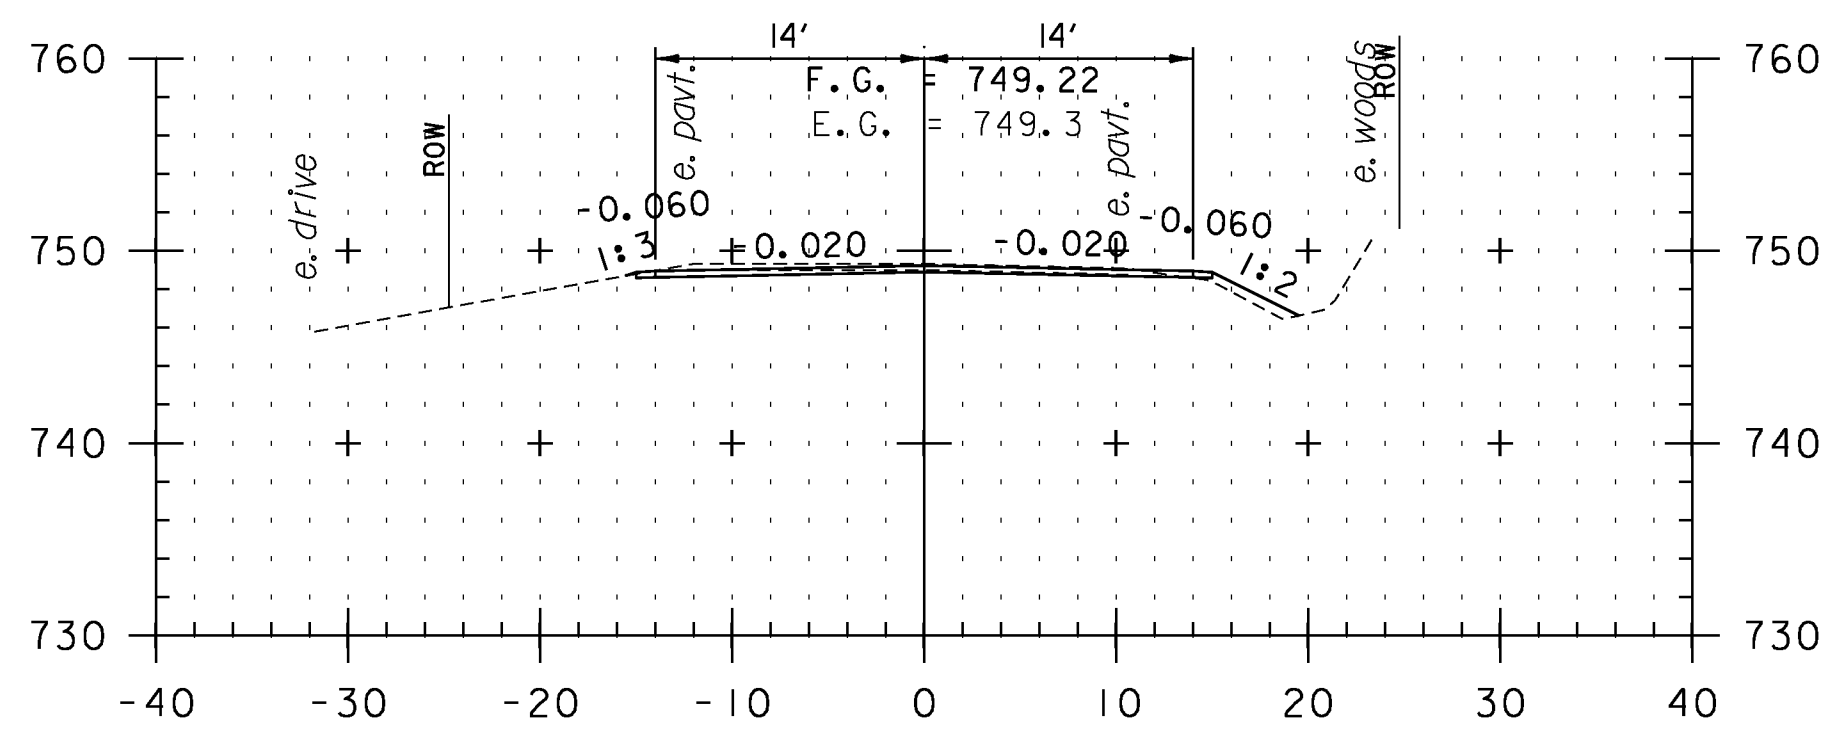

F54+00

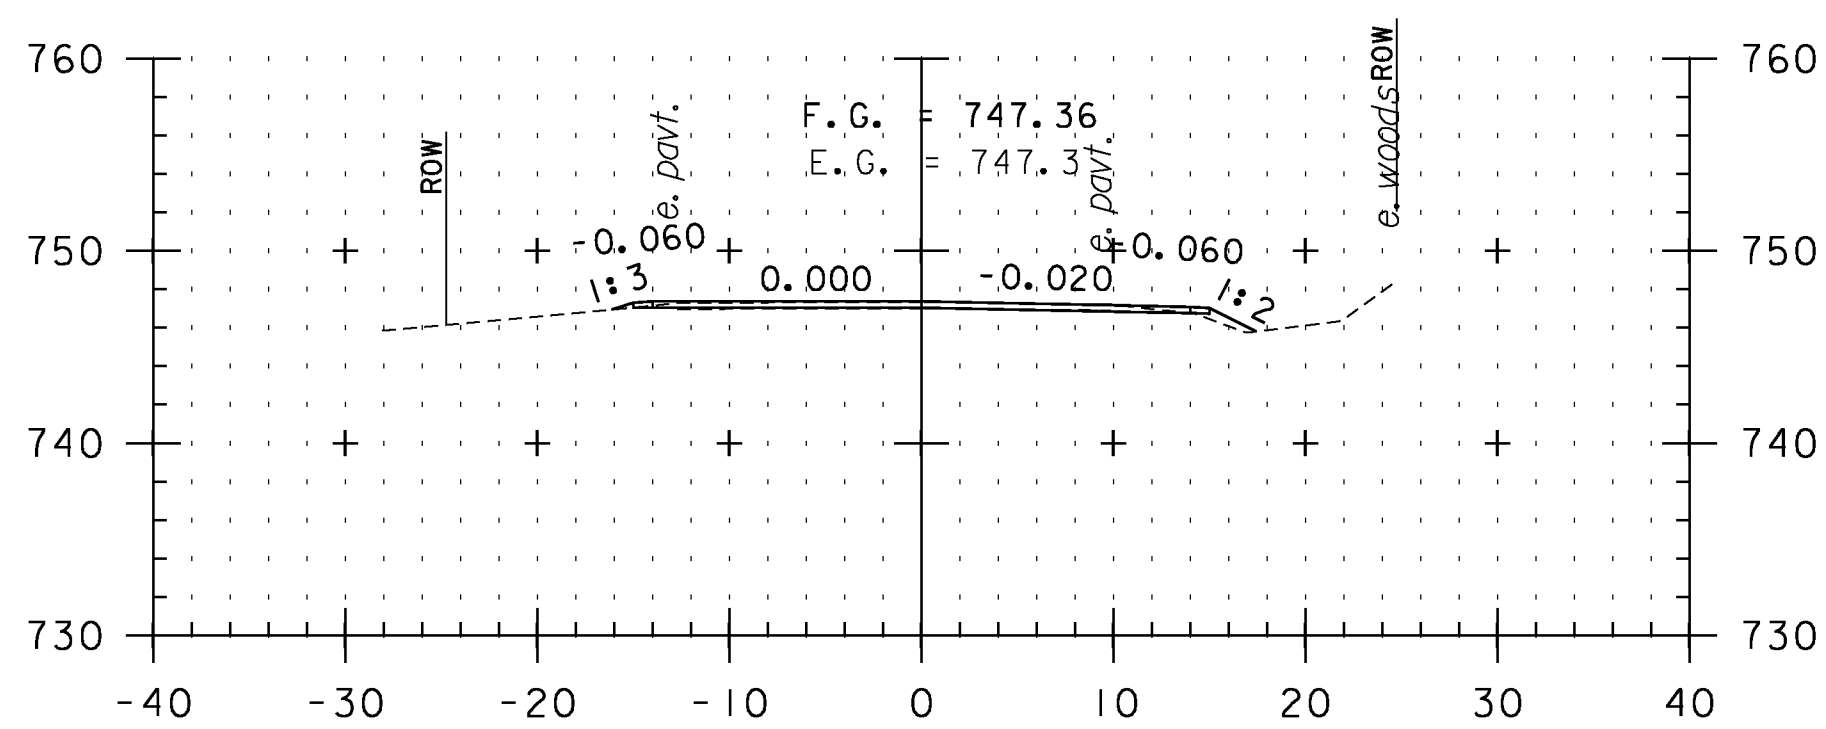

F55+50

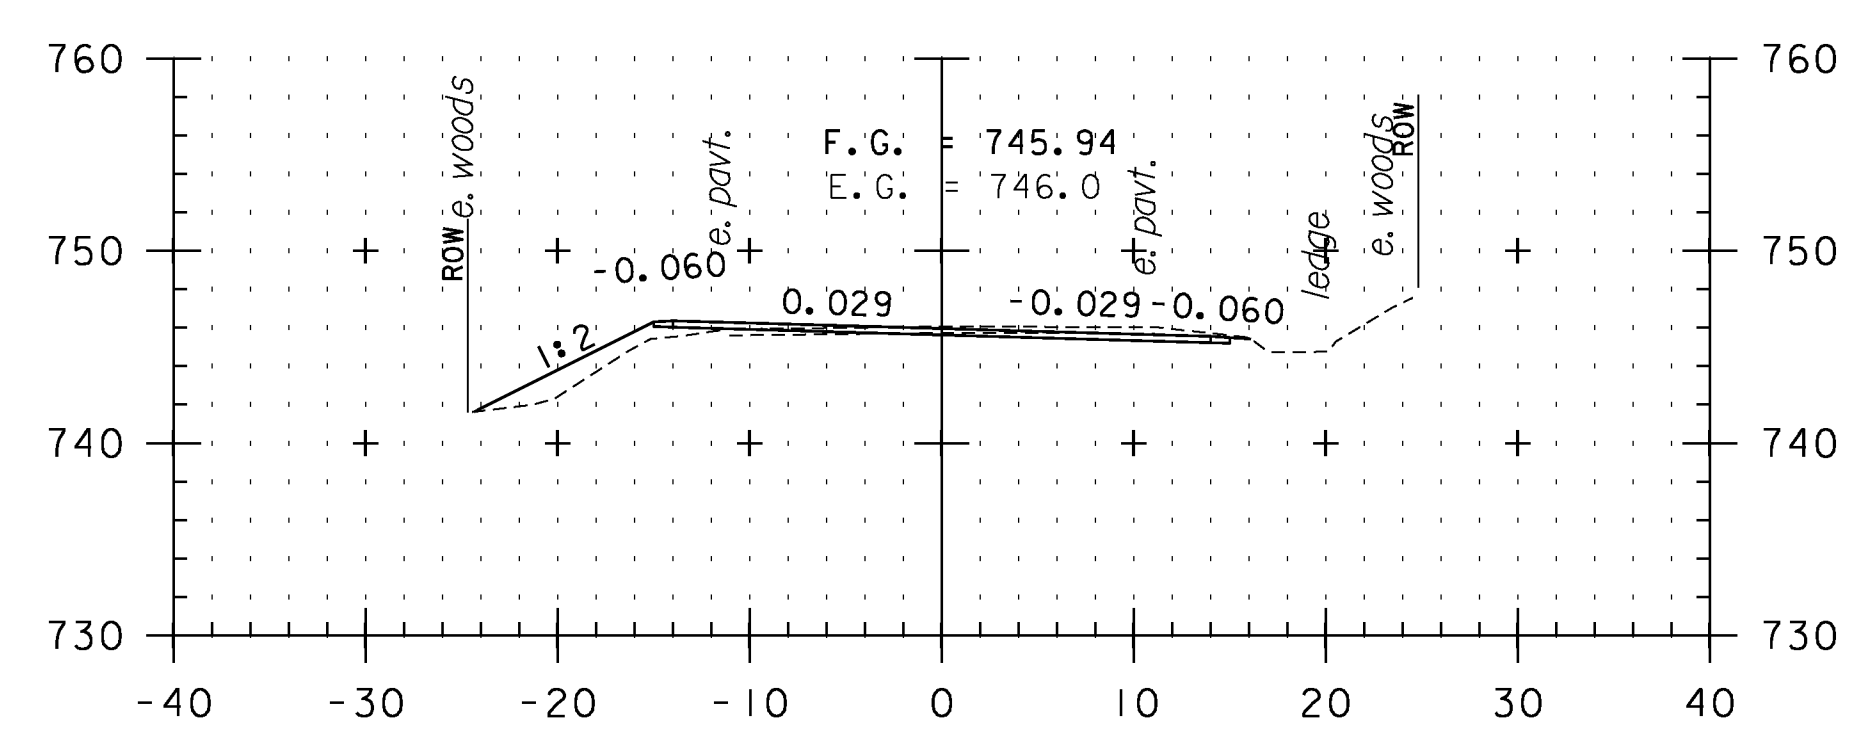

F57+00

CROSS SECTION SHEET 65

PROJECT NAME: VERSHIRE-THETFORD
 PROJECT NUMBER: STP 2911(I)
 FILE NAME: pl0c224.dgn
 PROJECT LEADER: PTS
 DESIGNED BY: NLL
 IPARM FILE NAME: IOC224_173
 PLOT DATE: 1/29/2013
 DRAWN BY: SNG
 CHECKED BY: PTS
 SHEET 173 OF 232

STA. F54+00 TO STA. F58+00

