




F59+50

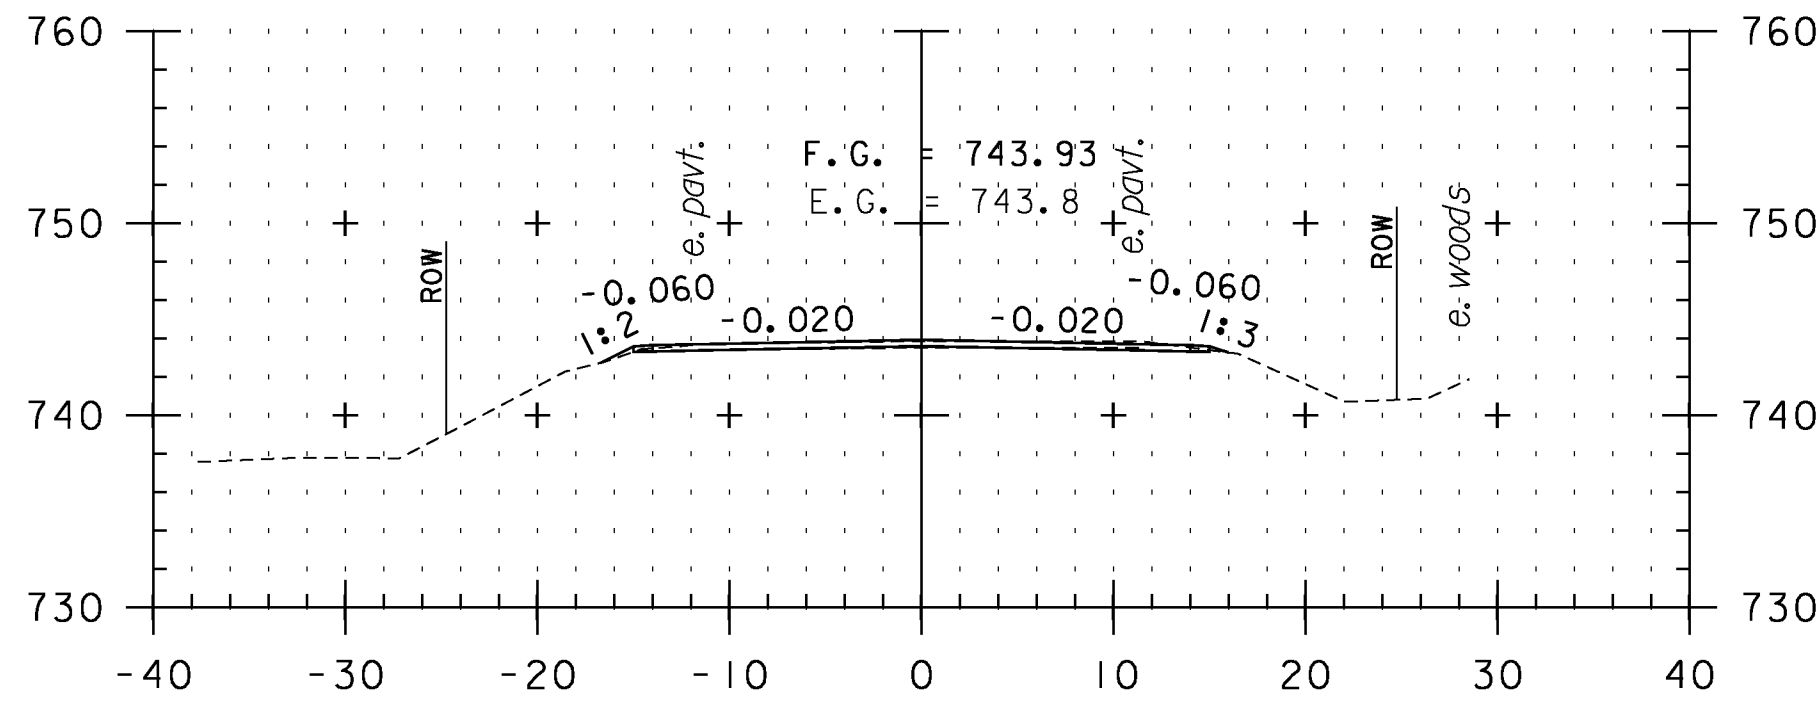


F61+00

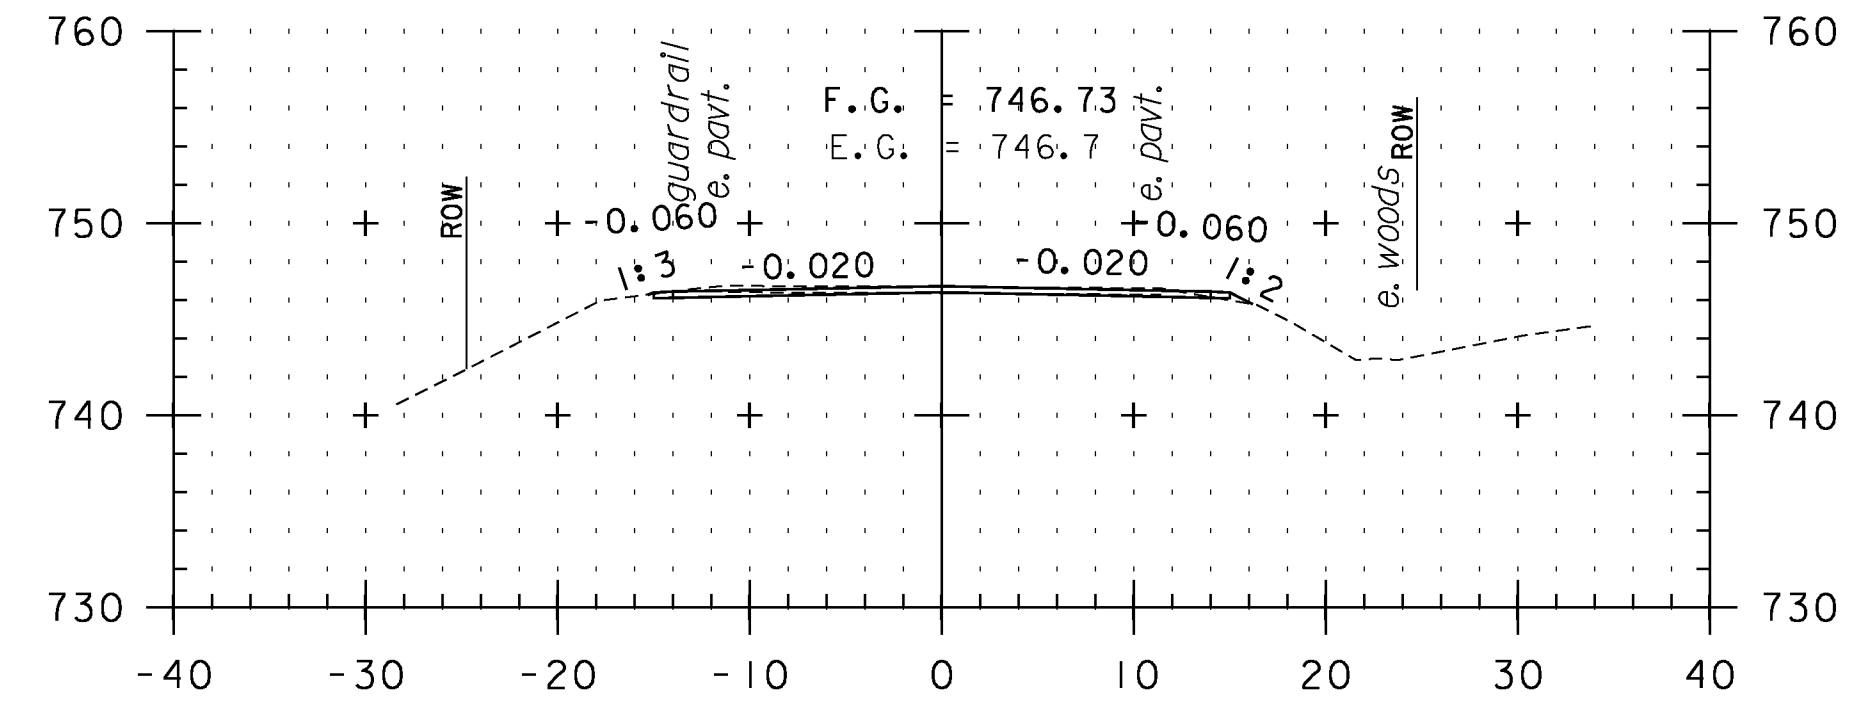


F62+50

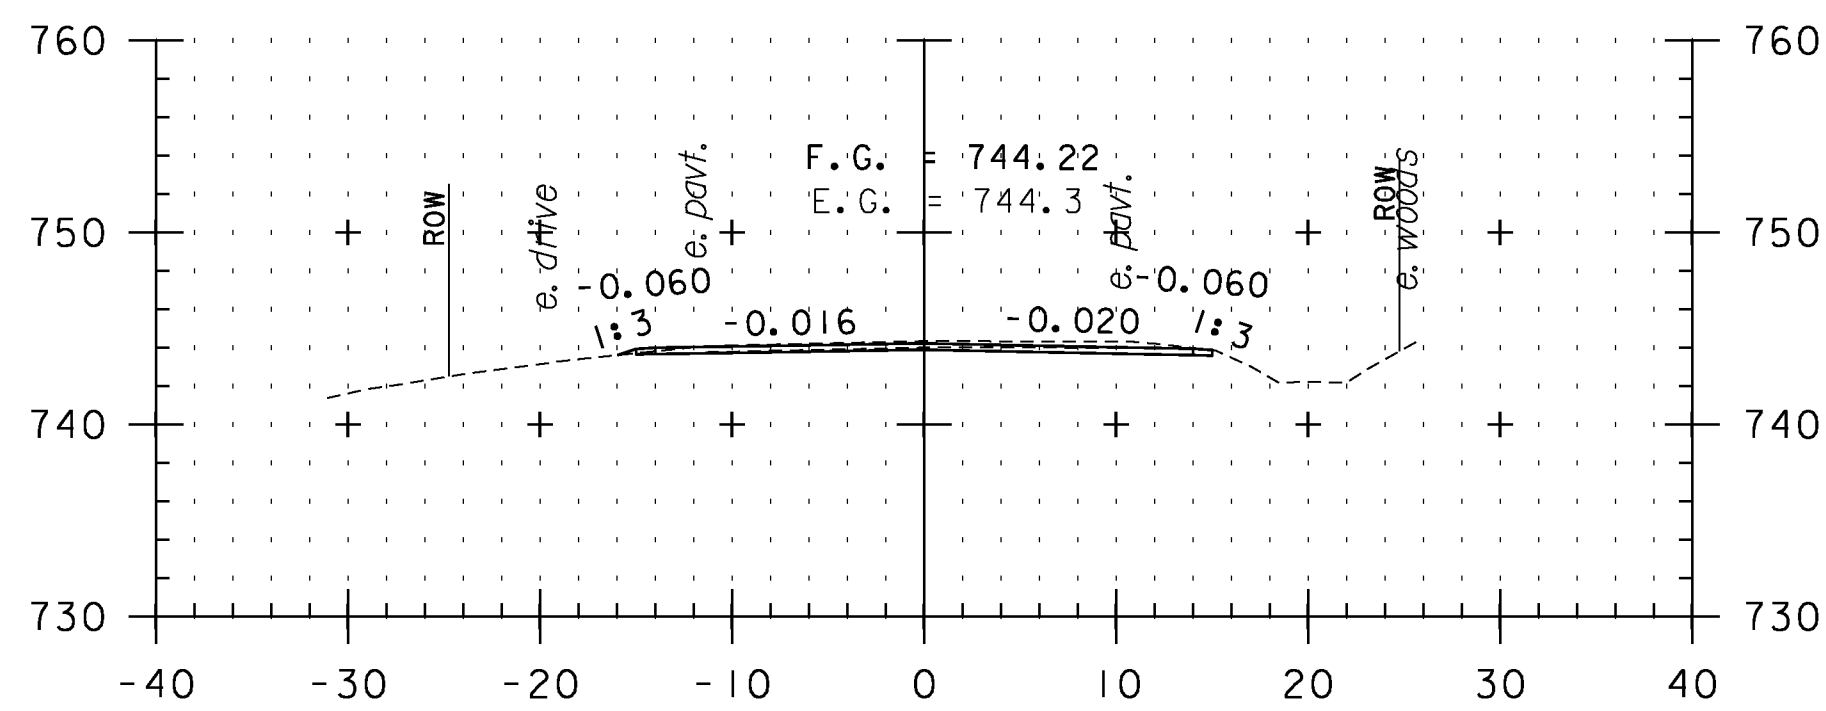


F59+00

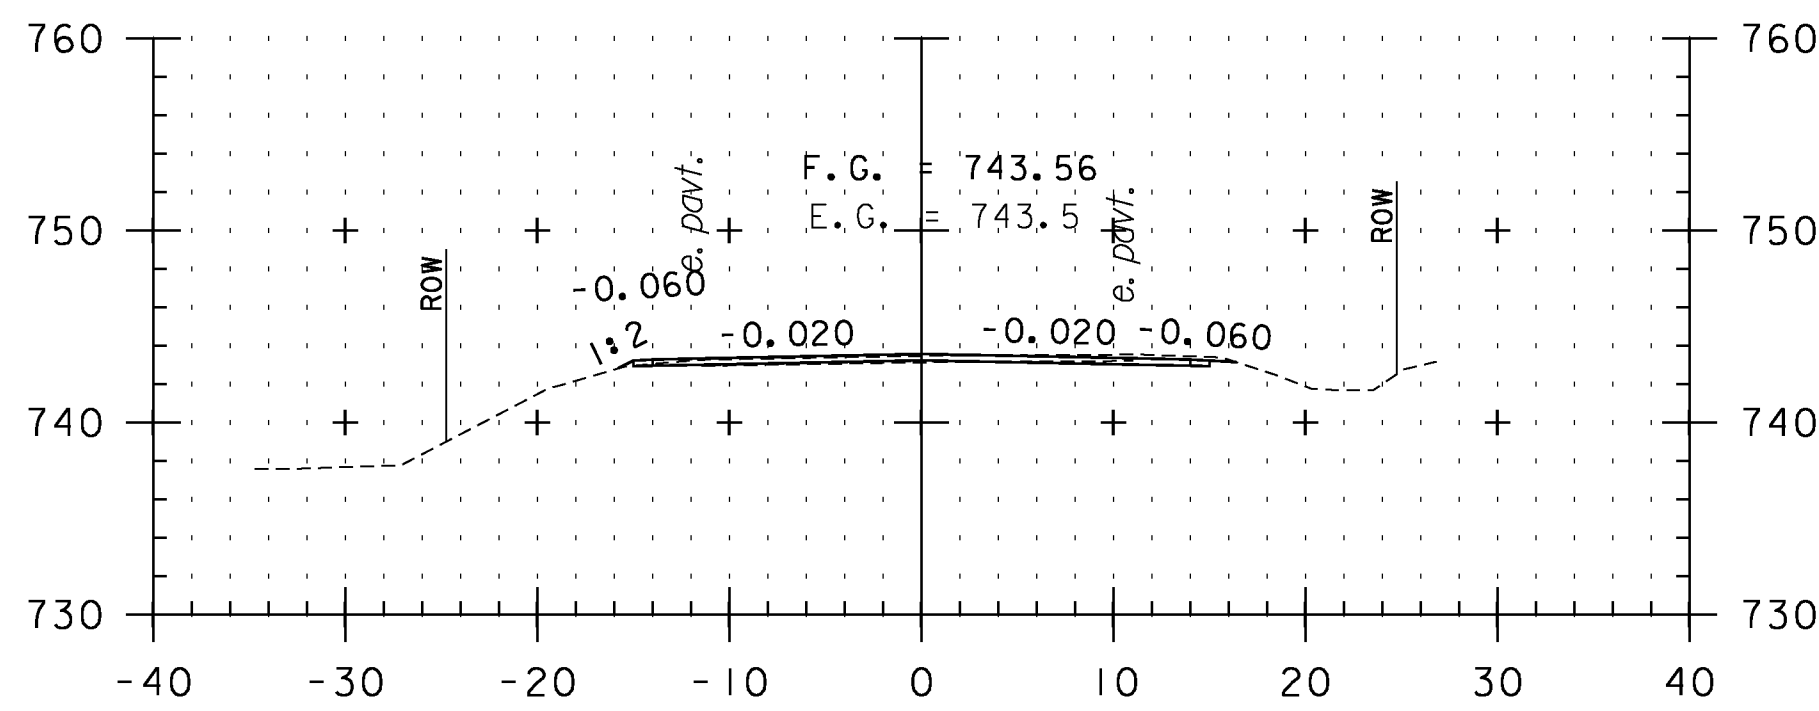


F60+50

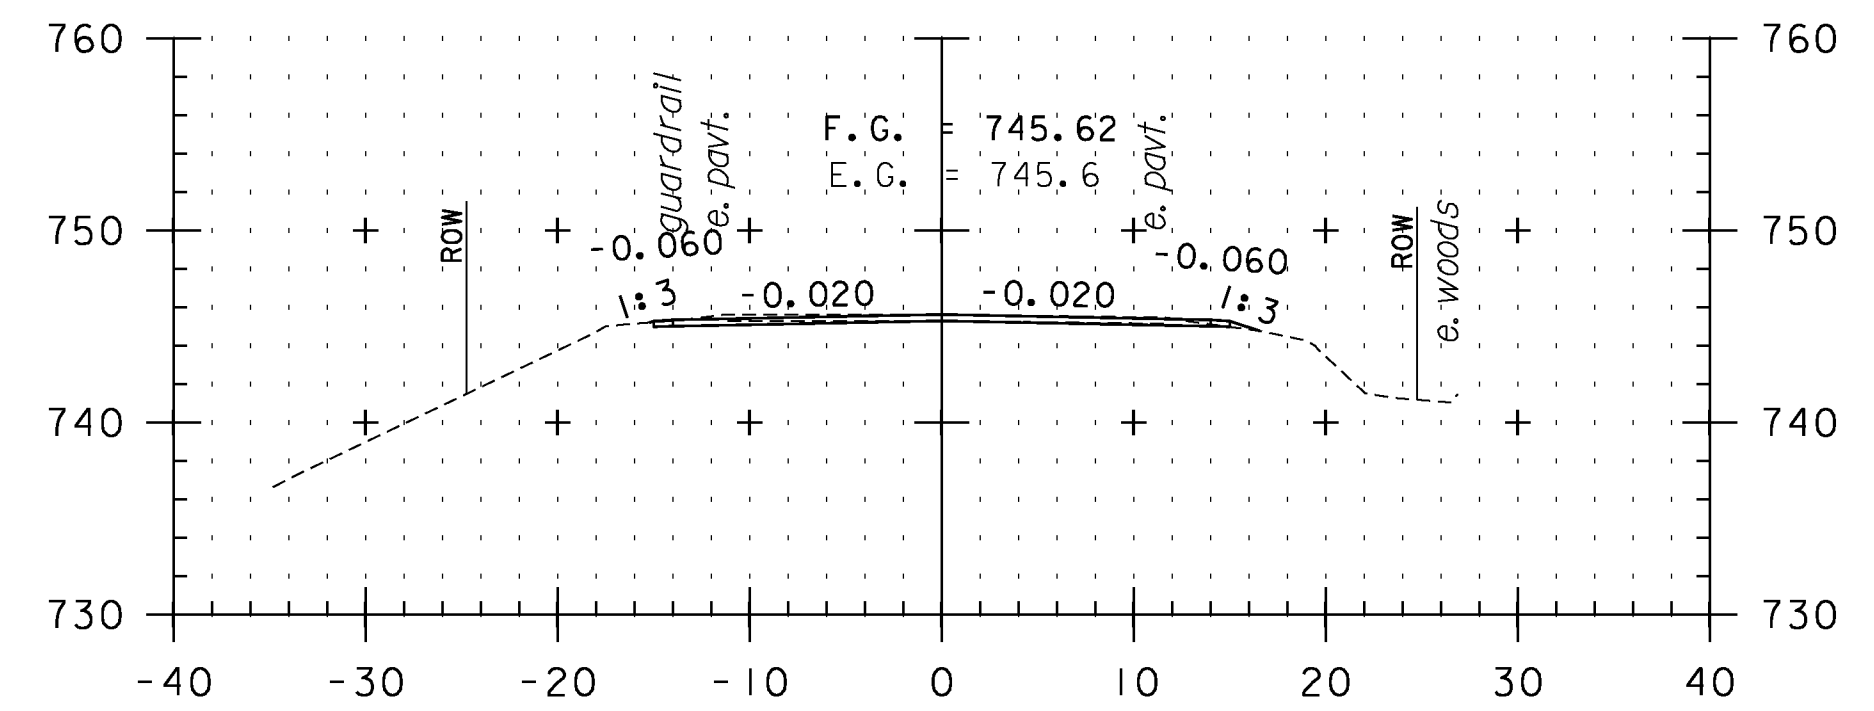


F62+00

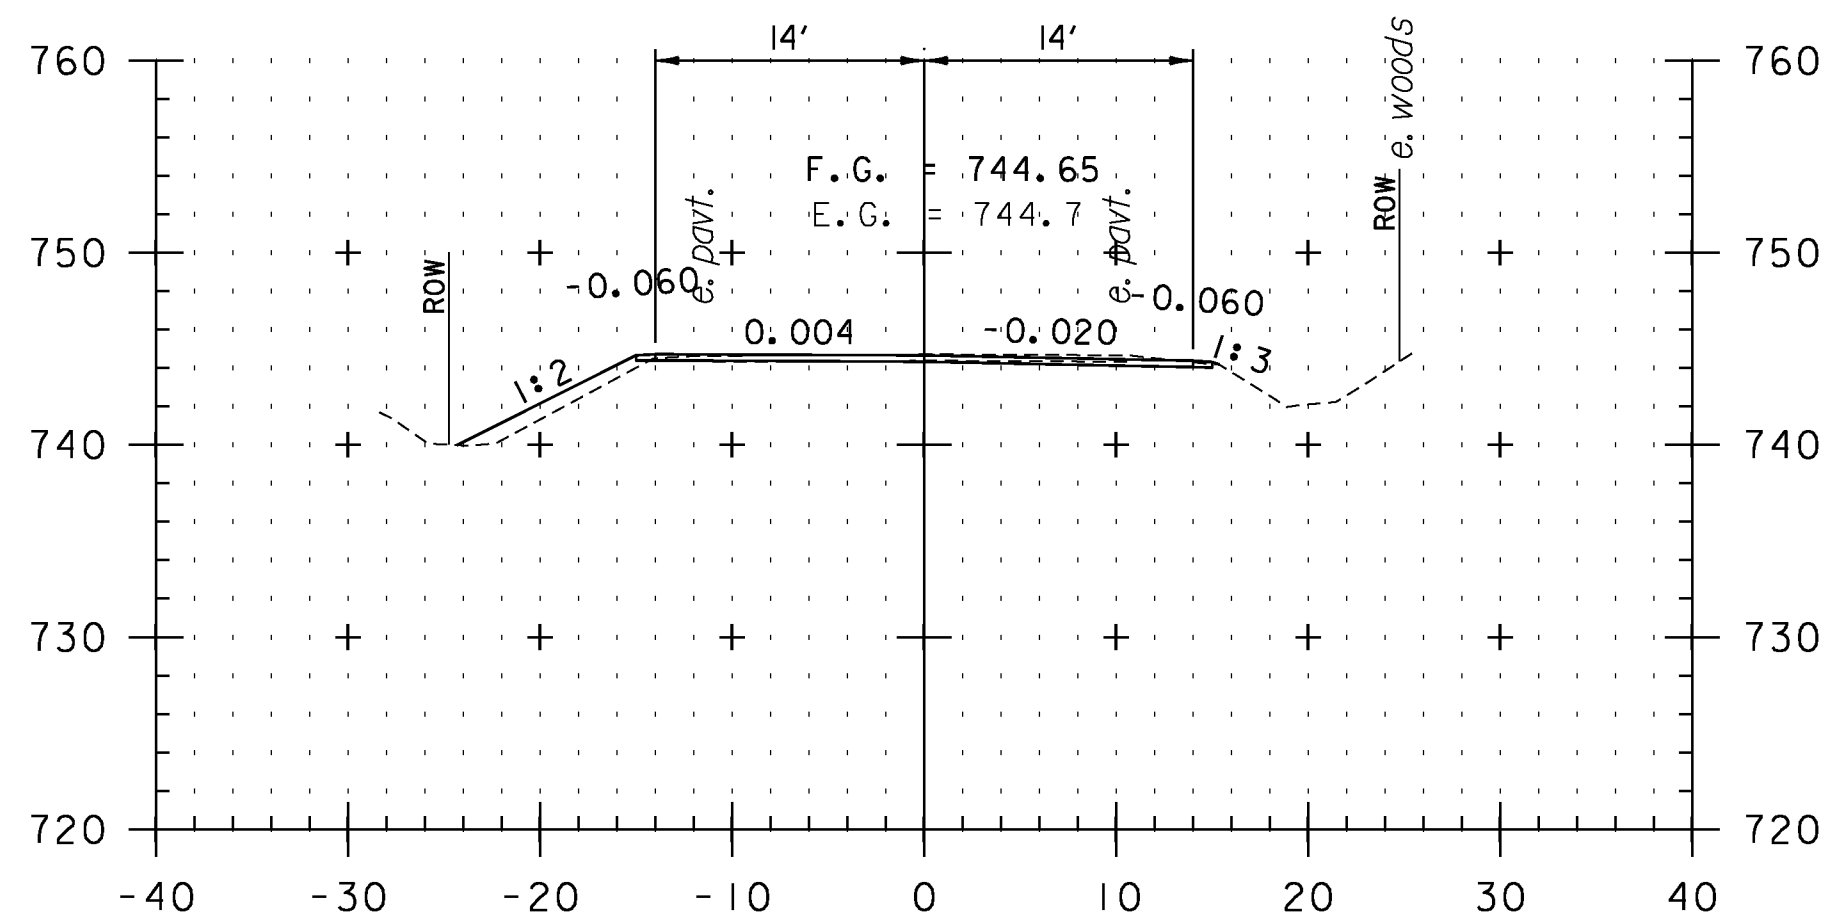

F58+50

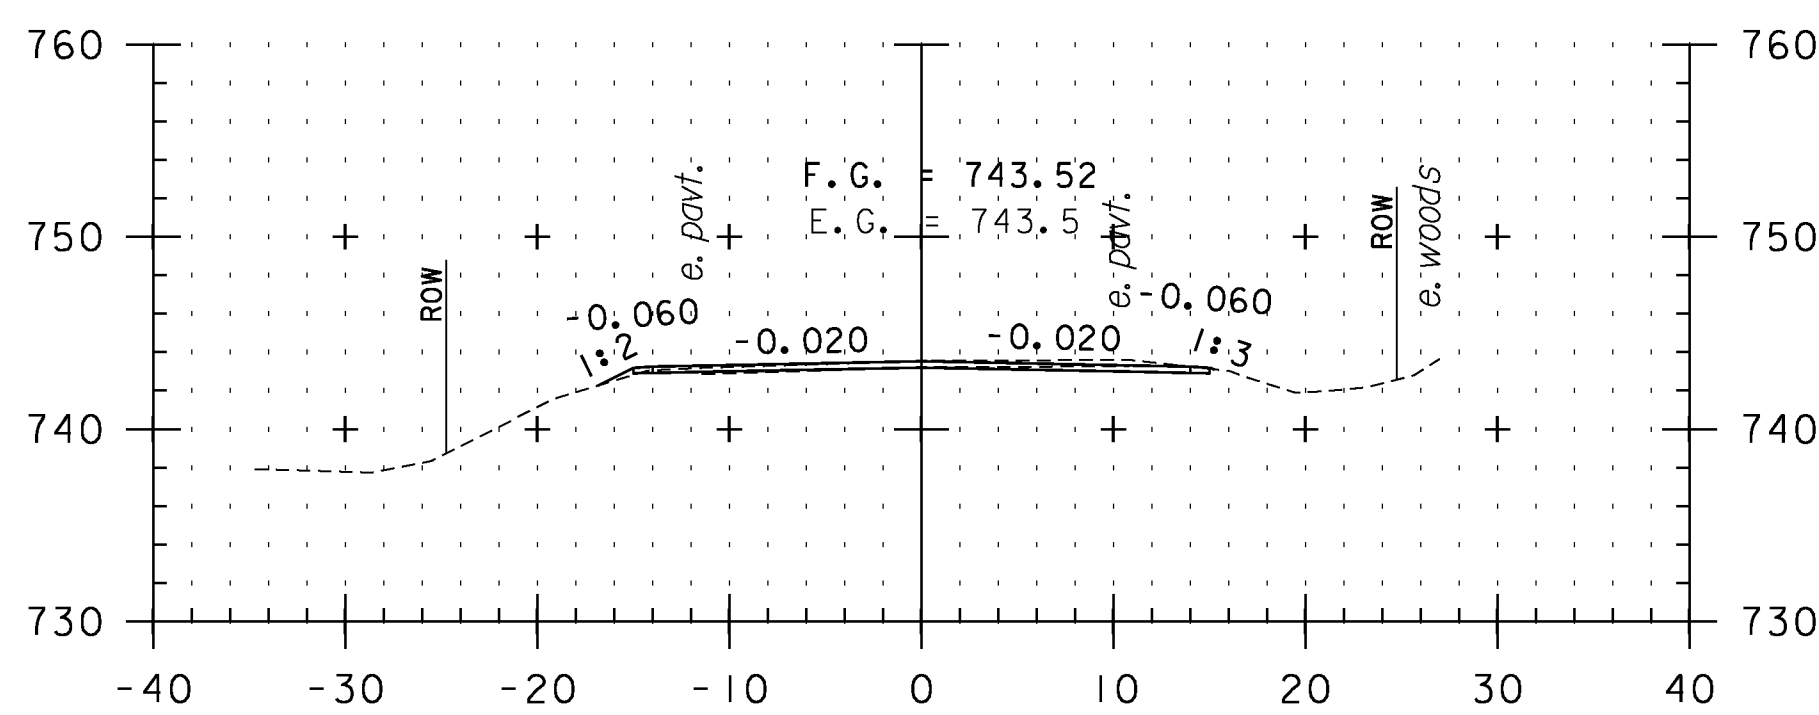


F60+00

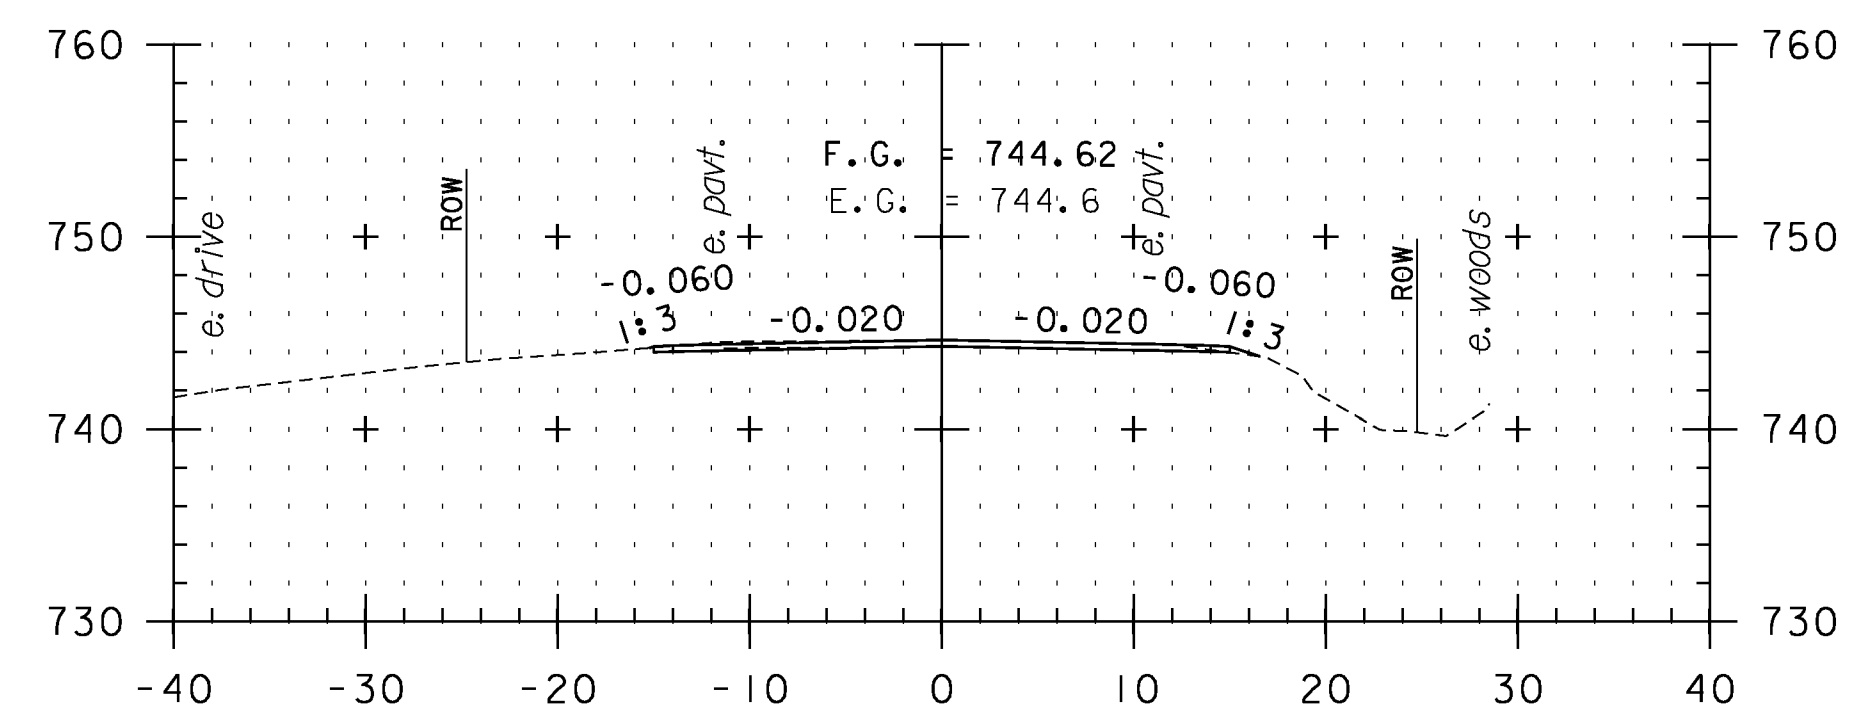

F61+50

CROSS SECTION SHEET 66

STA. F58+50 TO STA. F62+50

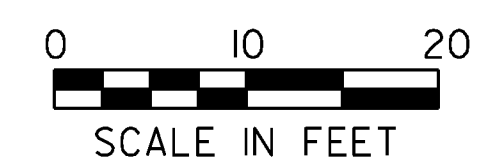

PROJECT NAME: VERSHIRE-THETFORD	PLOT DATE: 1/29/2013
PROJECT NUMBER: STP 2911(I)	DRAWN BY: SNG
FILE NAME: pl0c224.dgn	CHECKED BY: PTS
PROJECT LEADER: PTS	SHEET 174 OF 232
DESIGNED BY: NLL	
IPARM FILE NAME: IOC224_174	