




F64+00

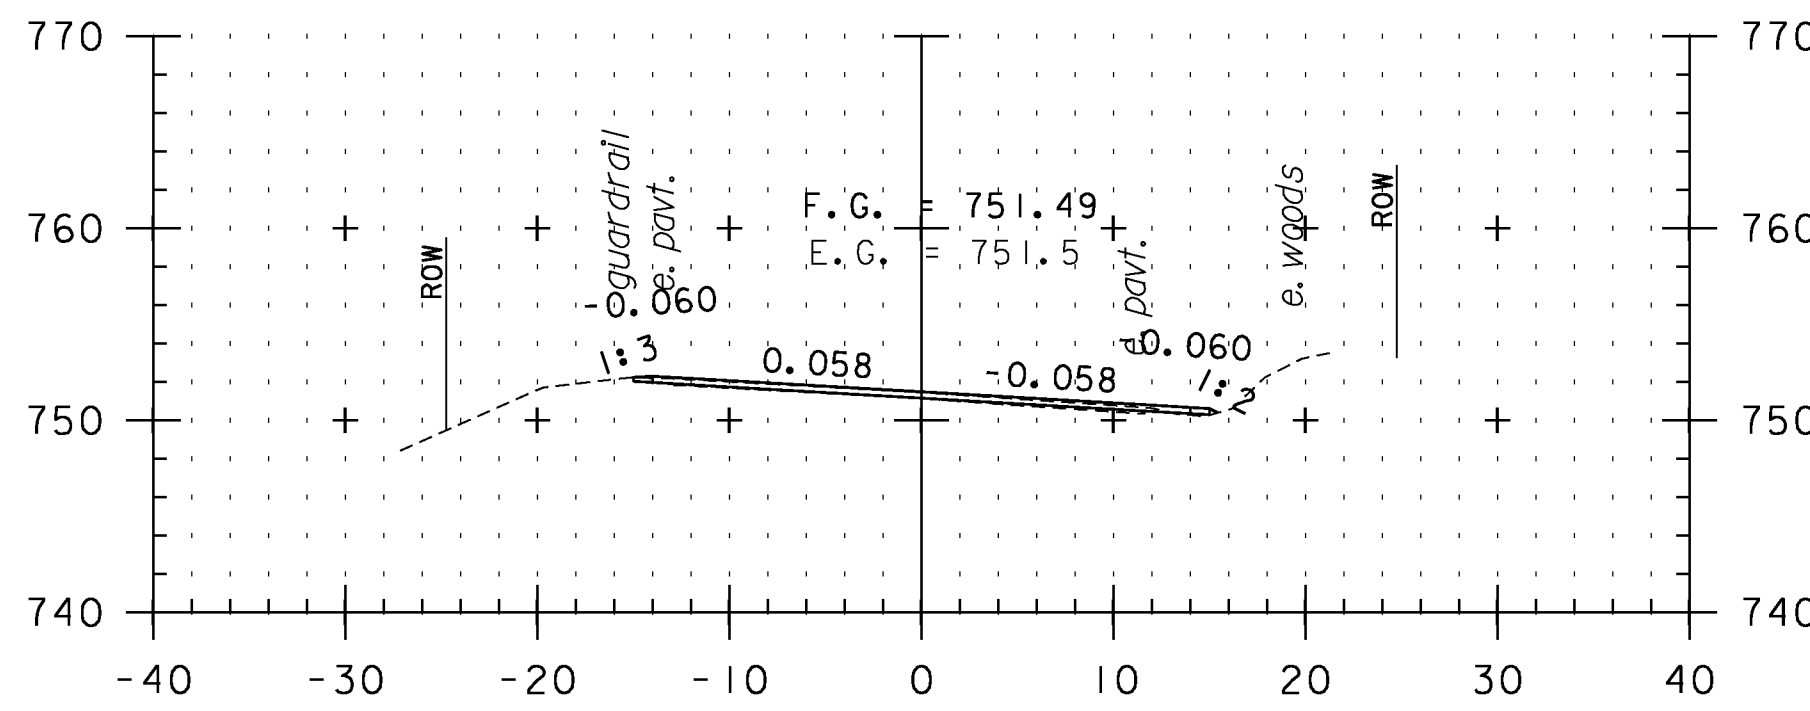


F65+50

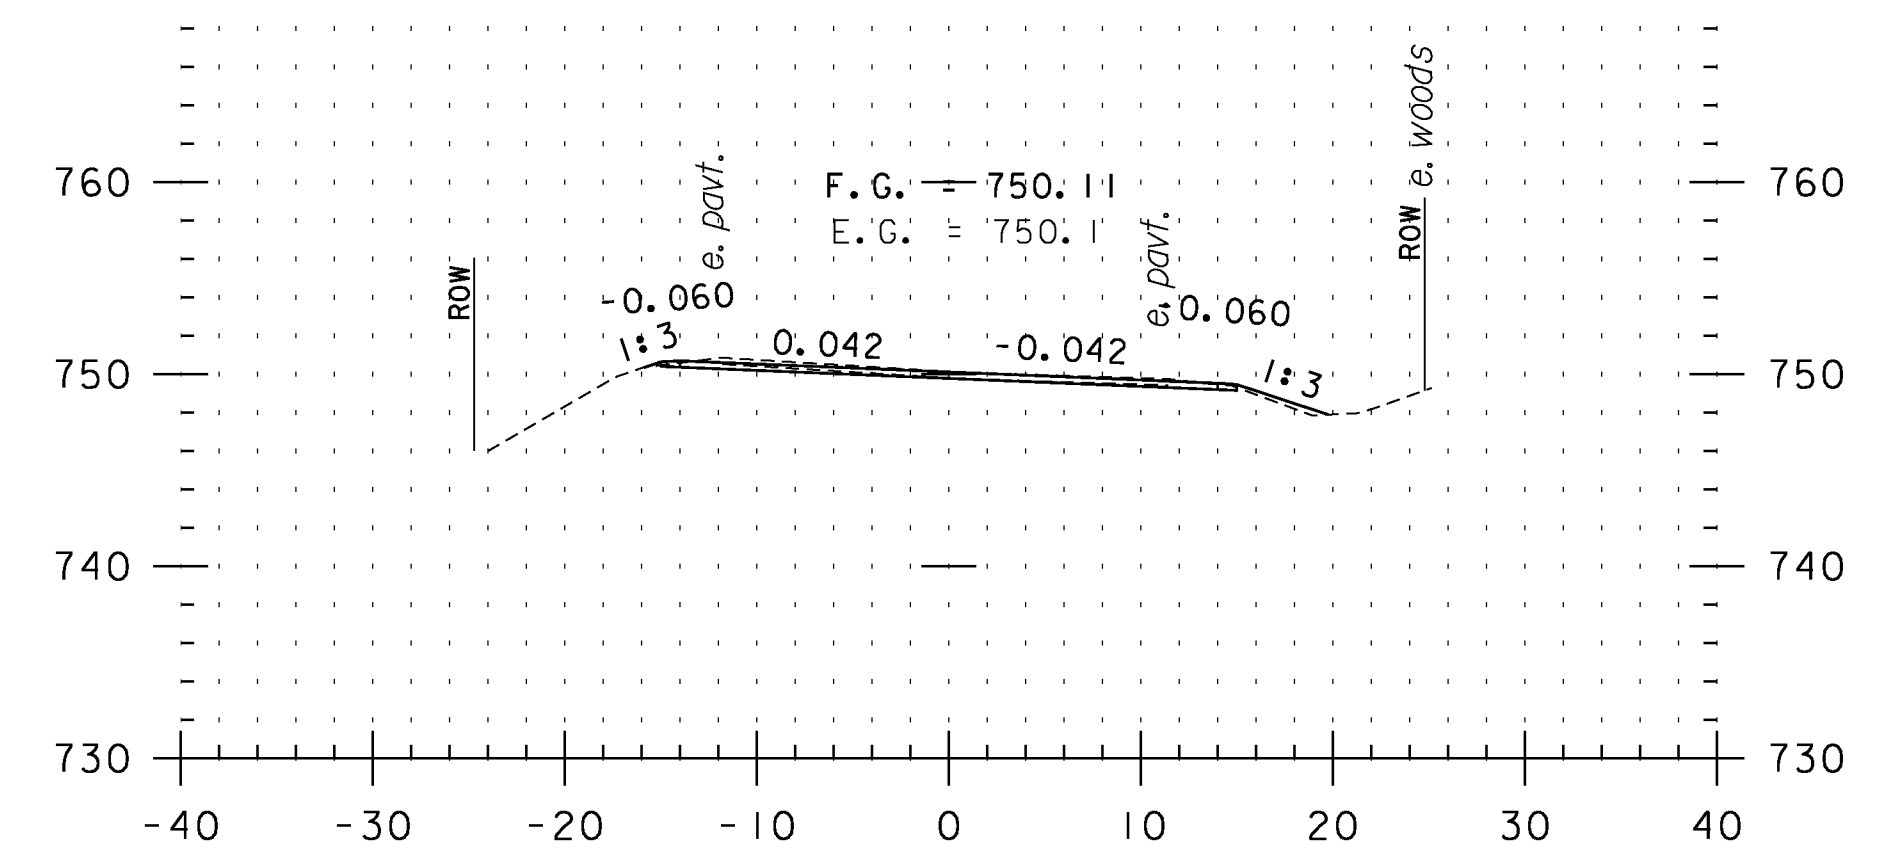


F67+00

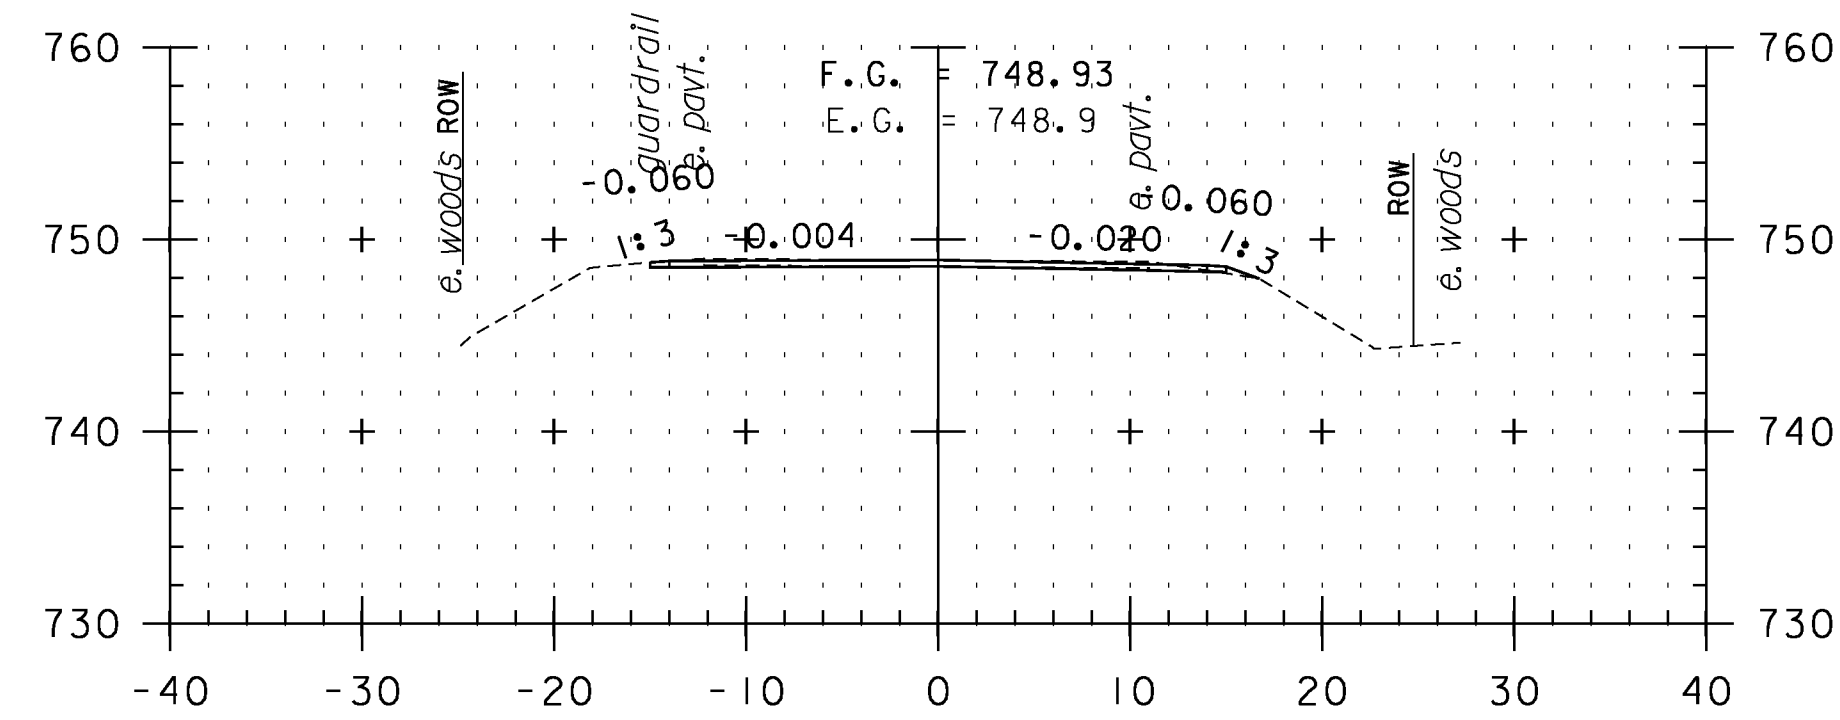


F63+50

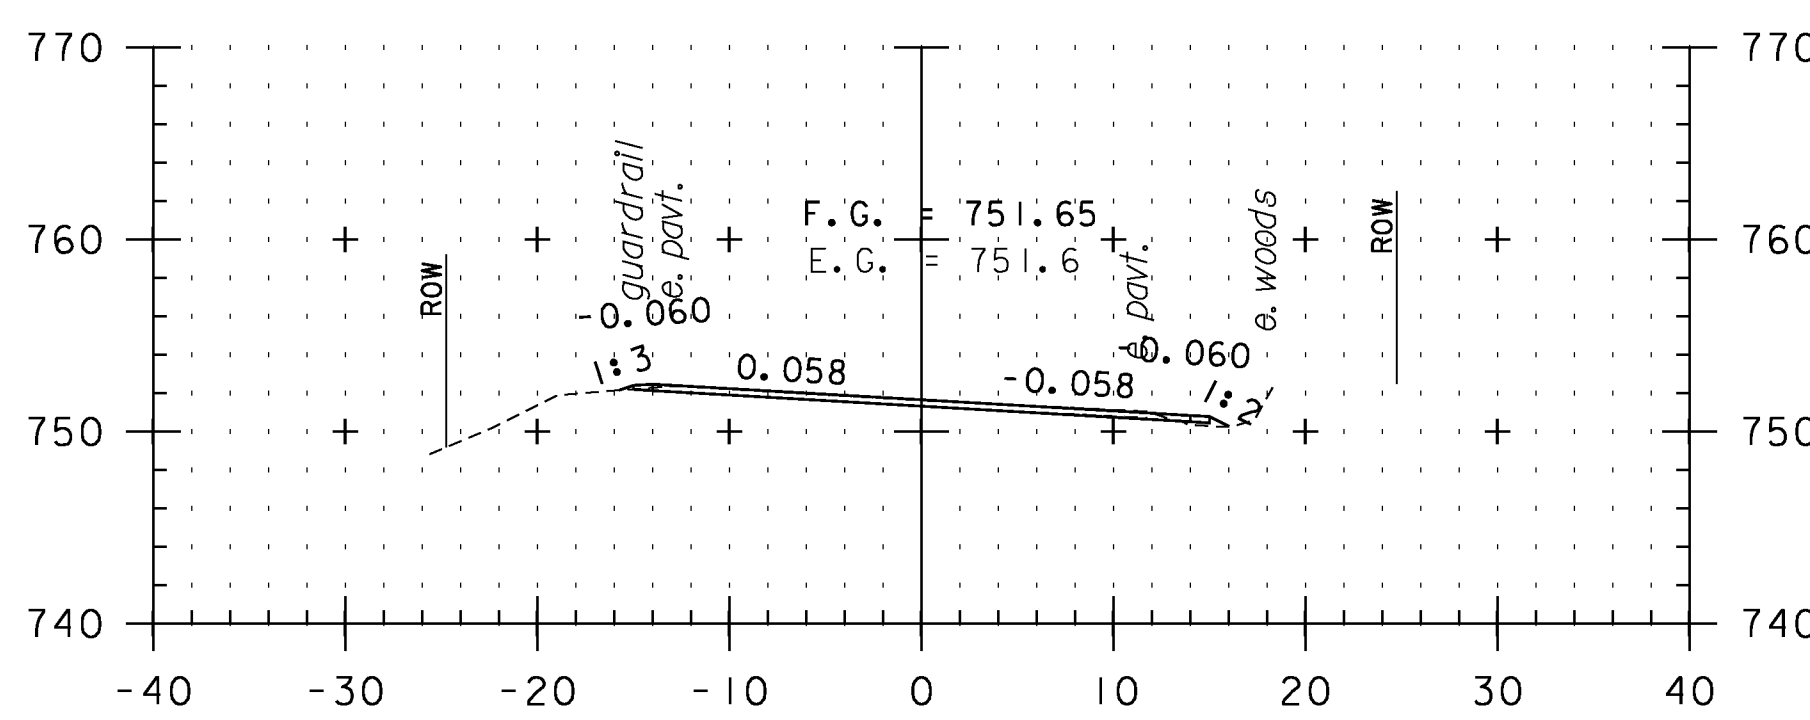


F65+00

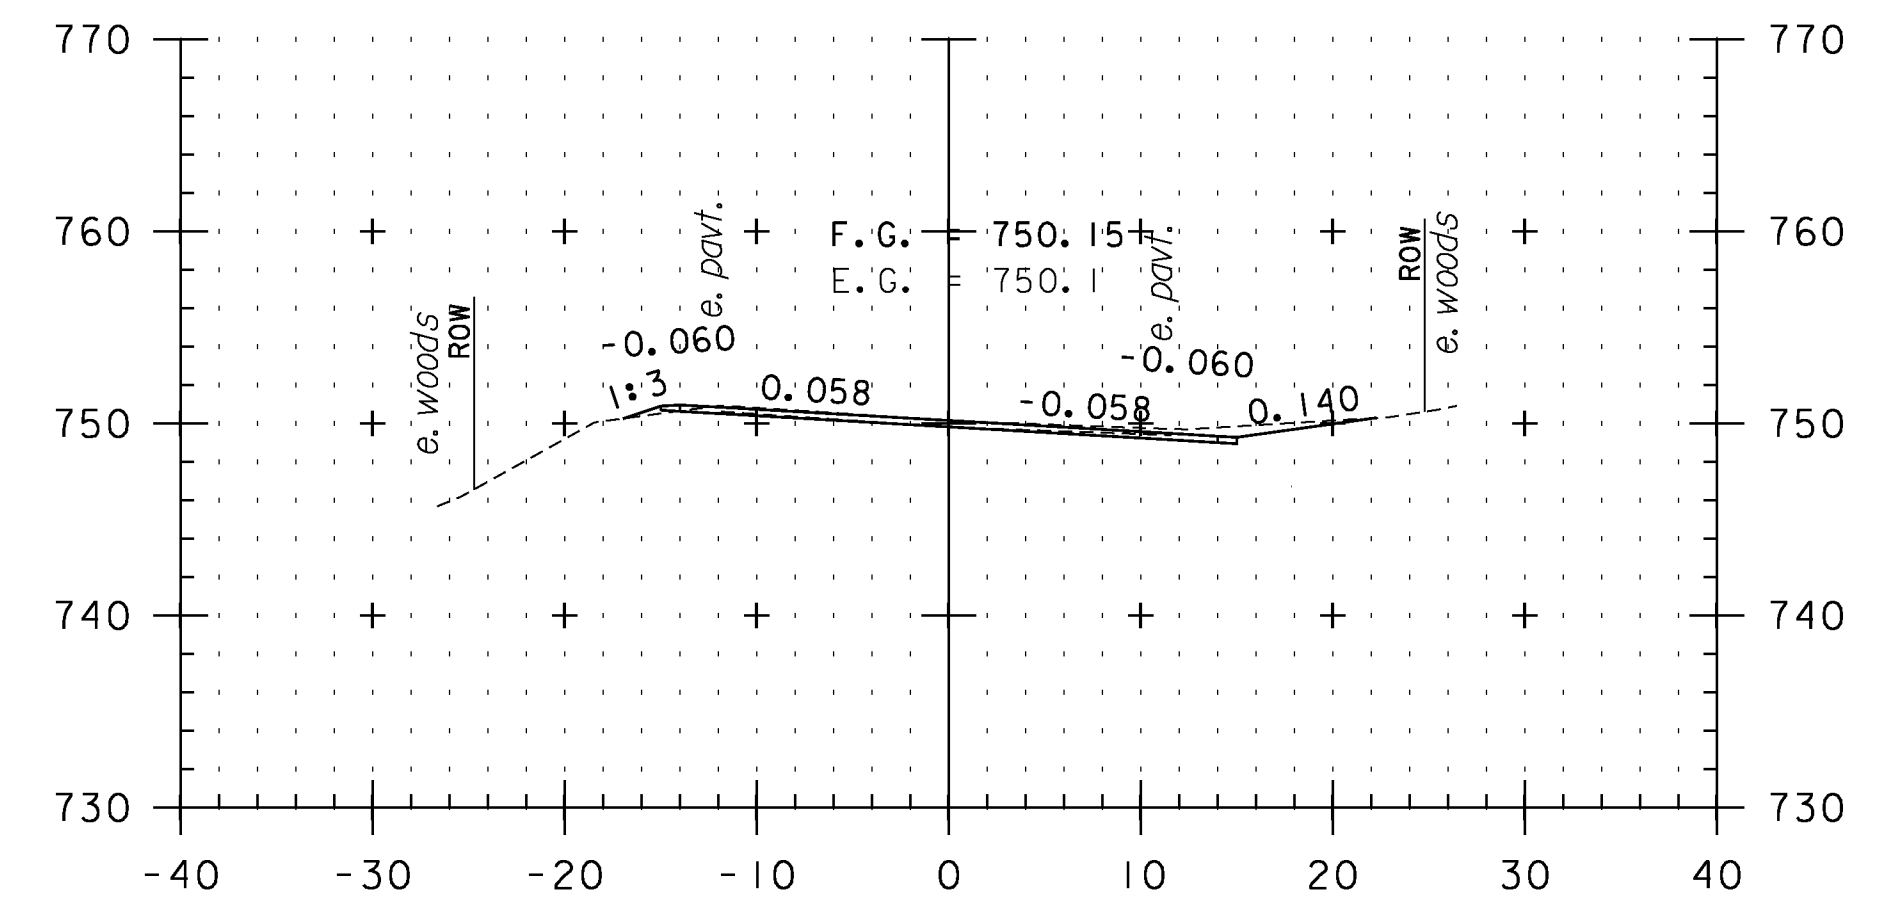


F66+50

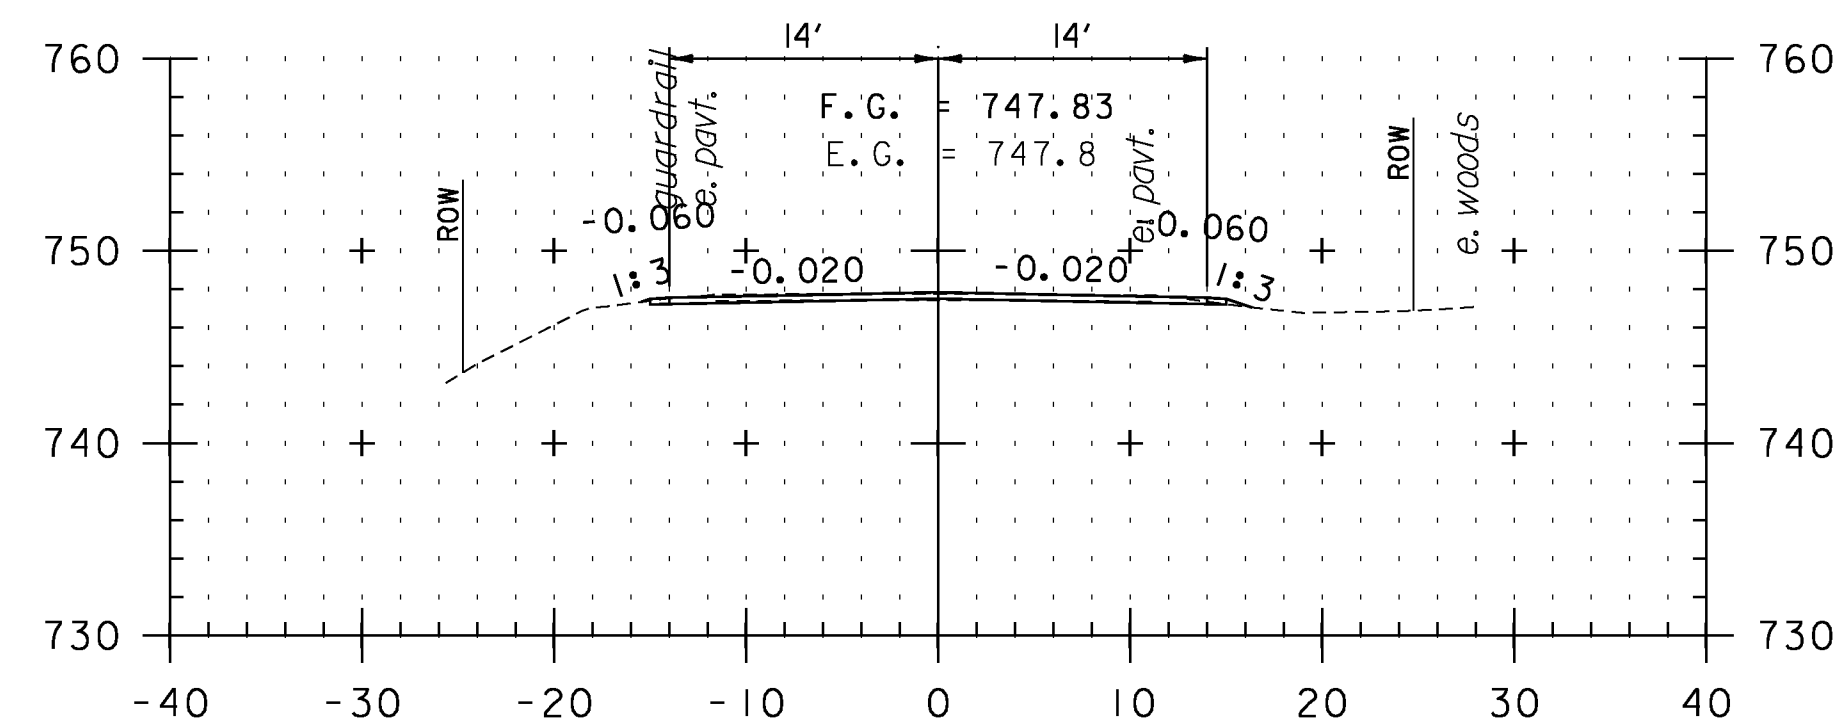

F63+00

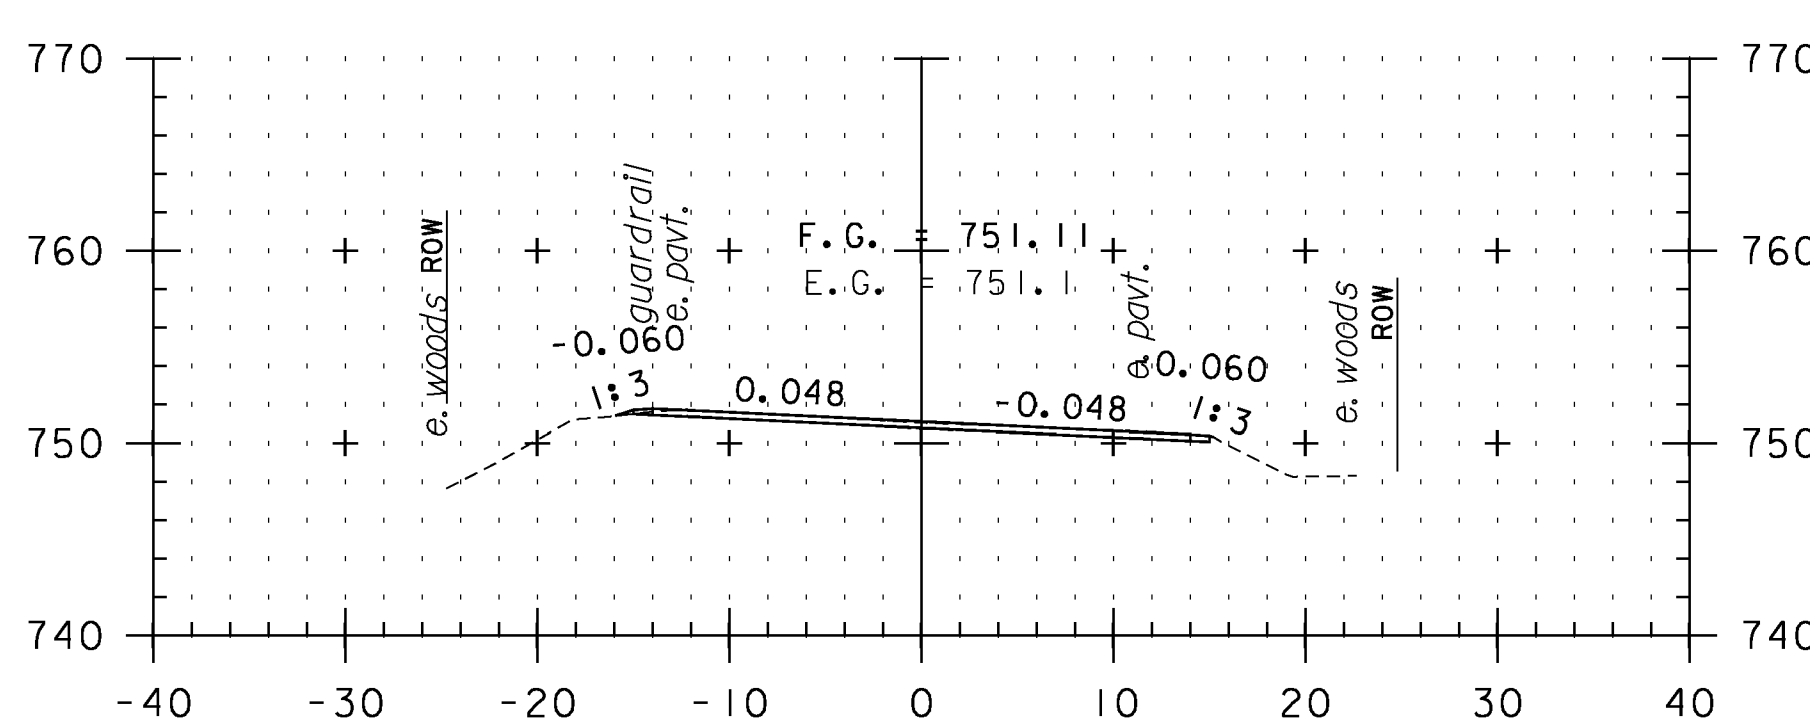

F64+50

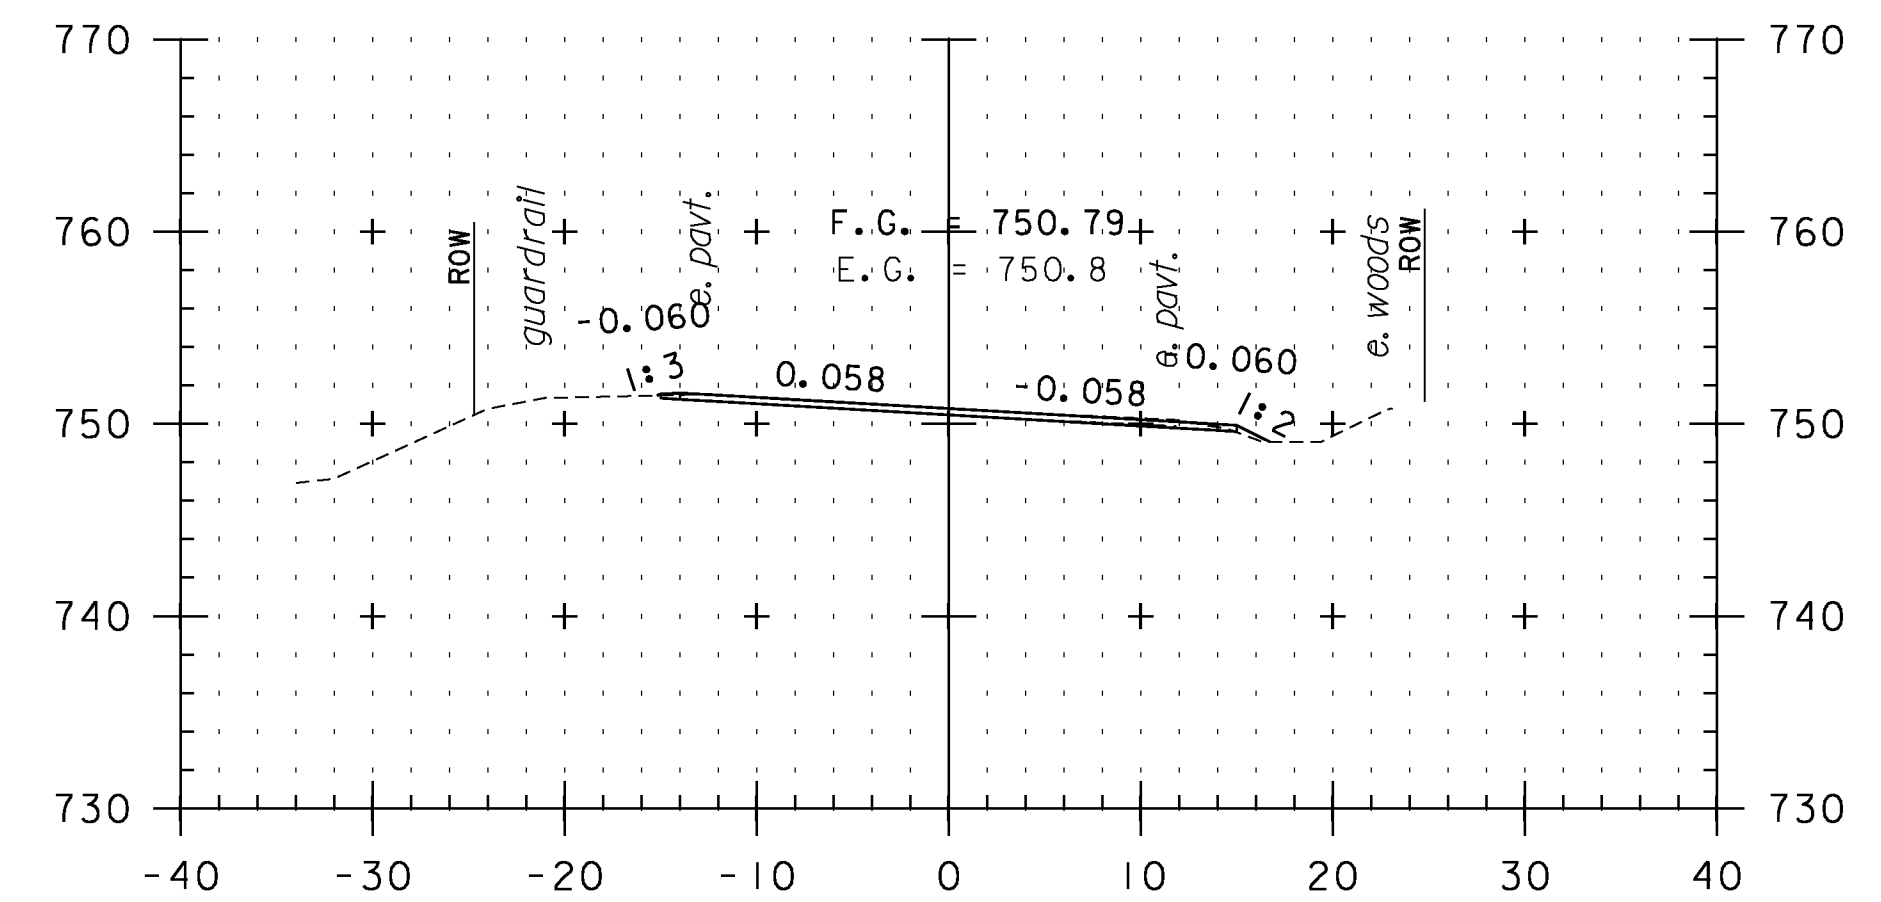

F66+00

**CROSS SECTION SHEET 67**

PROJECT NAME: VERSHIRE-THETFORD

PROJECT NUMBER: STP 2911(I)

FILE NAME: pl0c224.dgn

PLOT DATE: 1/29/2013

PROJECT LEADER: PTS

DRAWN BY: SNG


DESIGNED BY: NLL

CHECKED BY: PTS

IPARM FILE NAME: IOC224\_175

SHEET 175 OF 232

STA. F63+00 TO STA. F67+00

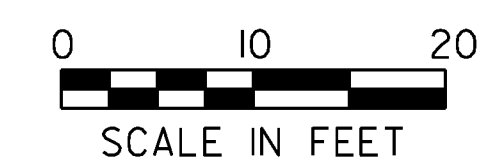

SCALE IN FEET