




F68+50

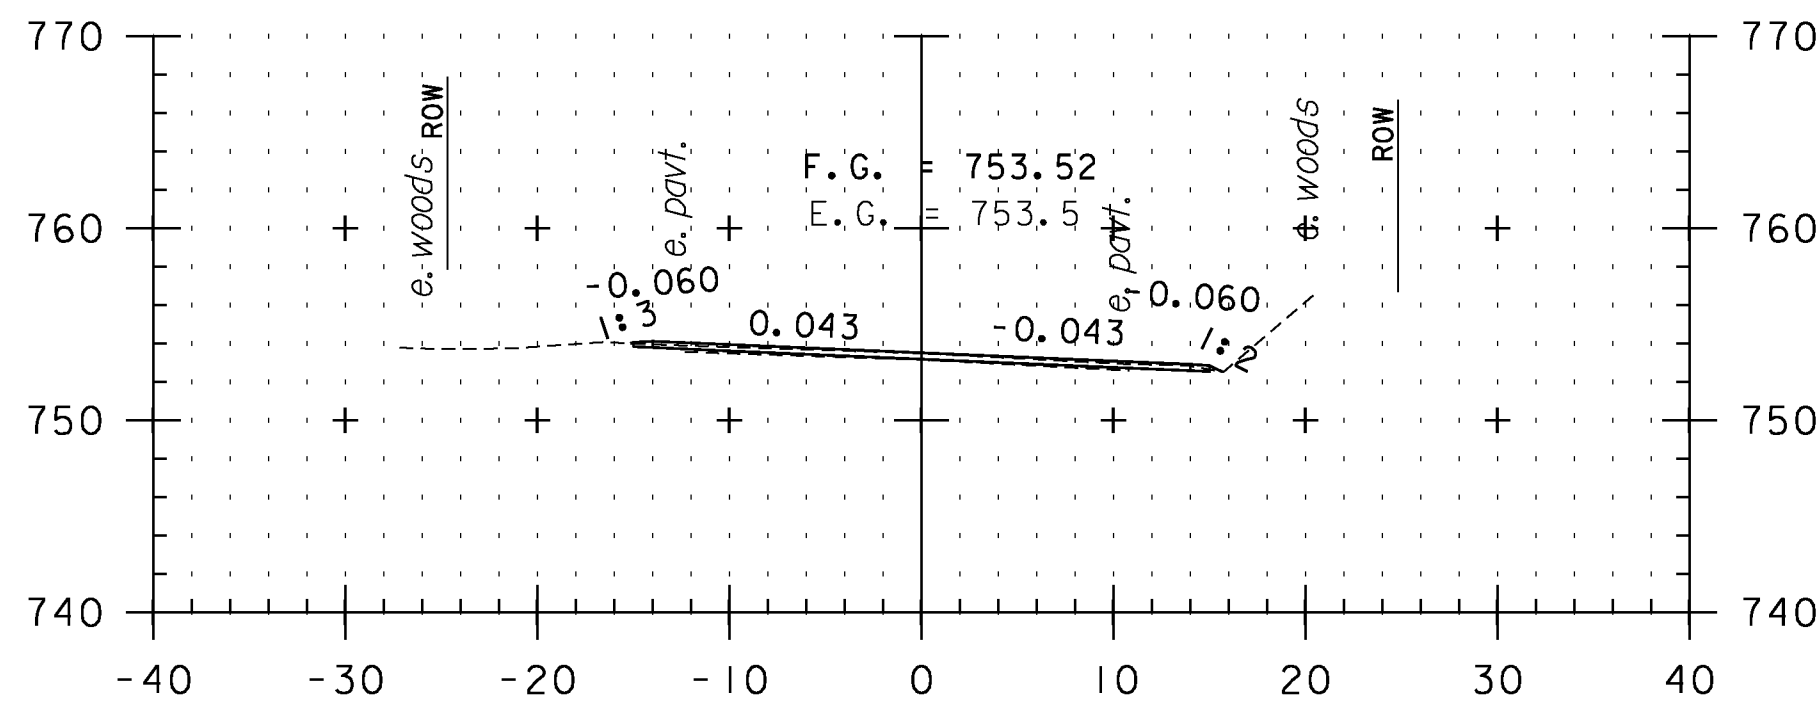


F70+00

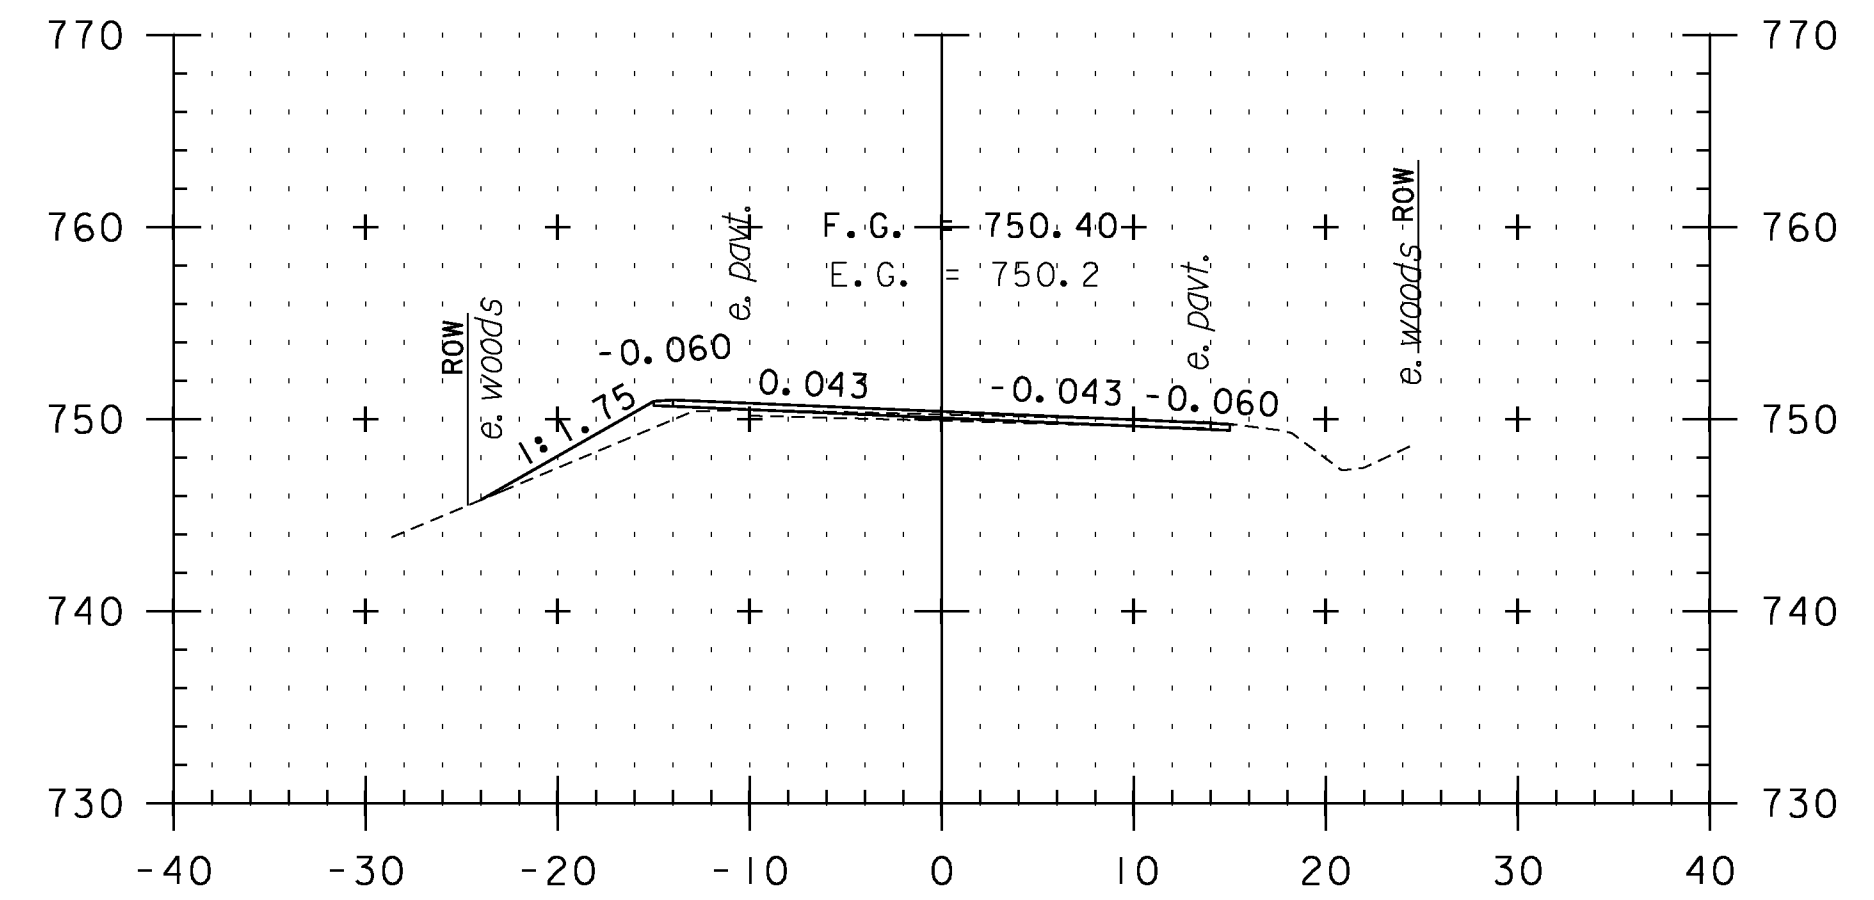


F71+50

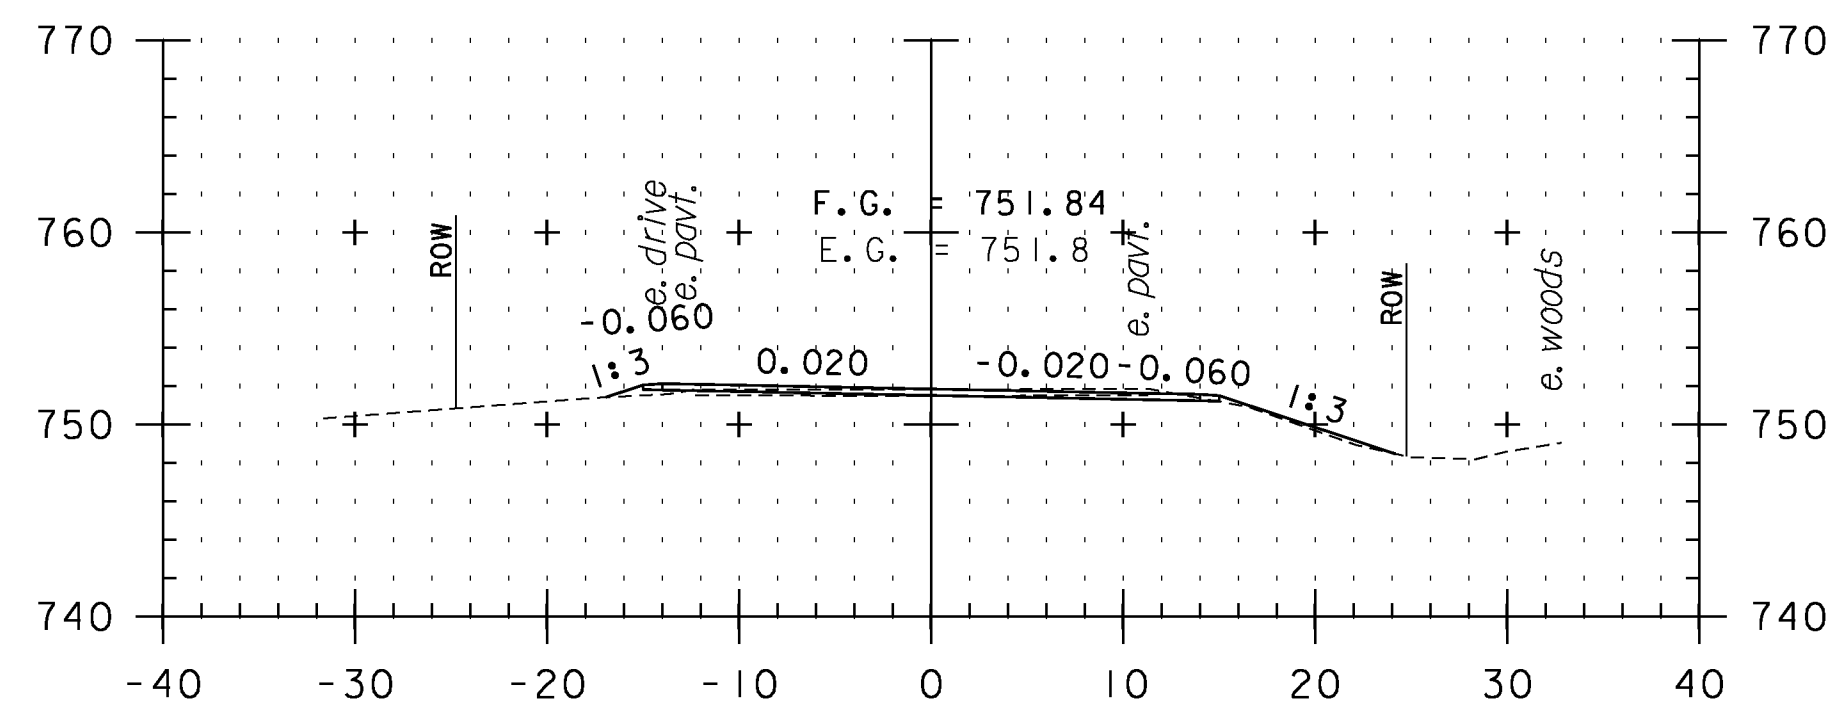


F68+00

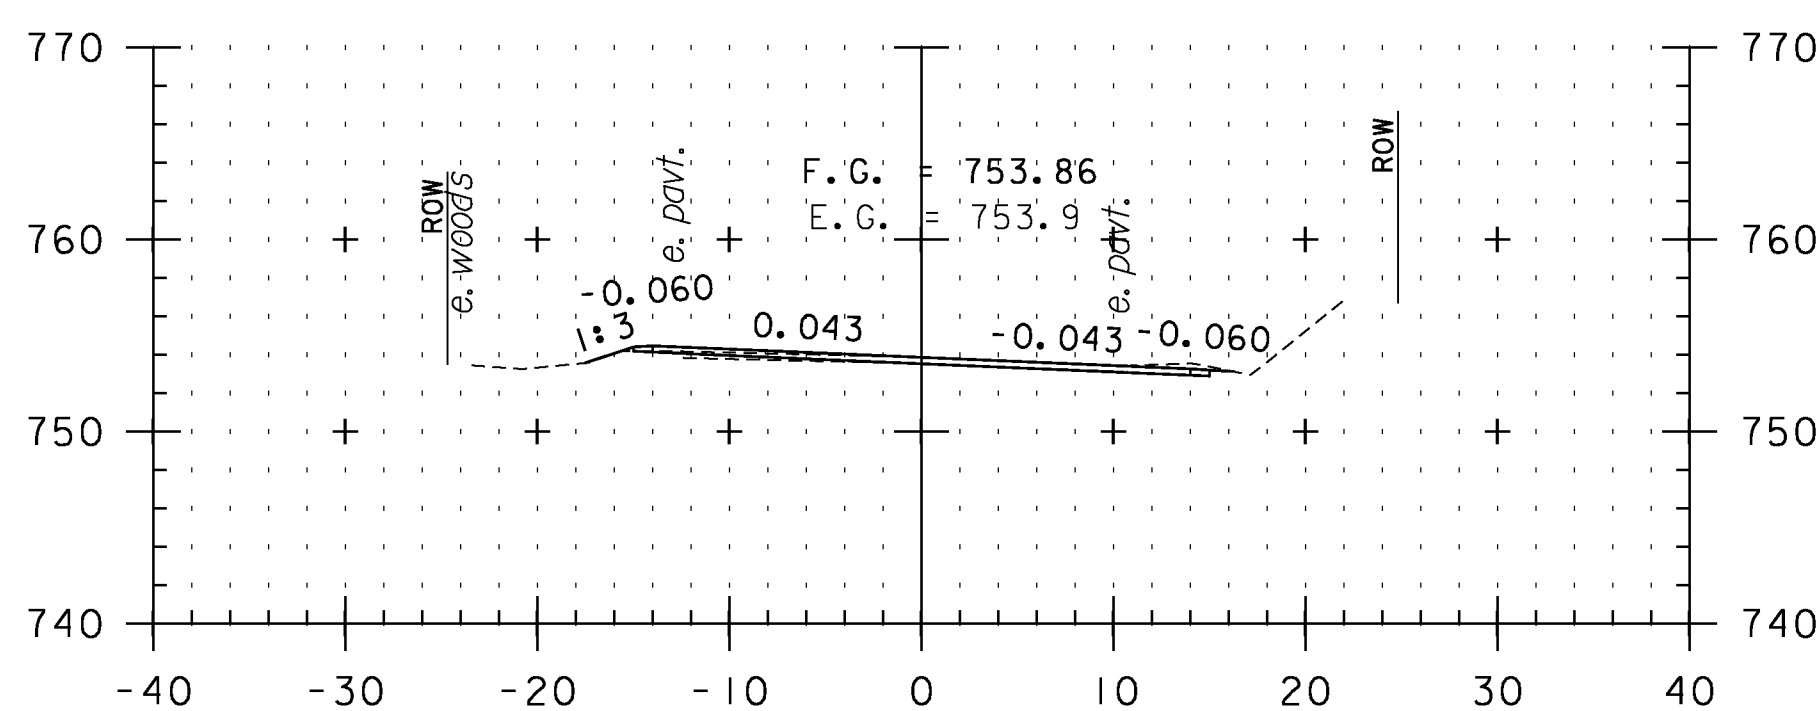


F69+50

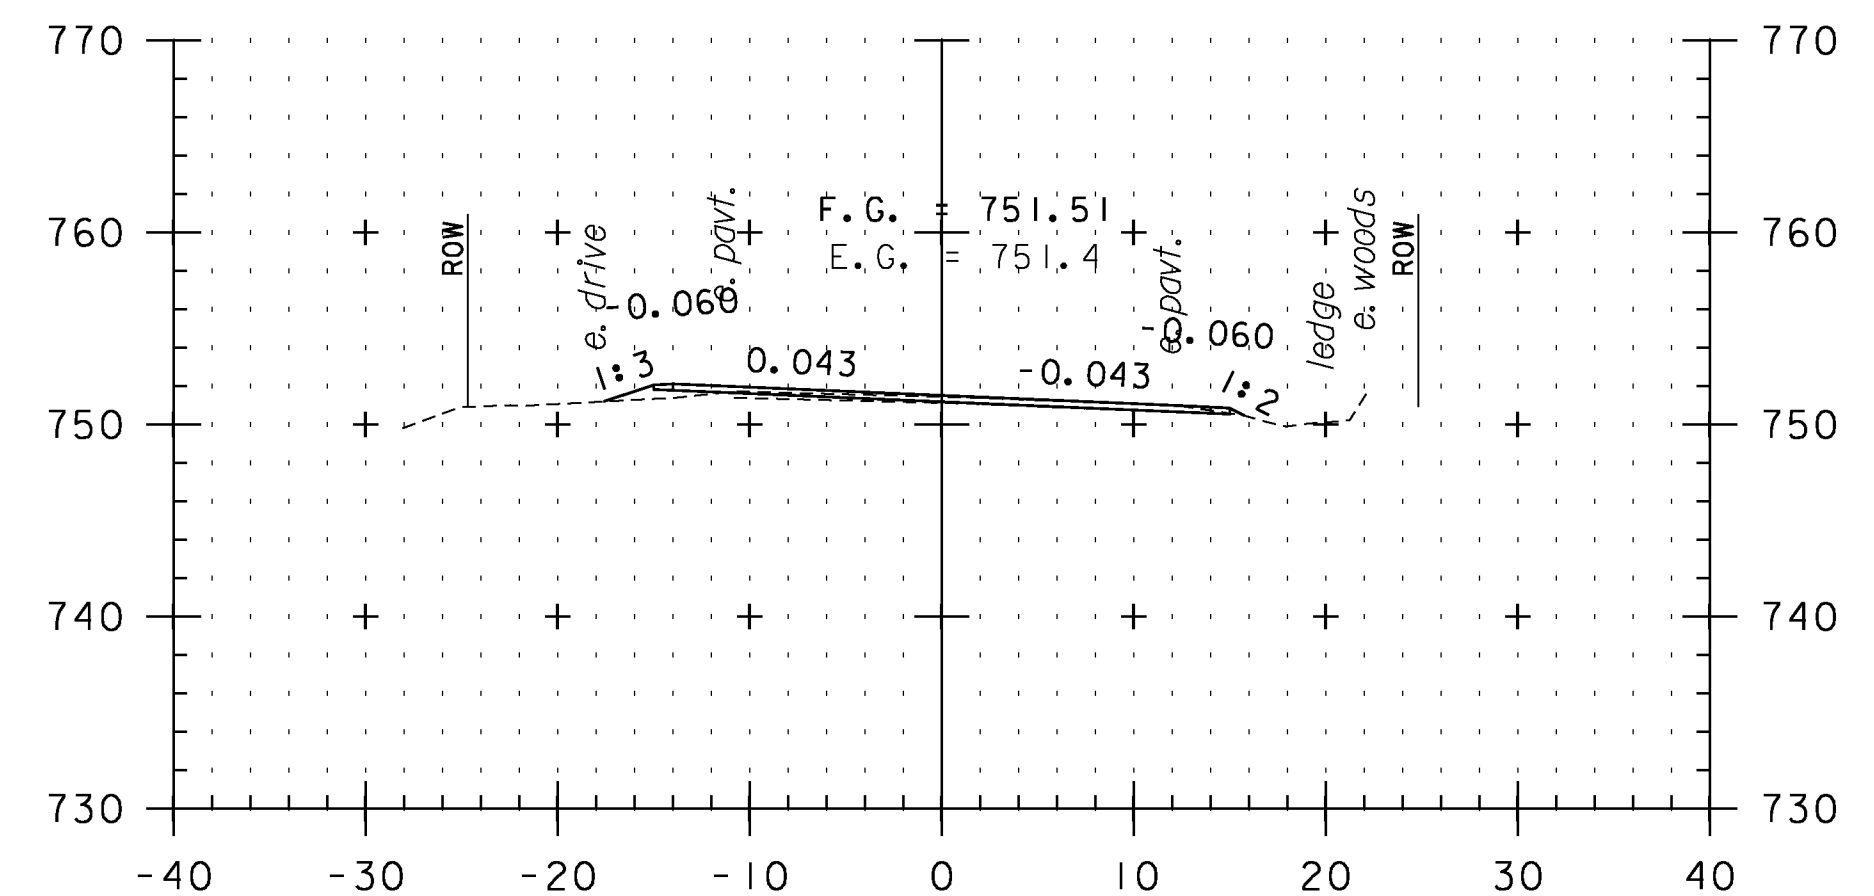


F71+00

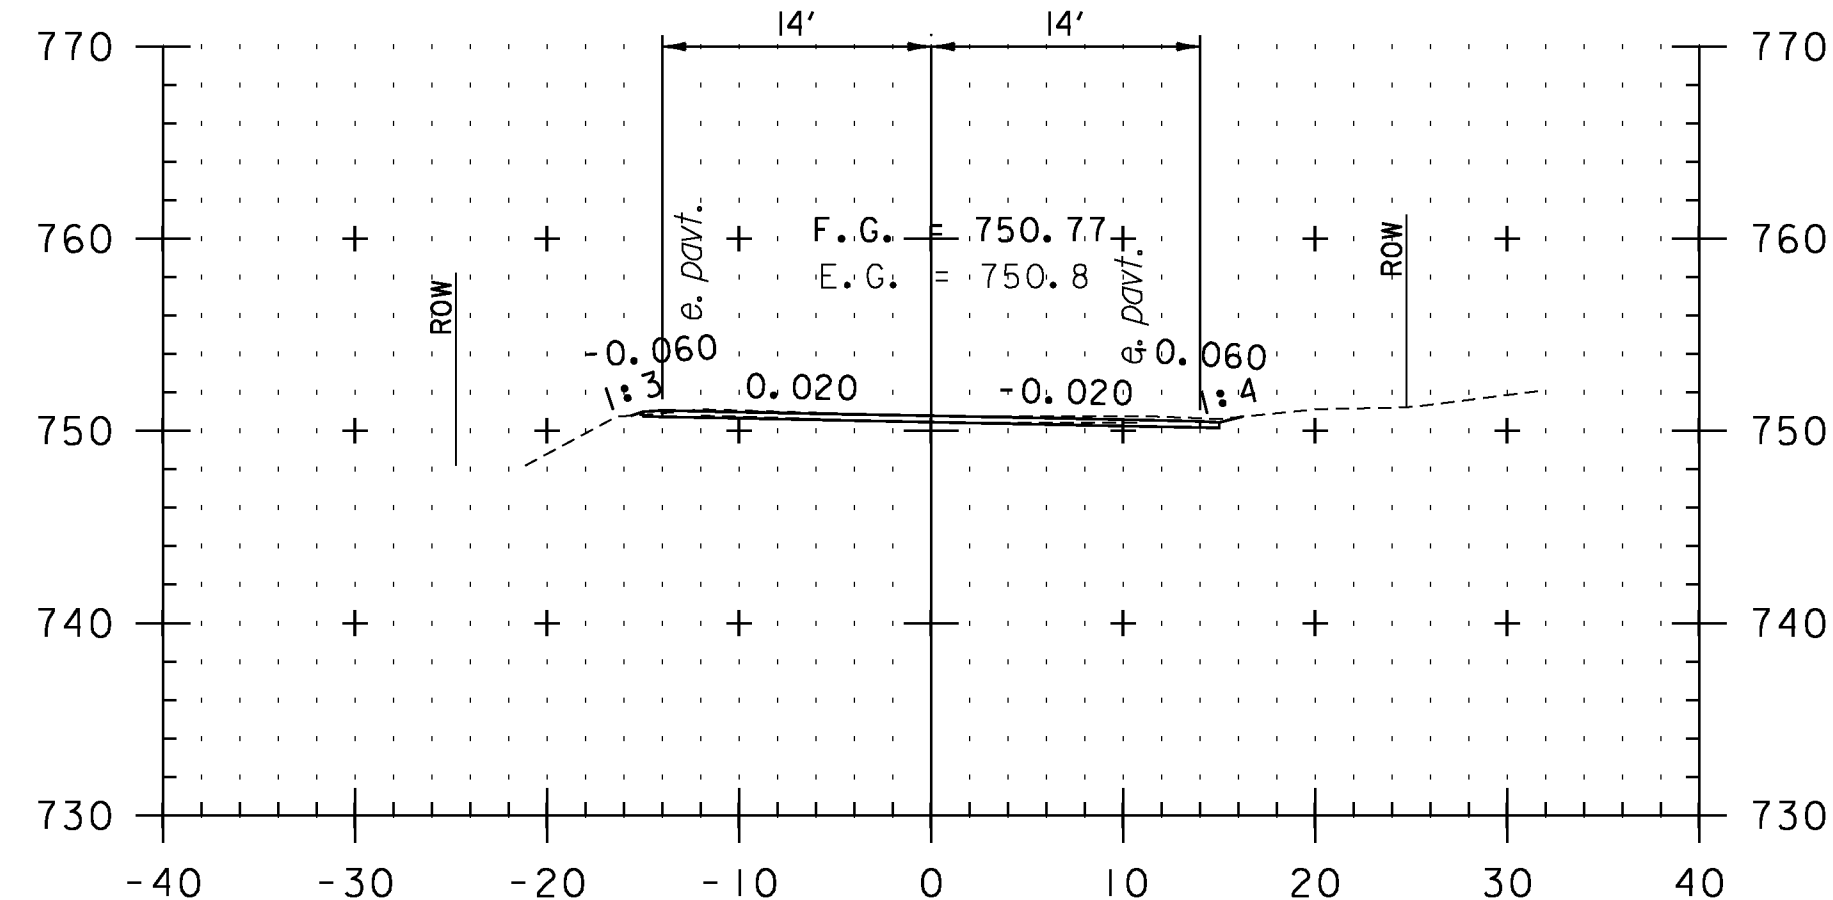

F67+50

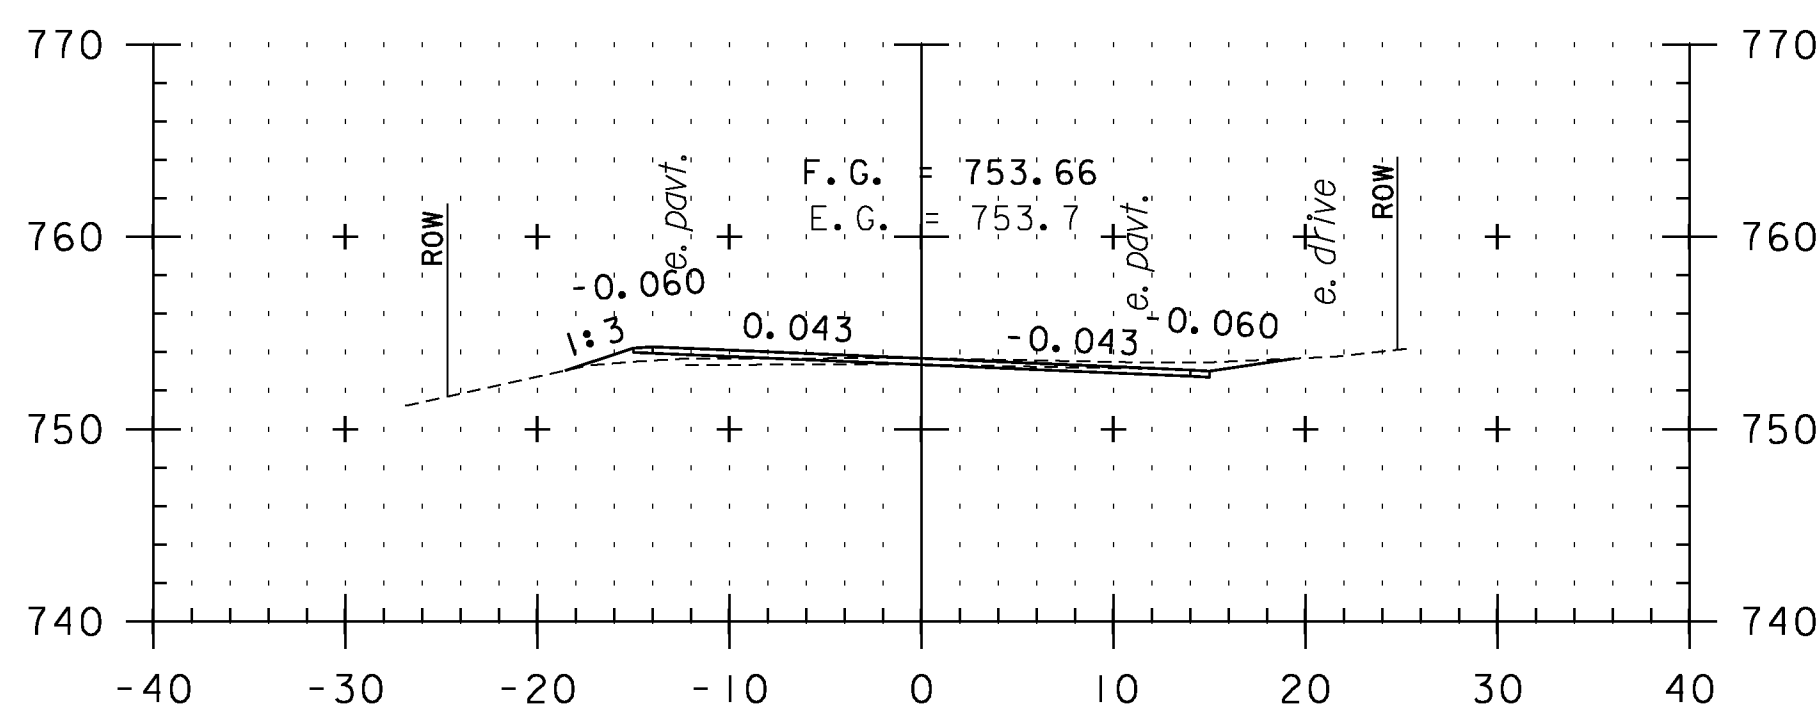


F69+00

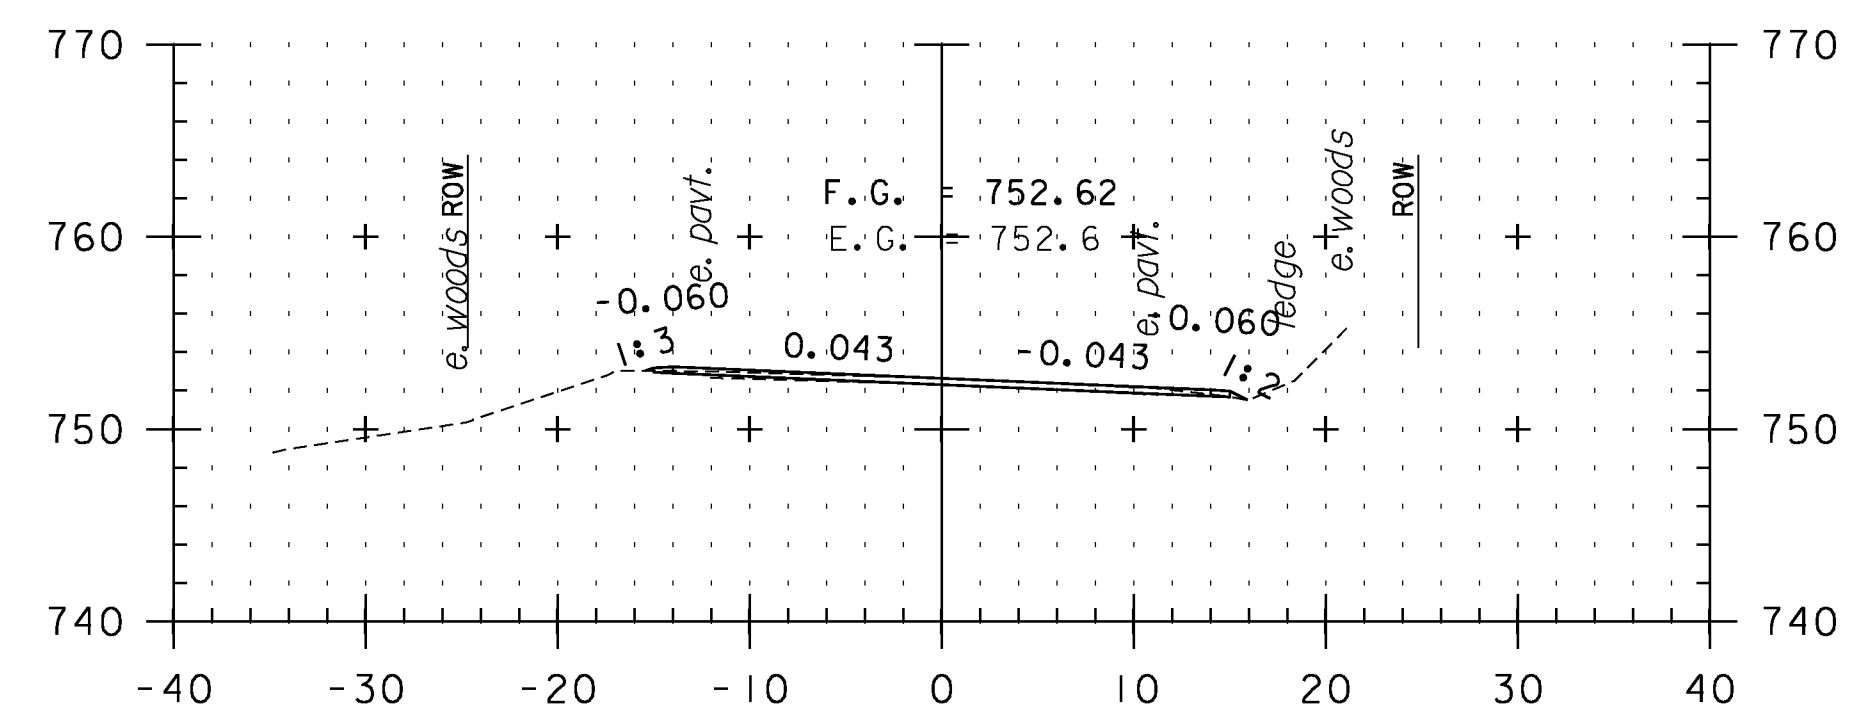

F70+50

CROSS SECTION SHEET 68

STA. F67+50 TO STA. F71+50

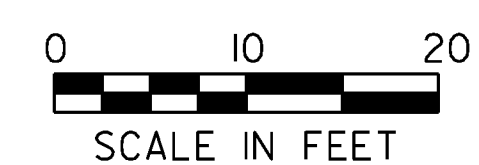

PROJECT NAME: VERSHIRE-THETFORD	PLOT DATE: 1/29/2013
PROJECT NUMBER: STP 2911(I)	DRAWN BY: SNG
FILE NAME: pl0c224.dgn	CHECKED BY: PTS
PROJECT LEADER: PTS	SHEET 176 OF 232
DESIGNED BY: NLL	
IPARM FILE NAME: IOC224_176	