

F73+00

F74+50

F76+00

F72+50

F74+00

F75+50


F72+00

F73+50

F75+00

CROSS SECTION SHEET 69

STA. F72+00 TO STA. F76+00

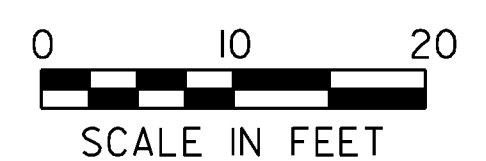

PROJECT NAME: VERSHIRE-THETFORD	PLOT DATE: 1/29/2013
PROJECT NUMBER: STP 2911(I)	DRAWN BY: SNG
FILE NAME: pl0c224.dgn	CHECKED BY: PTS
PROJECT LEADER: PTS	SHEET 177 OF 232
DESIGNED BY: NLL	
IPARM FILE NAME: IOC224_177	