




F77+50

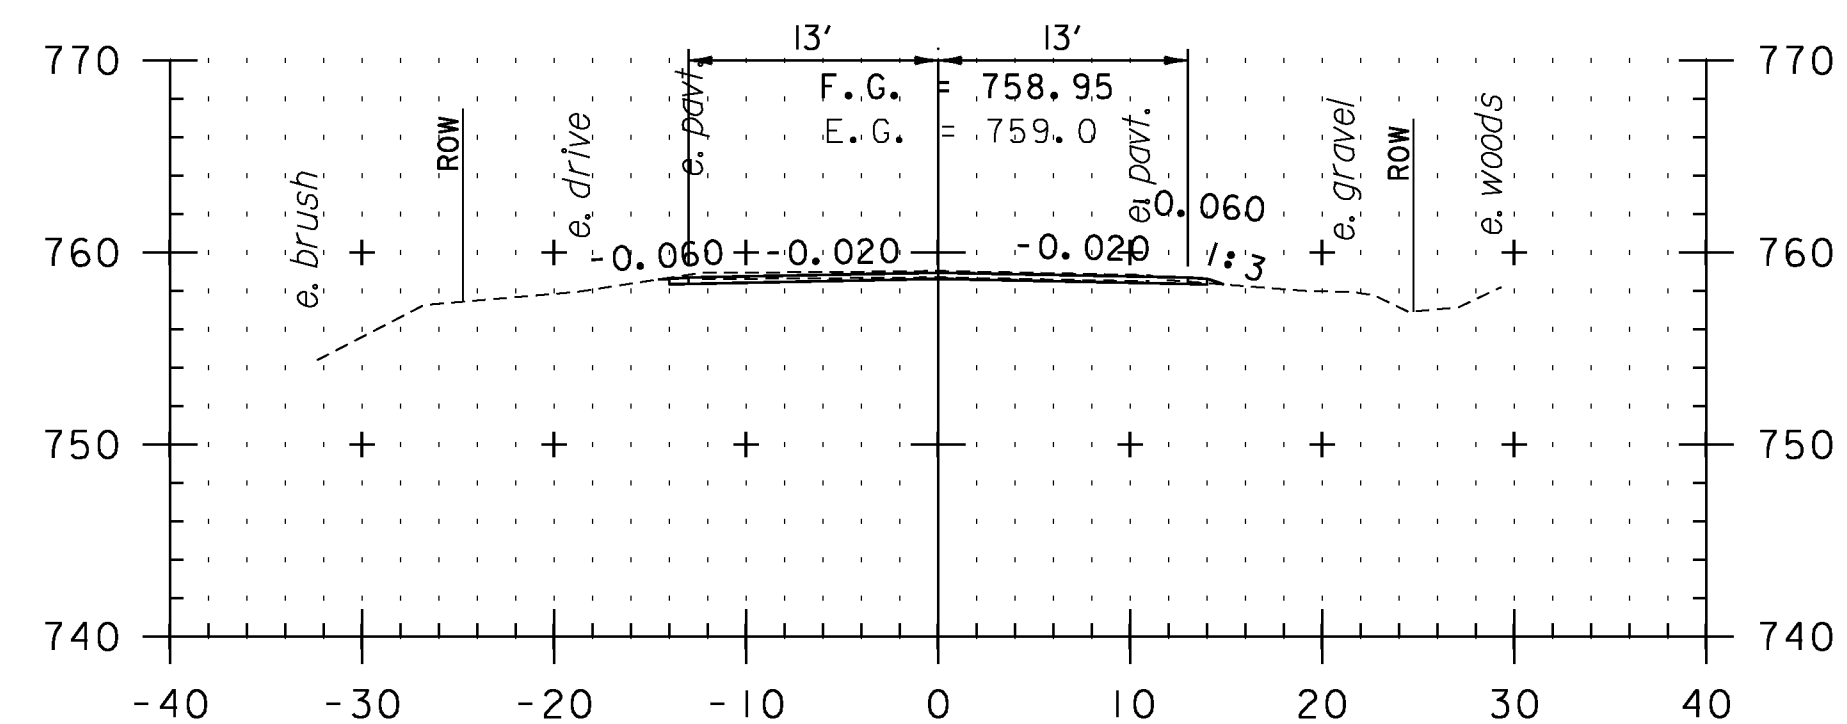


F77+00

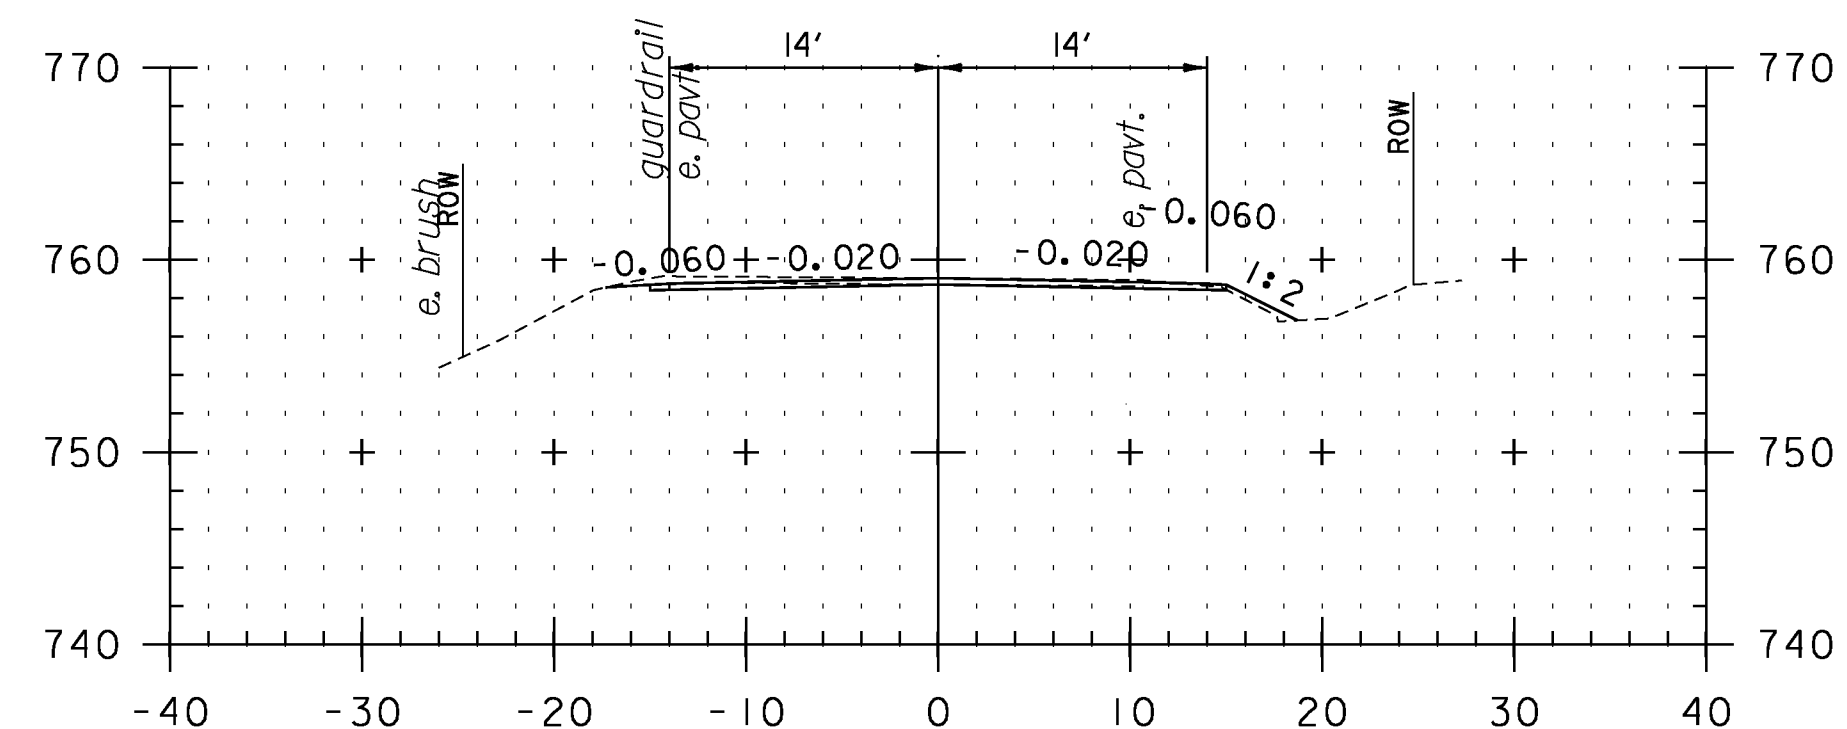


F76+50

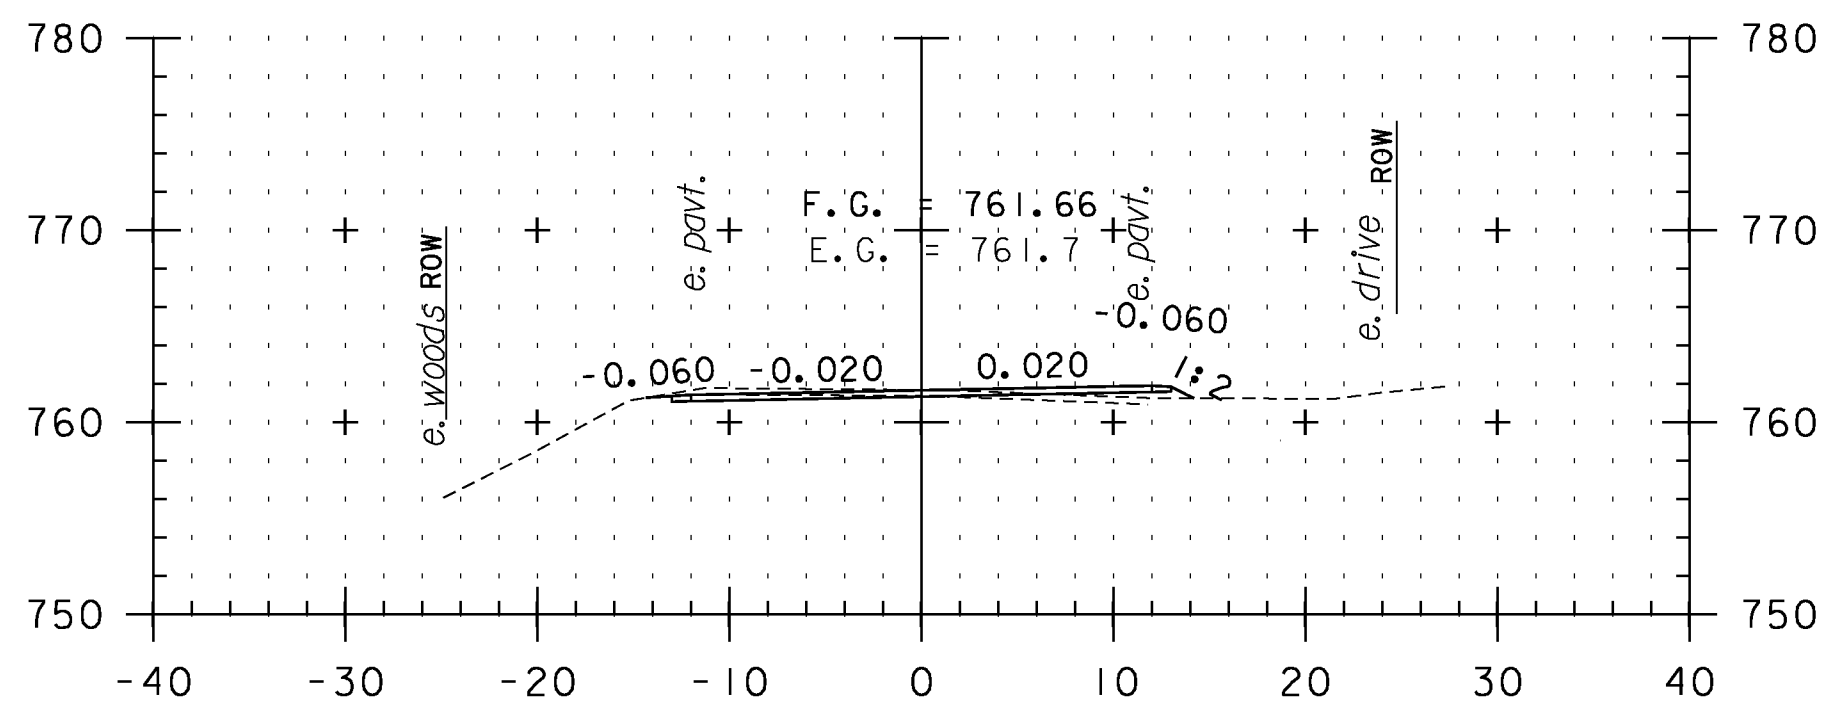


F79+00

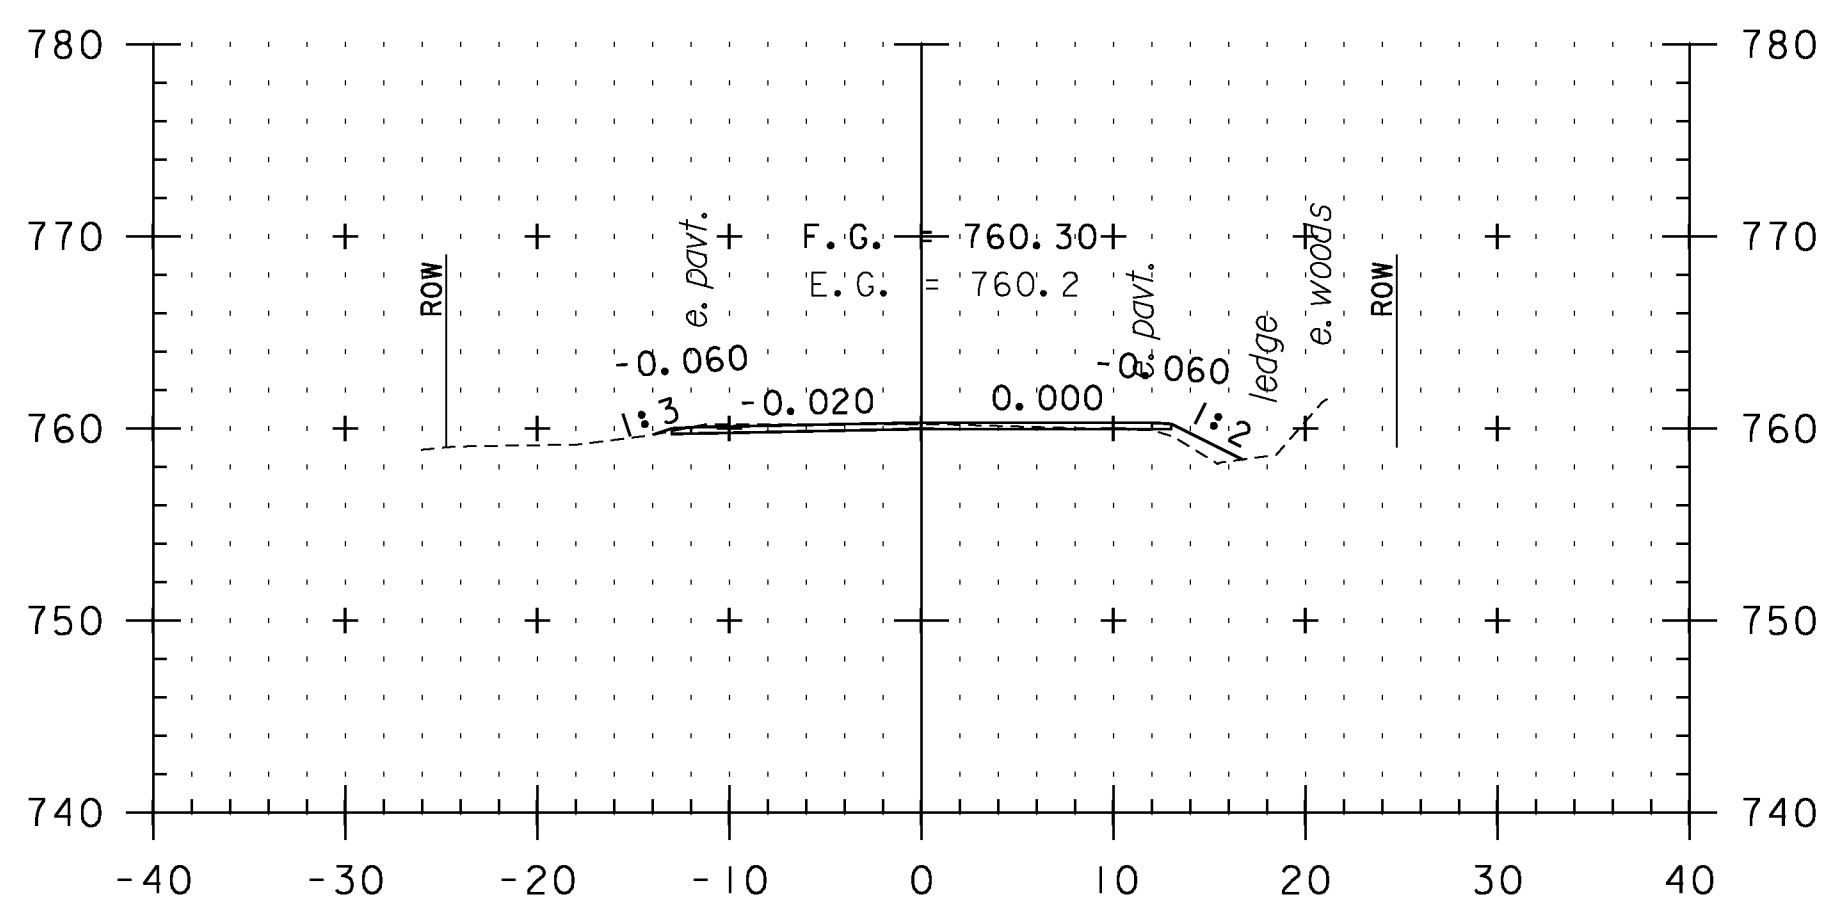


F78+50

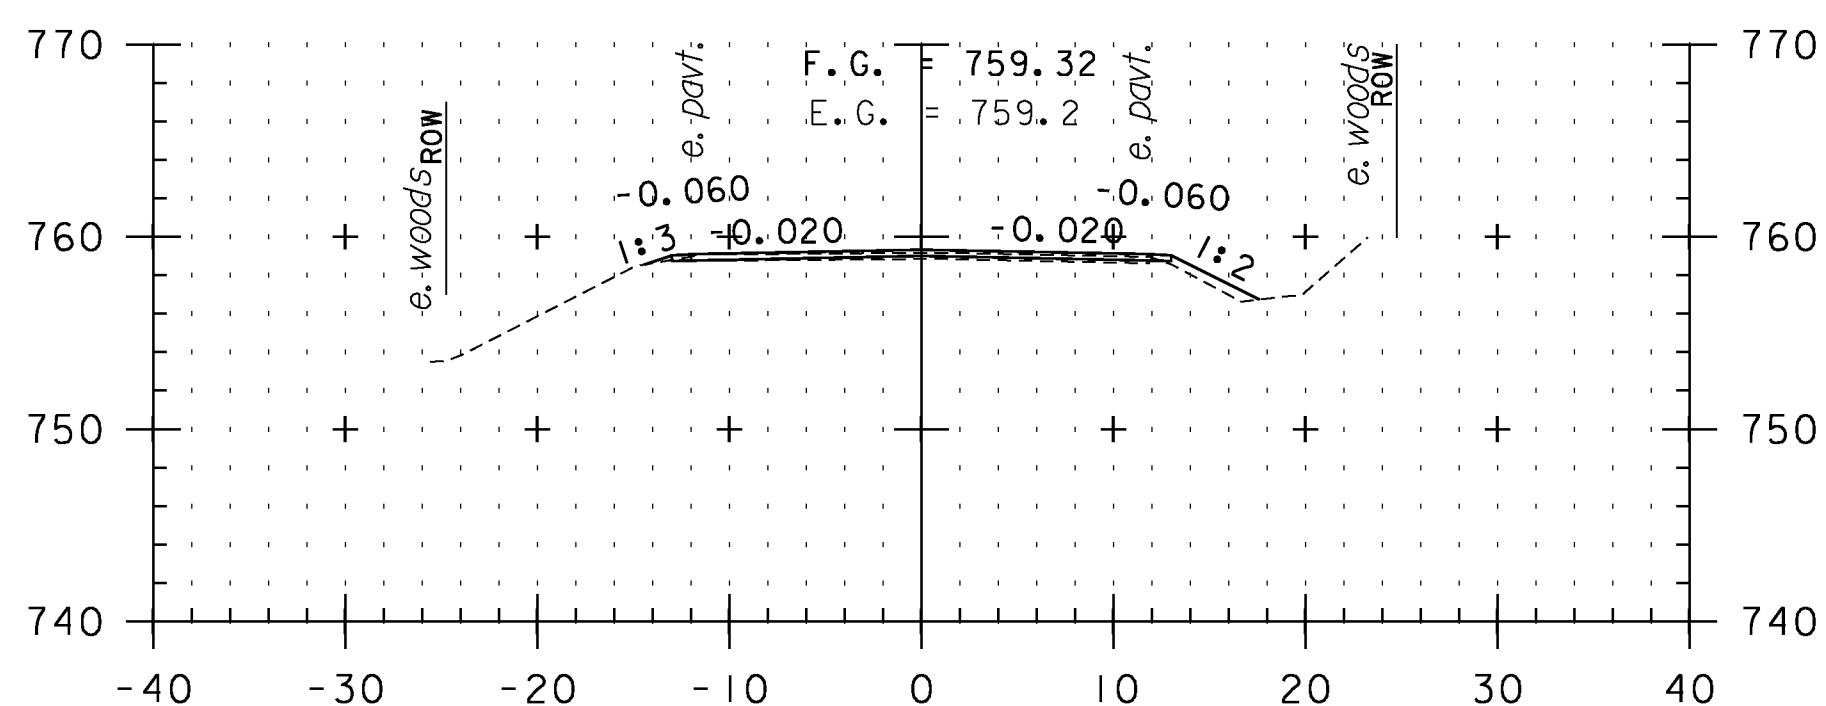


F78+00

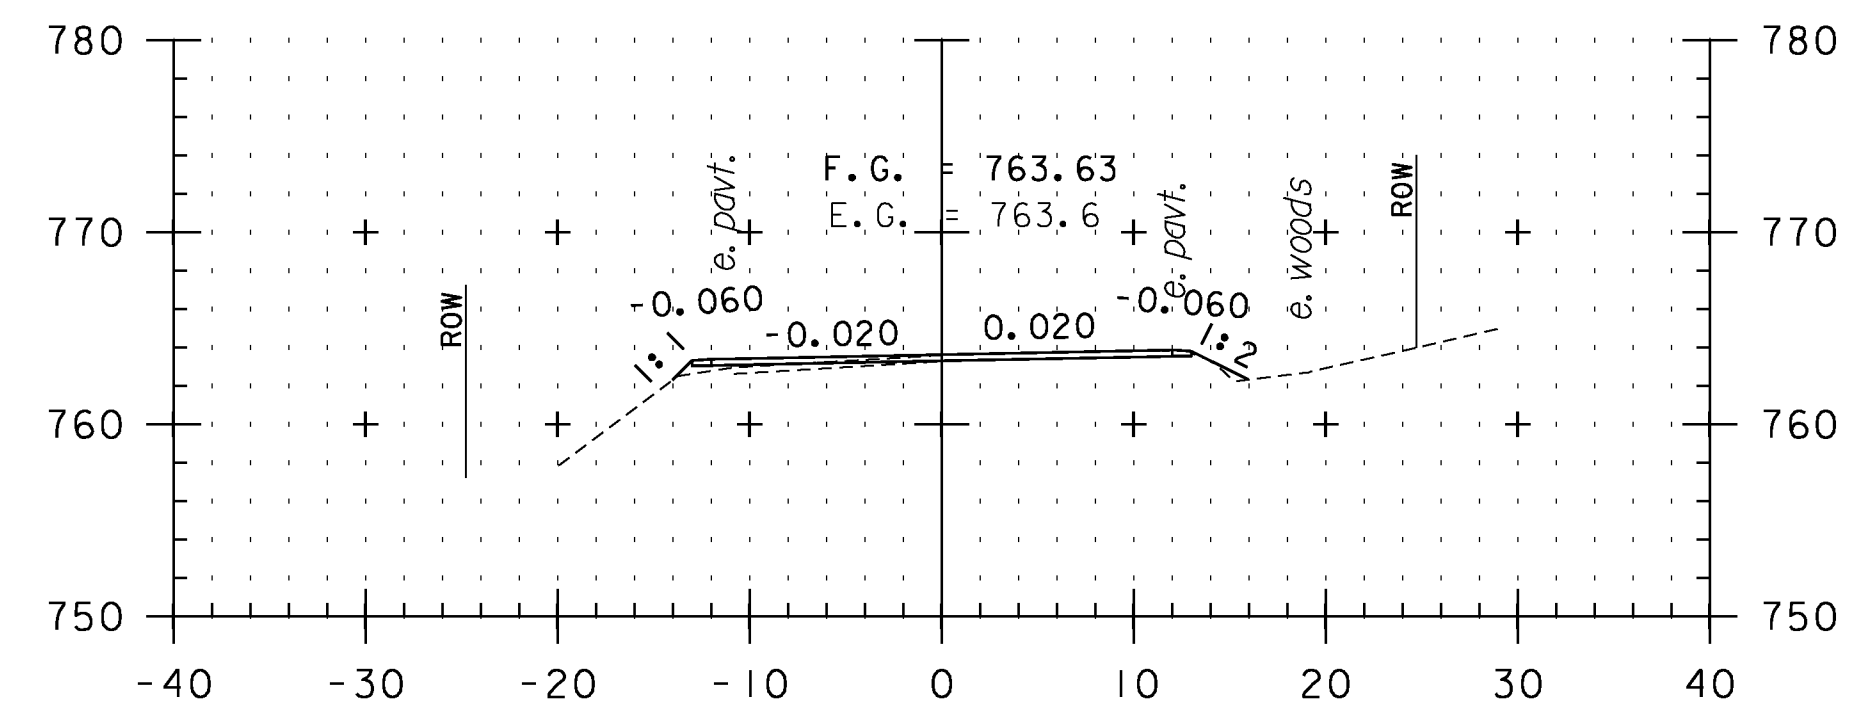

F80+50

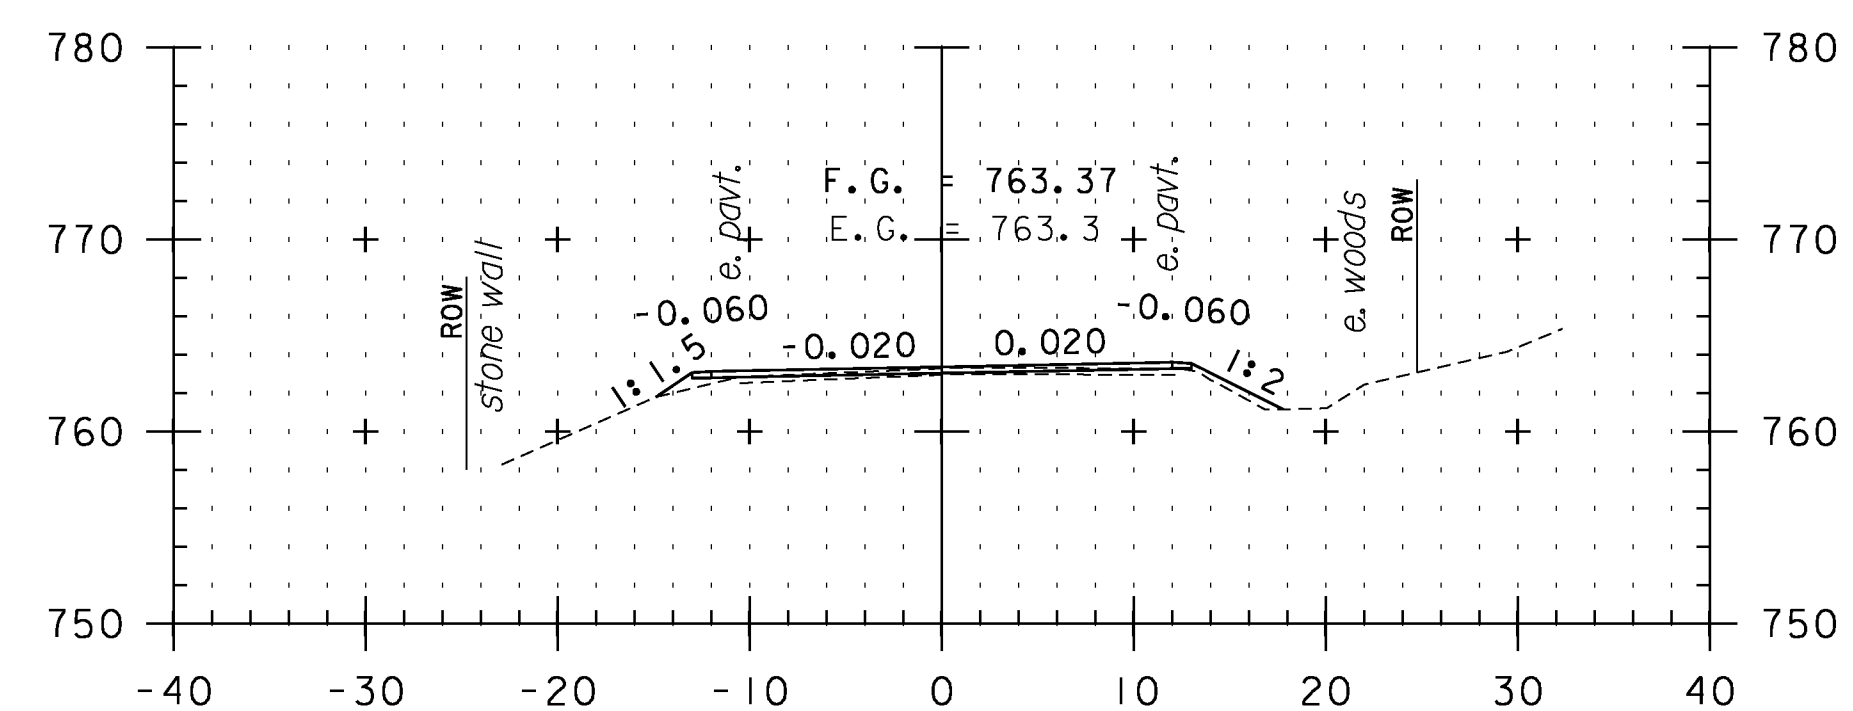

F80+00

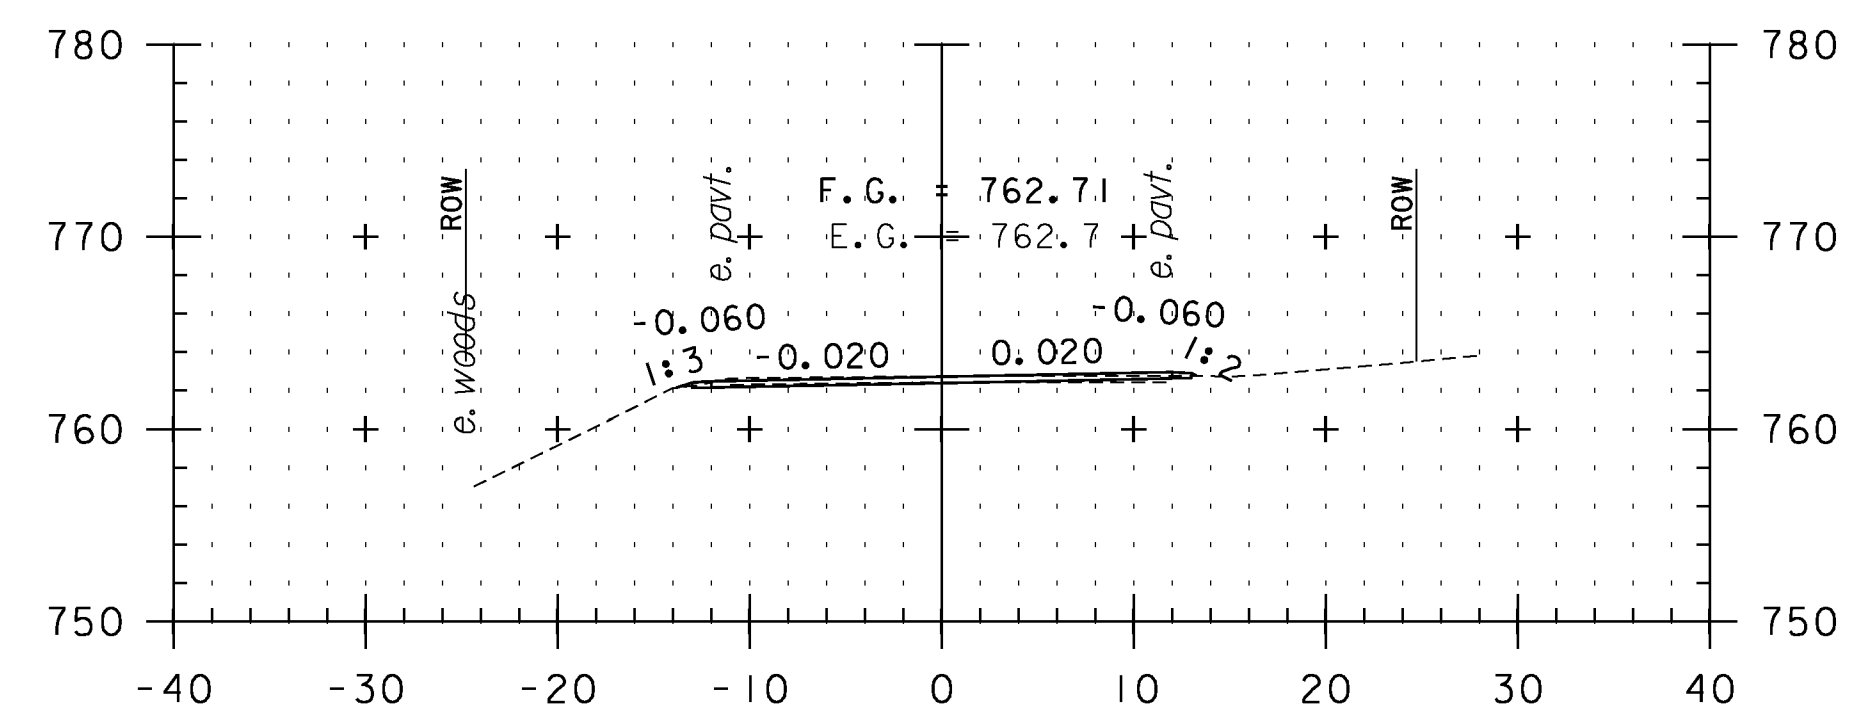

F79+50

CROSS SECTION SHEET 70

PROJECT NAME: VERSHIRE-THETFORD

PROJECT NUMBER: STP 2911(I)

FILE NAME: pl0c224.dgn

PLOT DATE: 1/29/2013

PROJECT LEADER: PTS

DRAWN BY: SNG


DESIGNED BY: NLL

CHECKED BY: PTS

IPARM FILE NAME: IOC224_I78

SHEET 178 OF 232

STA. F76+50 TO STA. F80+50

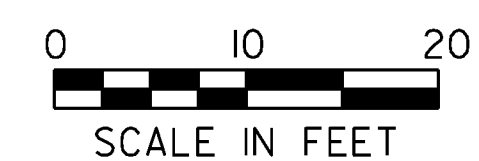

SCALE IN FEET