




F86+50

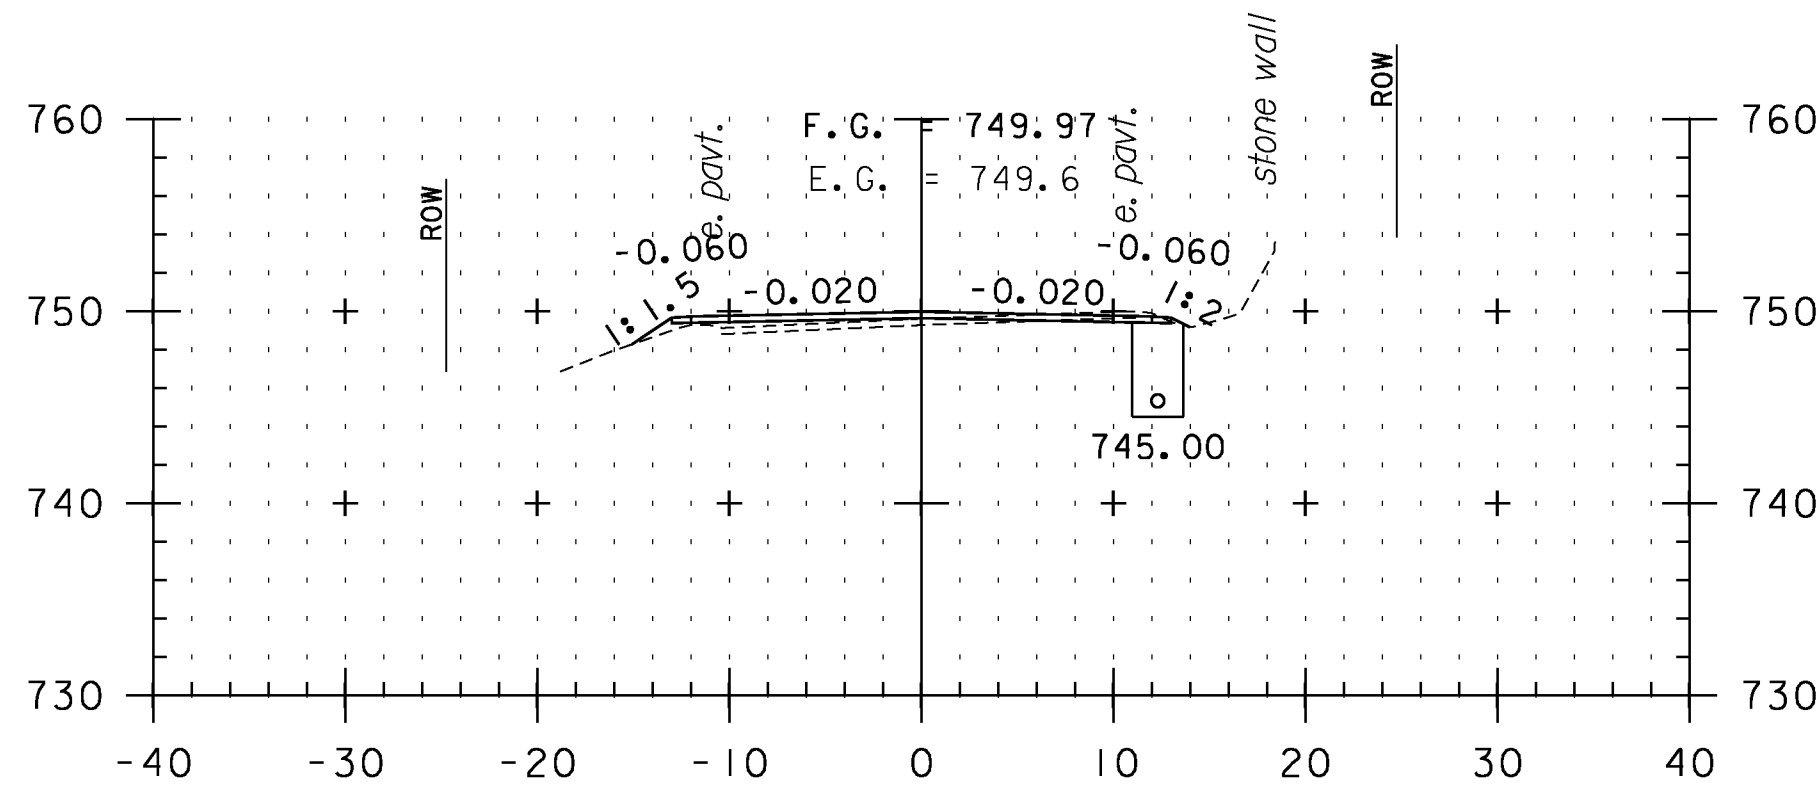


F88+00

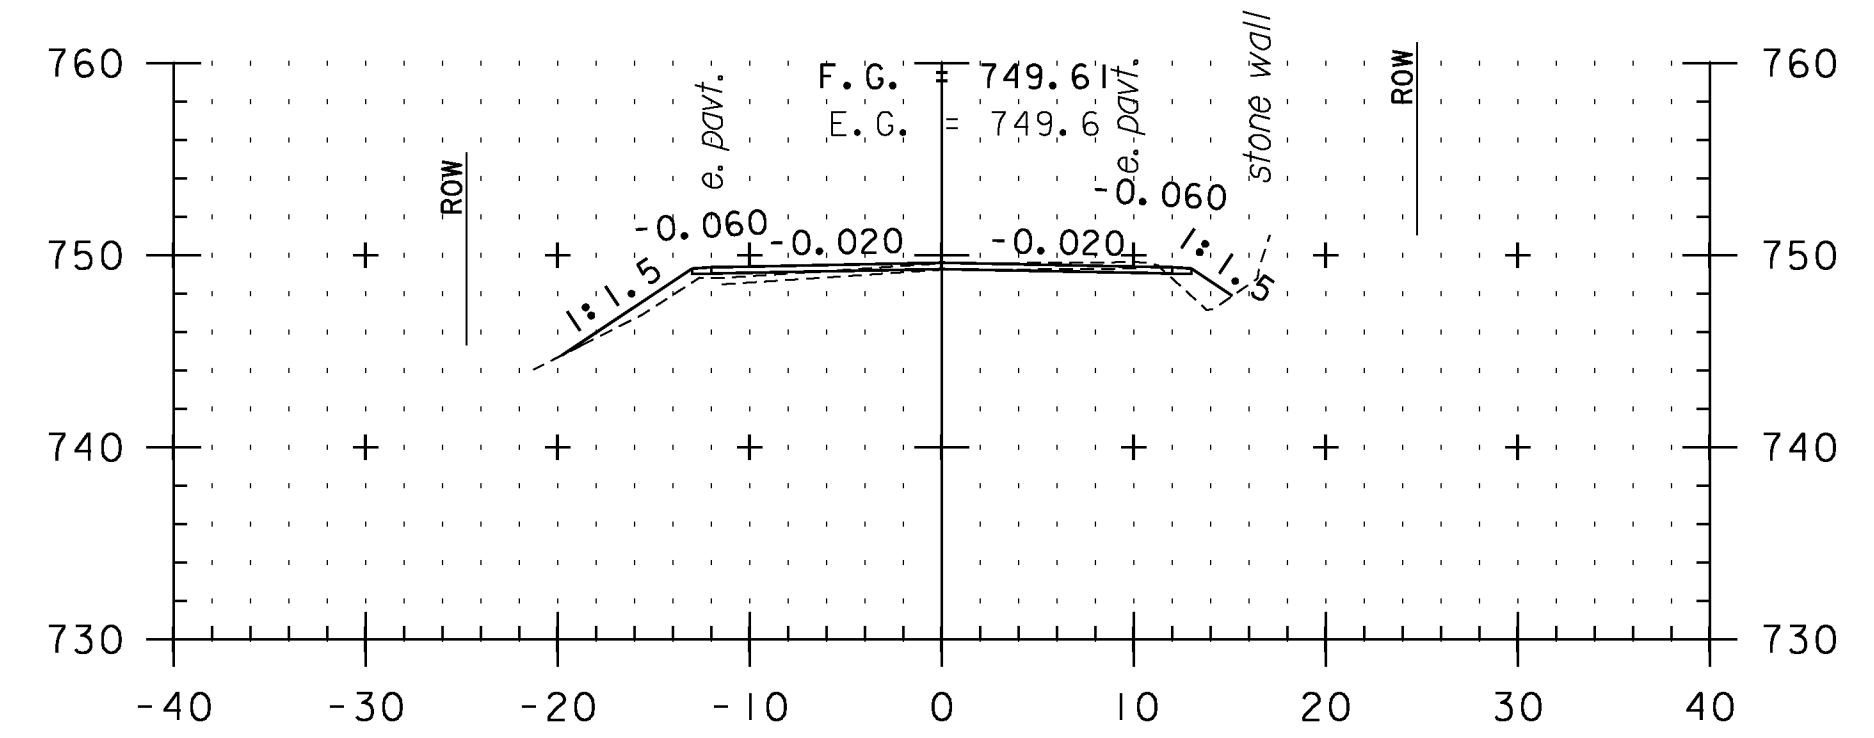


F89+50

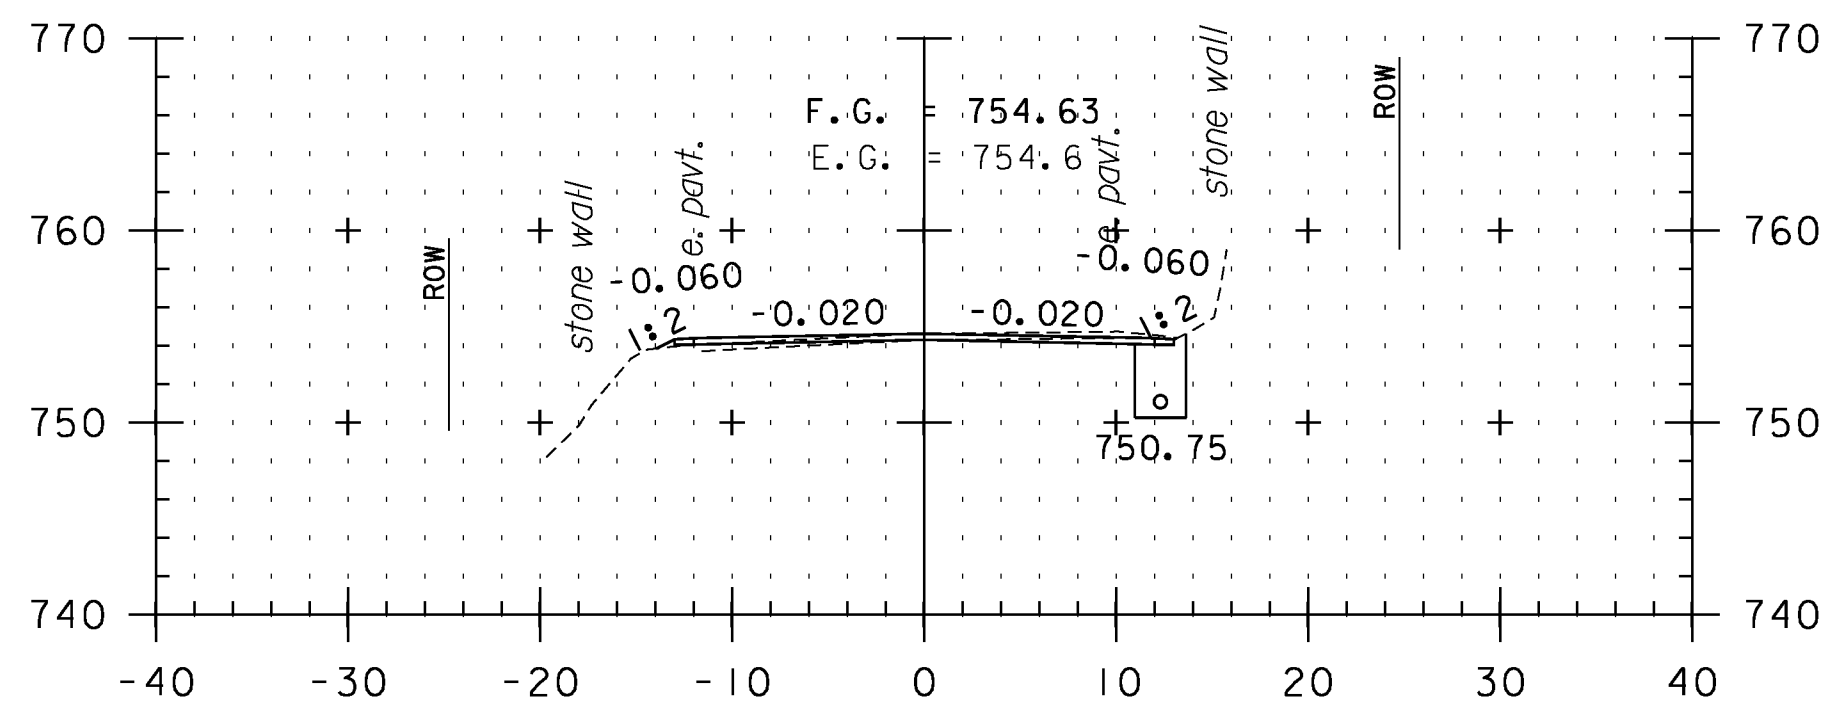


F86+00

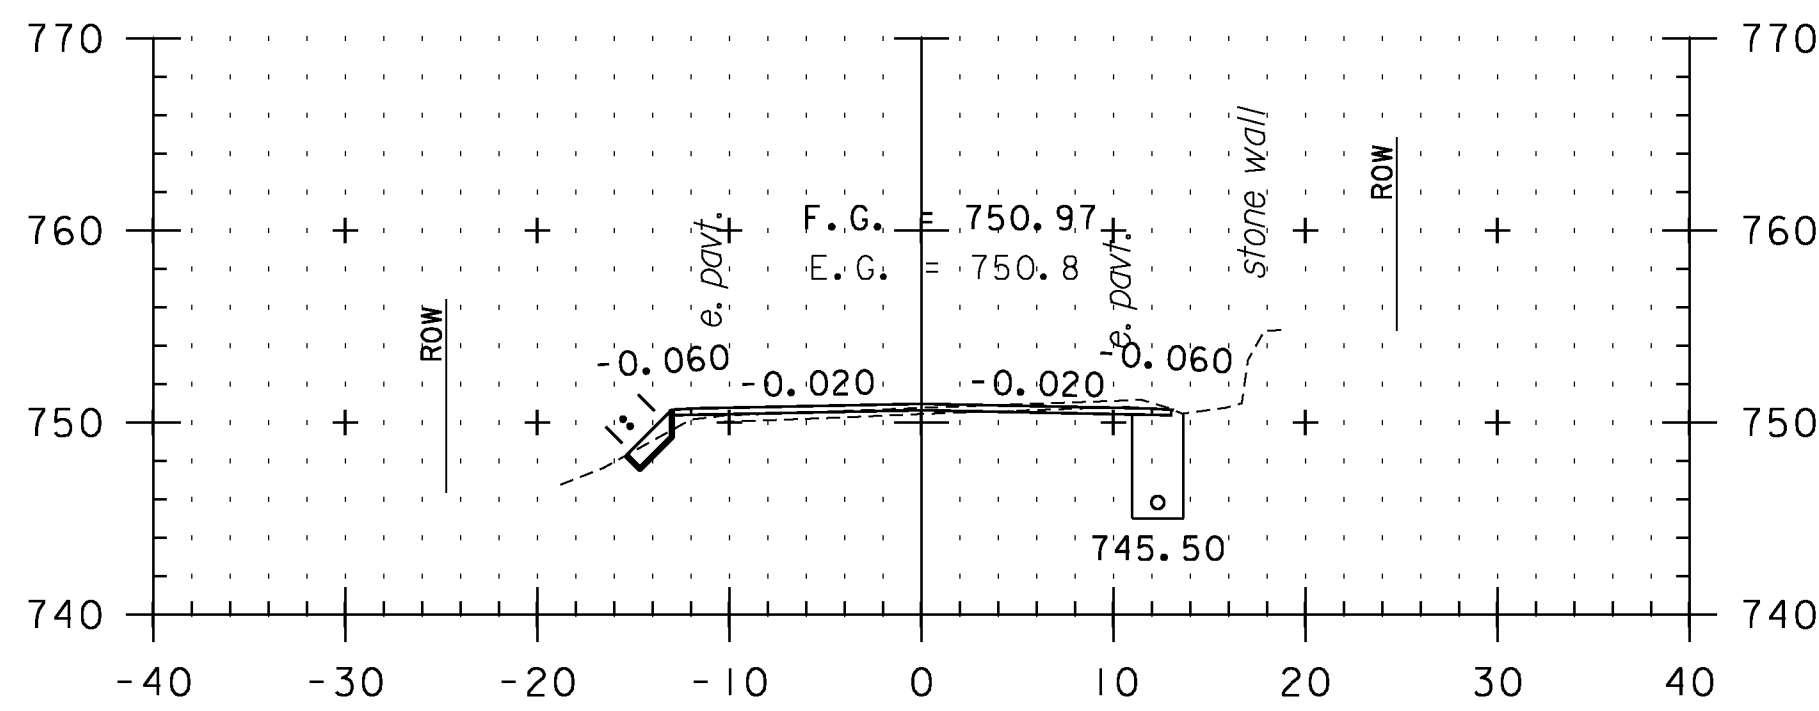


F87+50

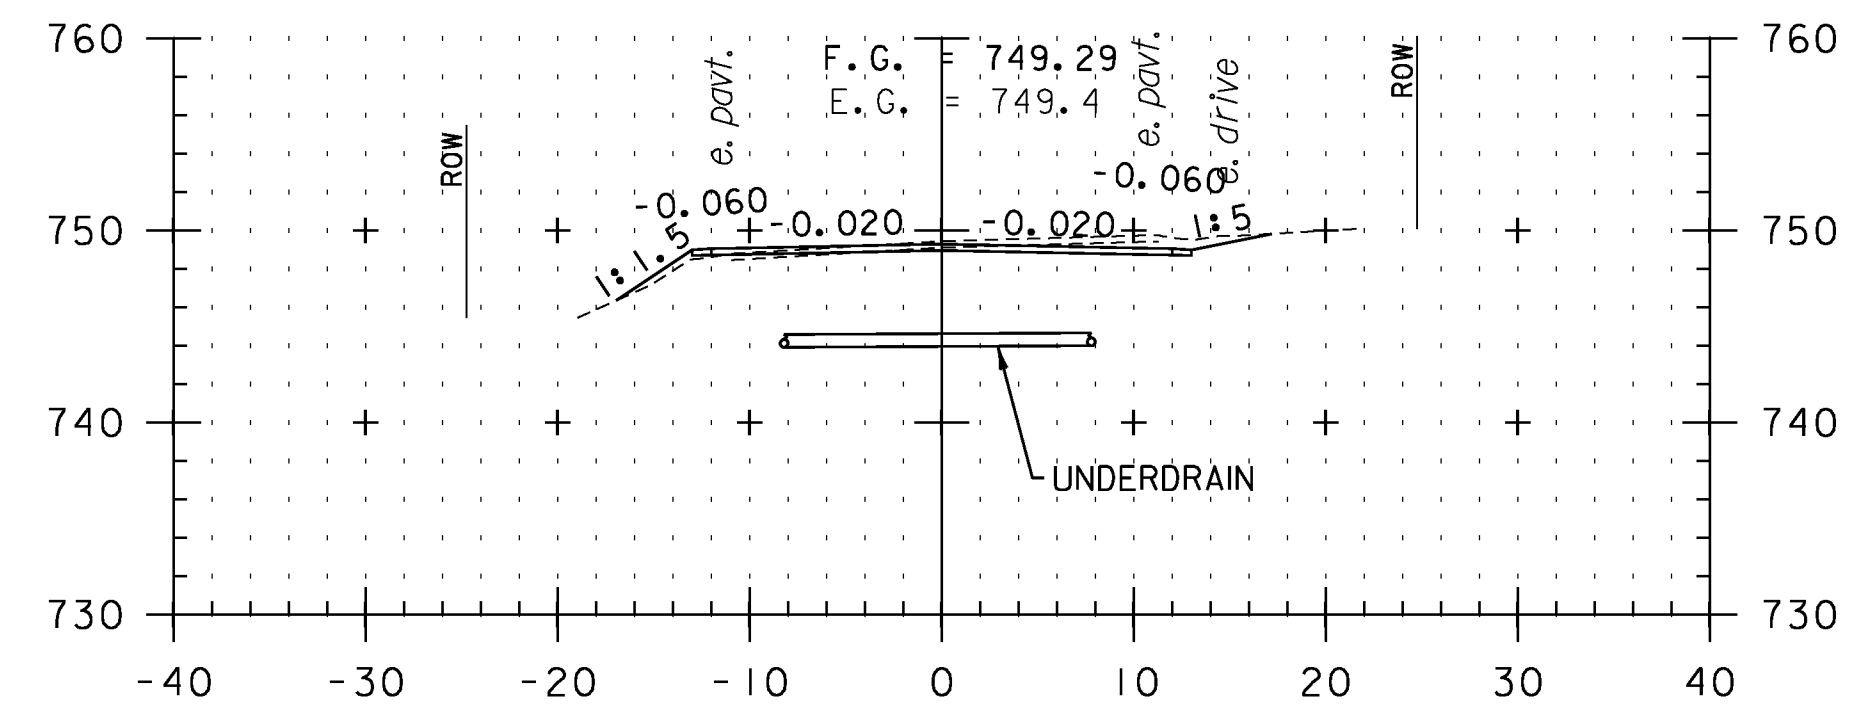


F89+00

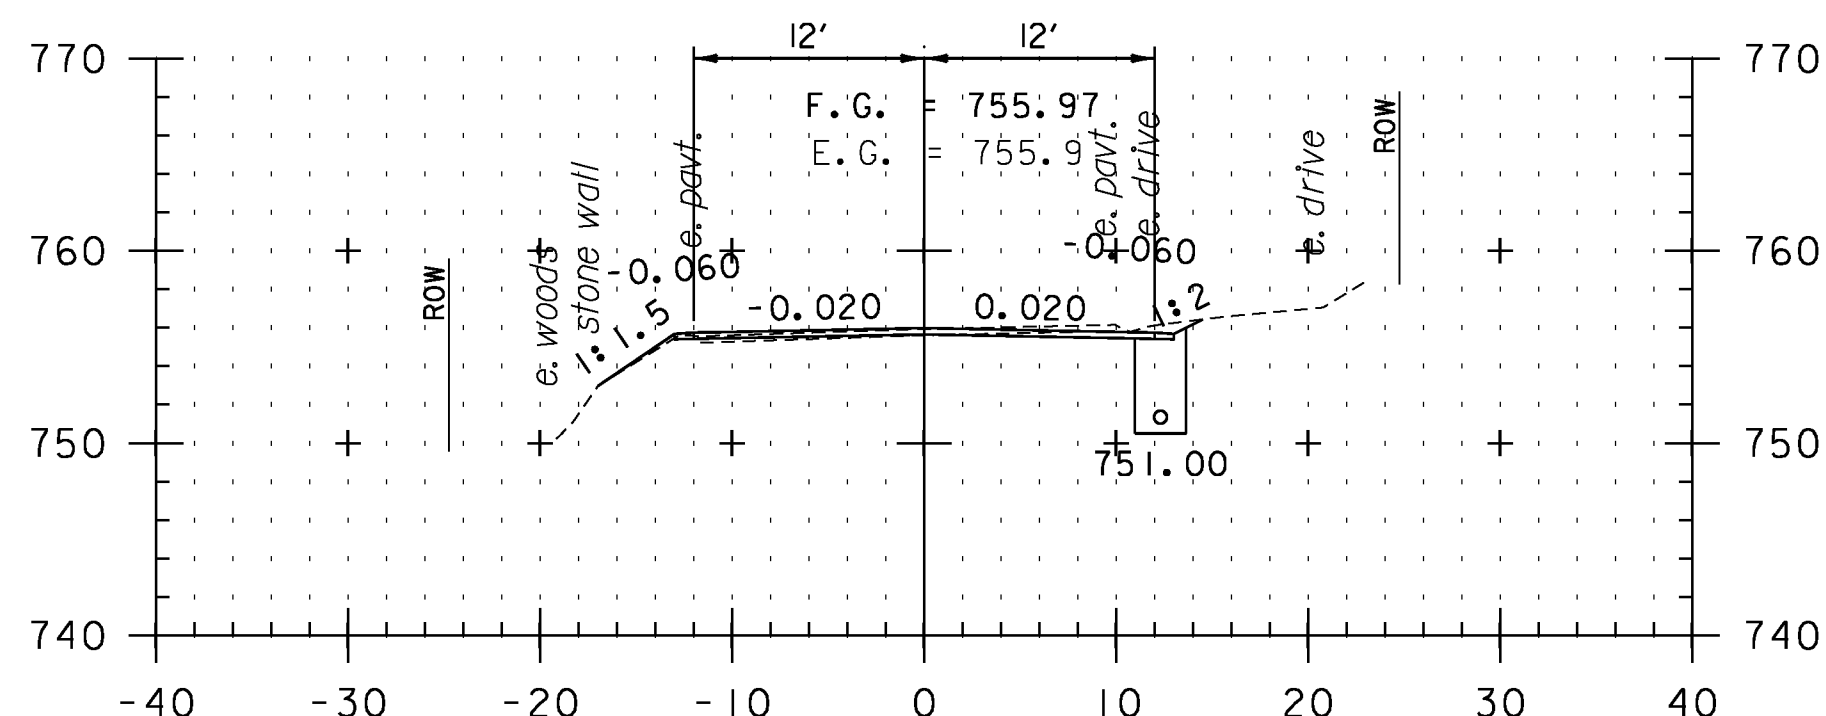

F85+50

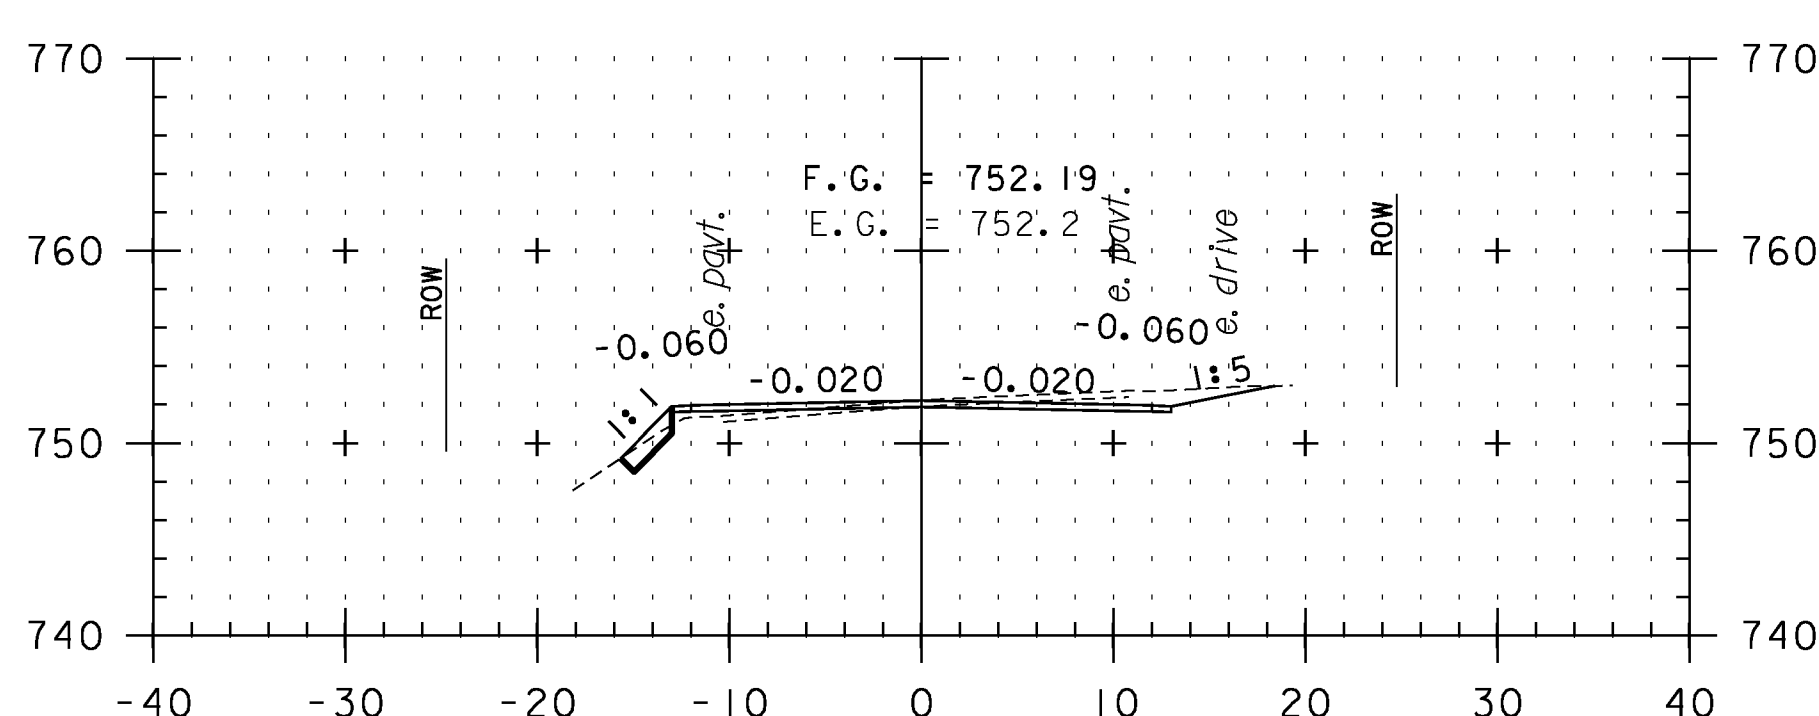


F87+00

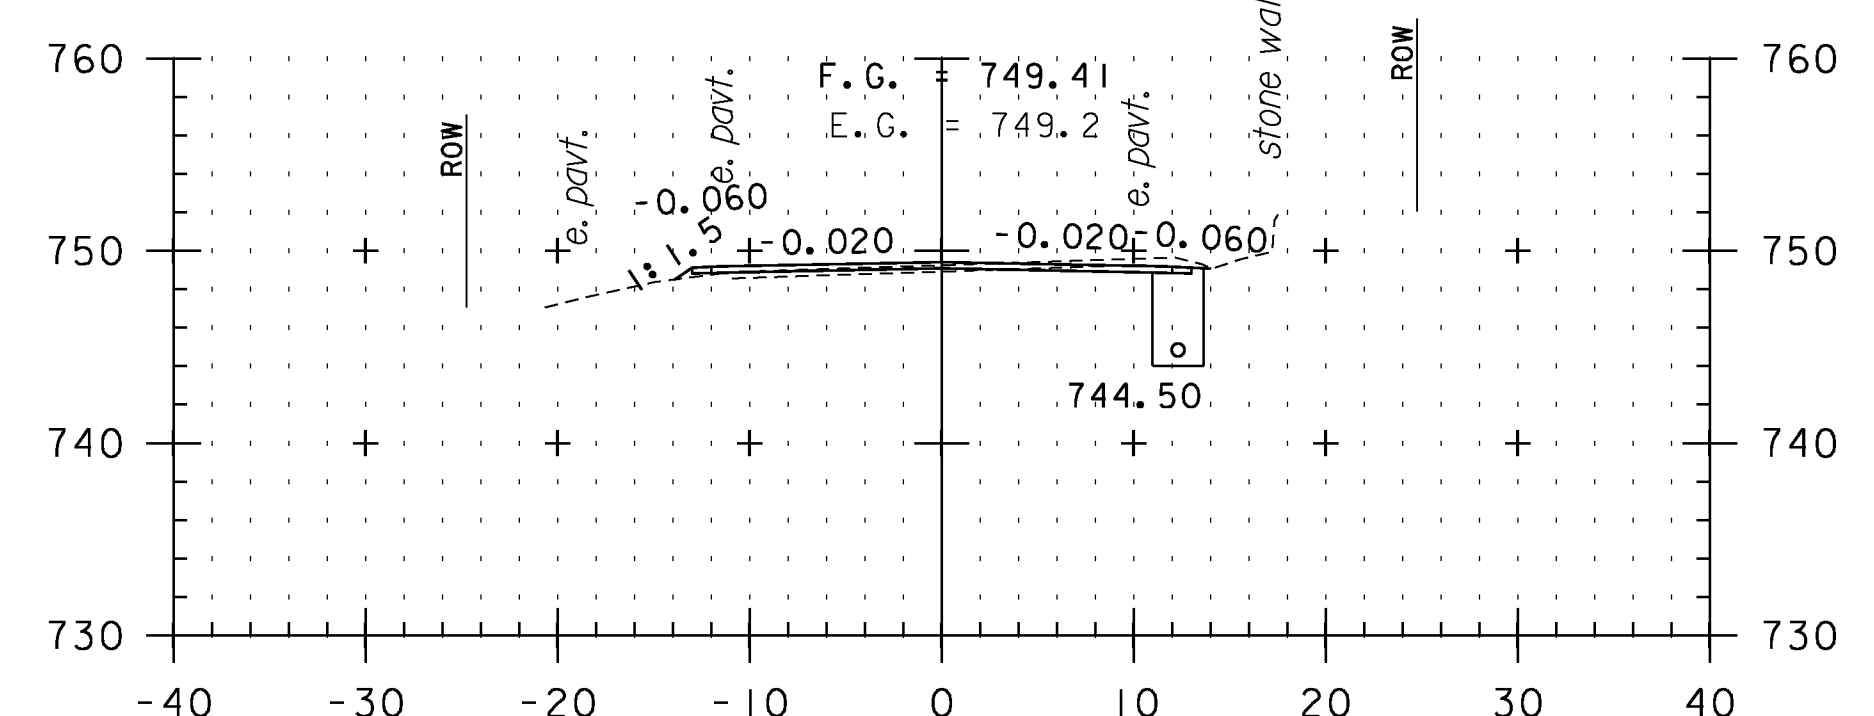

F88+50

CROSS SECTION SHEET 72

STA. F85+50 TO STA. F89+50

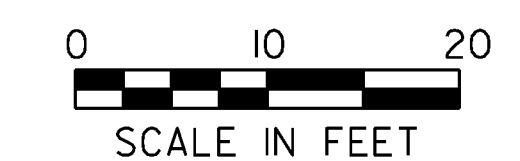

PROJECT NAME: VERSHIRE-THETFORD	
PROJECT NUMBER: STP 2911(I)	
FILE NAME: pl0c224.dgn	PLOT DATE: 1/29/2013
PROJECT LEADER: PTS	DRAWN BY: SNG
DESIGNED BY: NLL	CHECKED BY: PTS
IPARM FILE NAME: IOC224_180	SHEET 180 OF 232