




F91+00

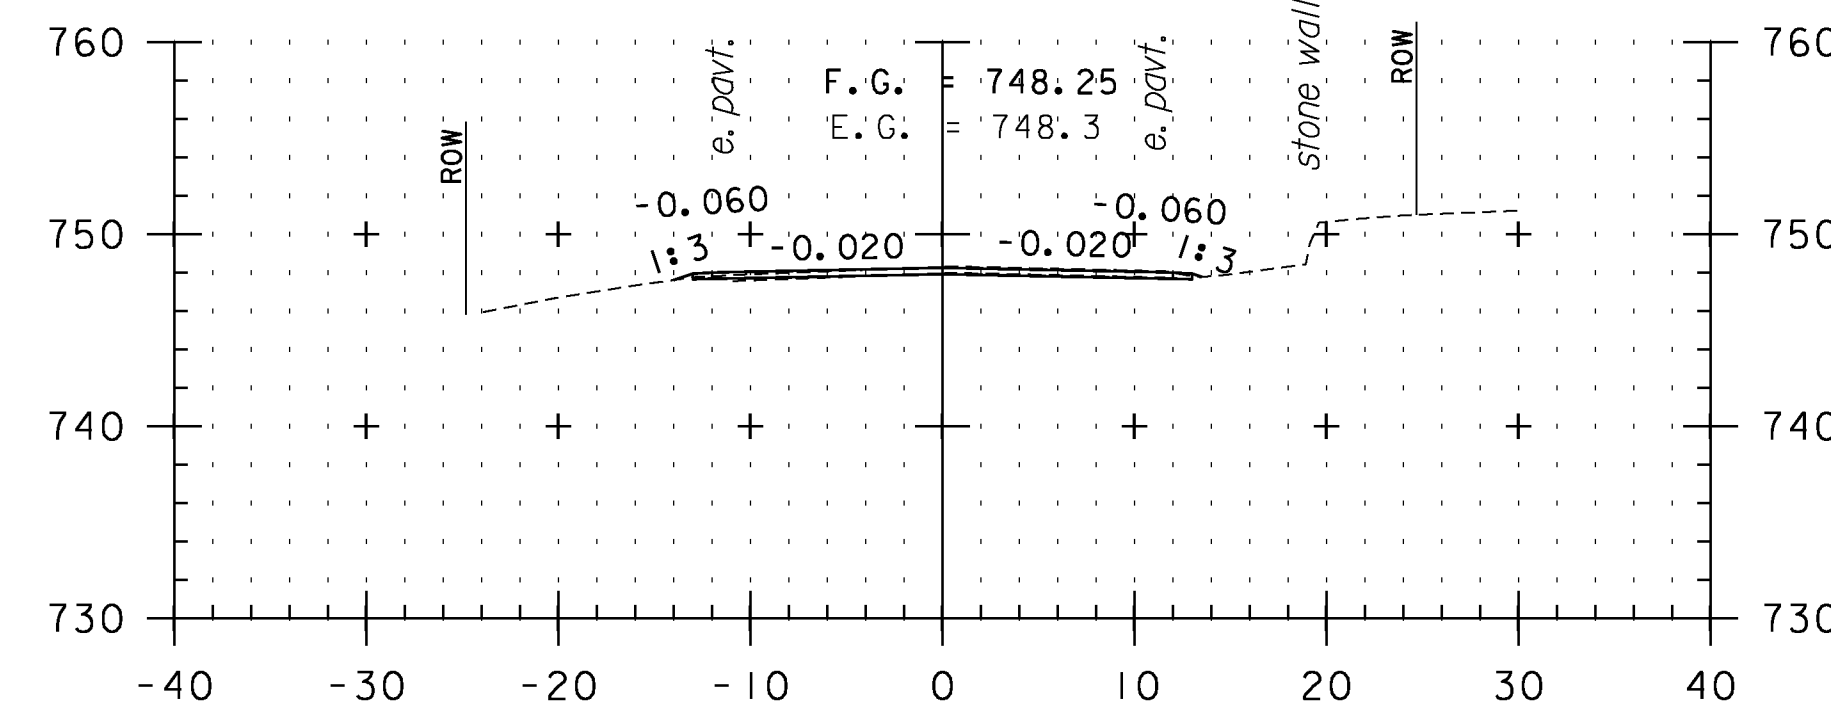


F92+50

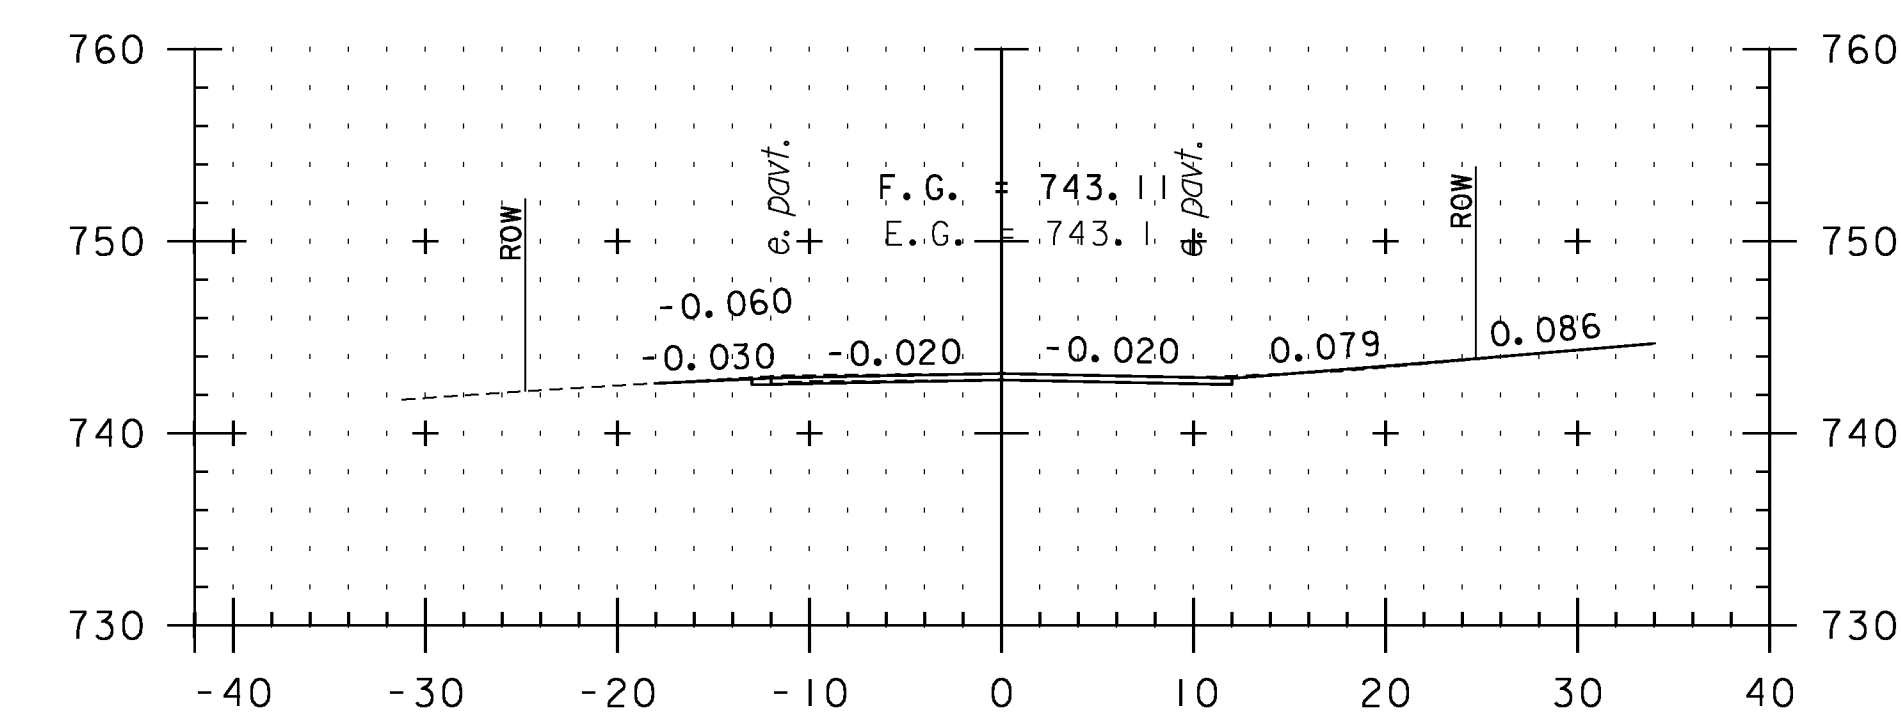


F93+75
TH 30

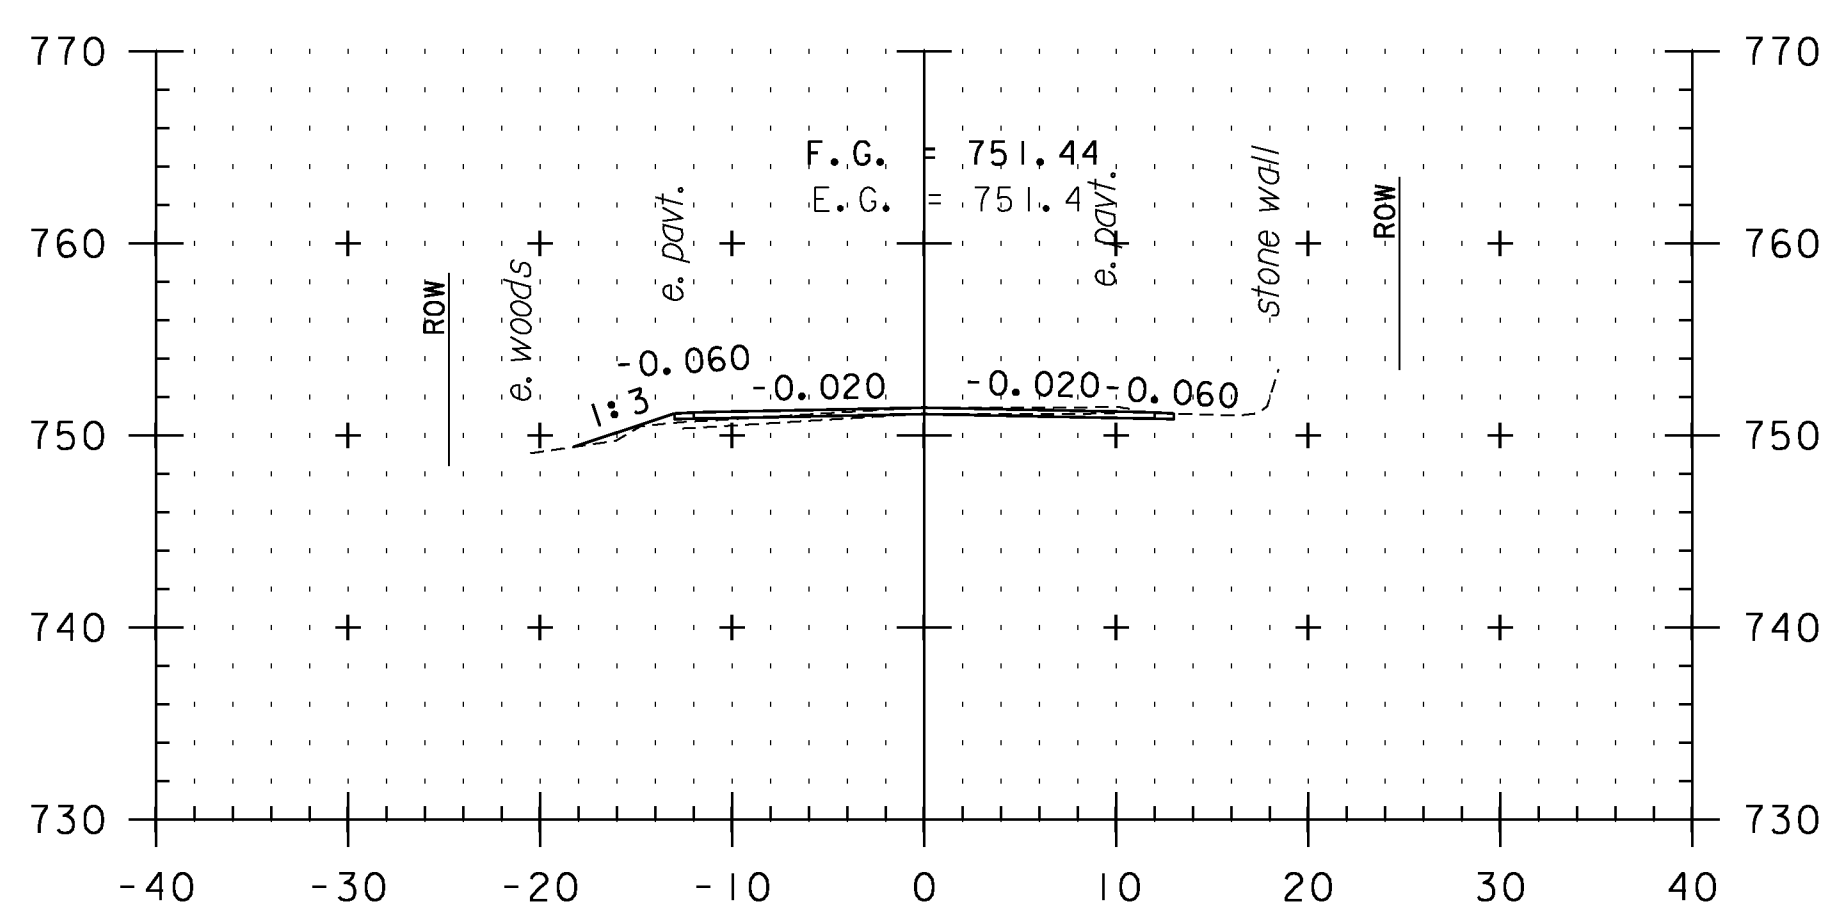


F90+50

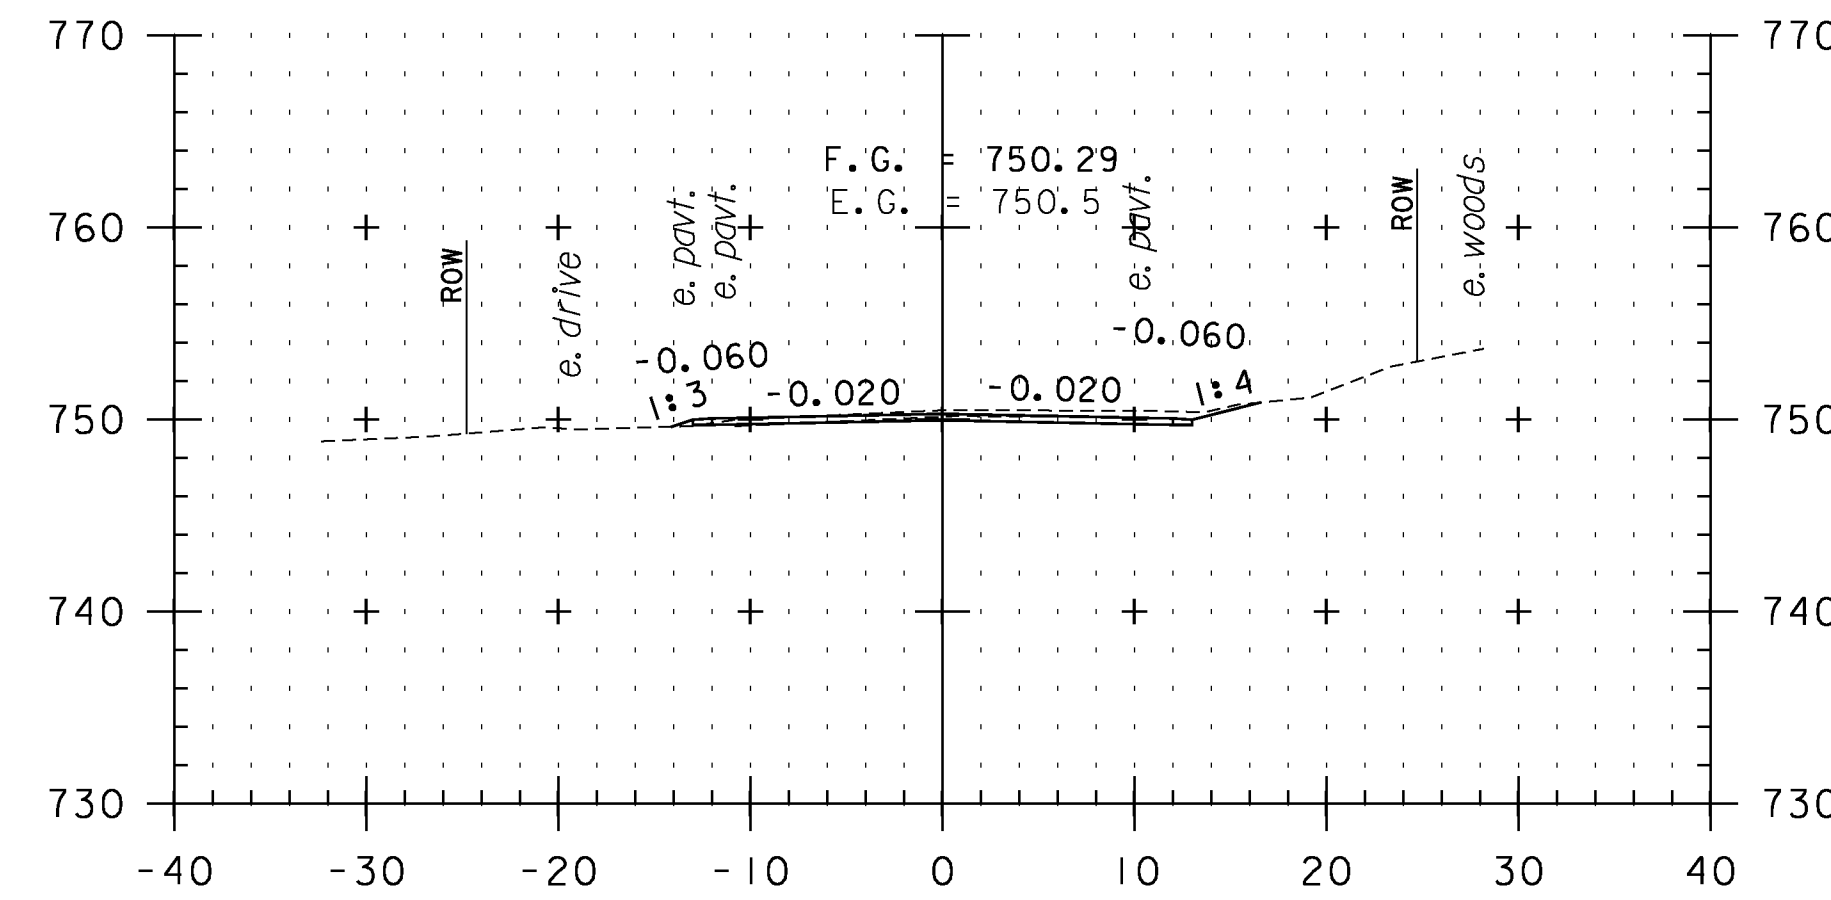


F92+00

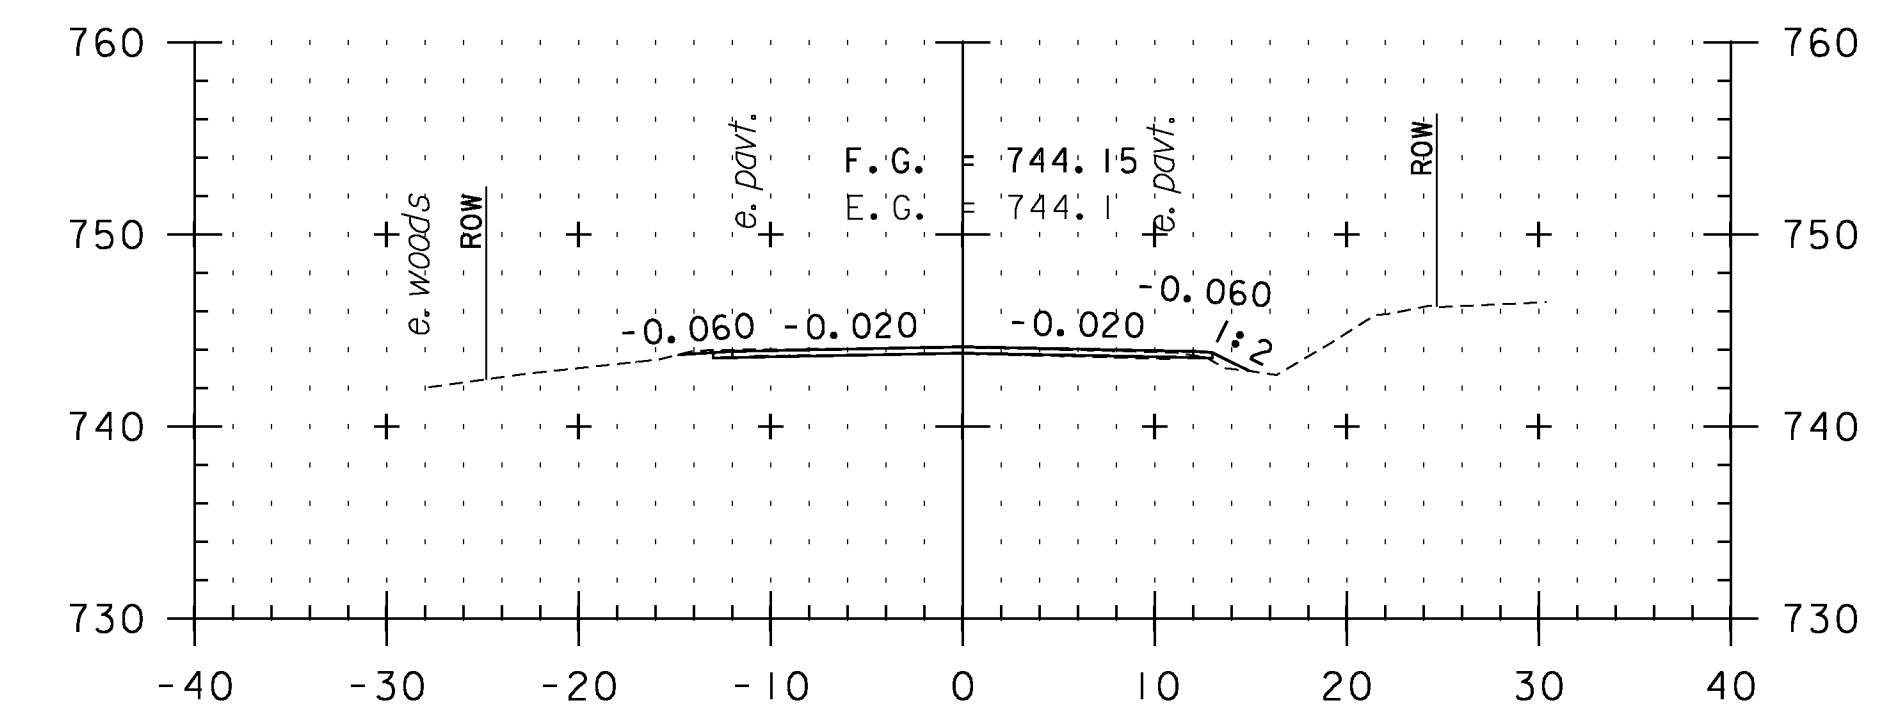


F93+50

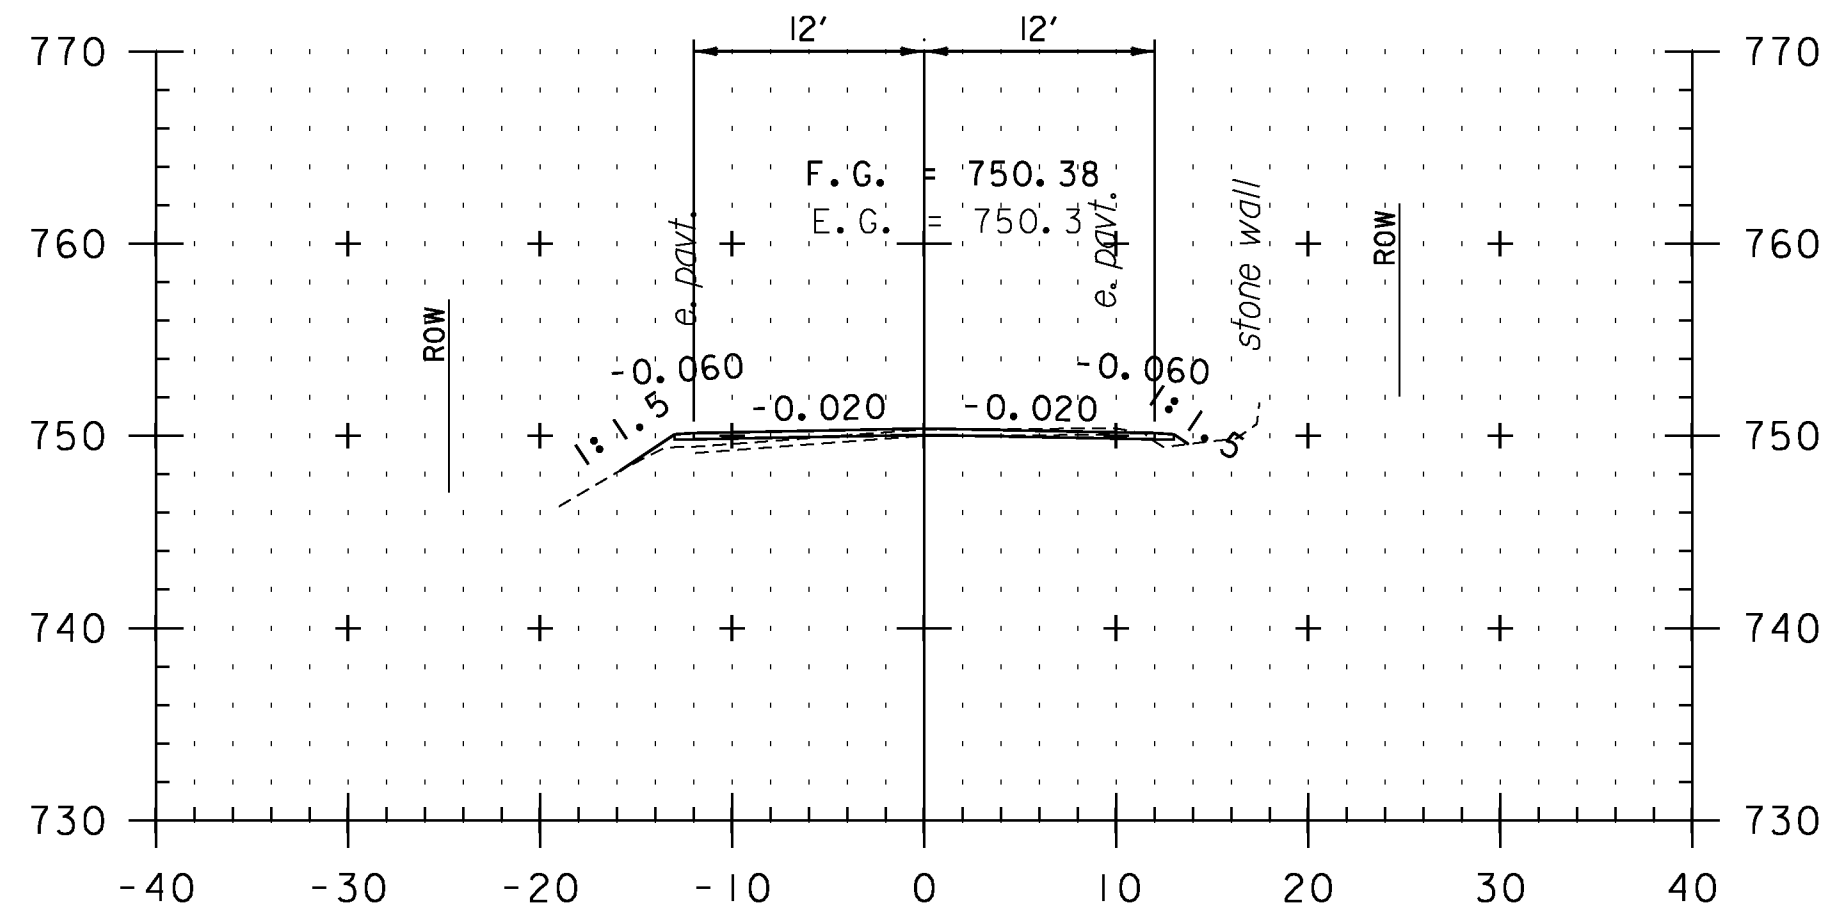

F90+00

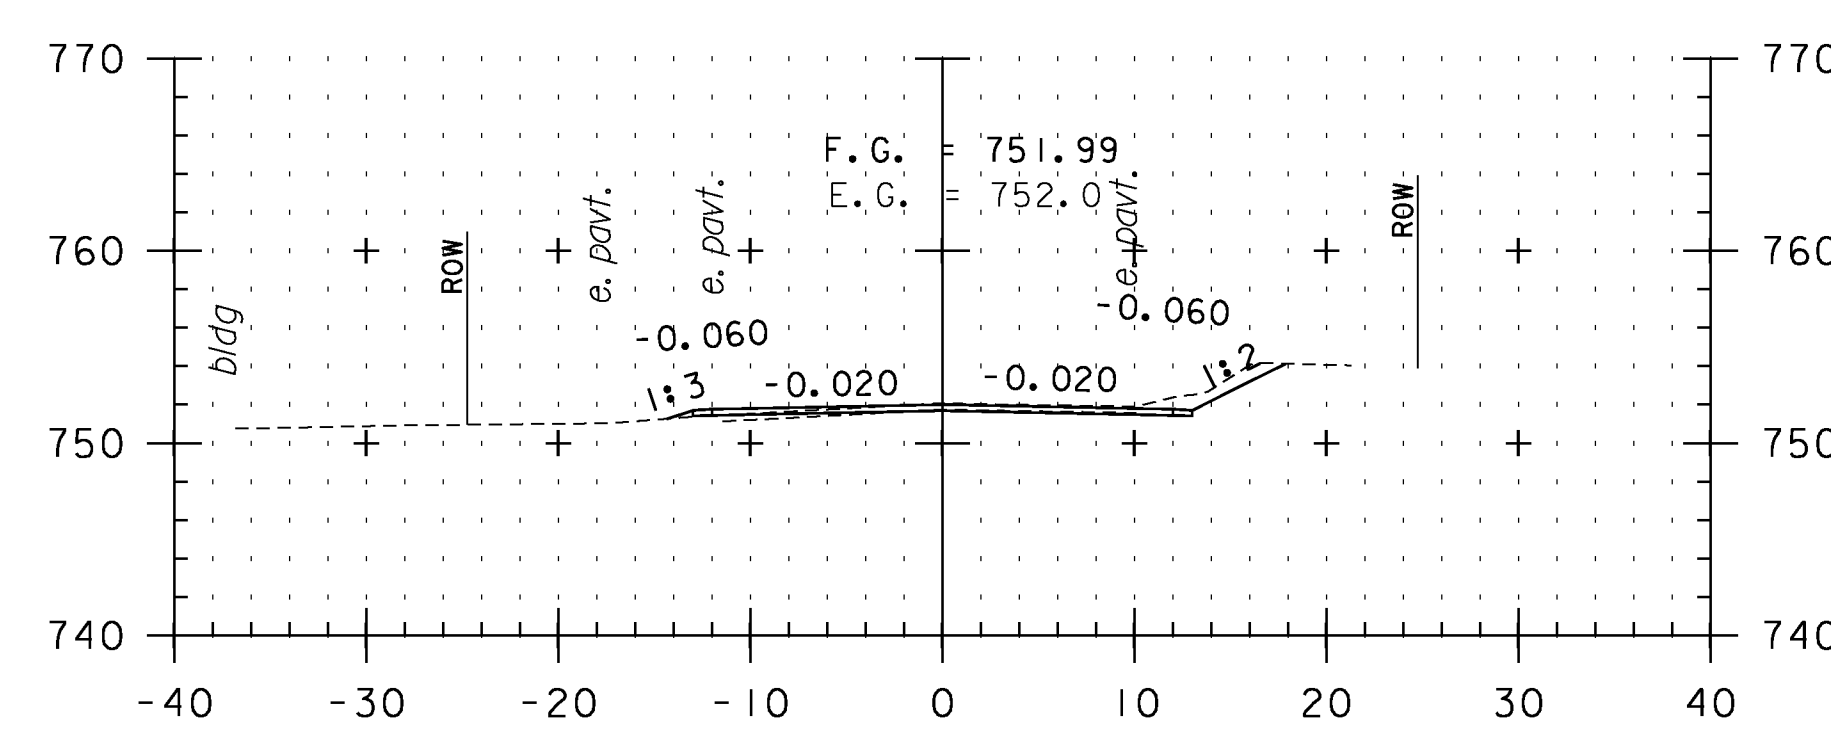


F91+50

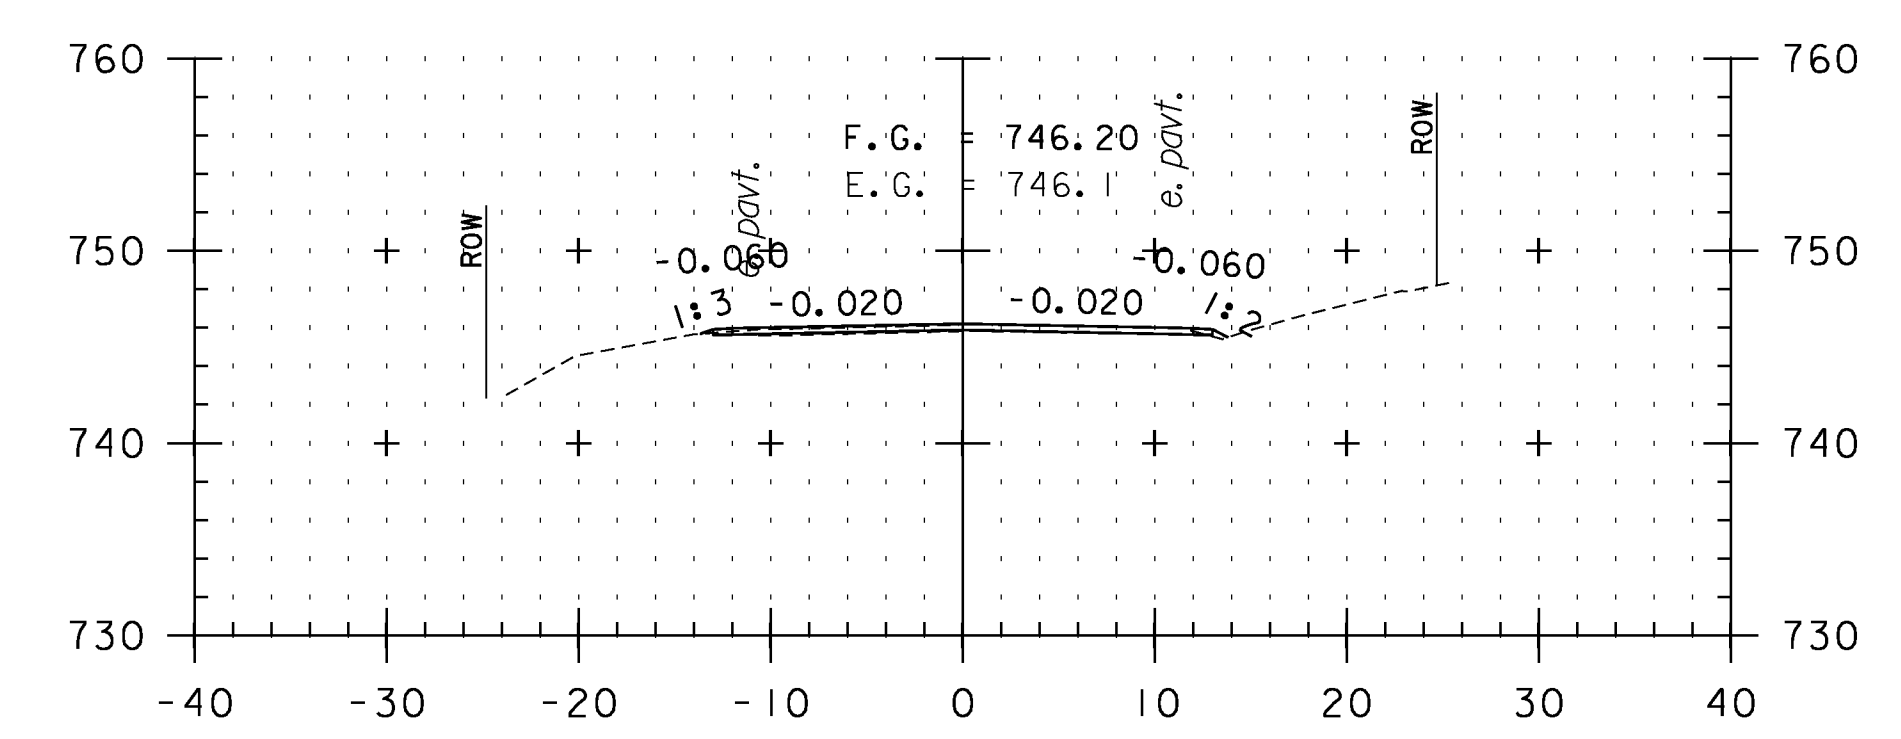

F93+00

CROSS SECTION SHEET 73

STA. F90+00 TO STA. F93+75

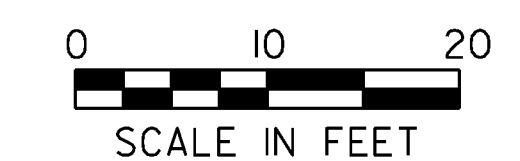

PROJECT NAME: VERSHIRE-THETFORD	PLOT DATE: 1/29/2013
PROJECT NUMBER: STP 2911(I)	DRAWN BY: SNG
FILE NAME: pl0c224.dgn	CHECKED BY: PTS
PROJECT LEADER: PTS	SHEET 181 OF 232
DESIGNED BY: NULL	
IPARM FILE NAME: IOC224_181	