




F95+00

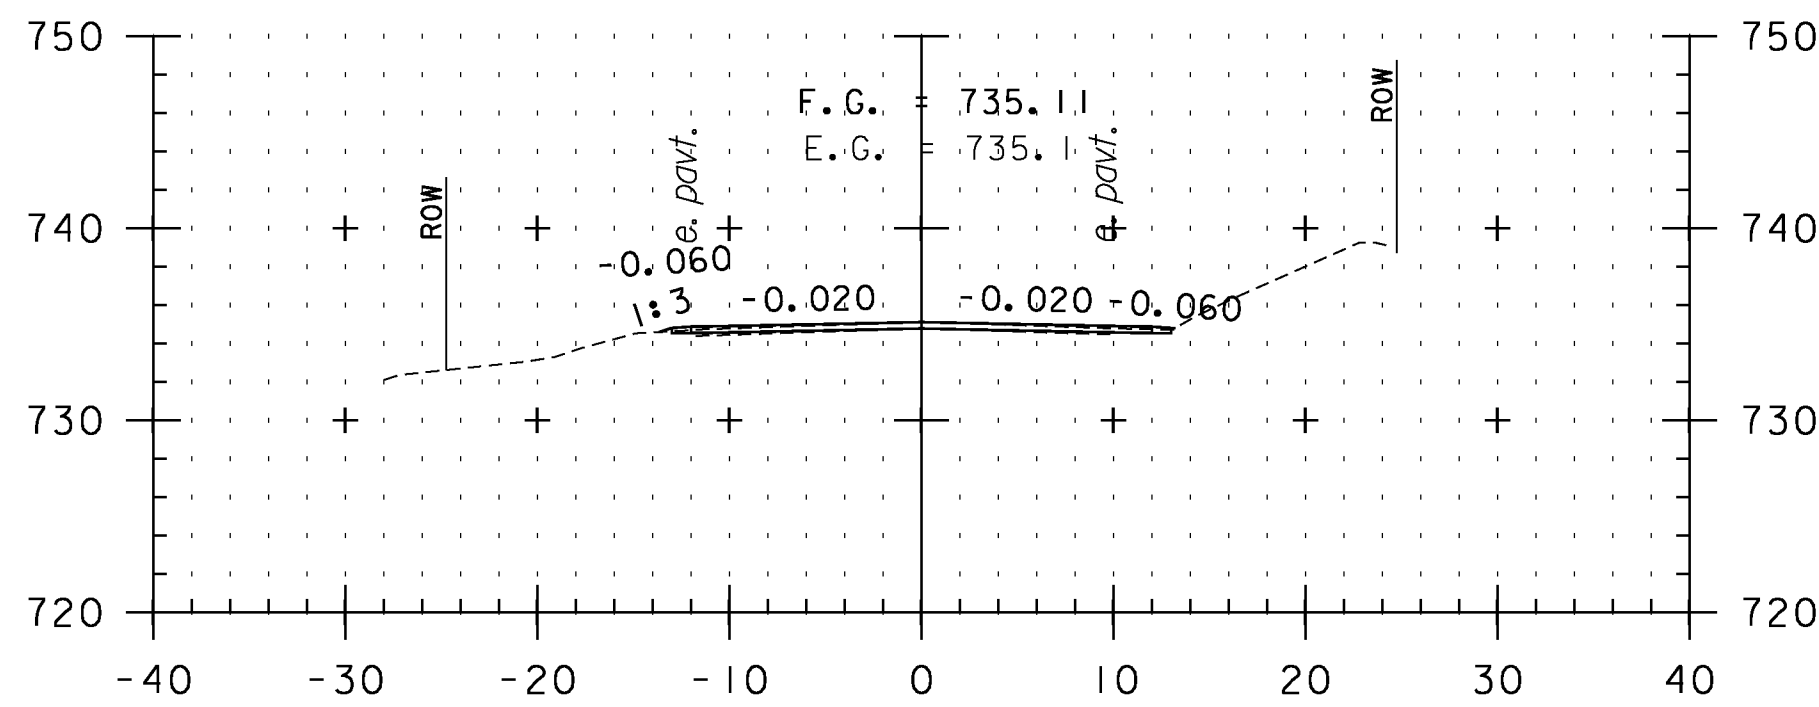


F96+50

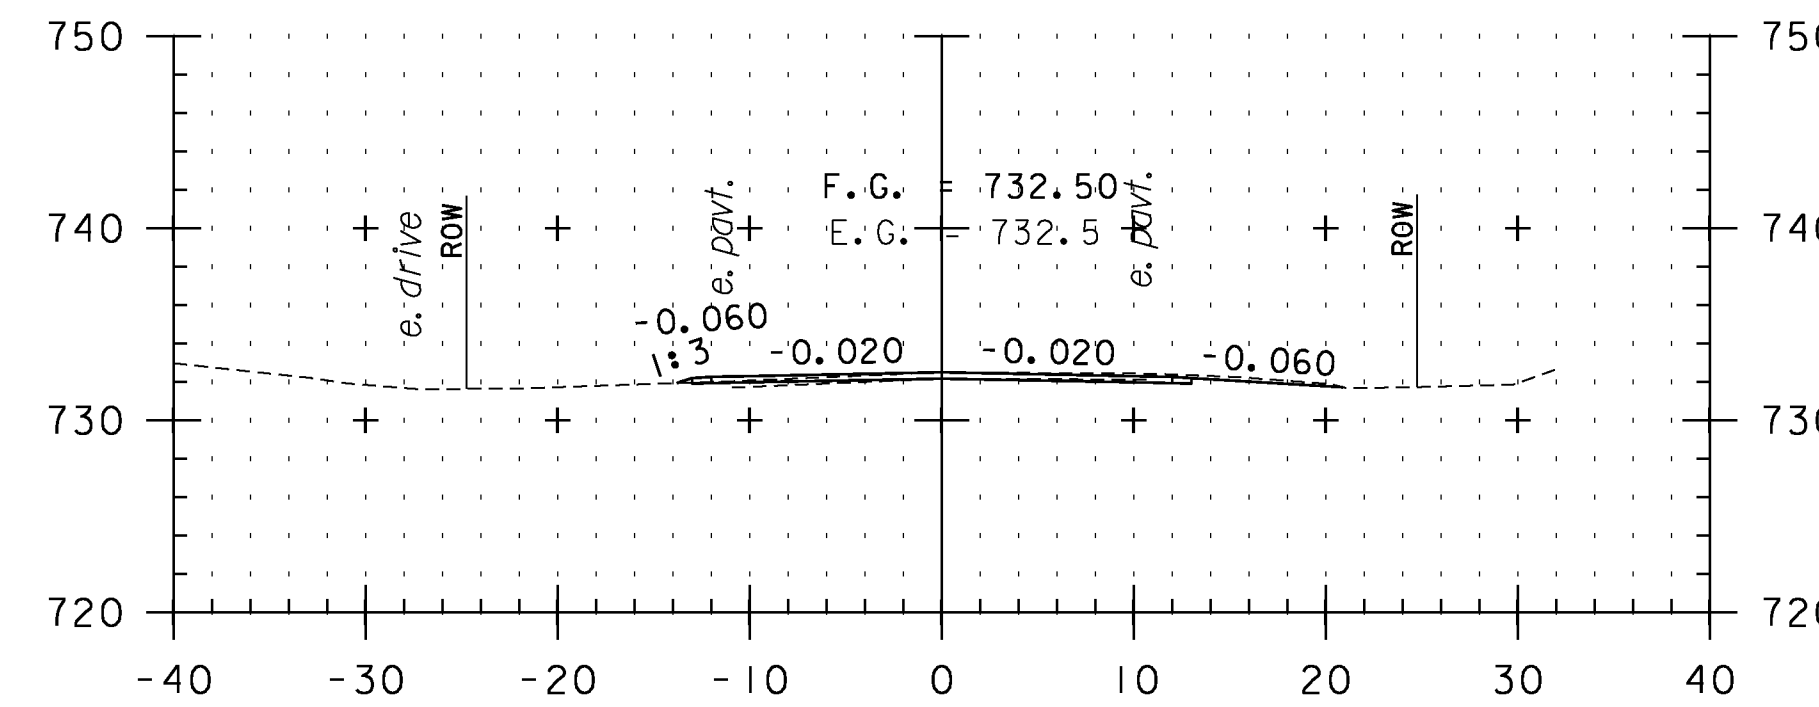


F98+00

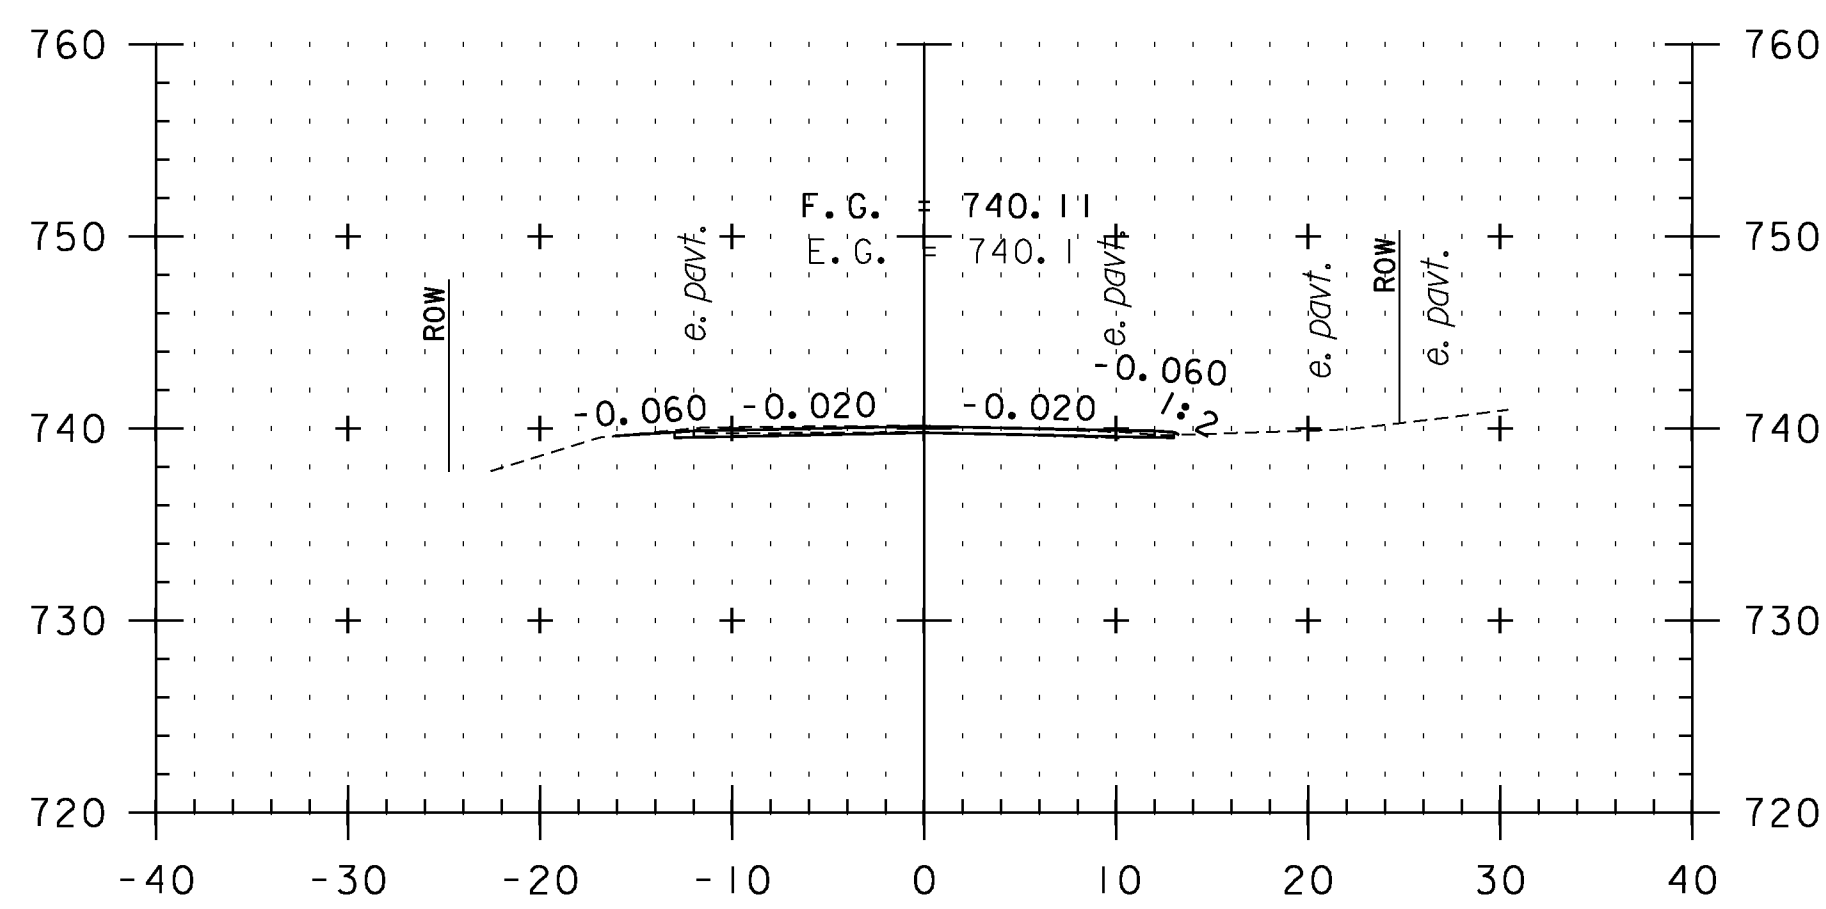


F94+50

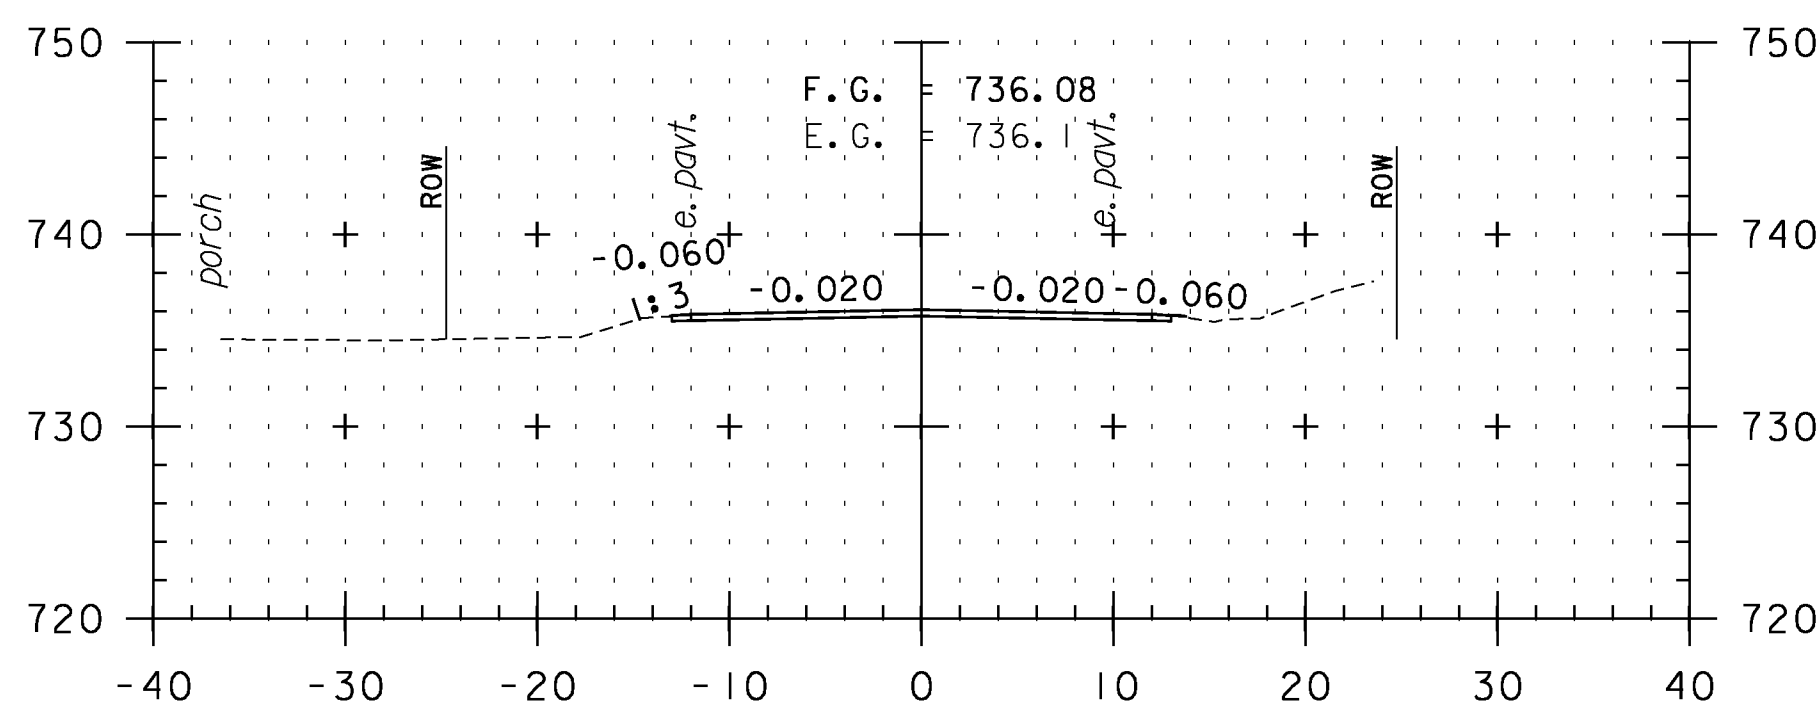


F96+00

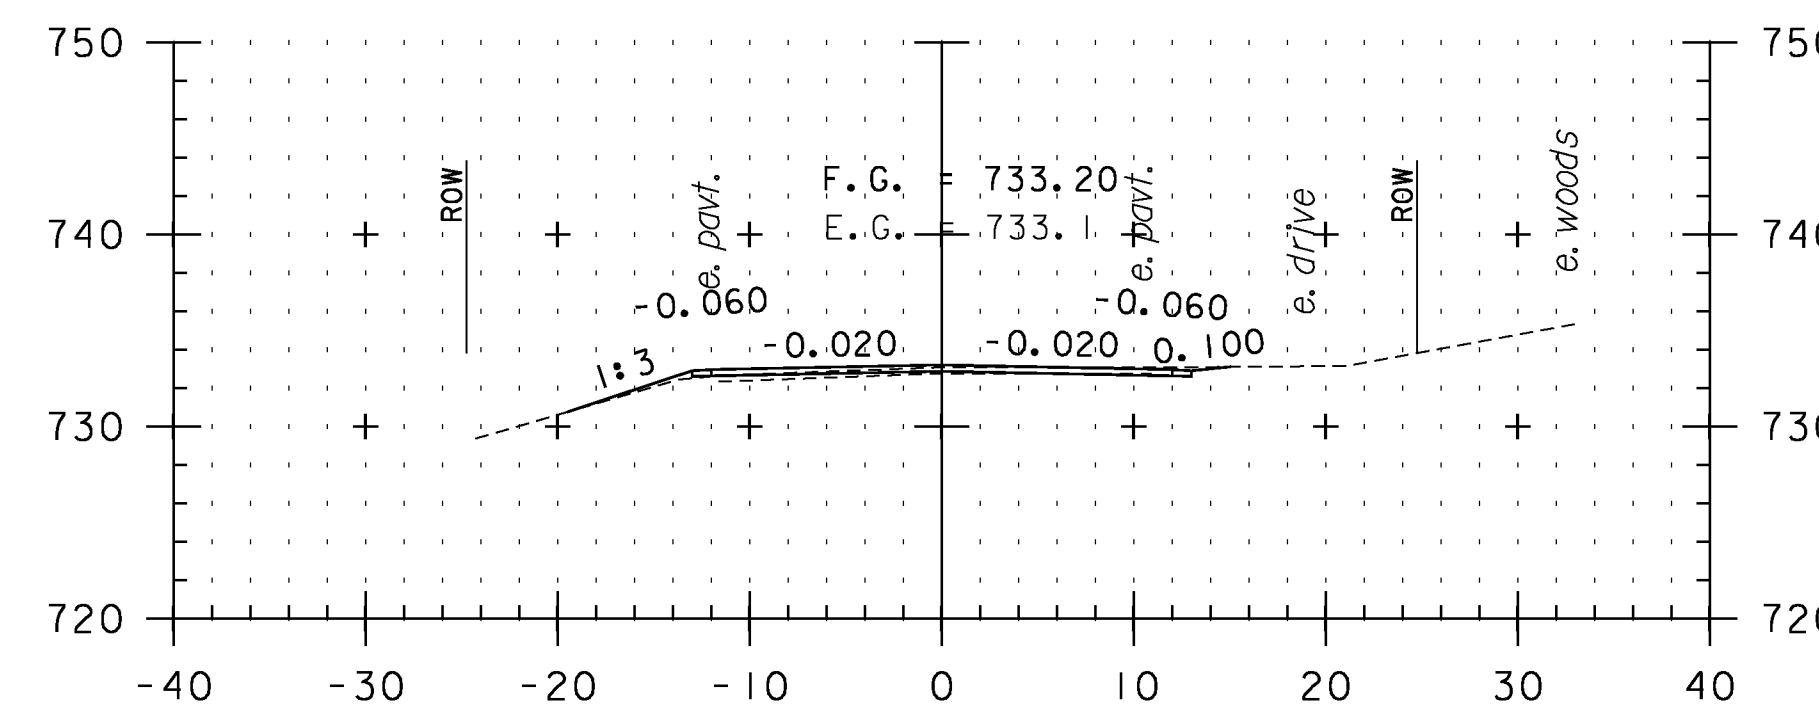


F97+50

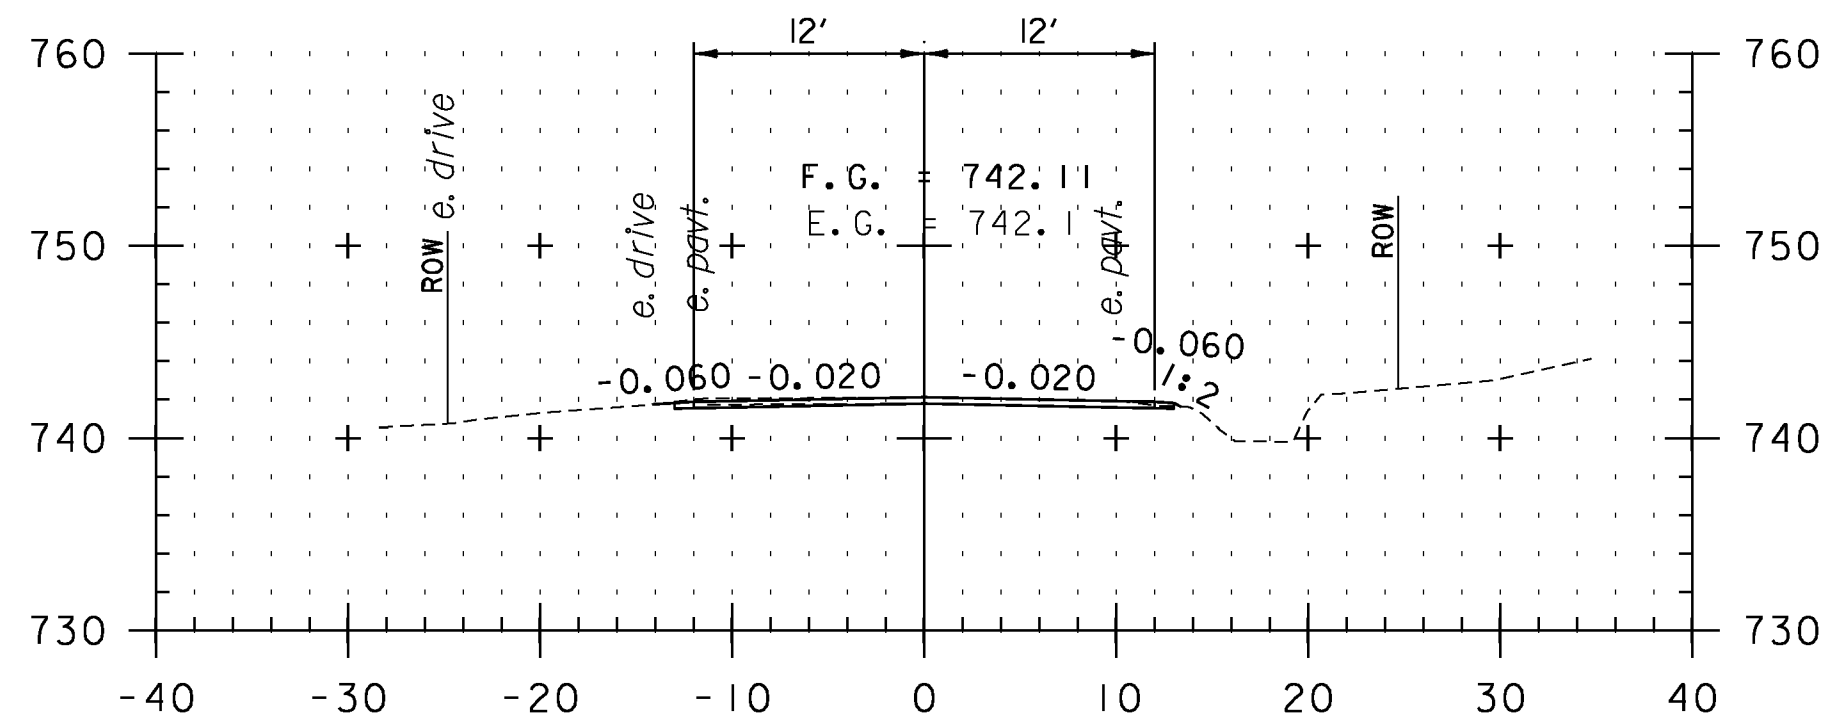

F94+00

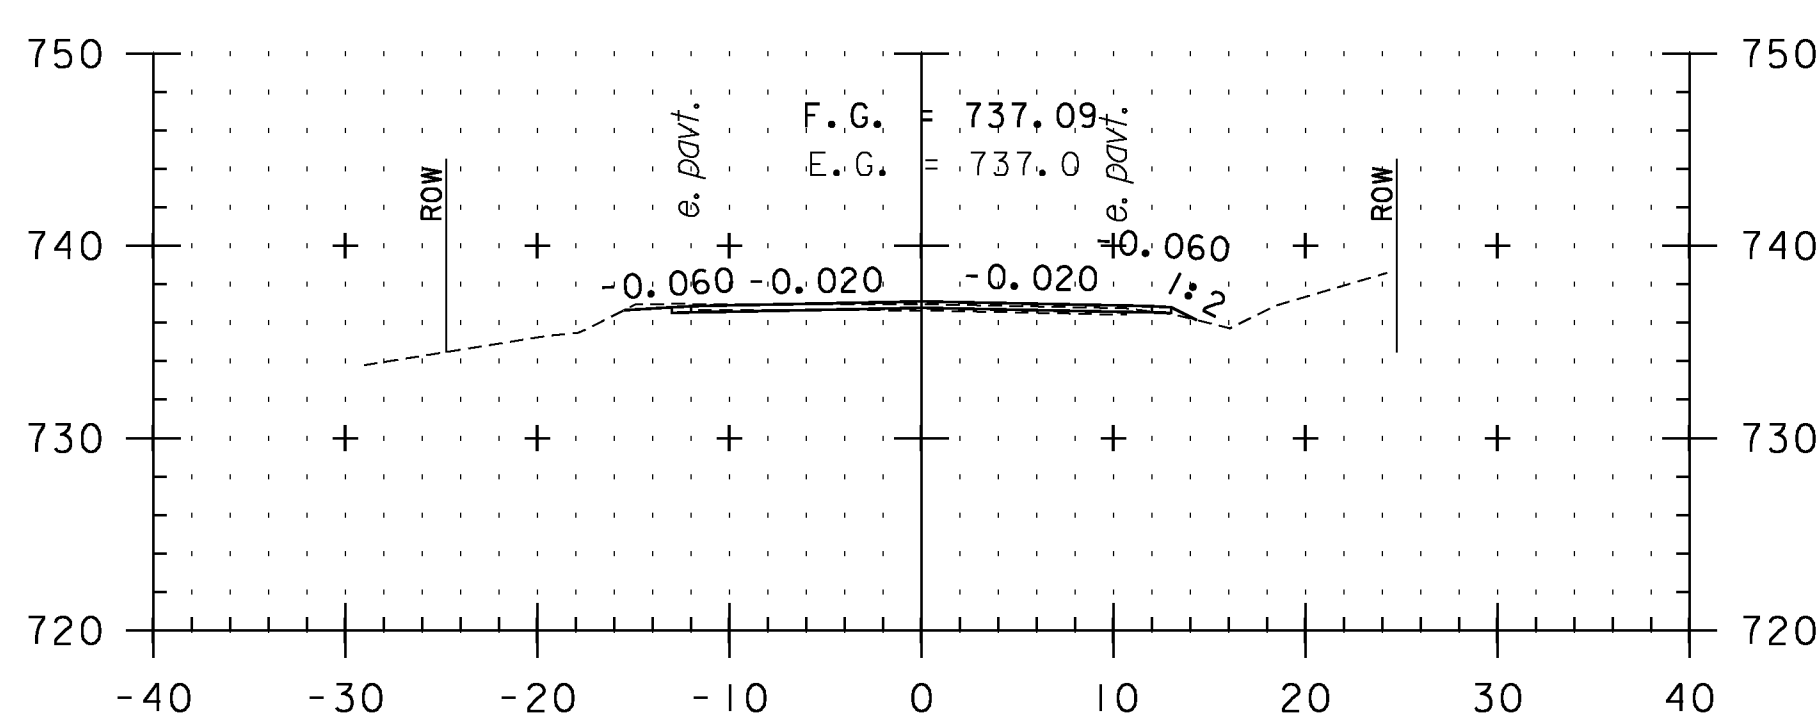

F95+50

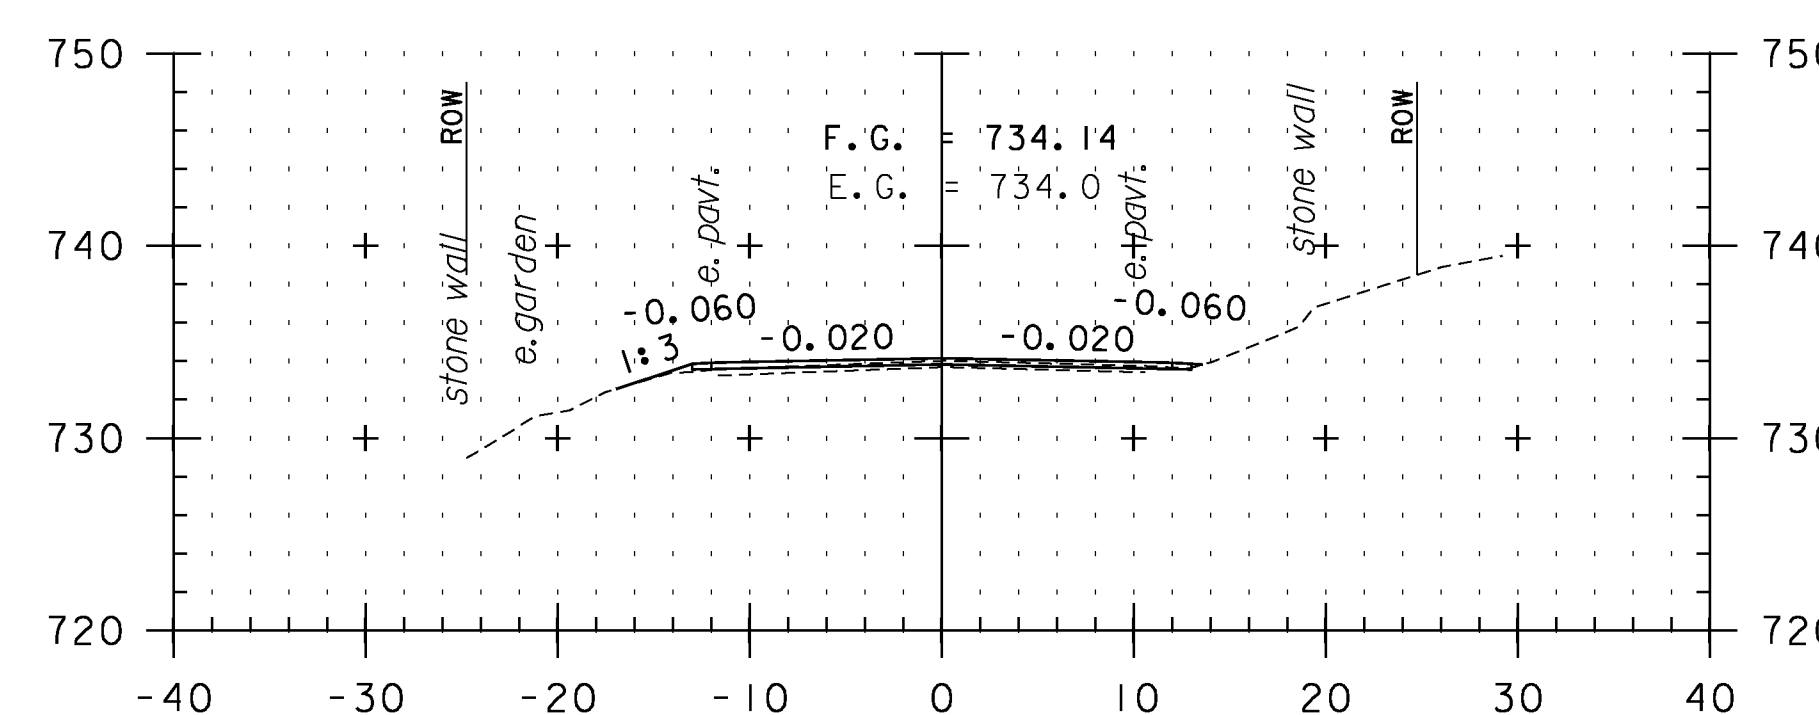

F97+00

CROSS SECTION SHEET 74

PROJECT NAME: VERSHIRE-THETFORD	PLOT DATE: 1/29/2013
PROJECT NUMBER: STP 2911(I)	DRAWN BY: SNG
FILE NAME: pl0c224.dgn	CHECKED BY: PTS
PROJECT LEADER: PTS	SHEET 182 OF 232
DESIGNED BY: NLL	
IPARM FILE NAME: IOC224_182	

STA. F94+00 TO STA. F98+00

