




F99+50

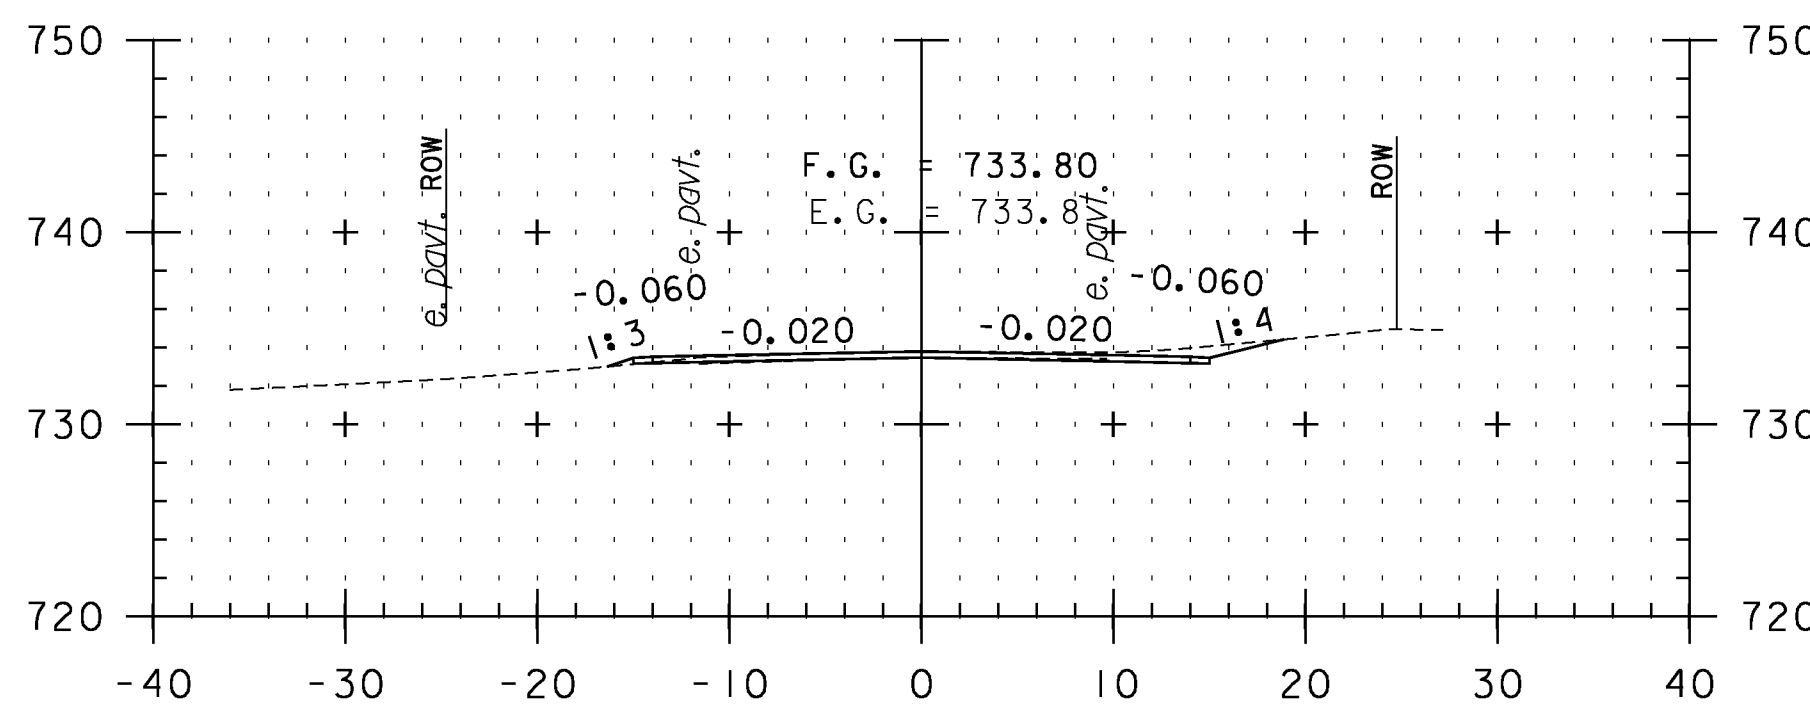


F101+00

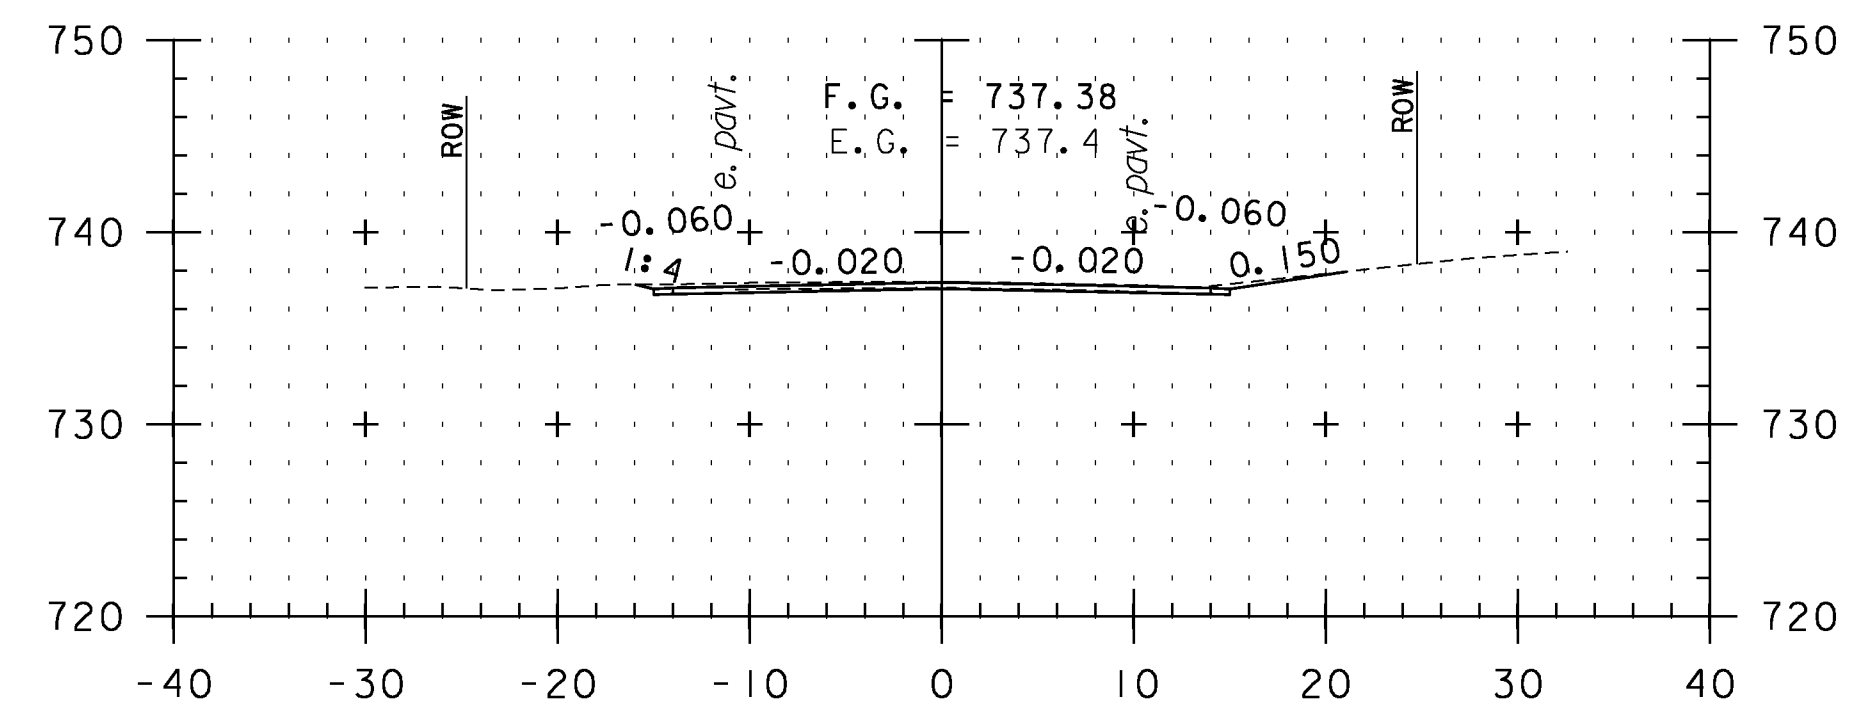


F102+50

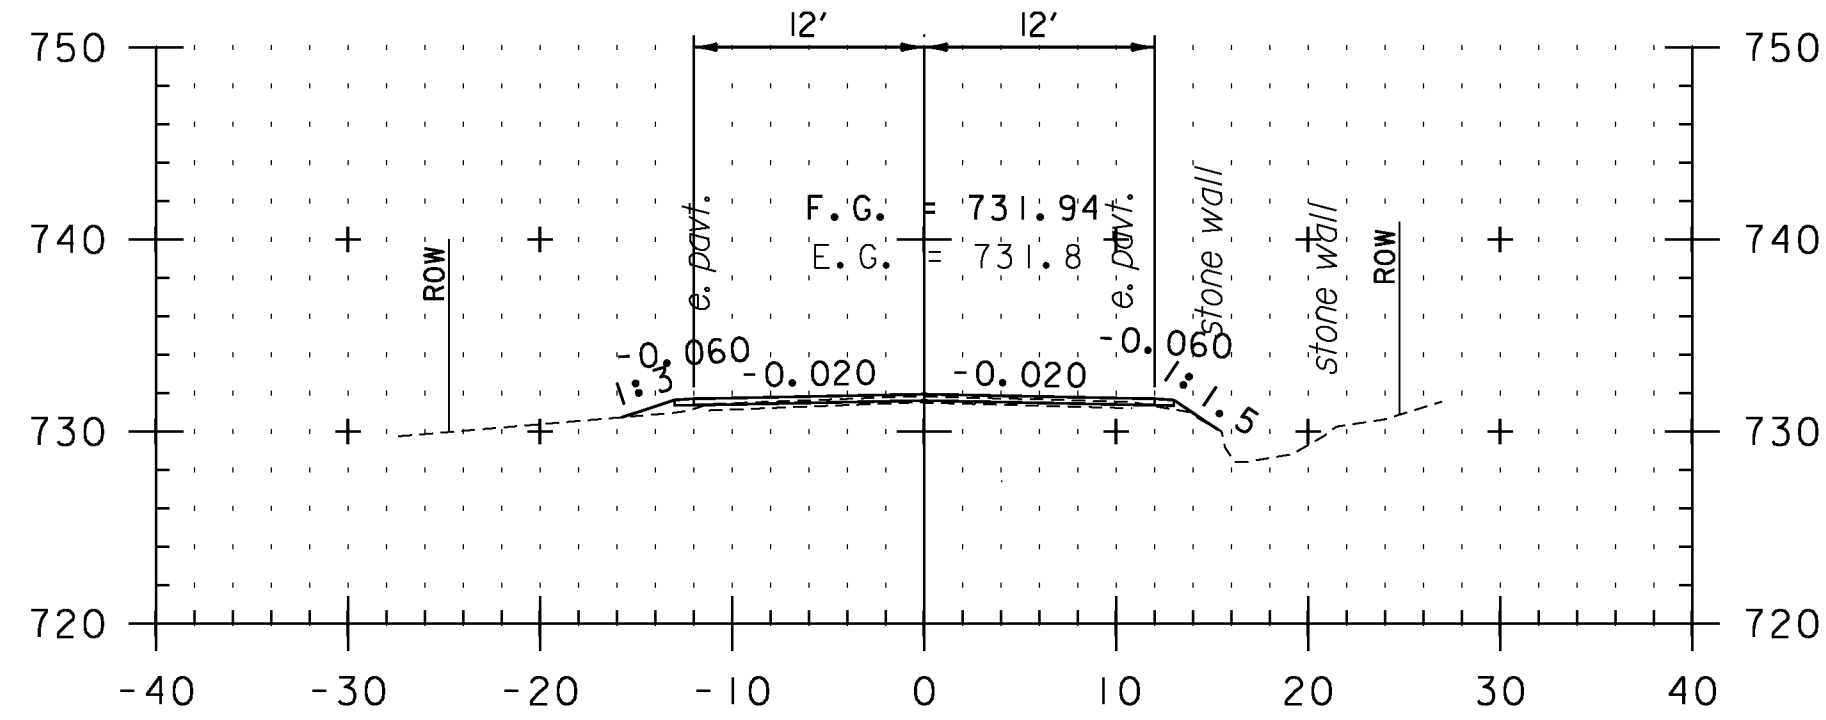


F99+00

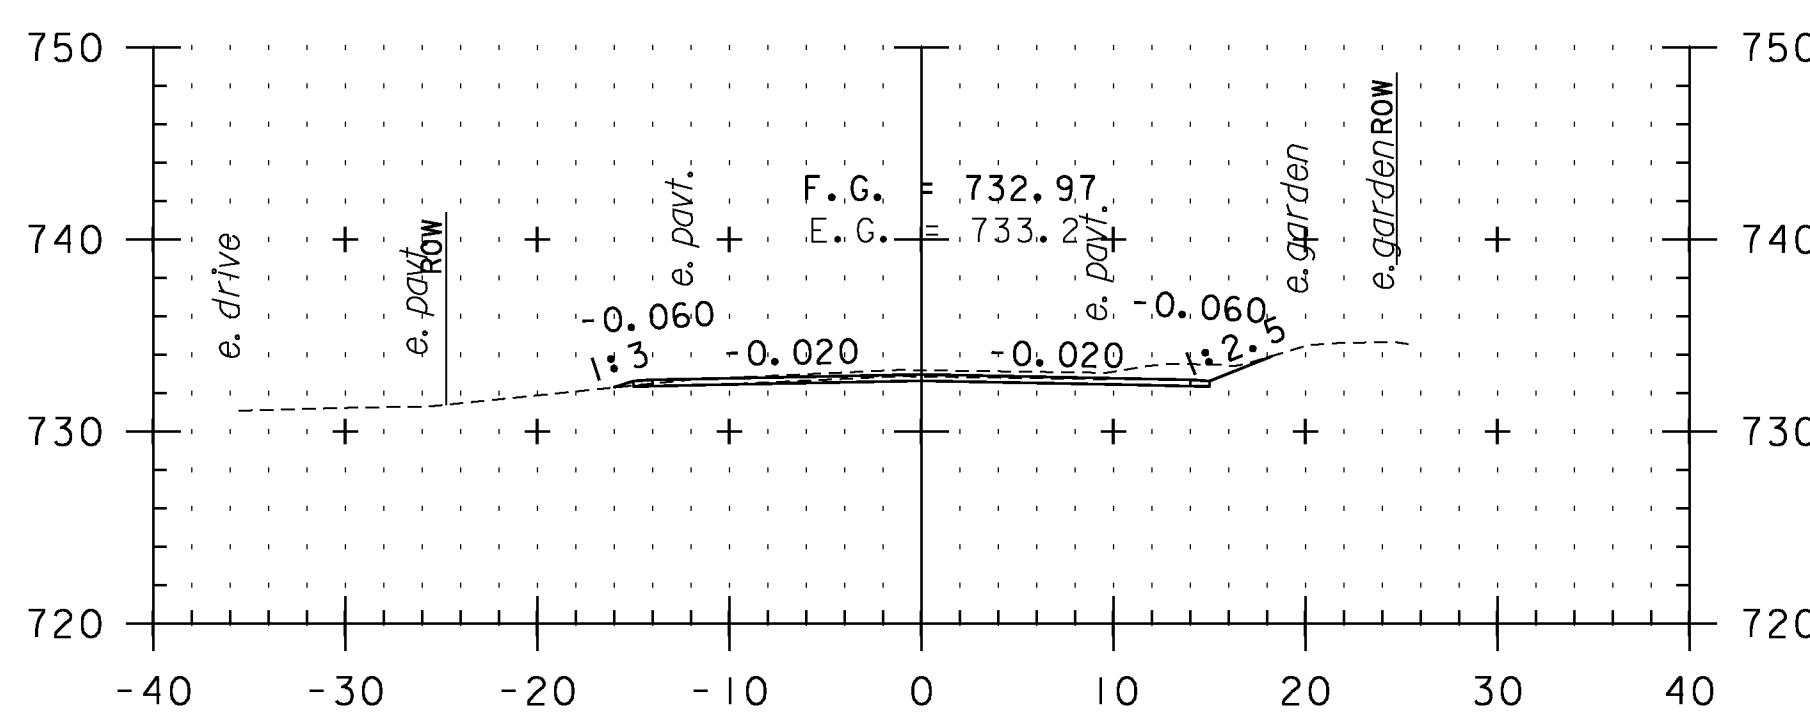


F100+50

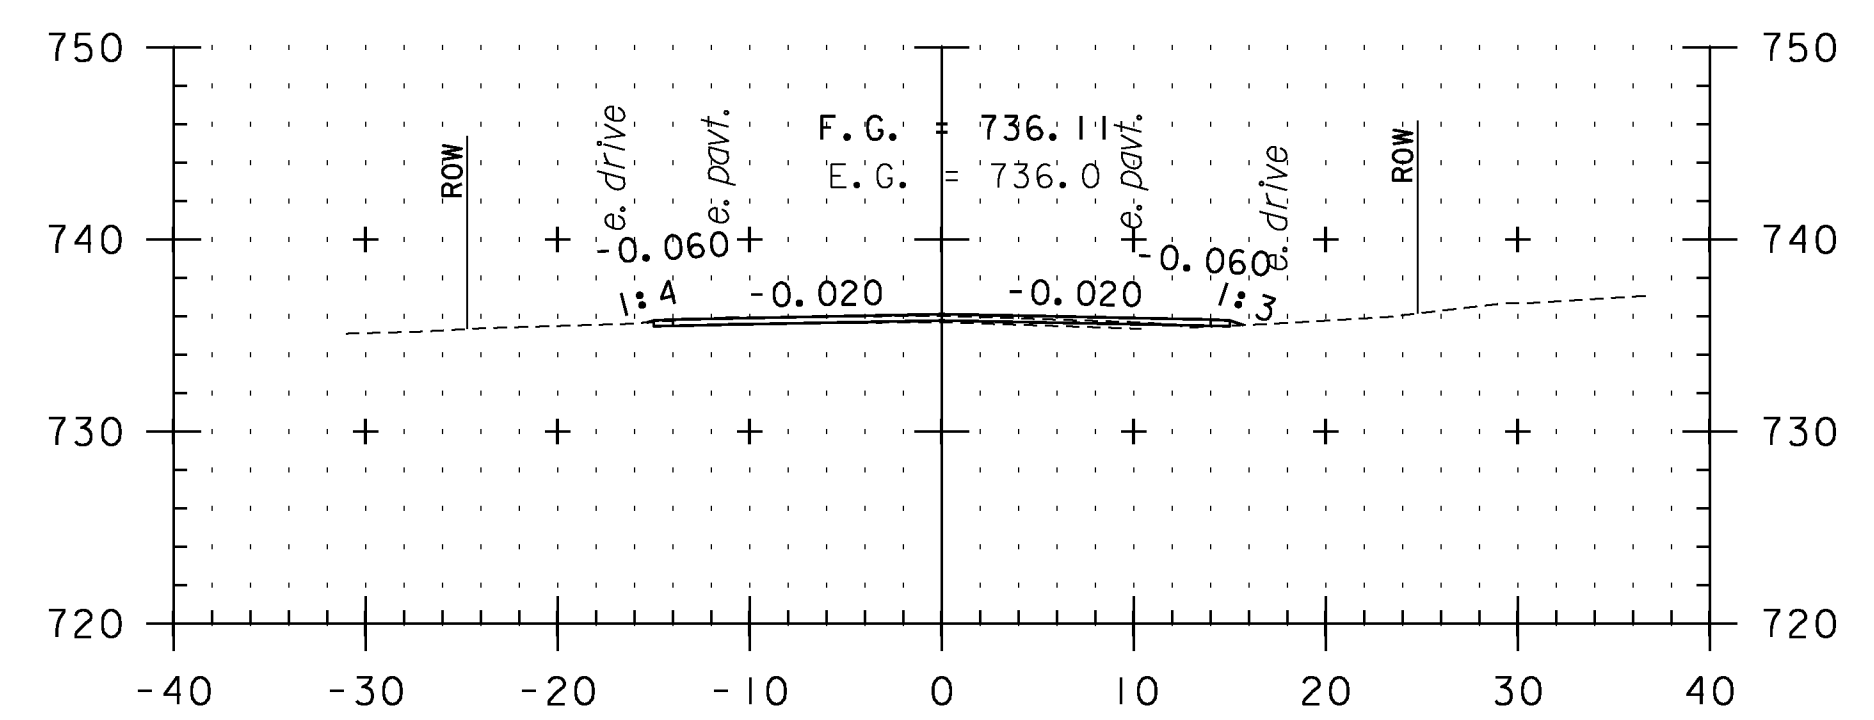


F102+00

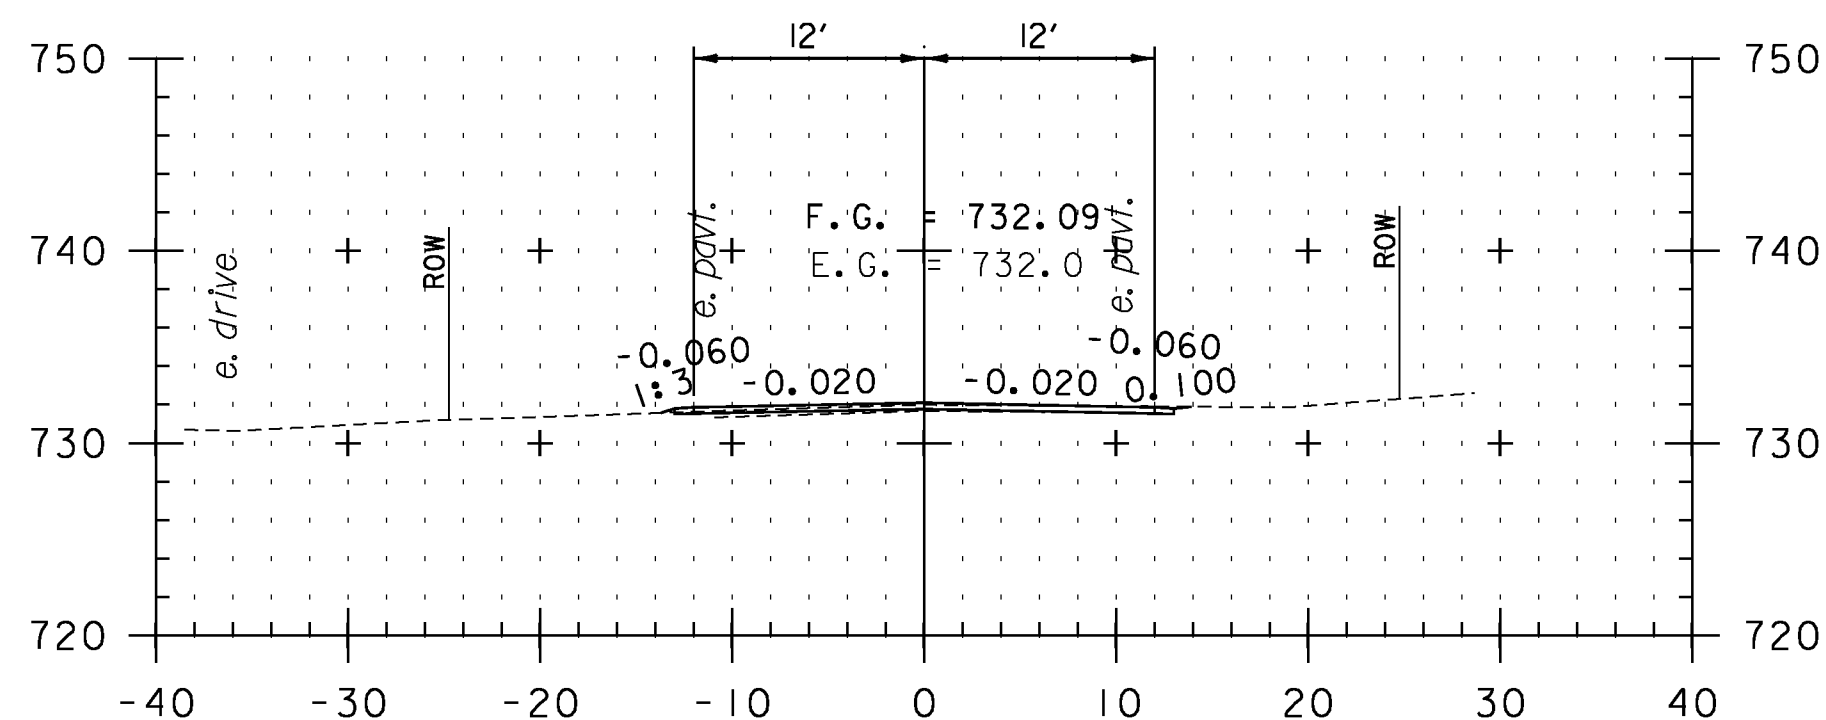

F98+50

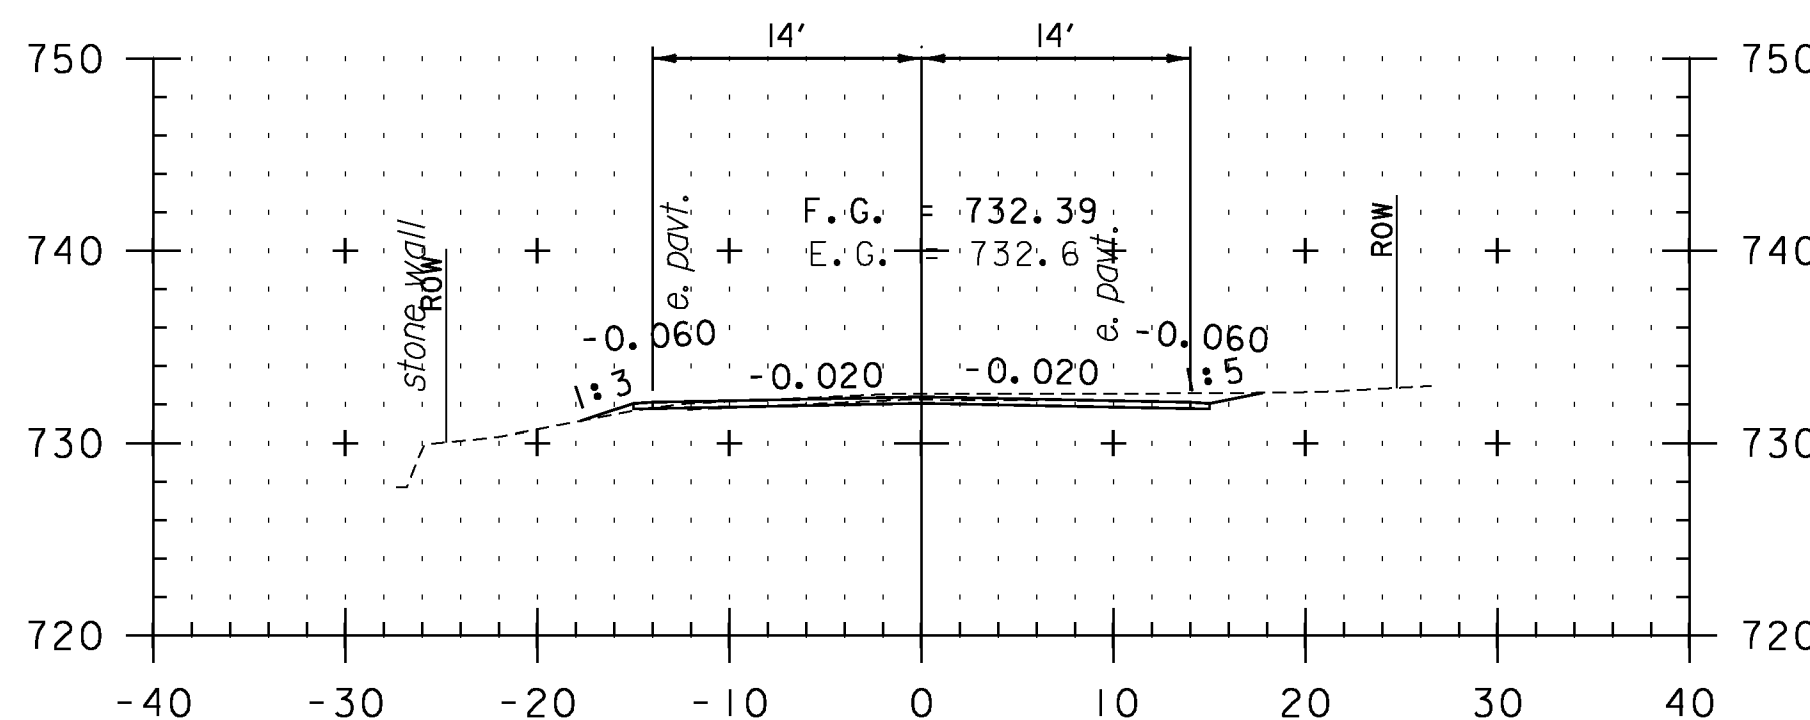

F100+00

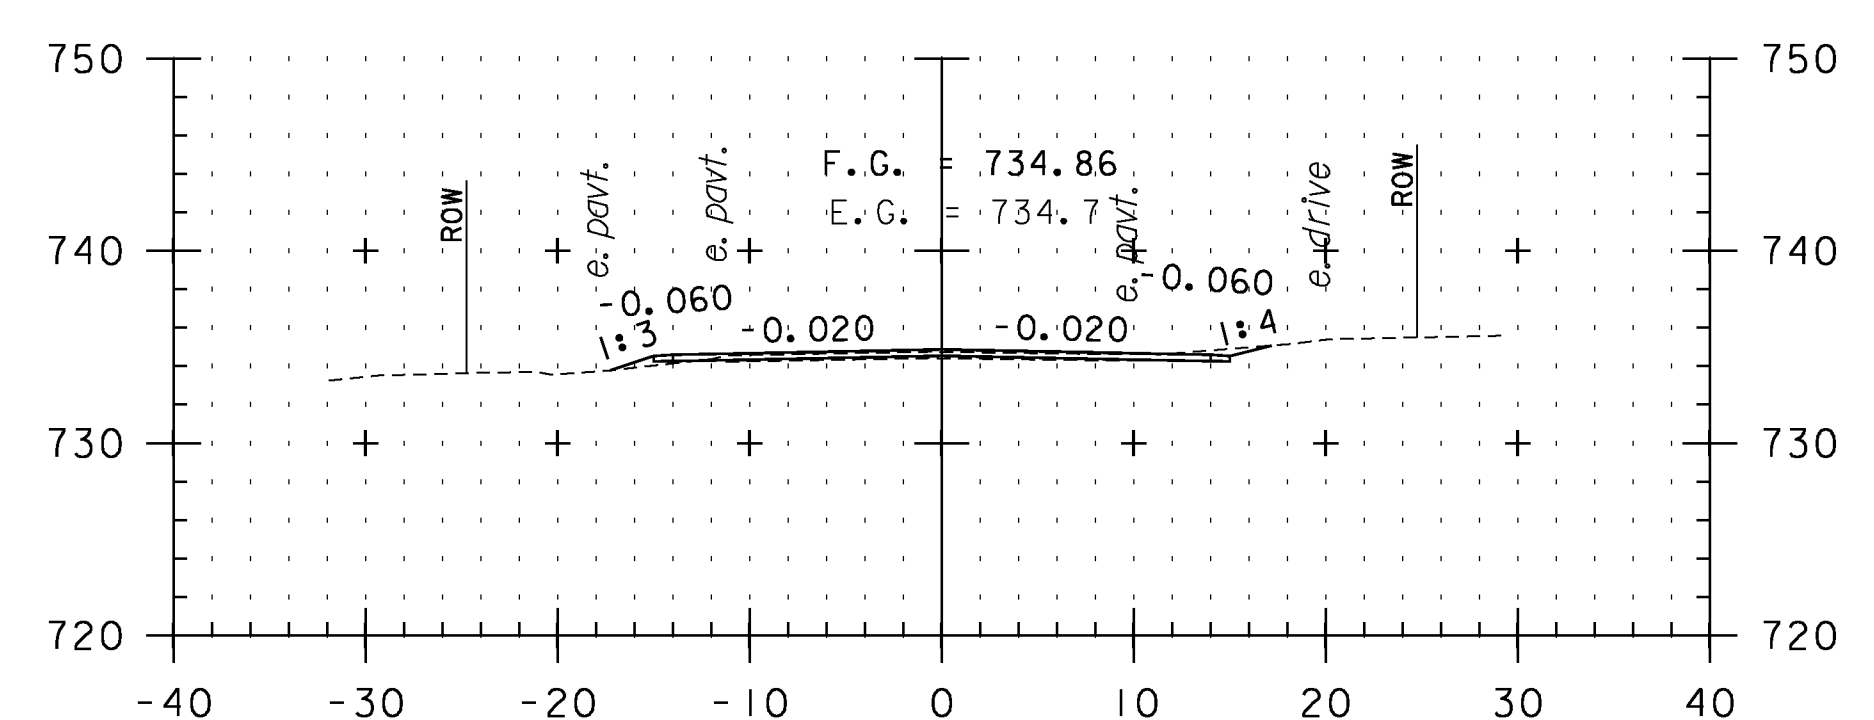

F101+50

CROSS SECTION SHEET 75

STA. F98+50 TO STA. F102+50



PROJECT NAME: VERSHIRE-THETFORD	PLOT DATE: 1/29/2013
PROJECT NUMBER: STP 2911(I)	DRAWN BY: SNG
FILE NAME: pl0c224.dgn	CHECKED BY: PTS
PROJECT LEADER: PTS	SHEET 183 OF 232
DESIGNED BY: NLL	
IPARM FILE NAME: IOC224_183	