




F 103+48  
TH 28

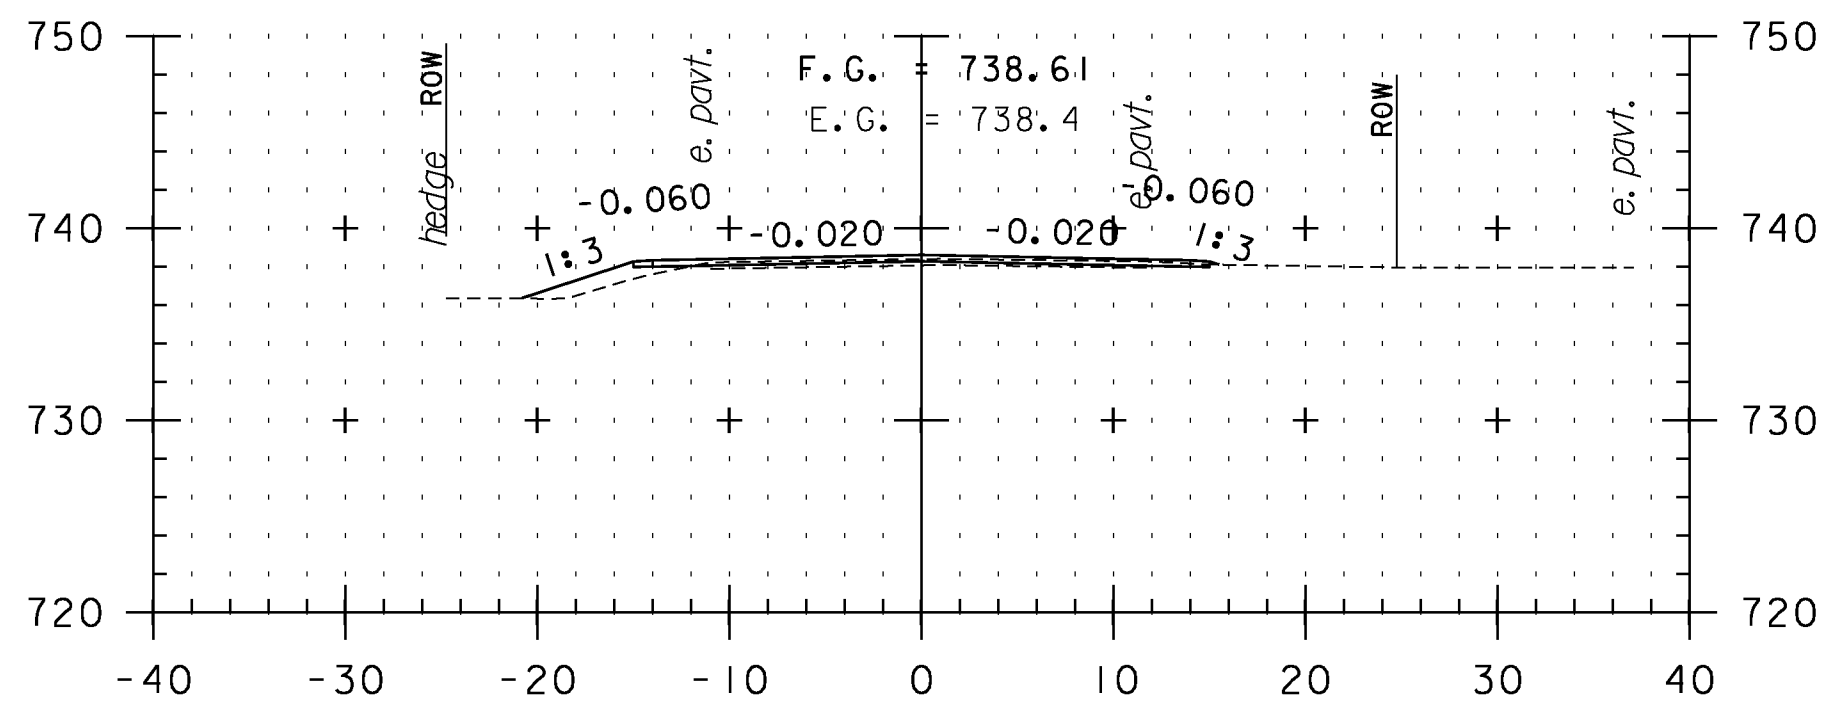


F 104+50

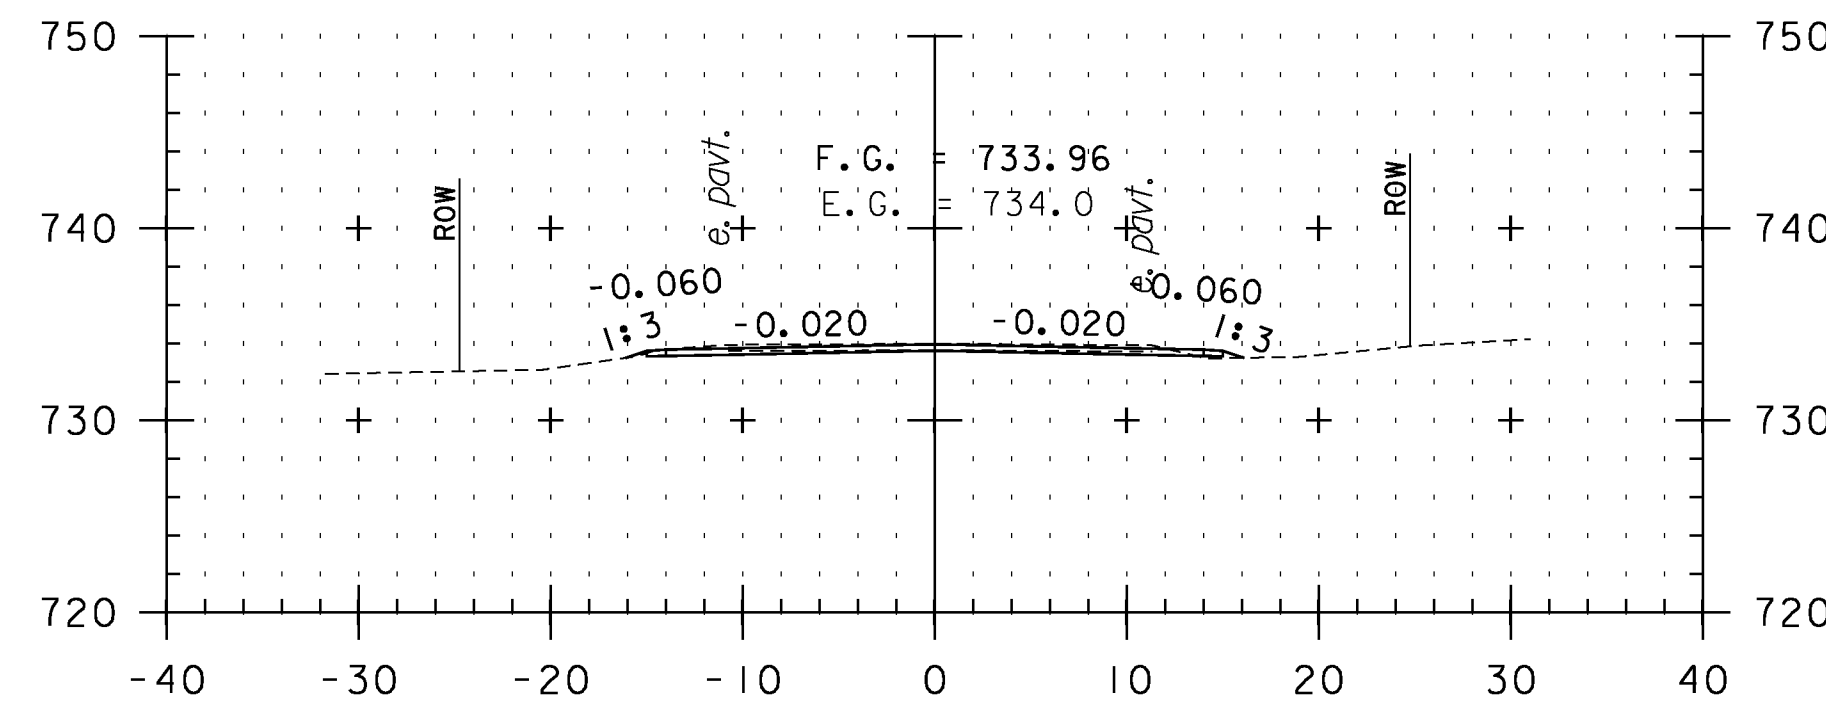


F 106+00

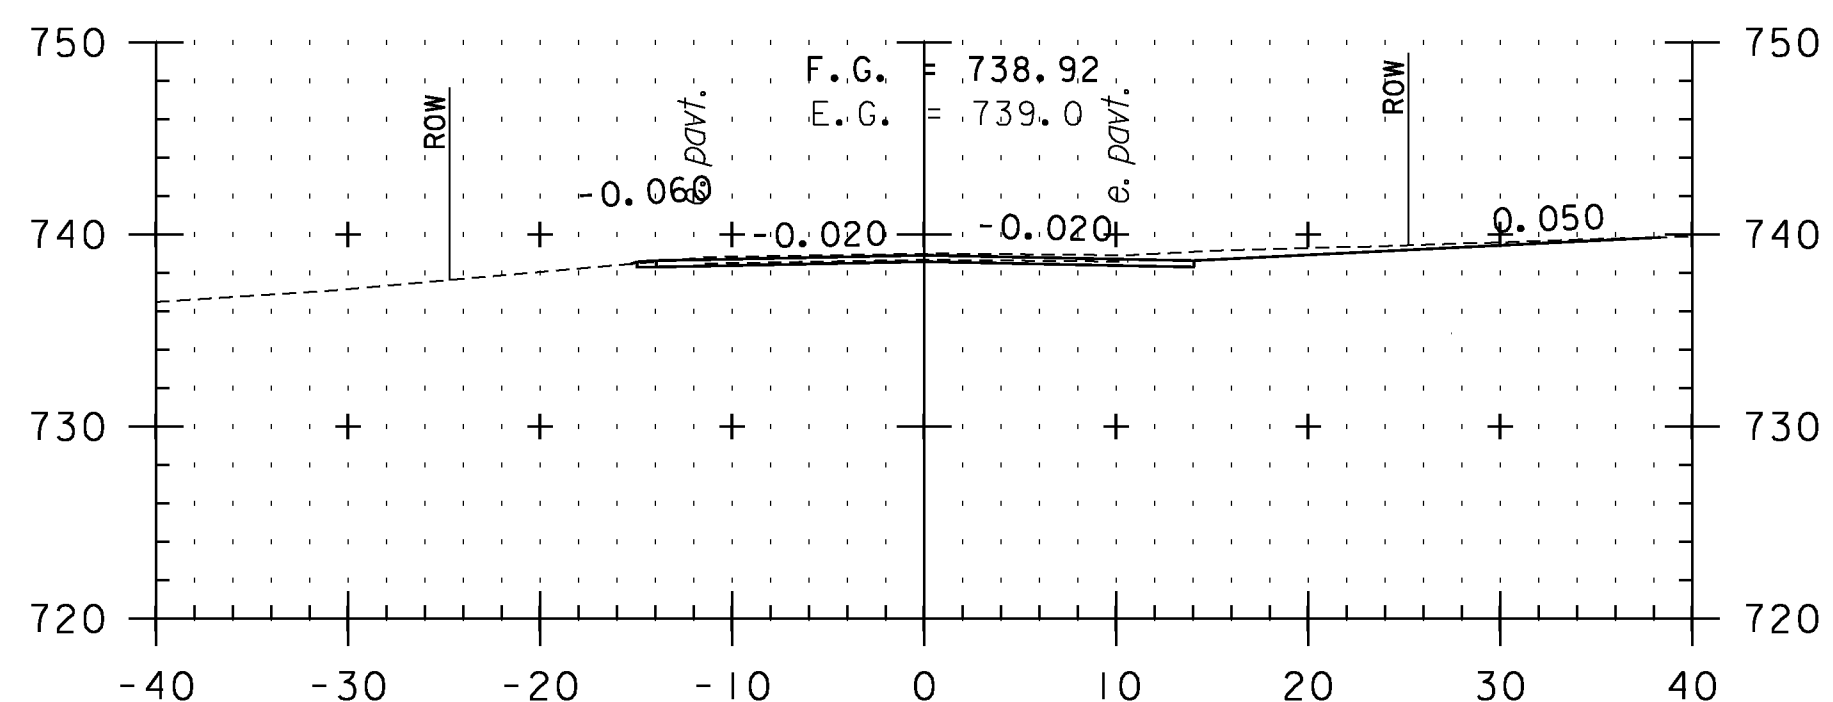


F 103+38  
TH 3

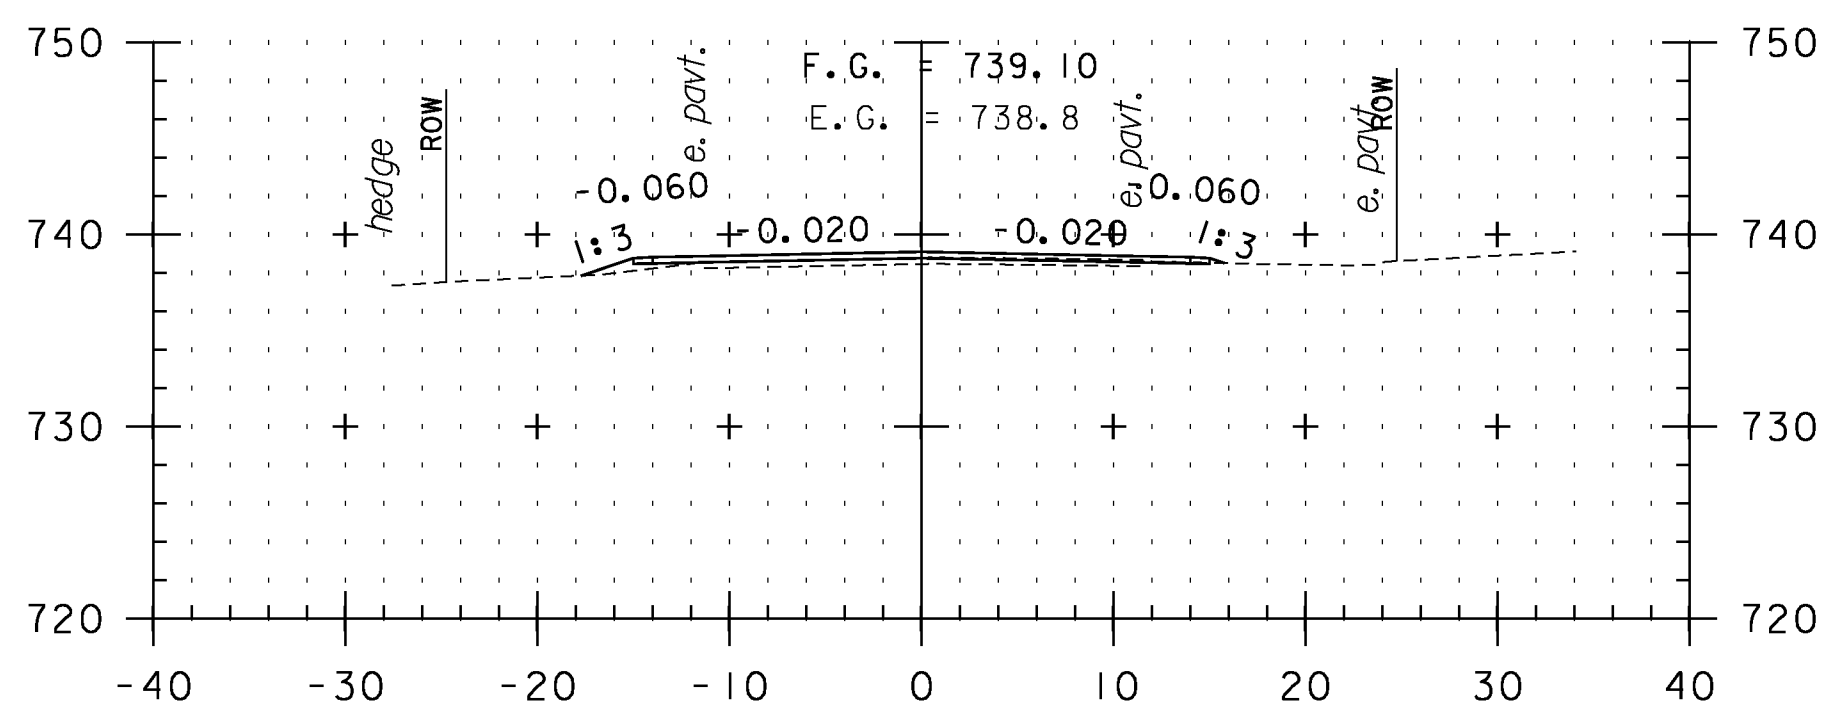


F 104+00

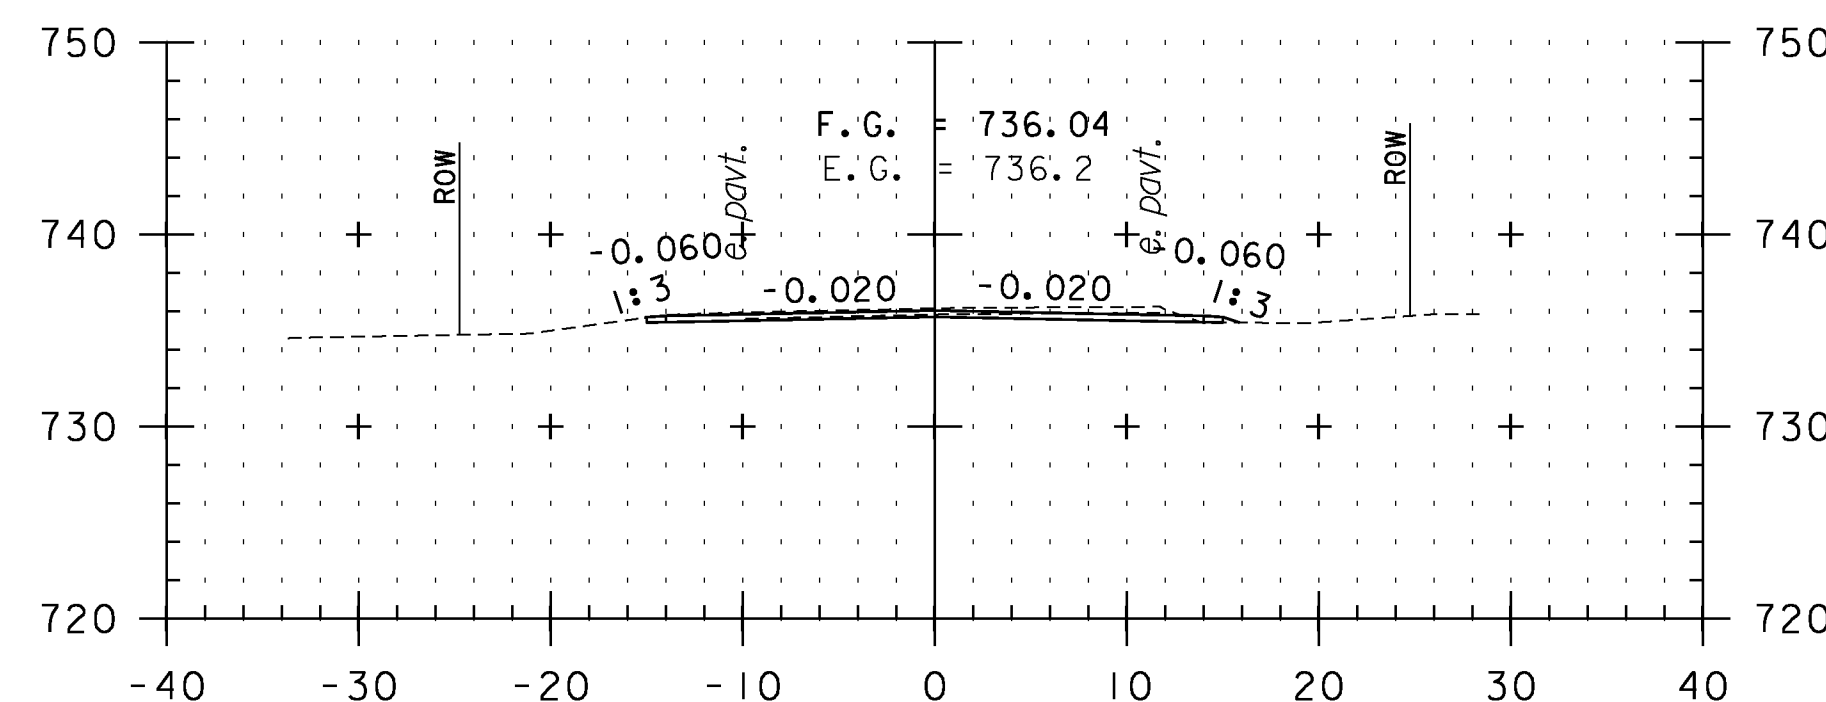


F 105+50

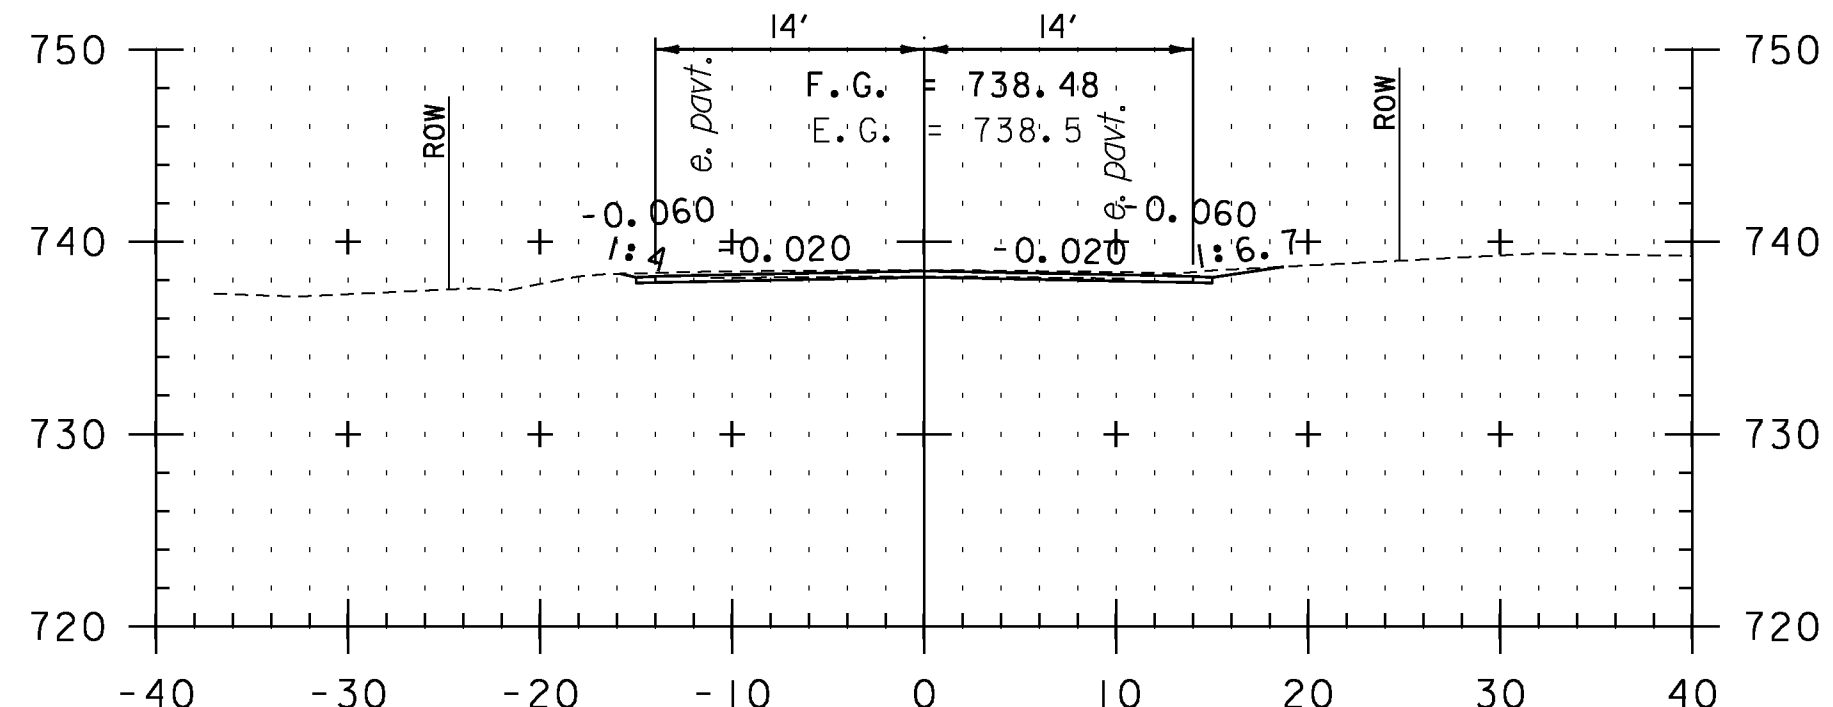

F 103+00

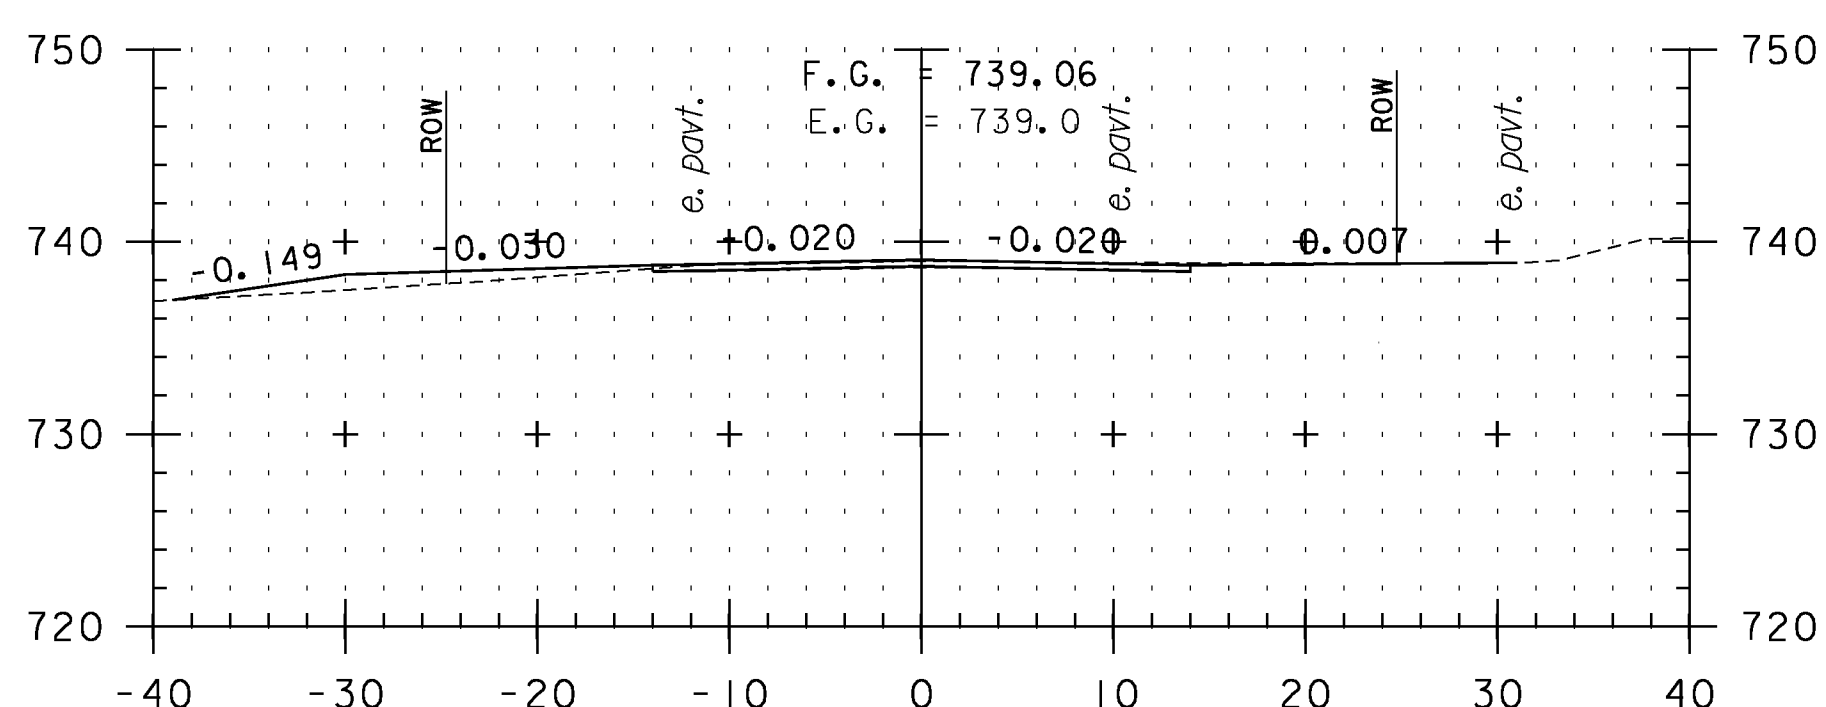


F 103+50

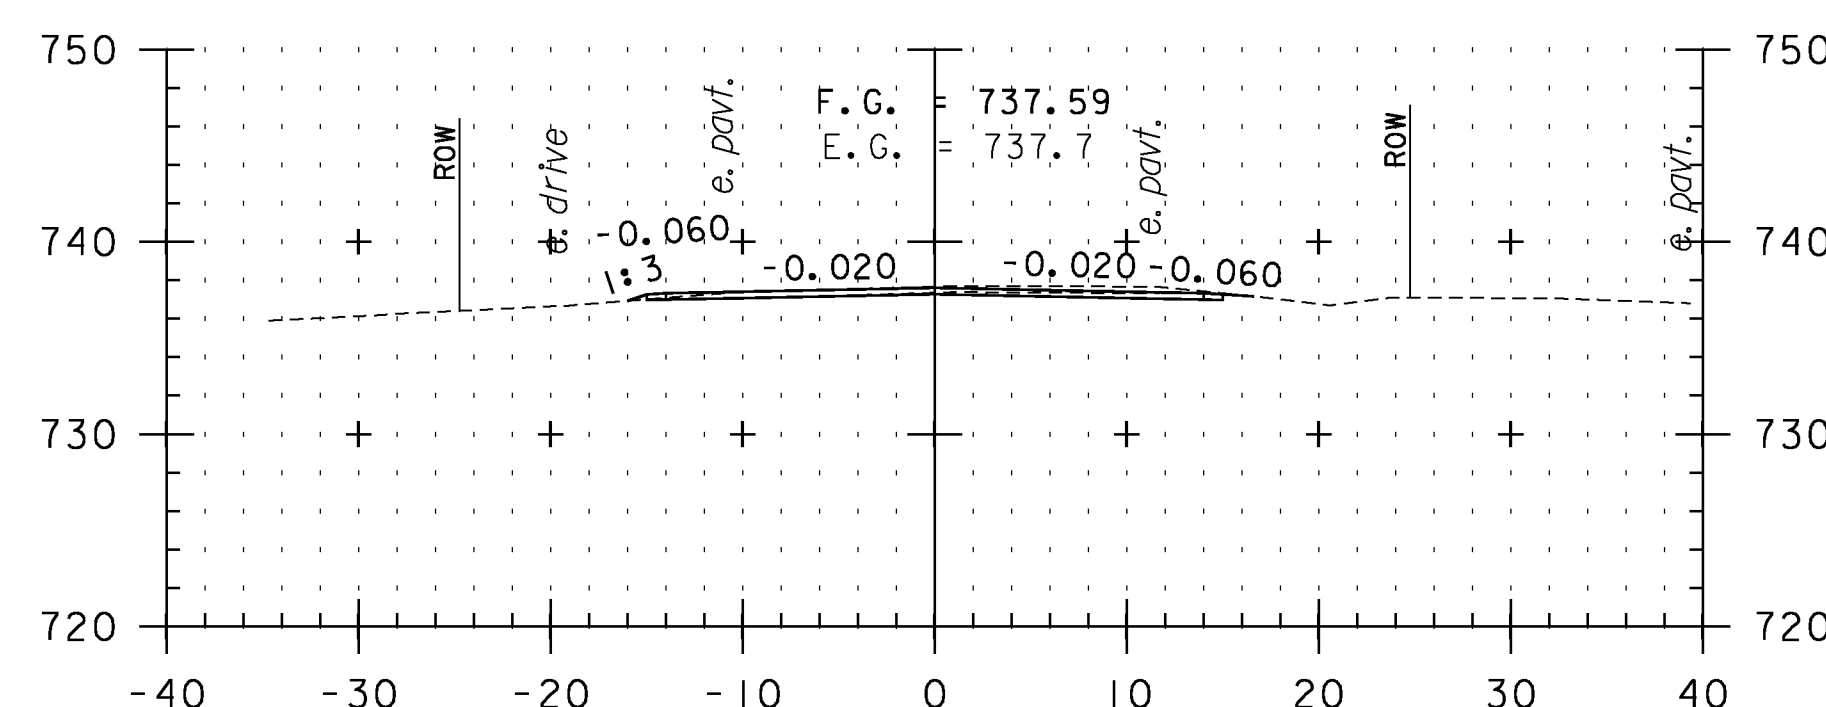

F 105+00

**CROSS SECTION SHEET 76**

STA. F103+00 TO STA. F106+00

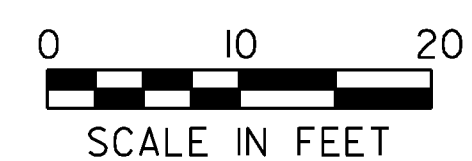

PROJECT NAME: VERSHIRE-THETFORD	PLOT DATE: 1/29/2013
PROJECT NUMBER: STP 2911(I)	DRAWN BY: SNG
FILE NAME: pl0c224.dgn	CHECKED BY: PTS
PROJECT LEADER: PTS	SHEET 184 OF 232
DESIGNED BY: NULL	
IPARM FILE NAME: IOC224_184	