




F 107+50

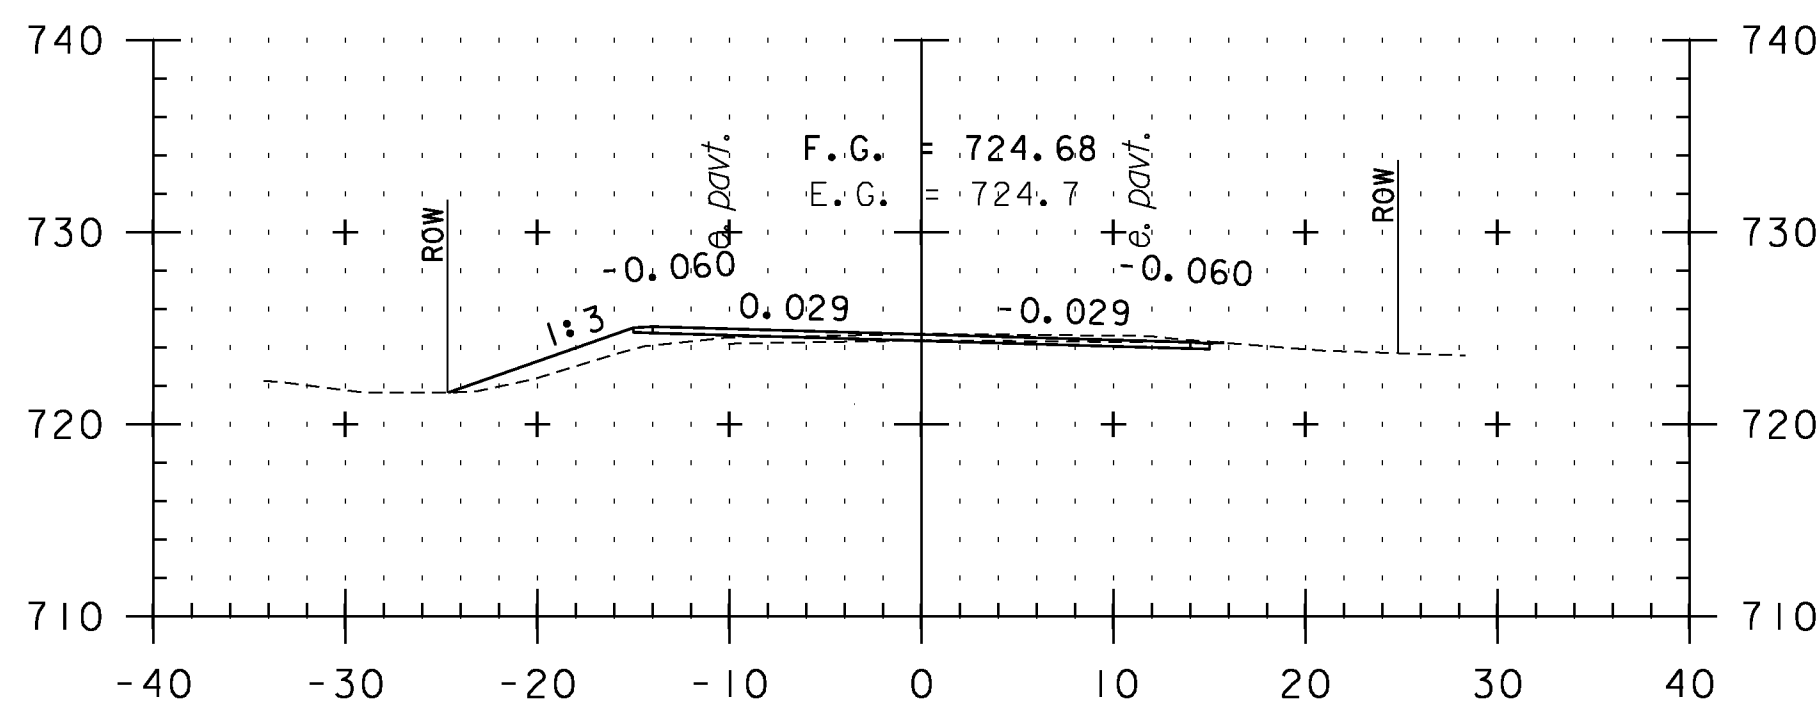


F 109+00

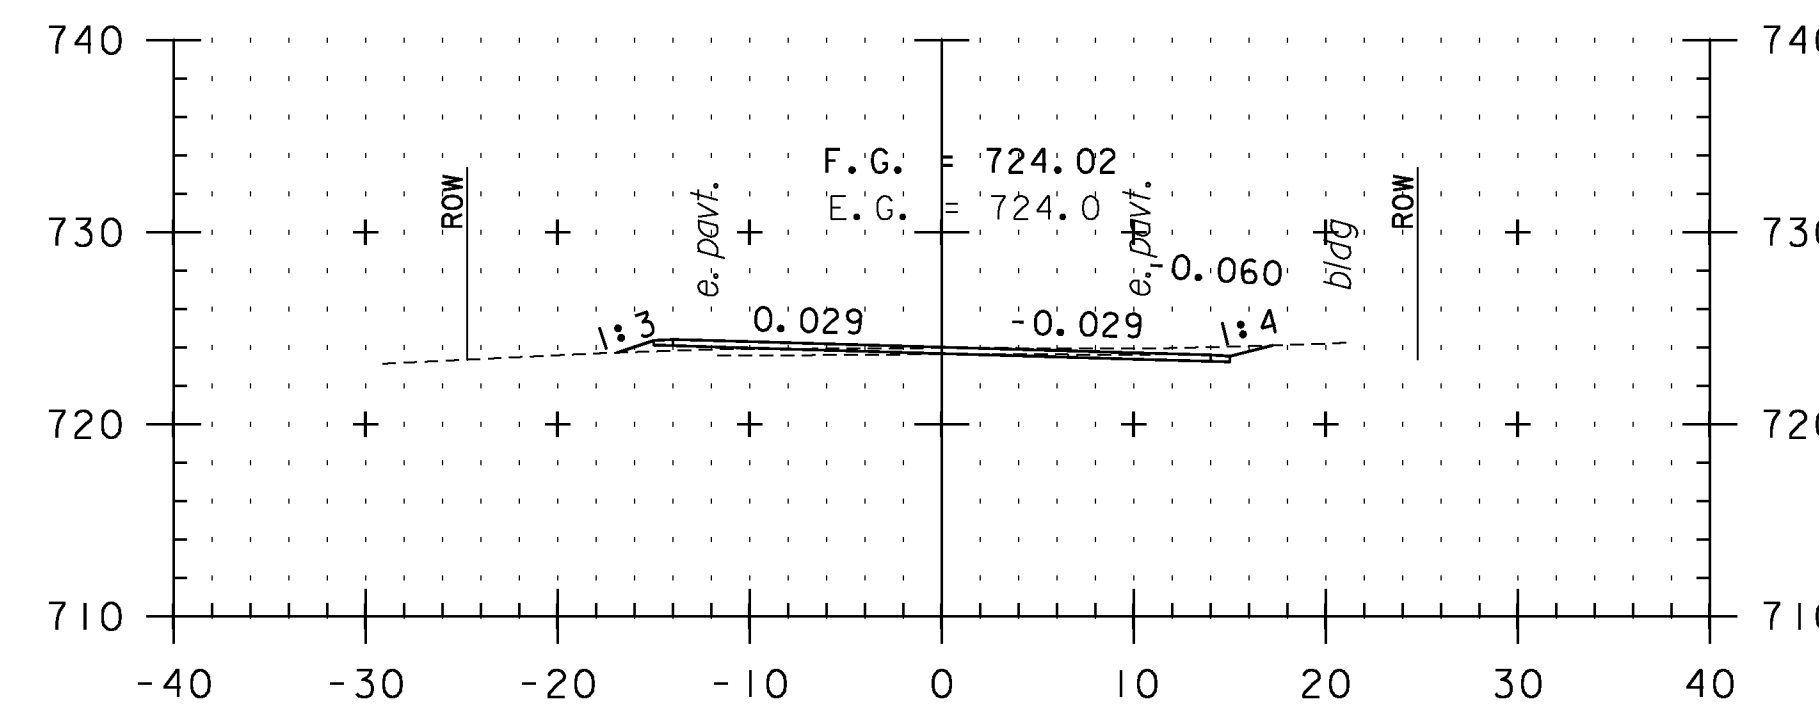


F 110+00

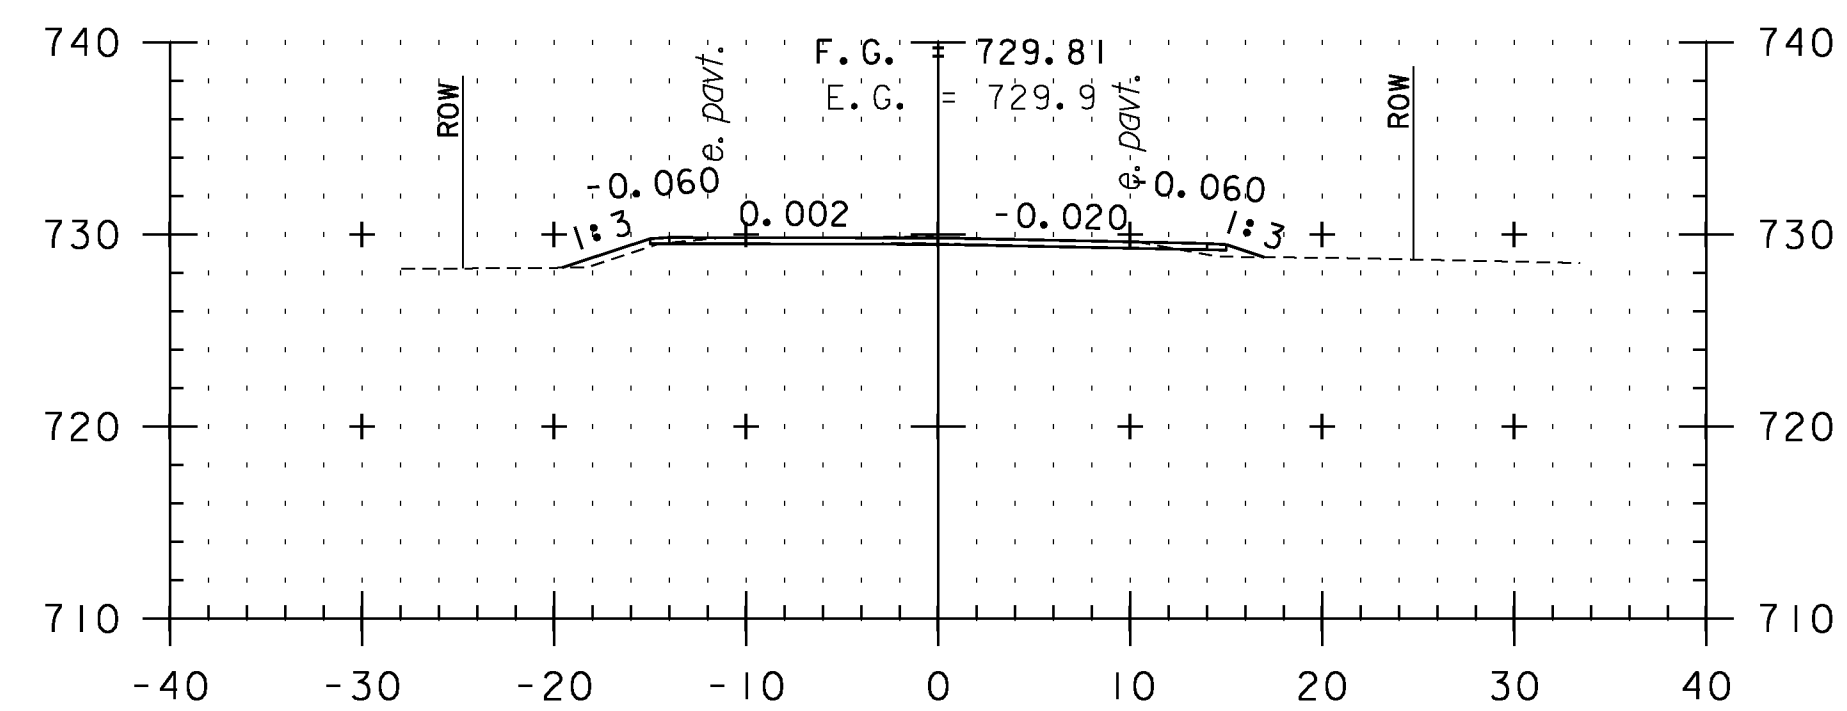


F 107+00

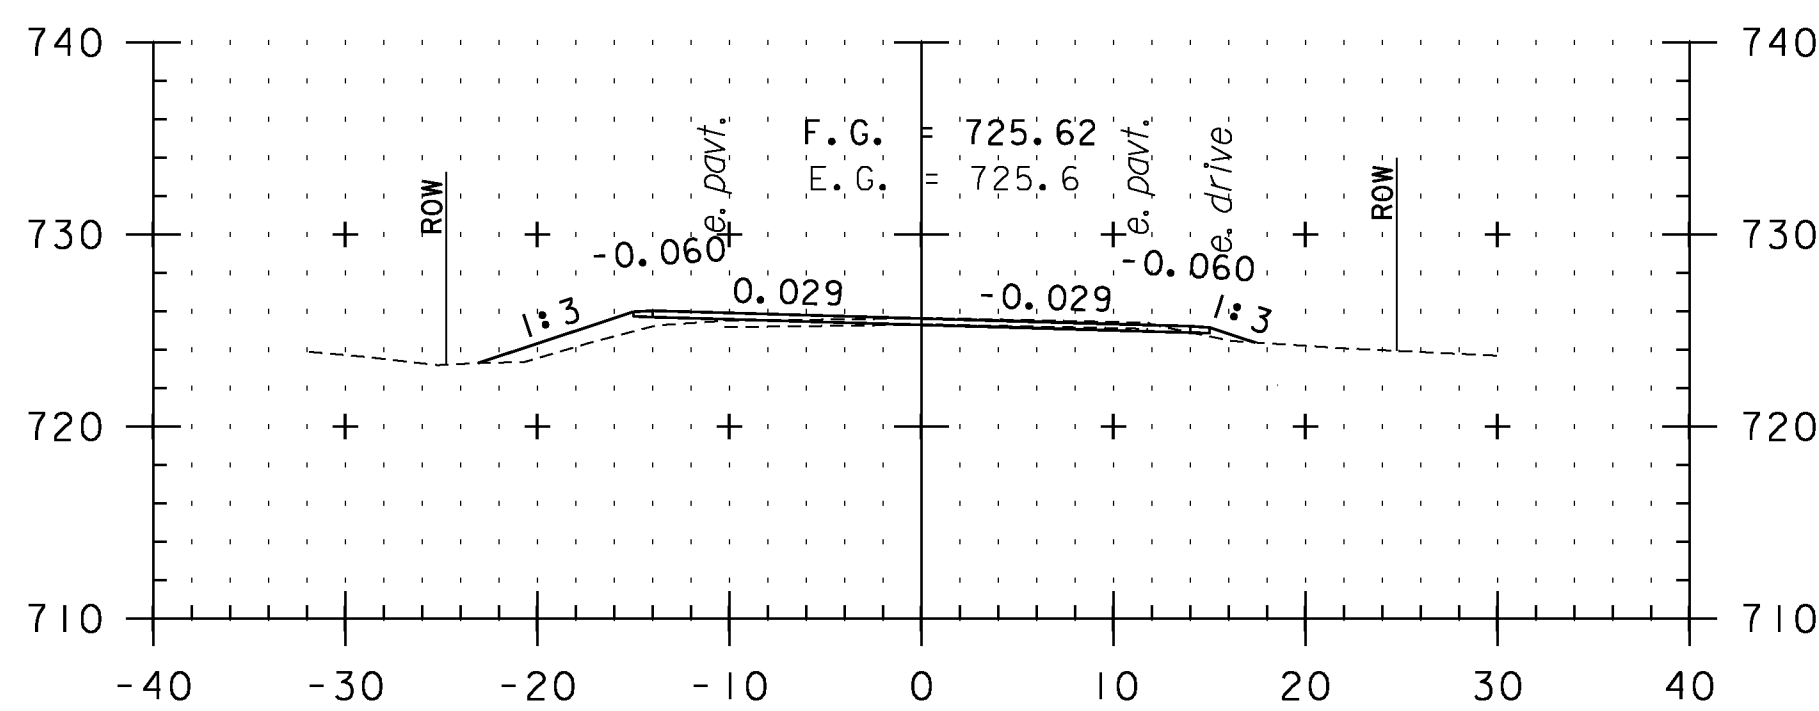


F 108+50

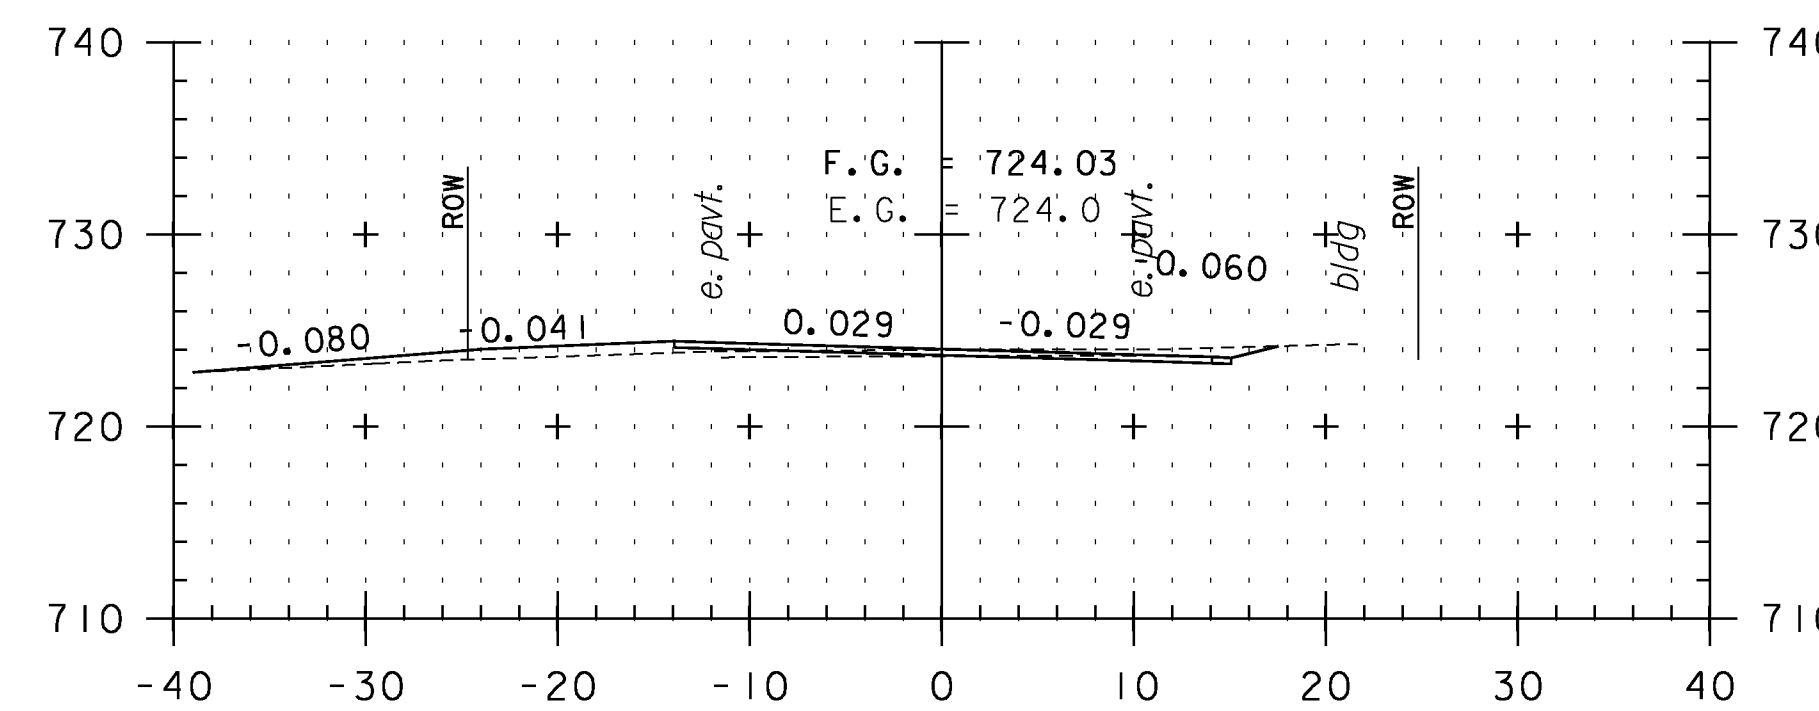


F 109+94
SCHOOL DRIVE

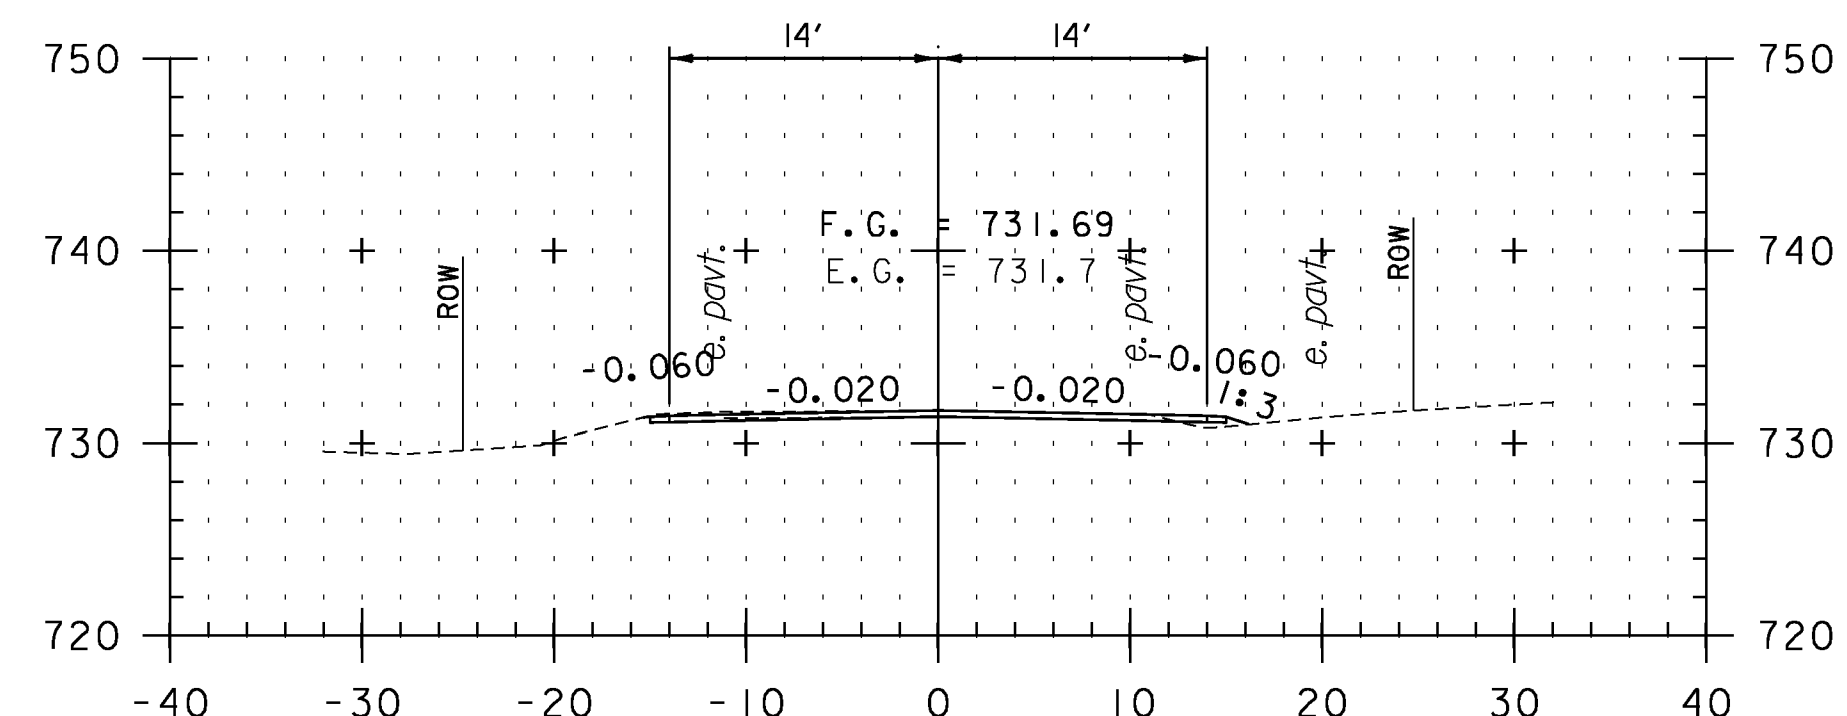

F 106+50

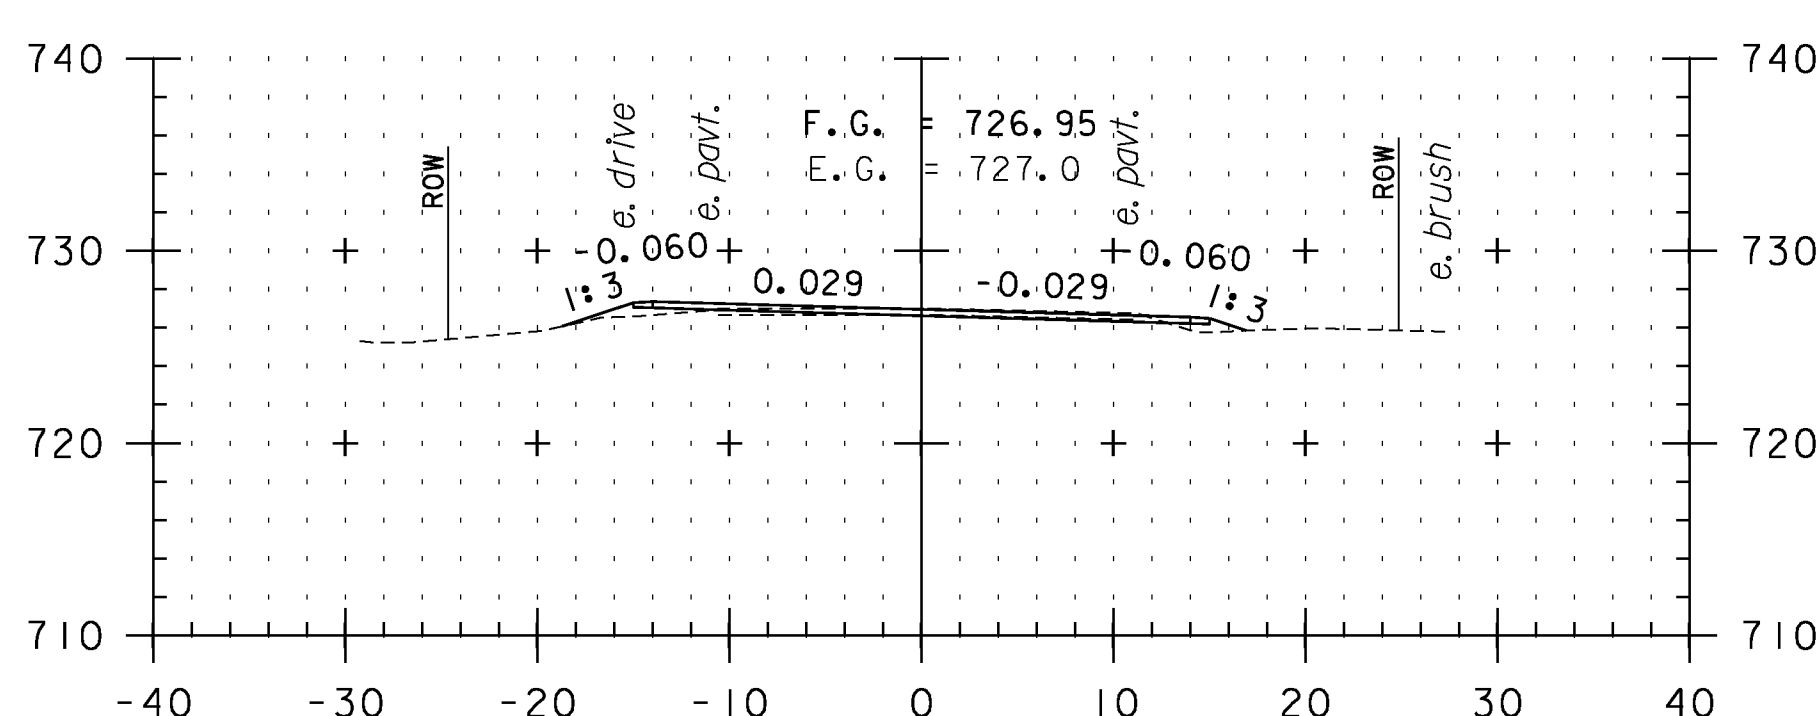


F 108+00

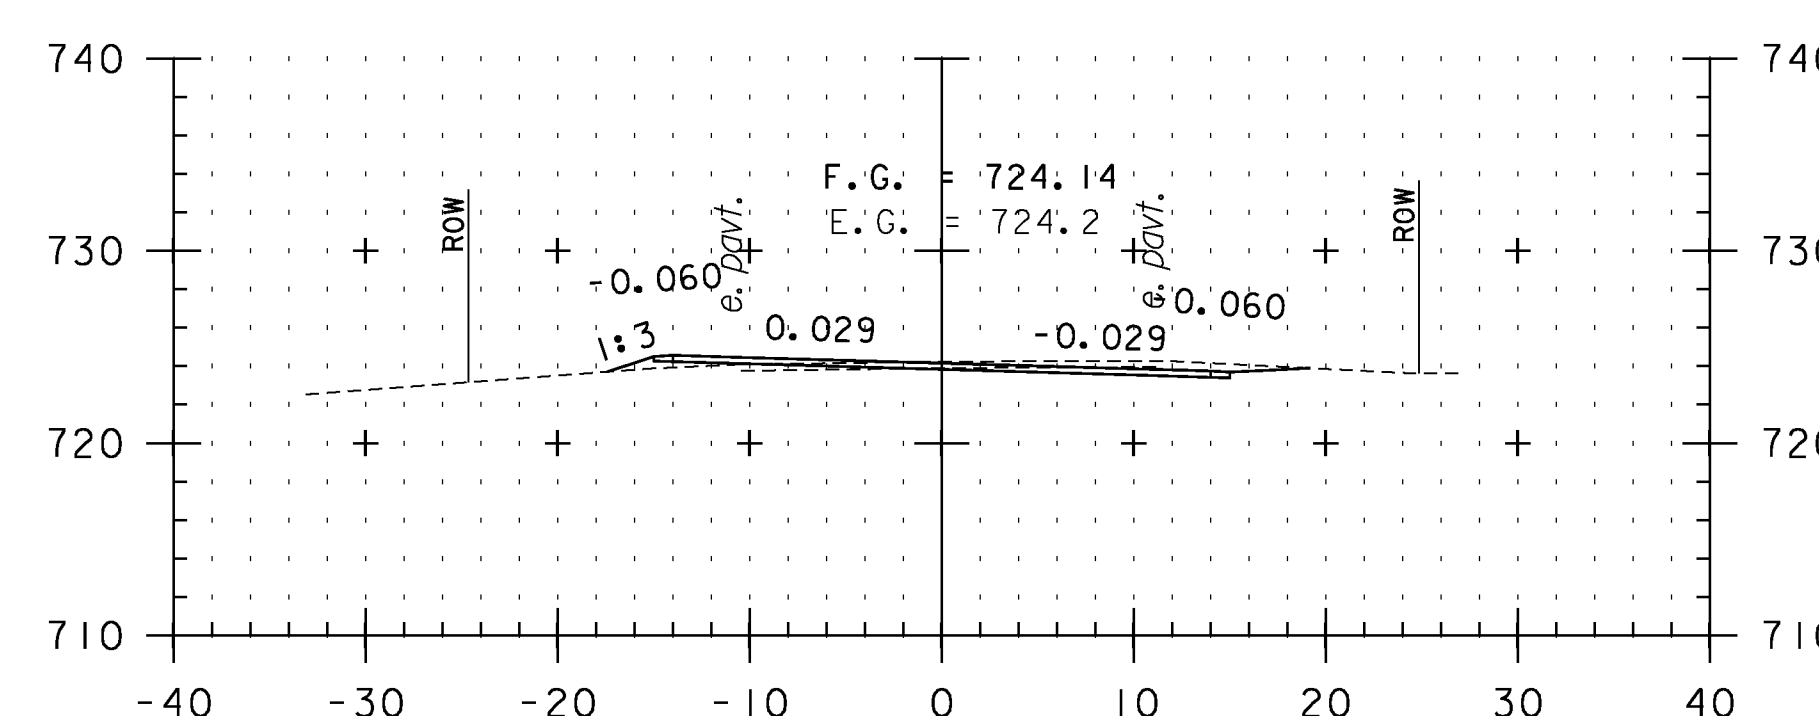

F 109+50

CROSS SECTION SHEET 77

STA. F106+50 TO STA. F110+00

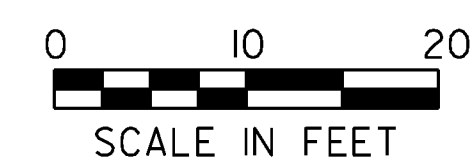

PROJECT NAME: VERSHIRE-THETFORD	PLOT DATE: 1/29/2013
PROJECT NUMBER: STP 2911(I)	DRAWN BY: SNG
FILE NAME: pl0c224.dgn	CHECKED BY: PTS
PROJECT LEADER: PTS	SHEET 185 OF 232
DESIGNED BY: NLL	
IPARM FILE NAME: IOC224_185	