




F 114+00

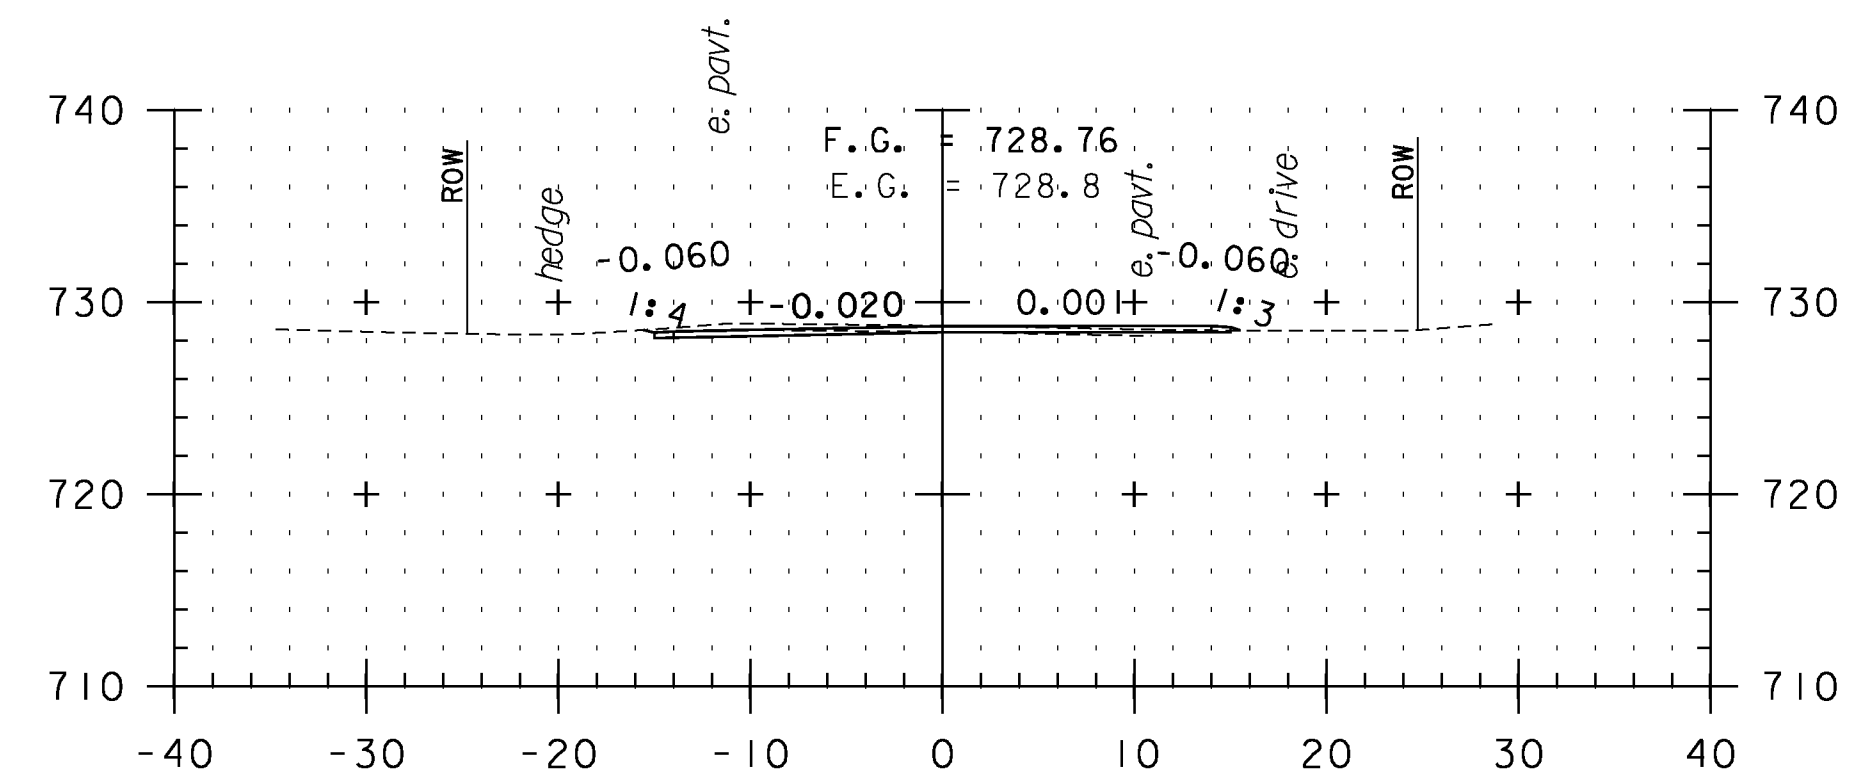


F 115+50

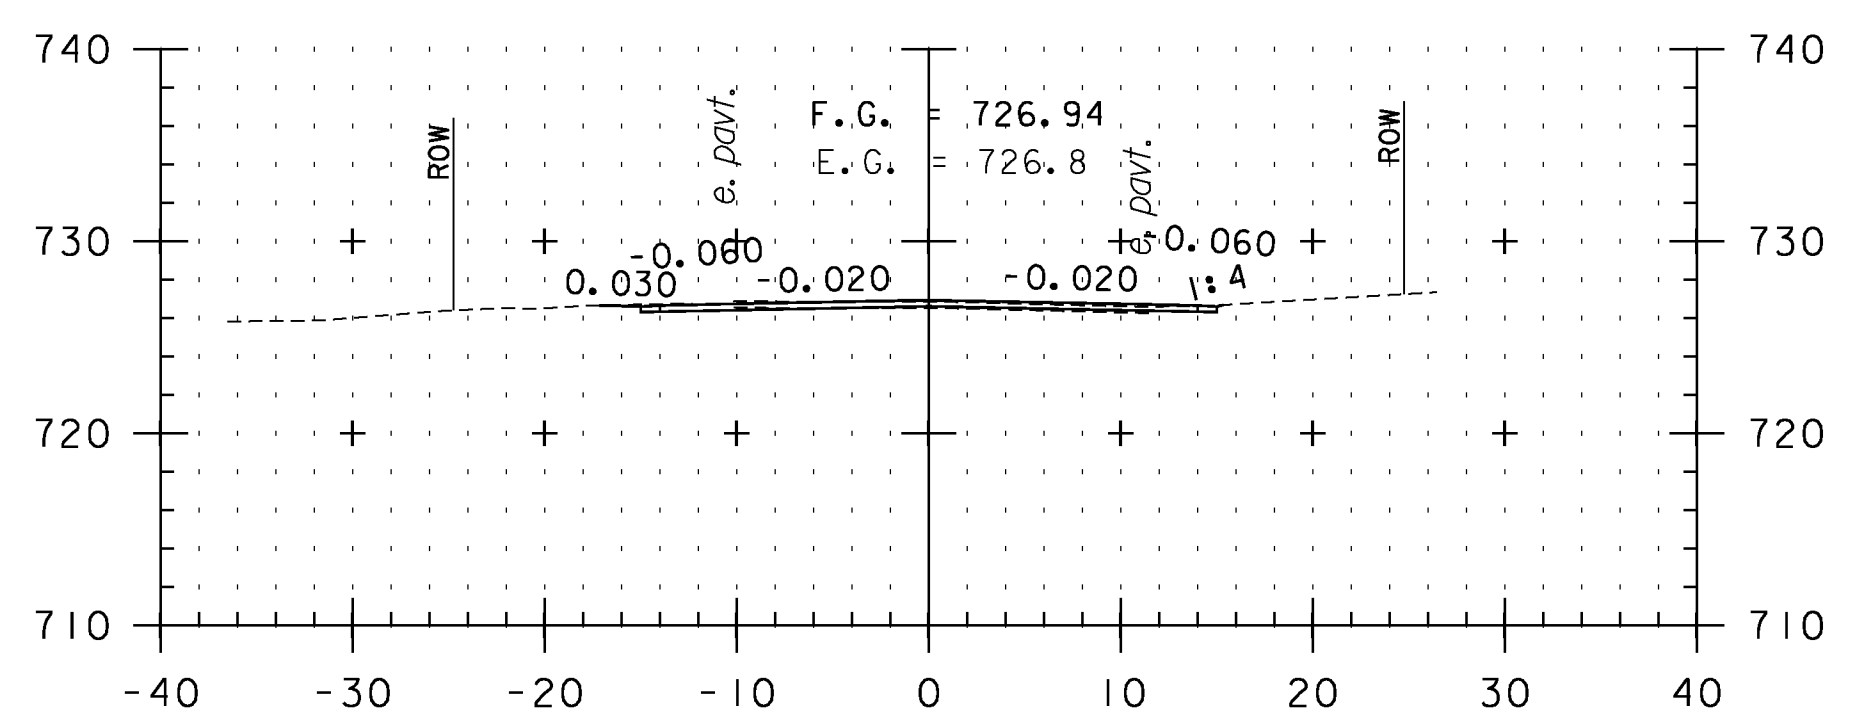


F 117+00

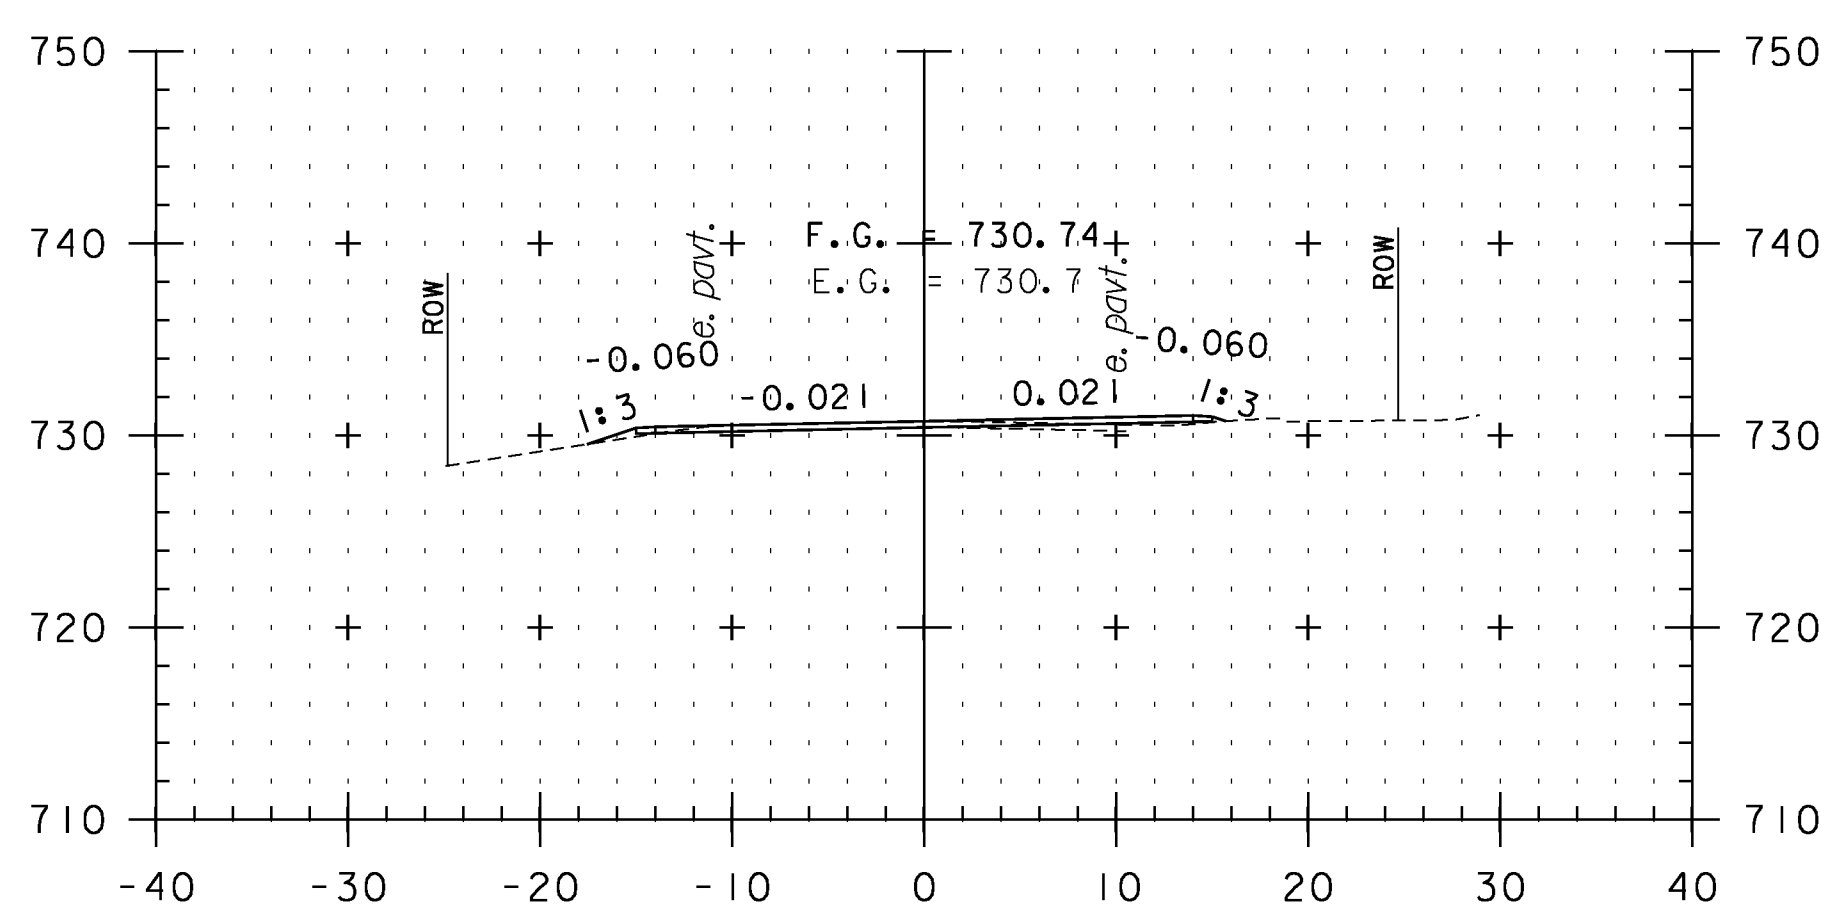


F 113+50

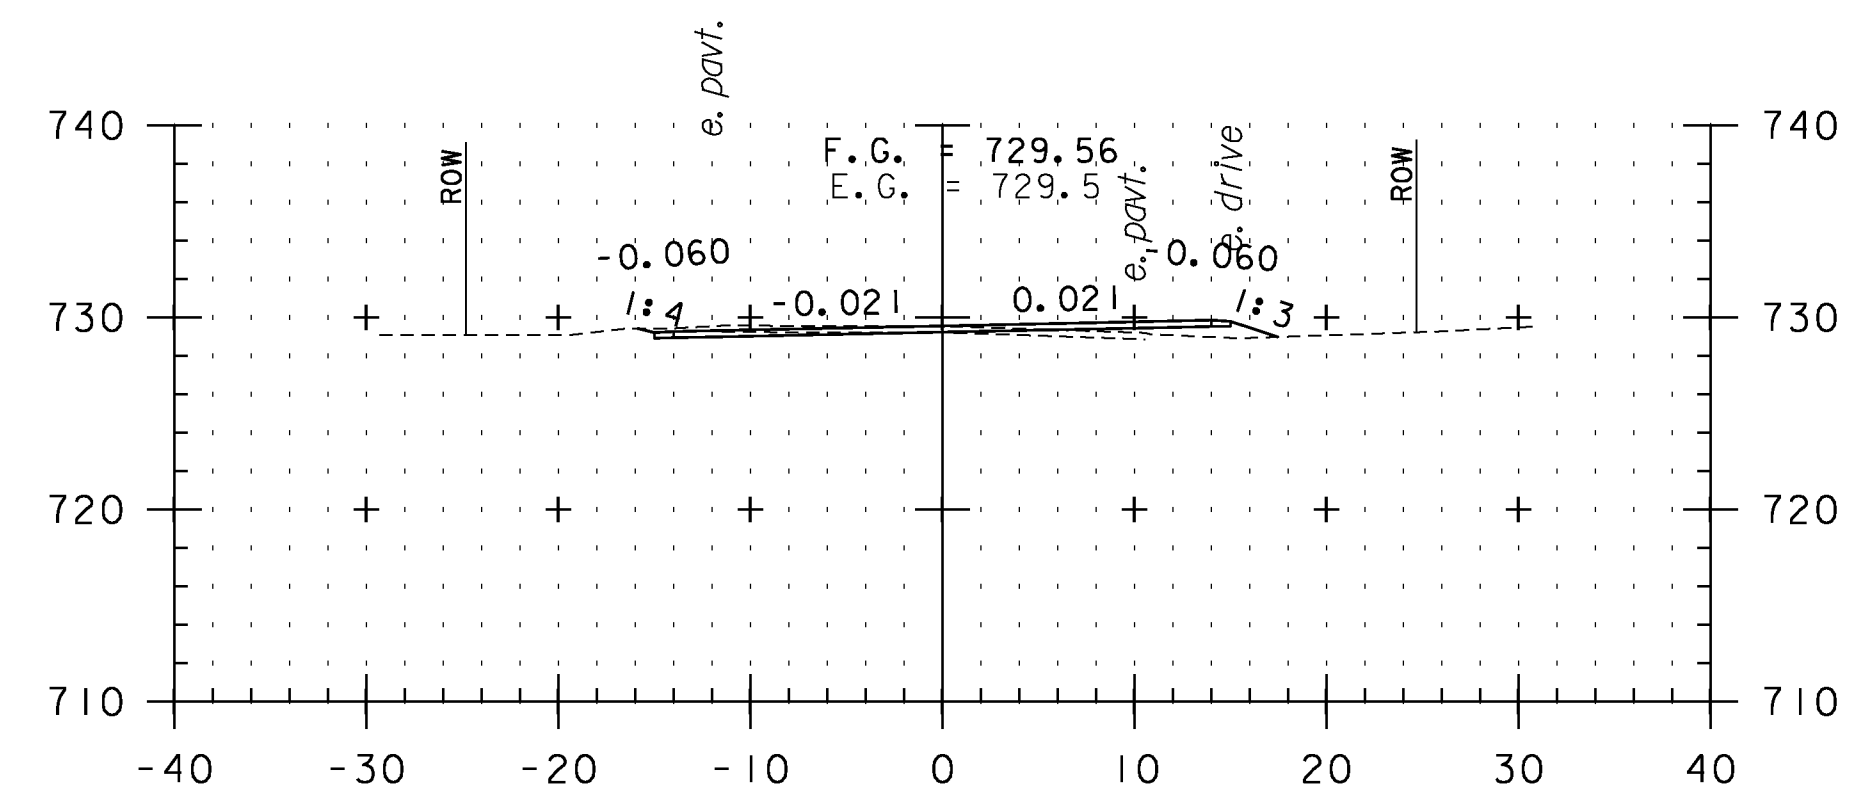


F 115+00

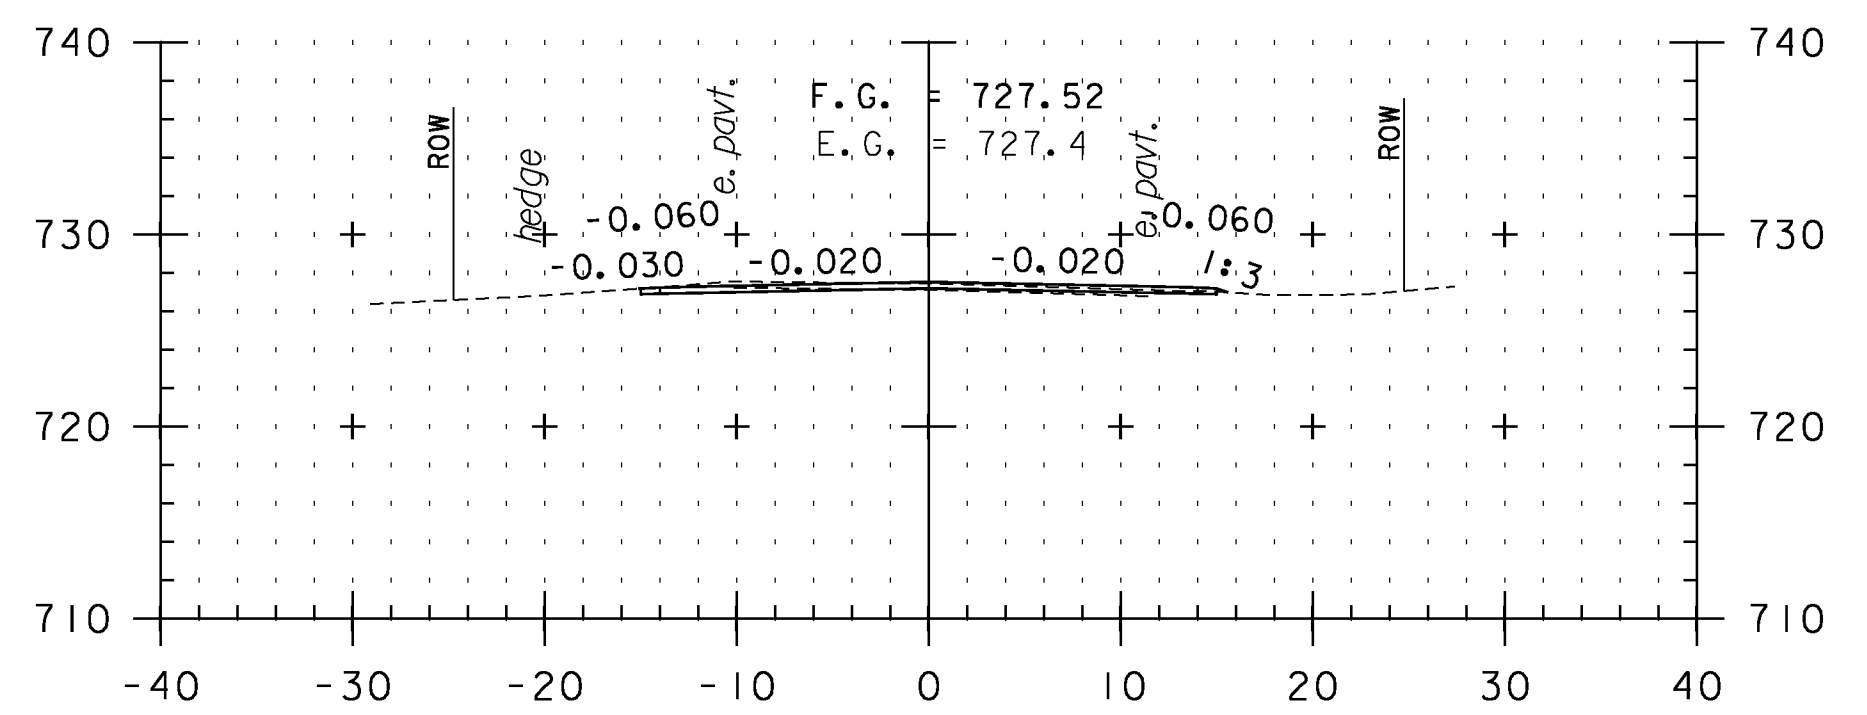


F 116+50

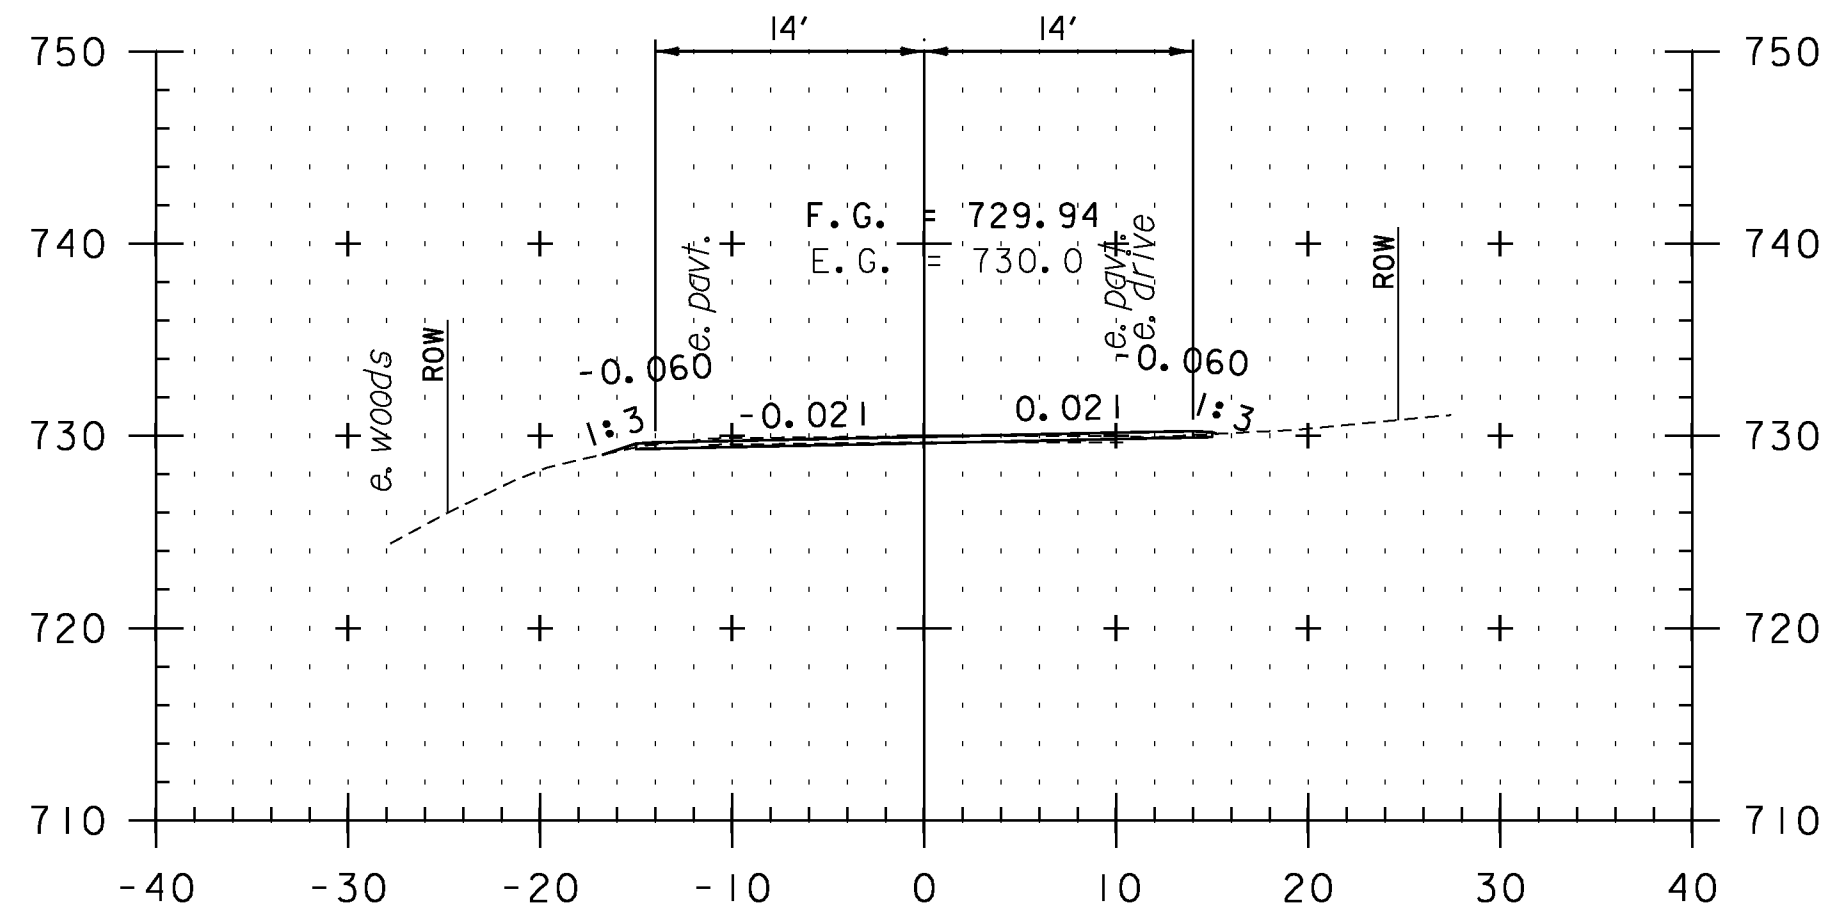

F 113+00

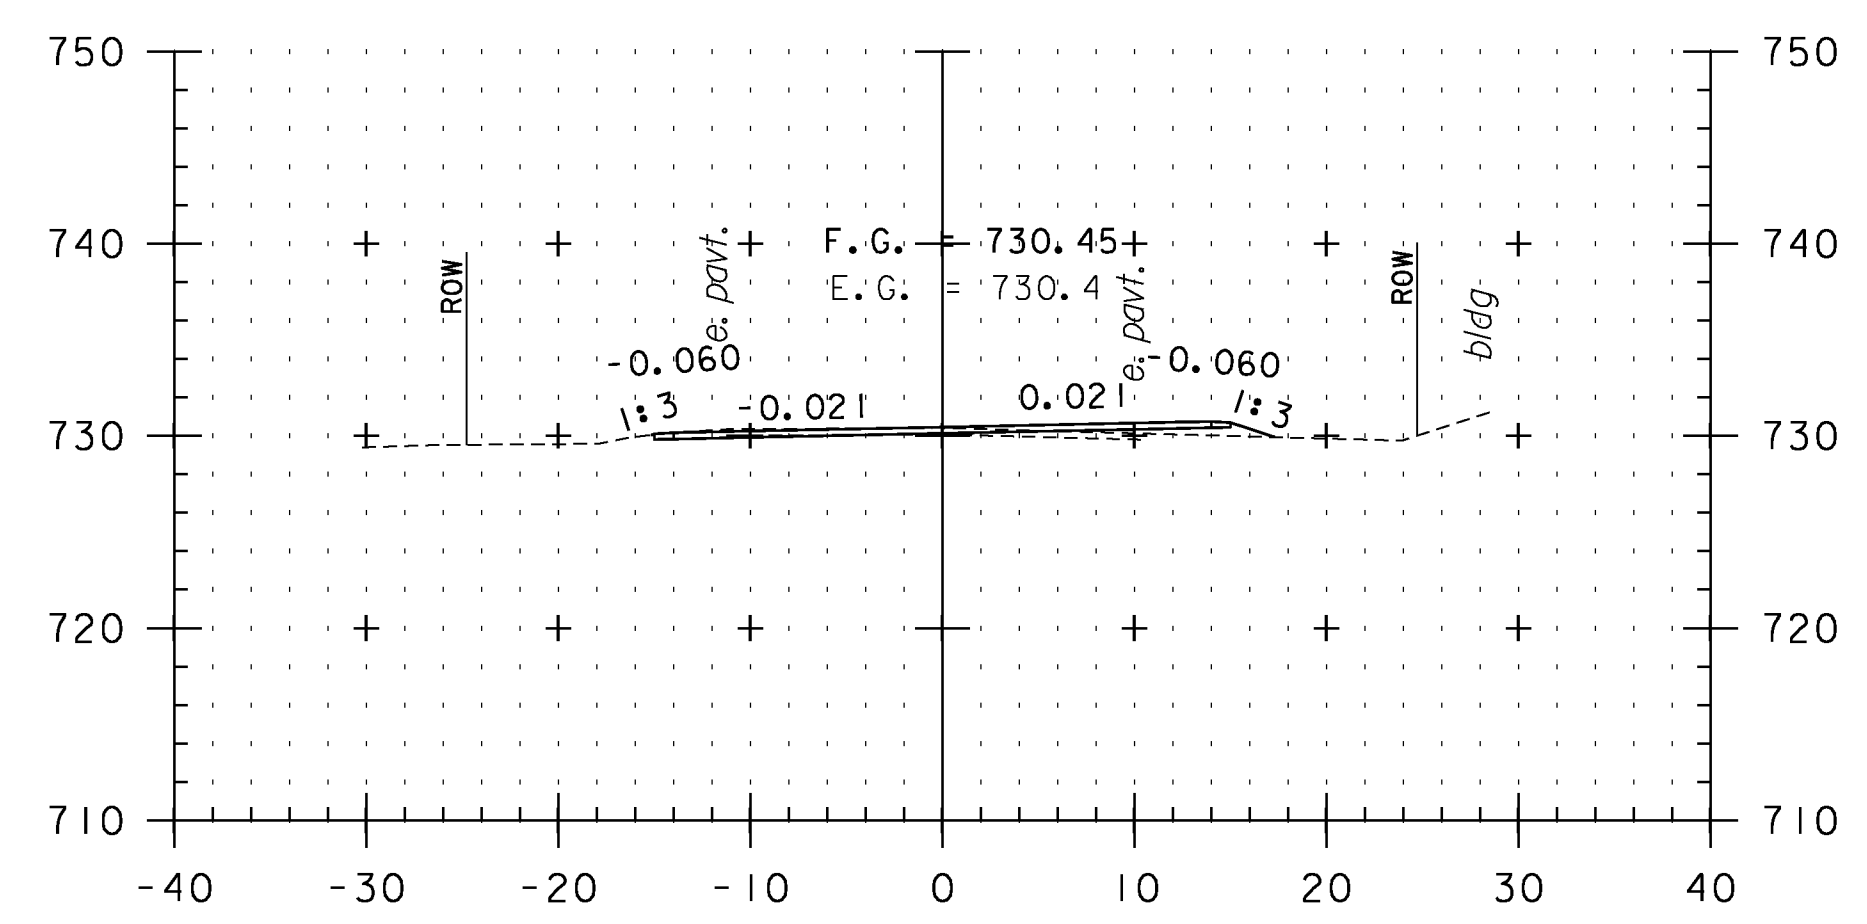


F 114+50

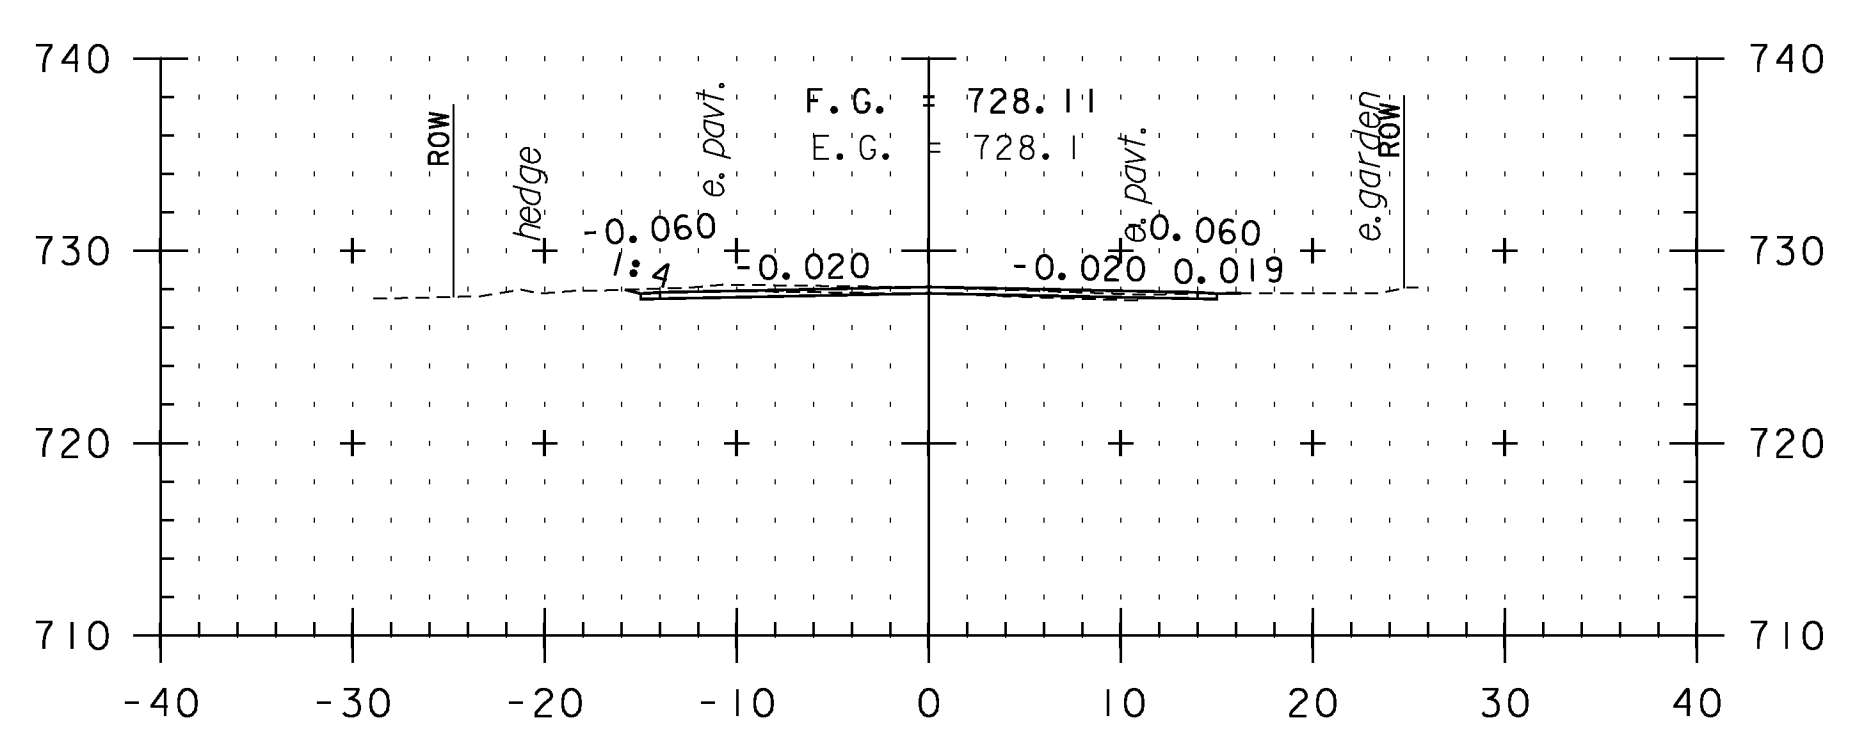

F 116+00

STA. F113+00 TO STA. F117+00

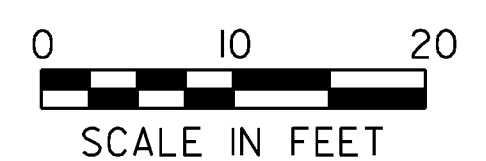

CROSS SECTION SHEET 79

PROJECT NAME: VERSHIRE-THETFORD	PLOT DATE: 1/29/2013
PROJECT NUMBER: STP 2911(I)	DRAWN BY: SNG
FILE NAME: pl0c224.dgn	CHECKED BY: PTS
DESIGNED BY: NLL	SHEET 187 OF 232
IPARM FILE NAME: IOC224_187	