




F 118+50

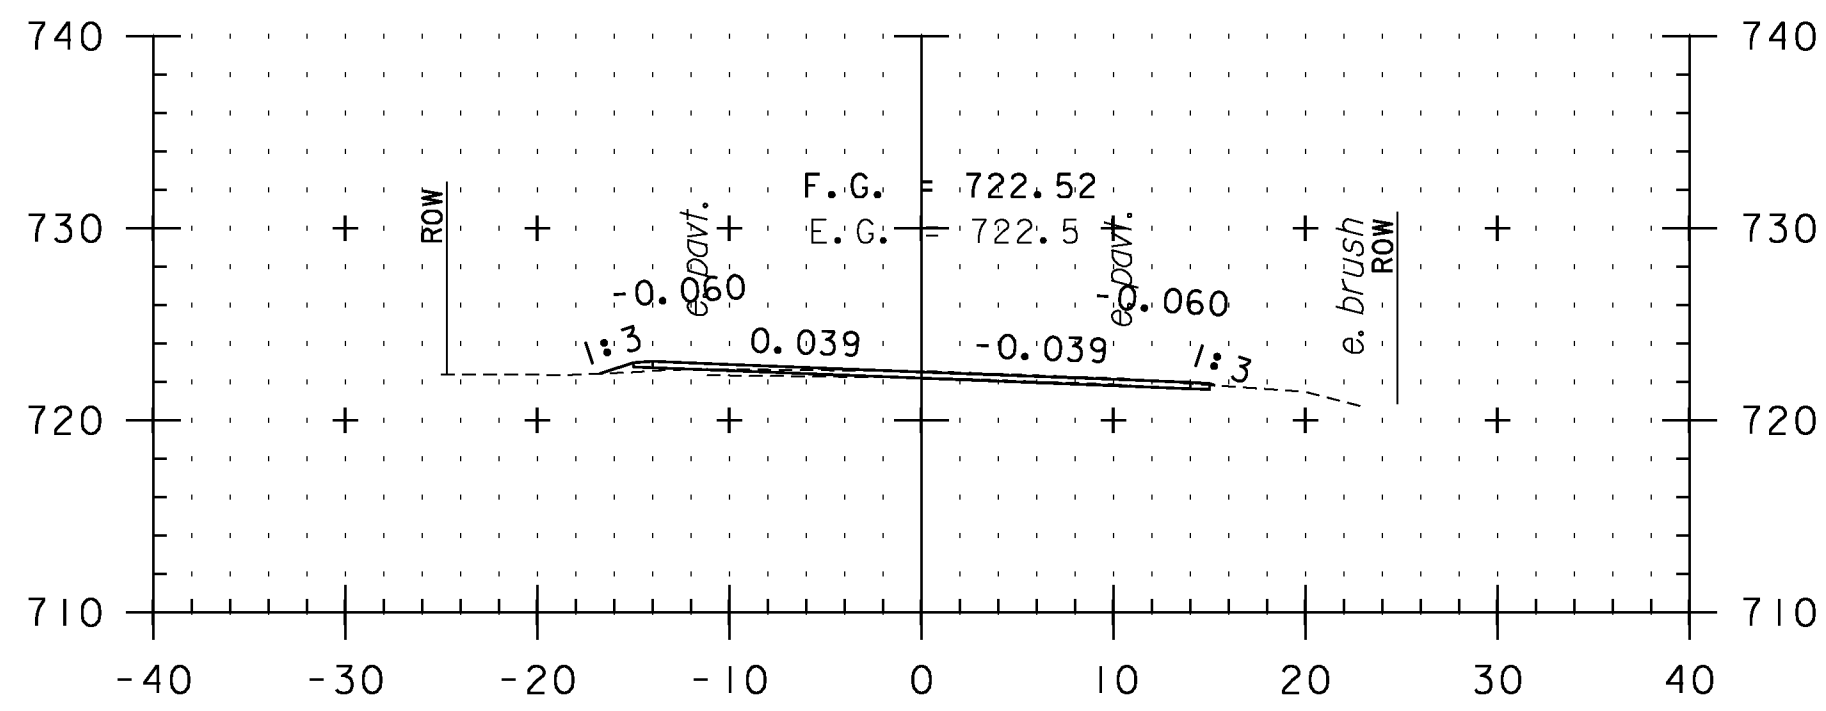


F 120+00

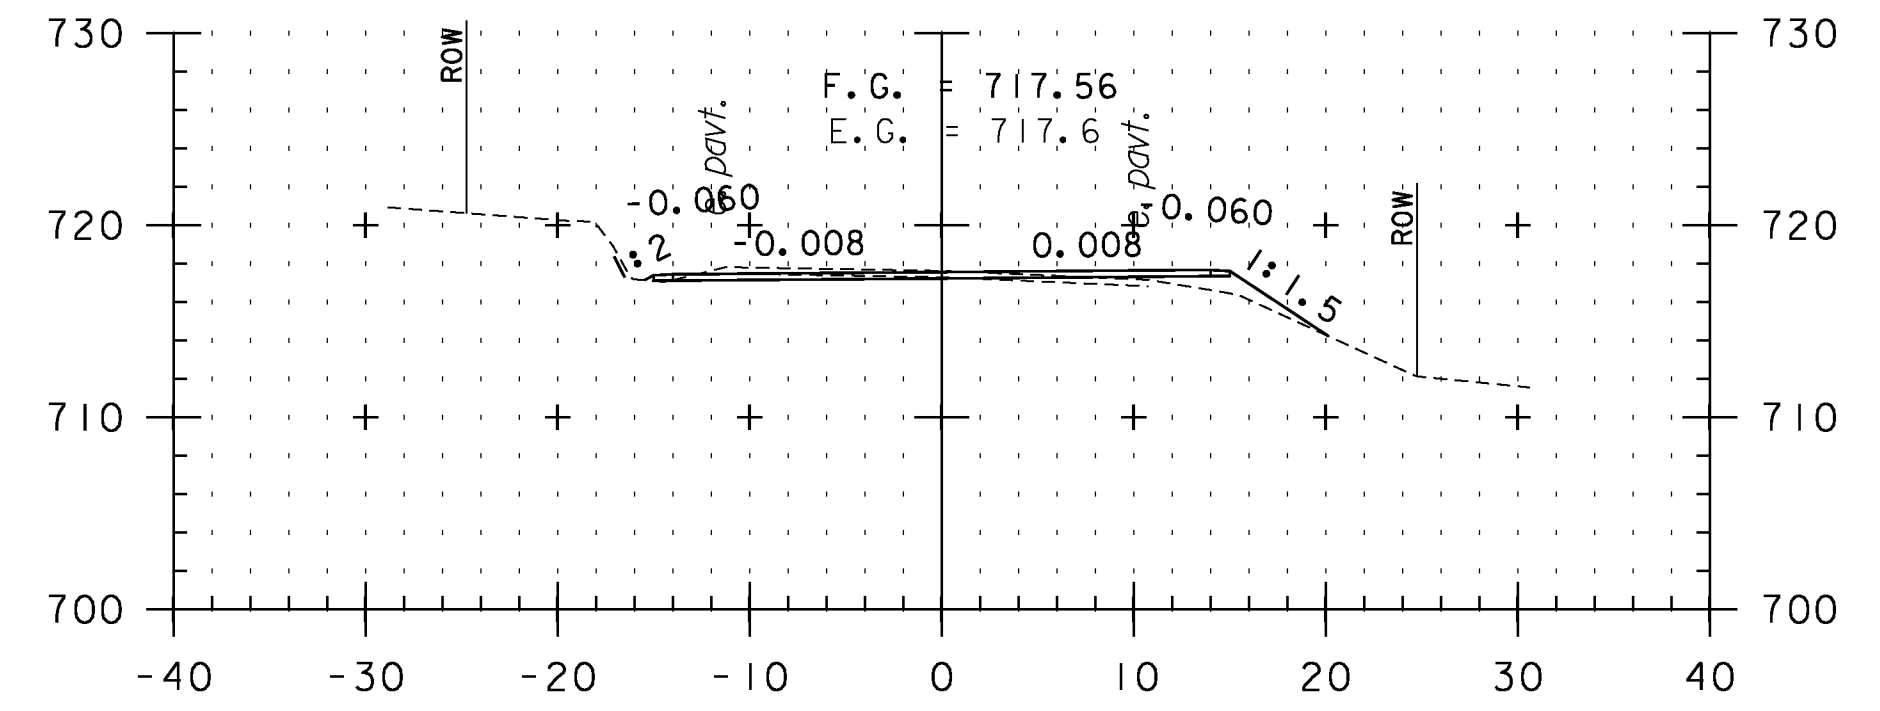


F 121+50

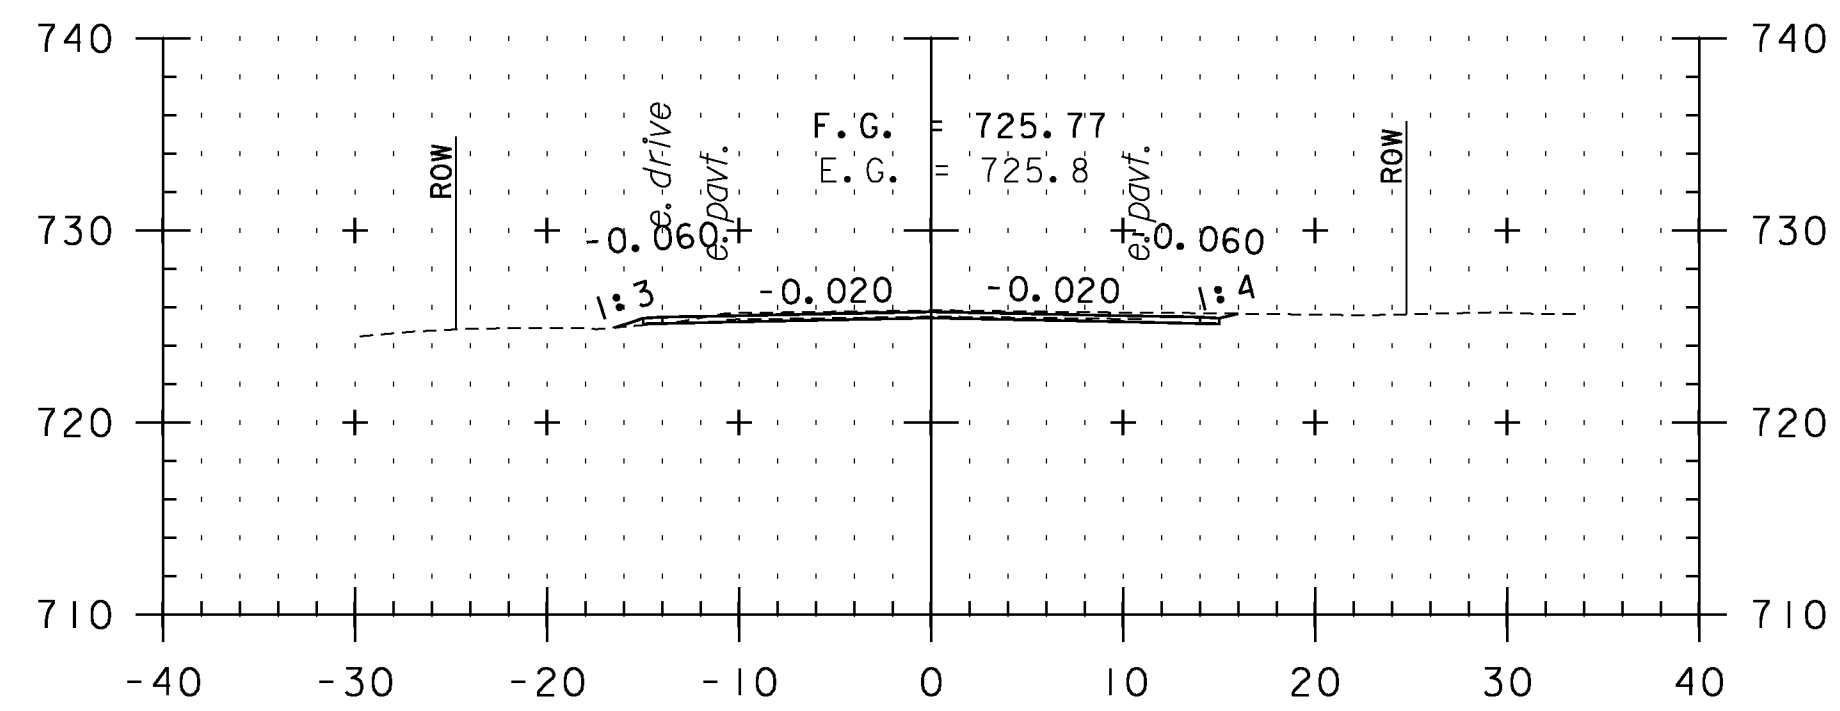


F 118+00

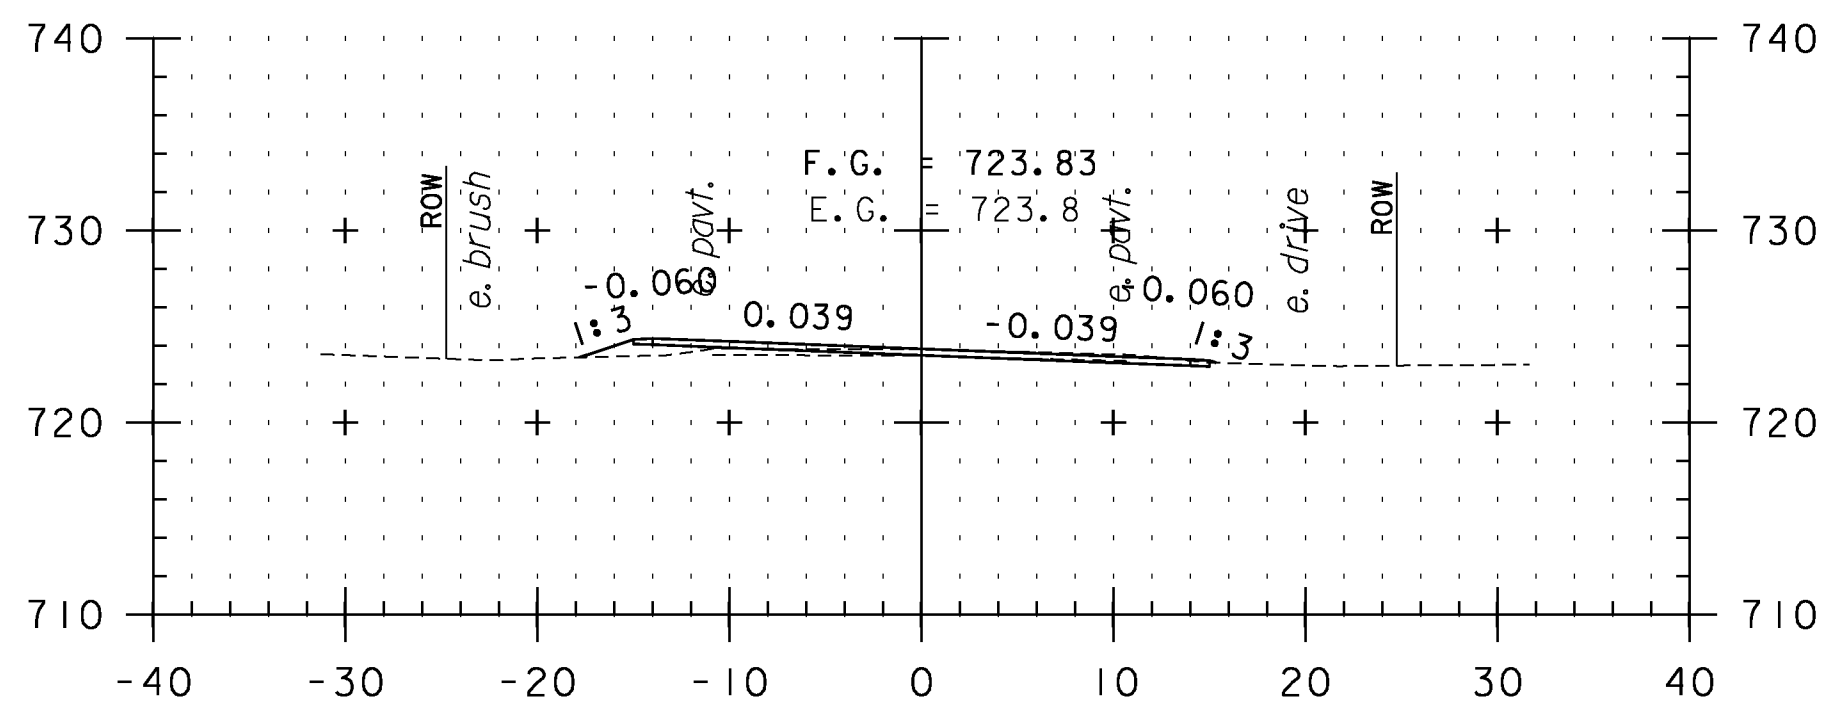


F 119+50

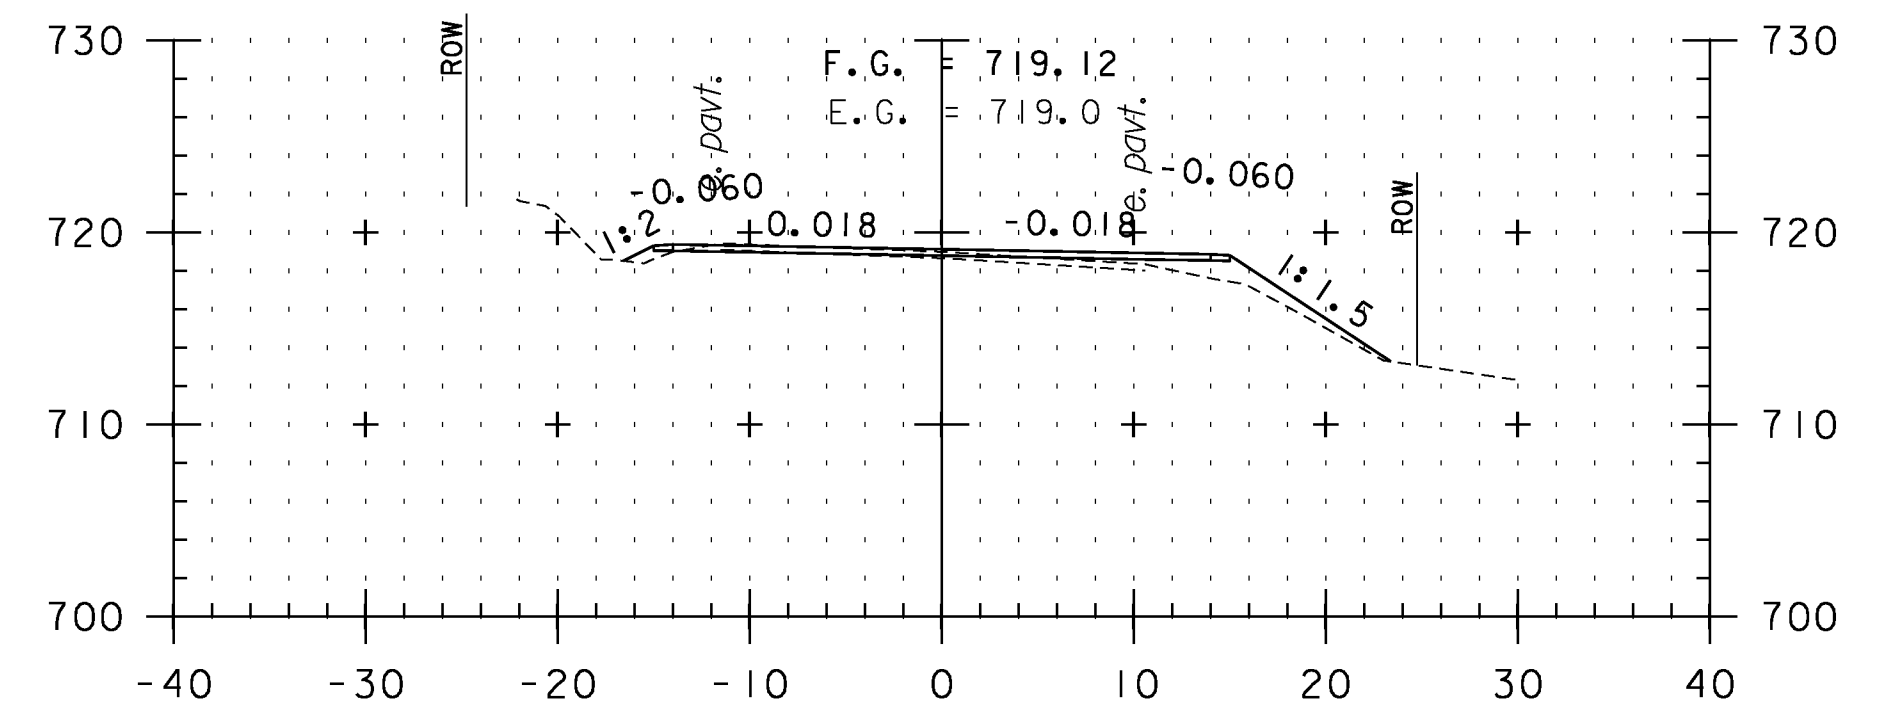


F 121+00

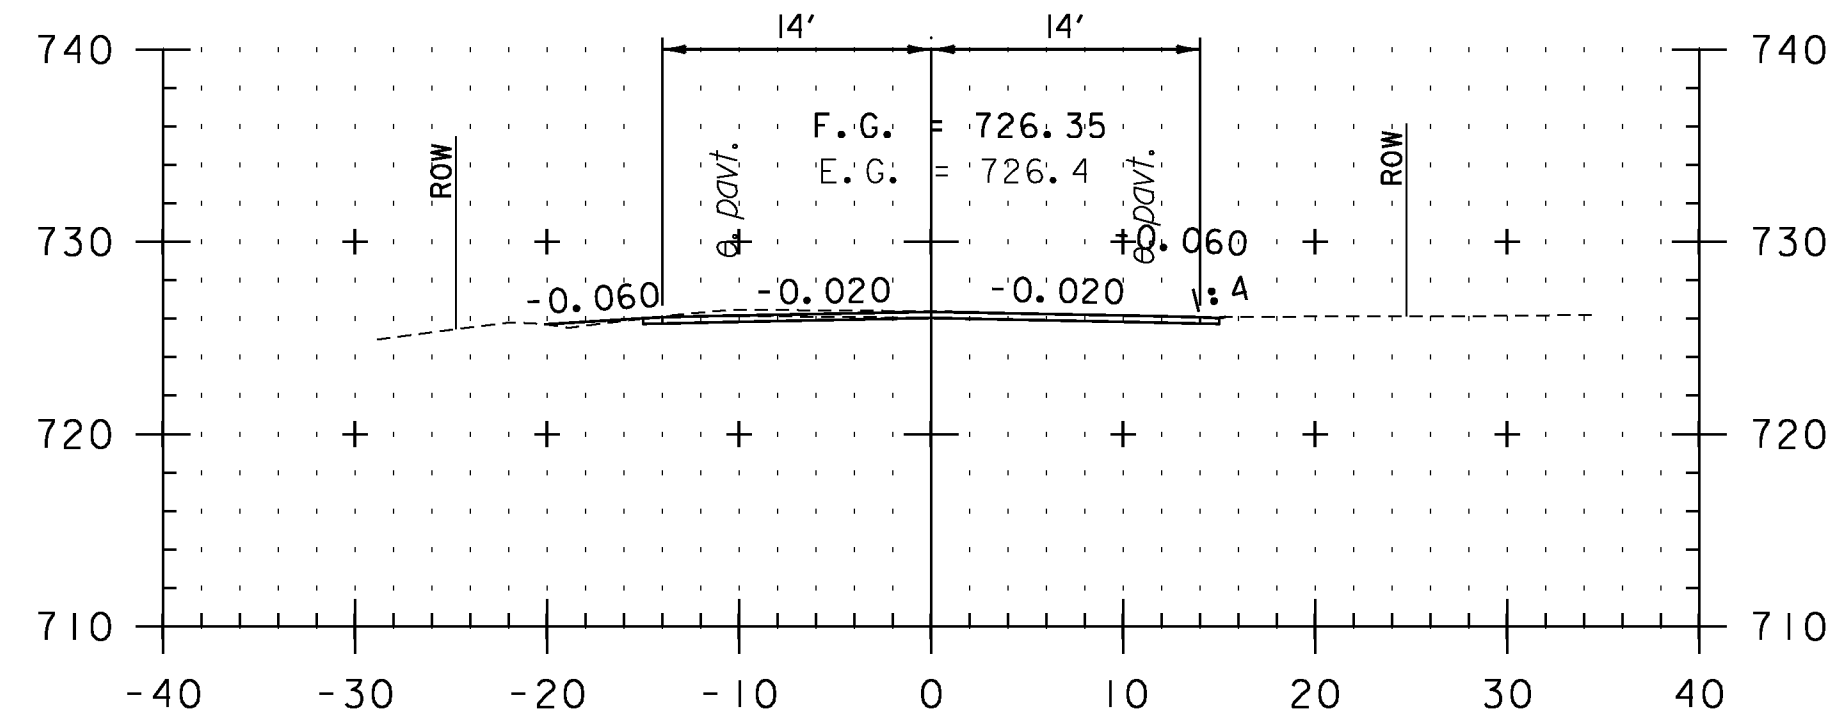

F 117+50

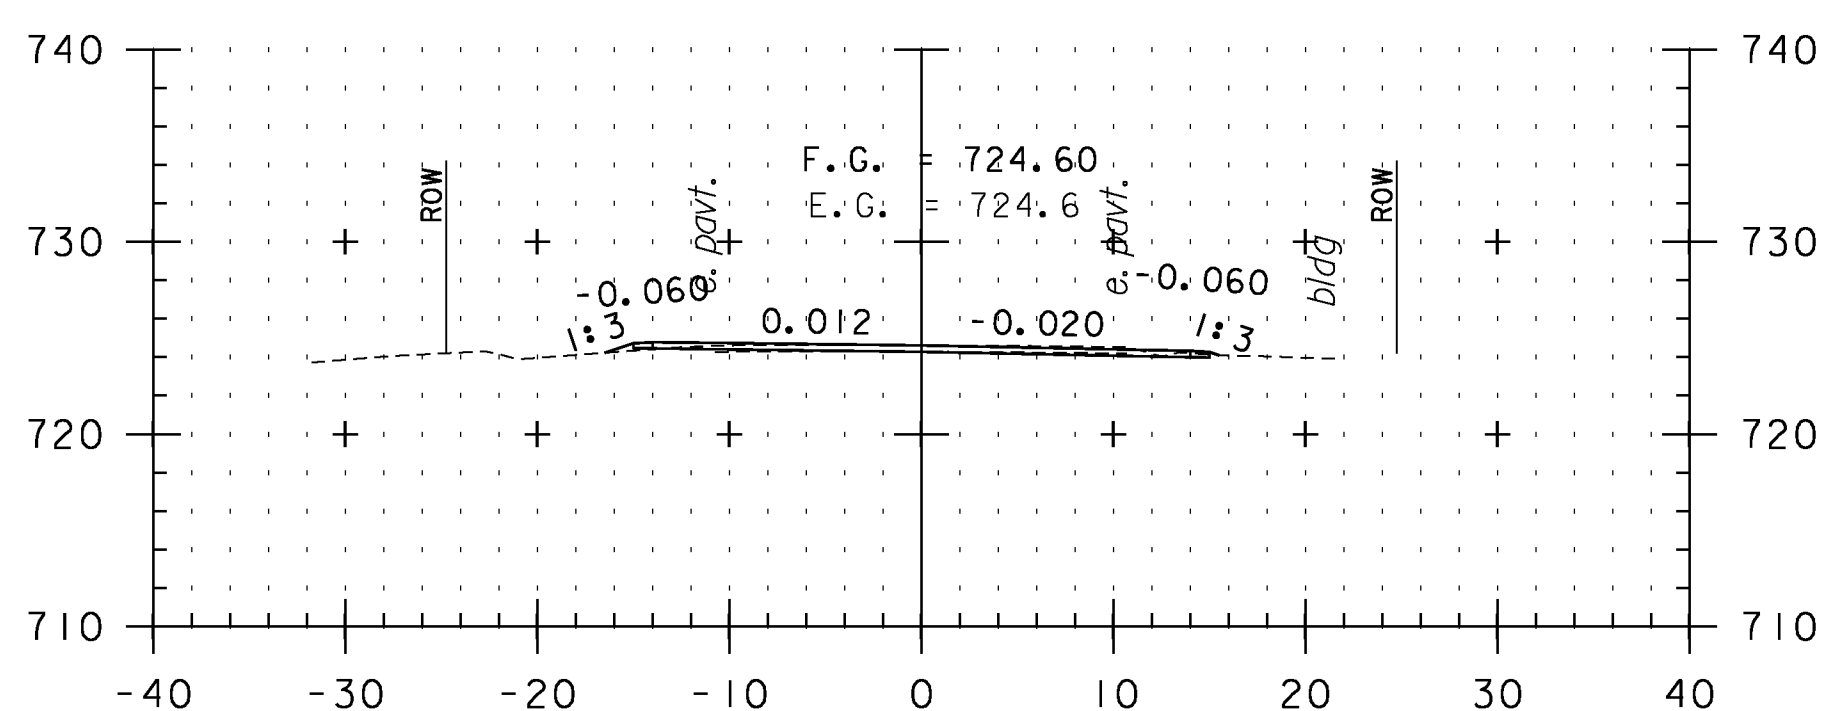

F 119+00

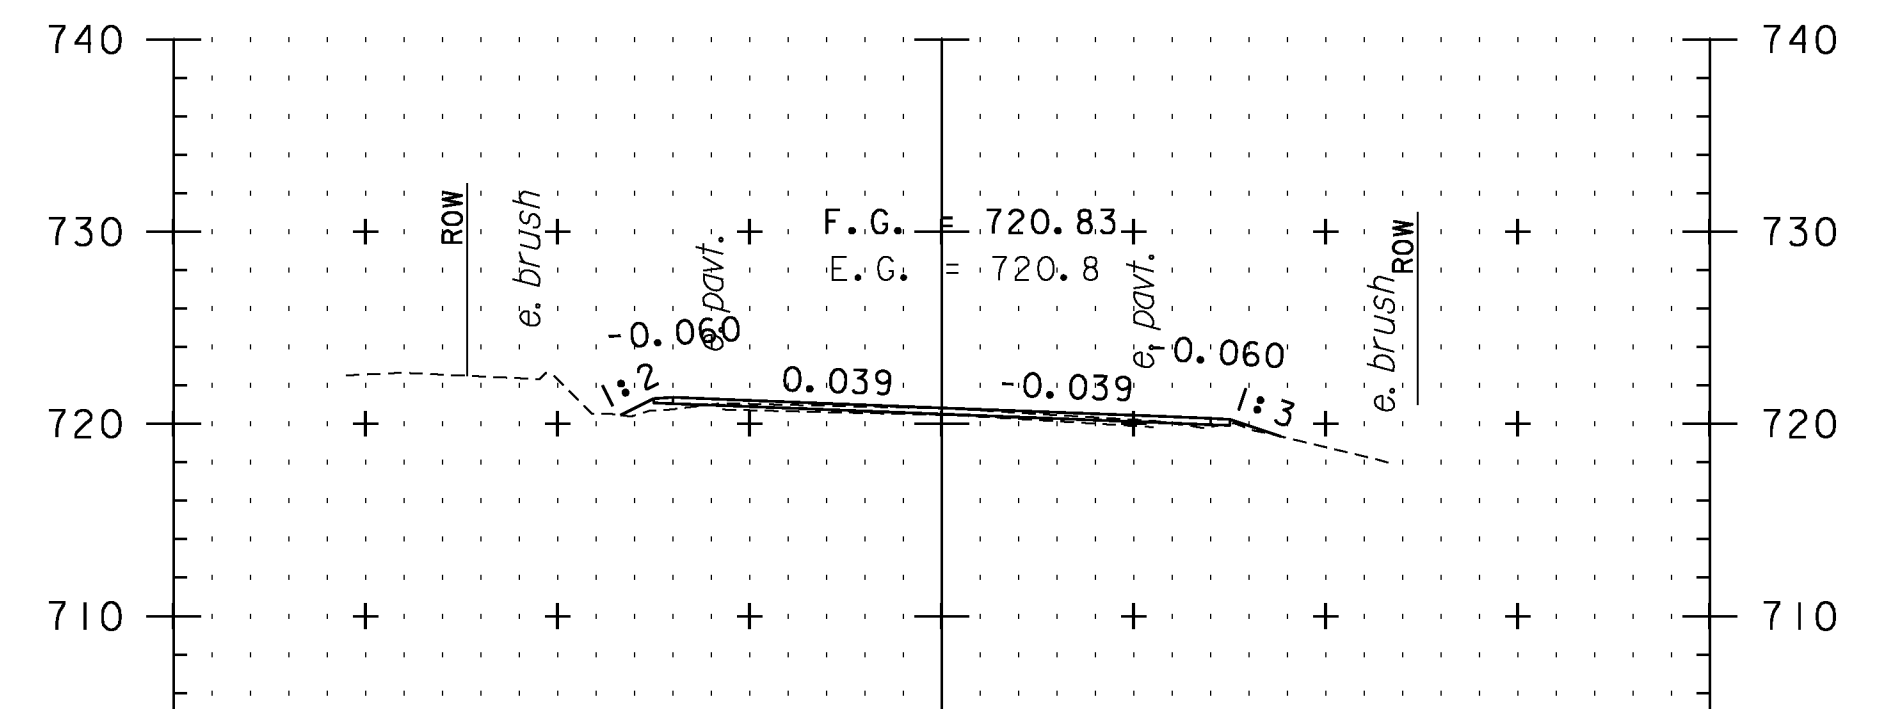

F 120+50

**CROSS SECTION SHEET 80**

STA. F117+50 TO STA. F121+50



PROJECT NAME: VERSHIRE-THETFORD	PLOT DATE: 1/29/2013
PROJECT NUMBER: STP 2911(I)	DRAWN BY: SNG
FILE NAME: pl0c224.dgn	CHECKED BY: PTS
PROJECT LEADER: PTS	SHEET 188 OF 232
DESIGNED BY: NLL	
IPARM FILE NAME: IOC224_188	