




F 123+00

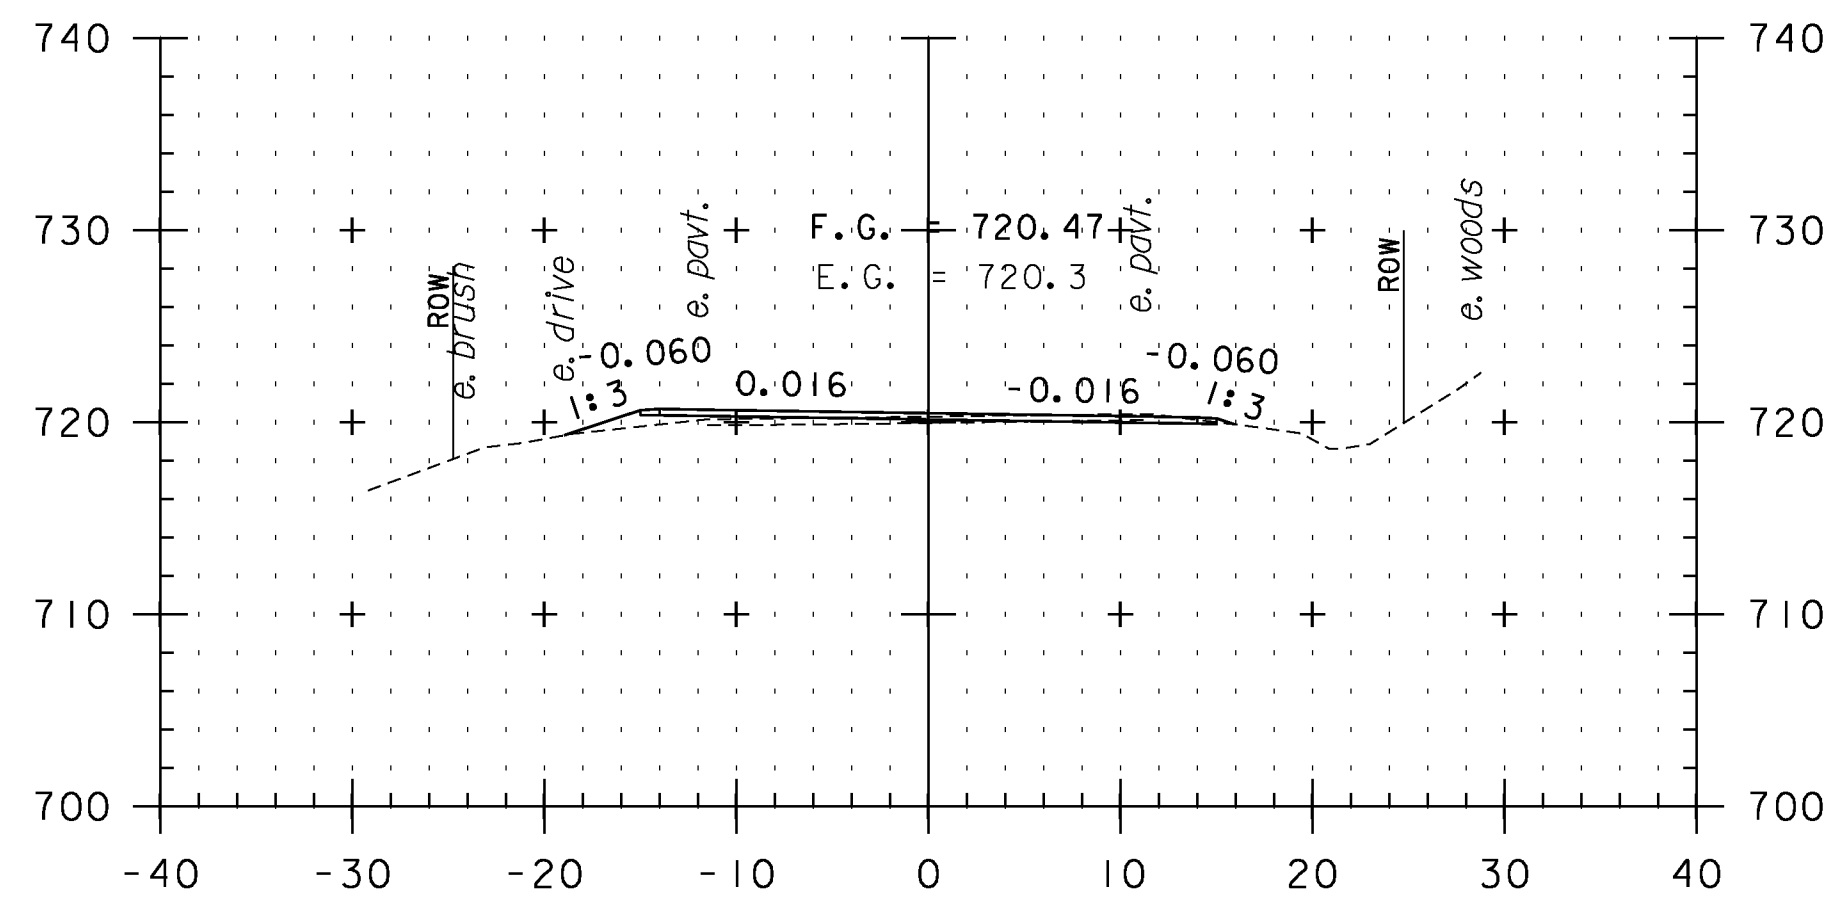


F 124+50

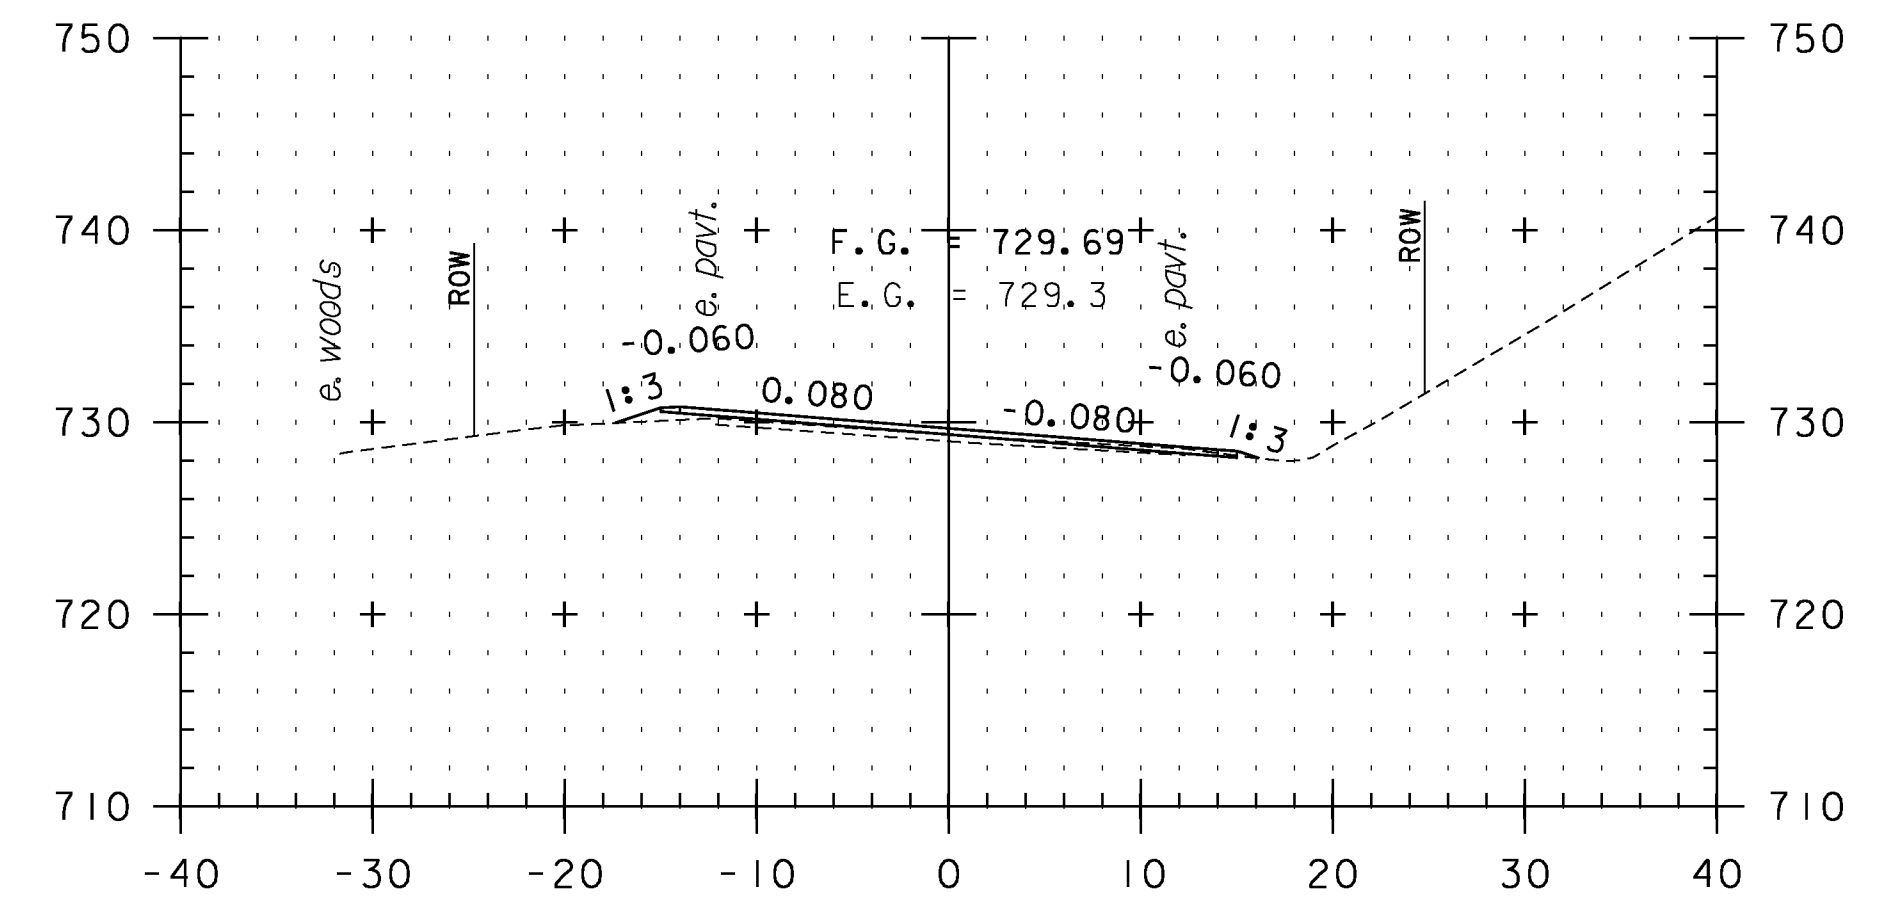


F 126+00

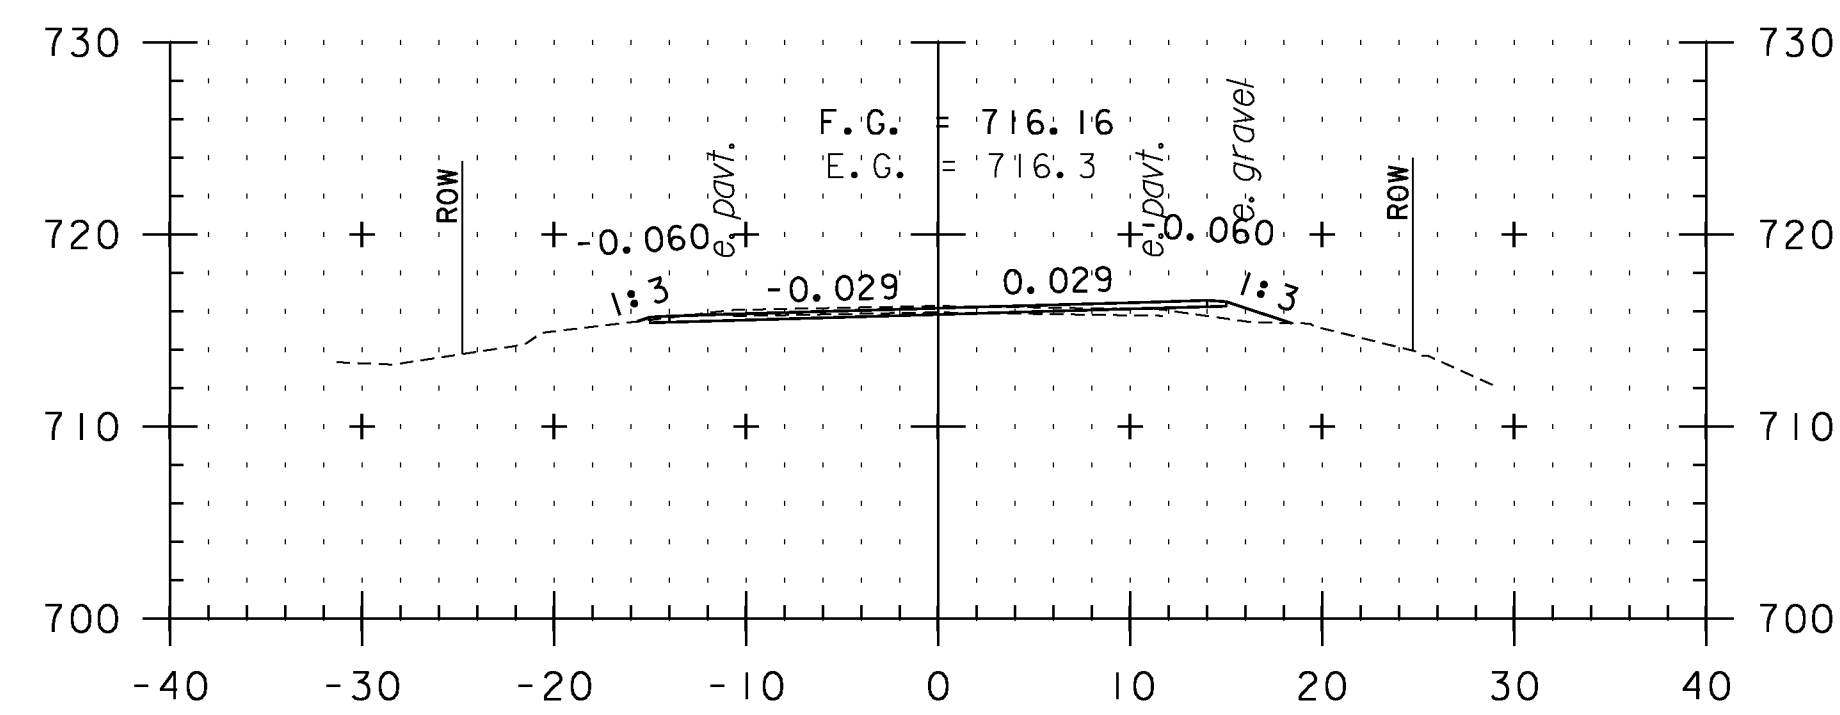


F 122+50

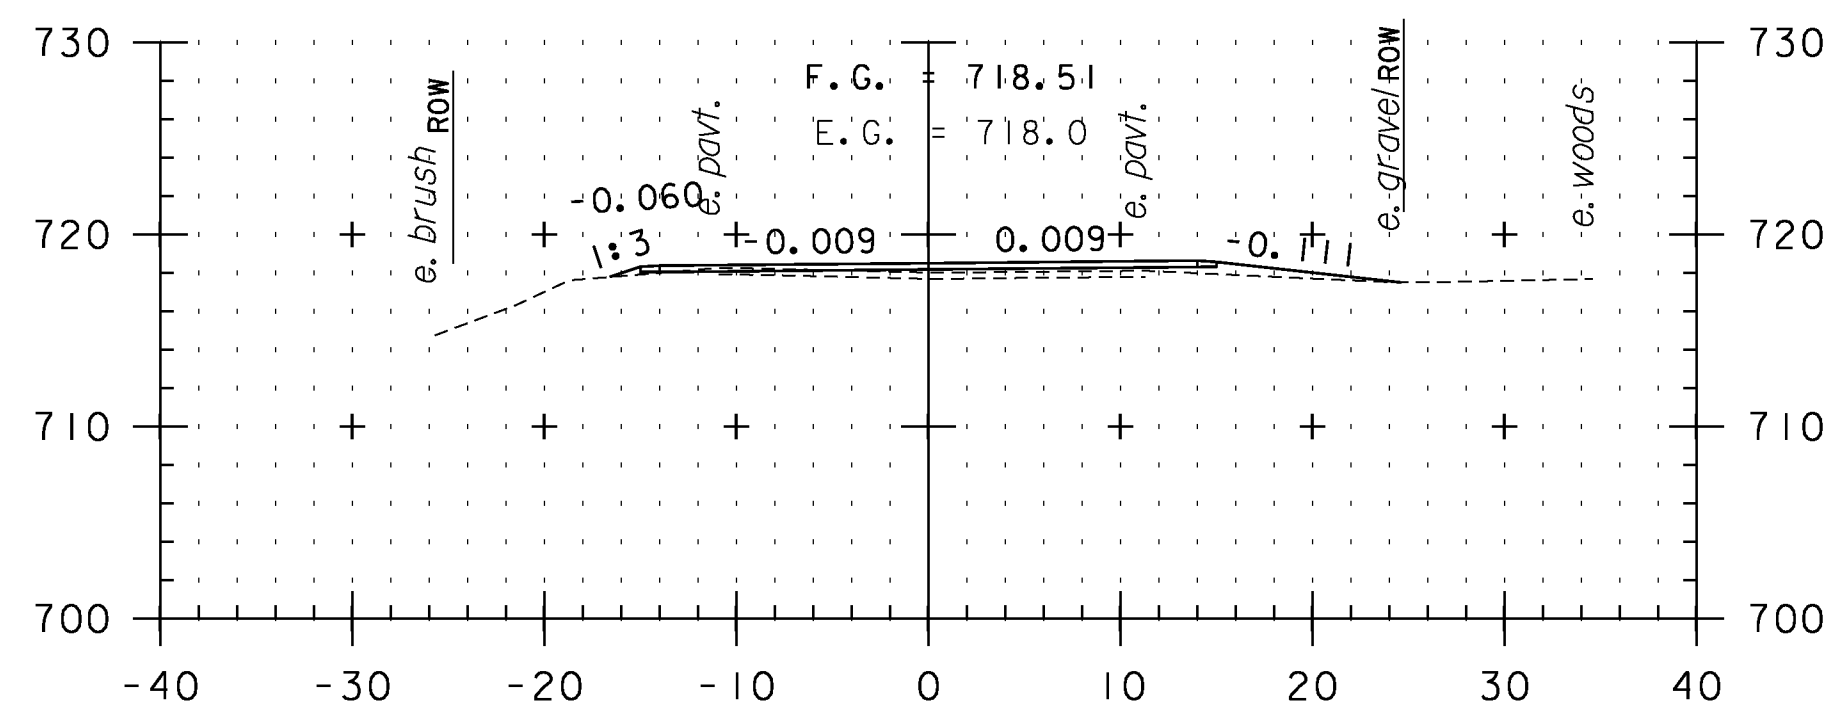


F 124+00

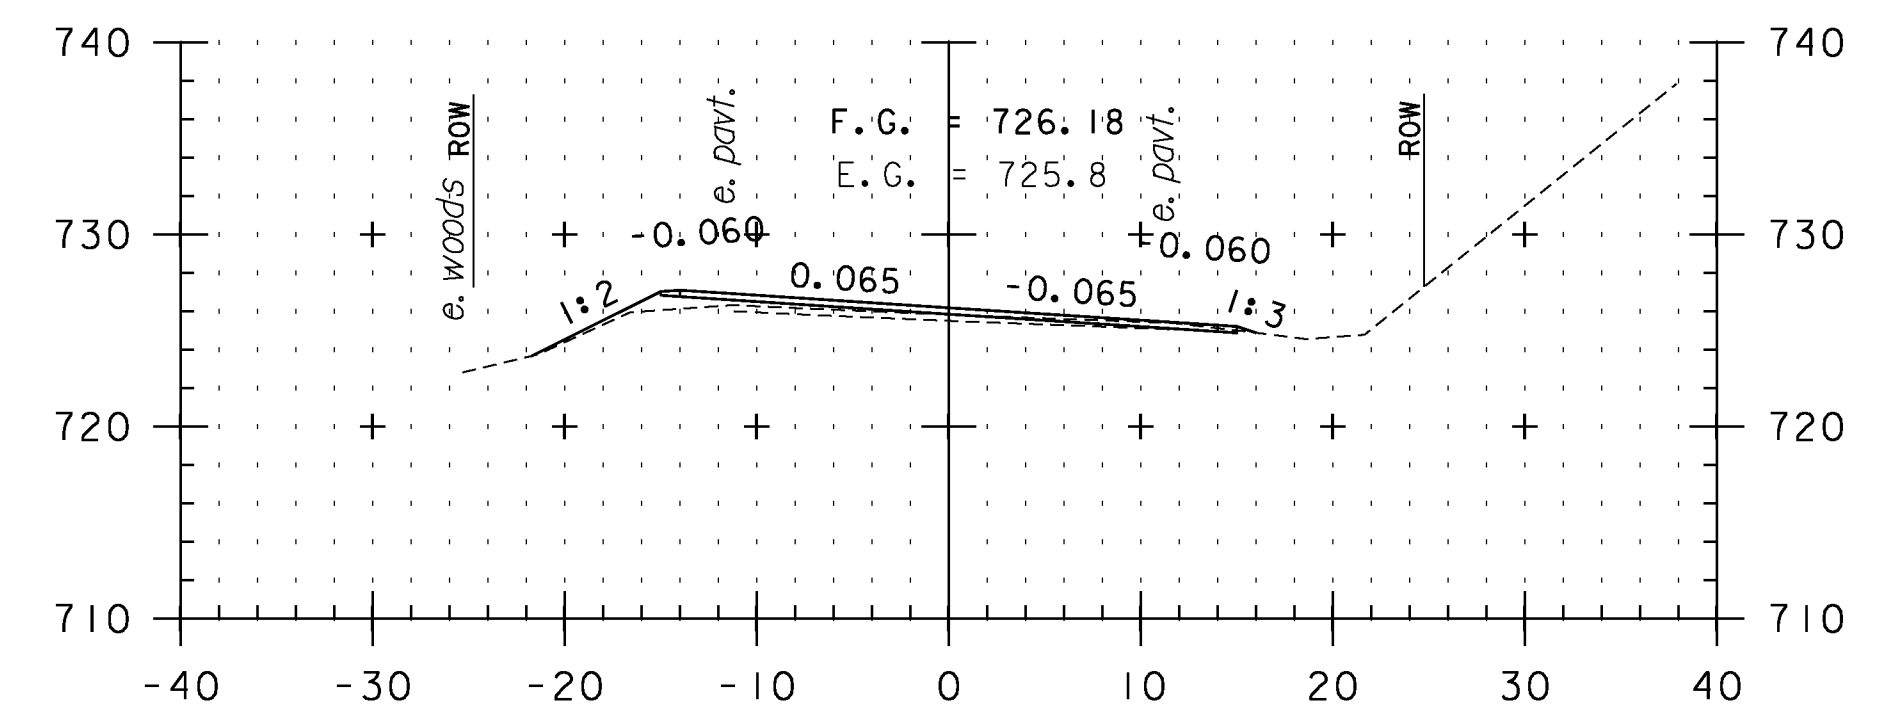


F 125+50

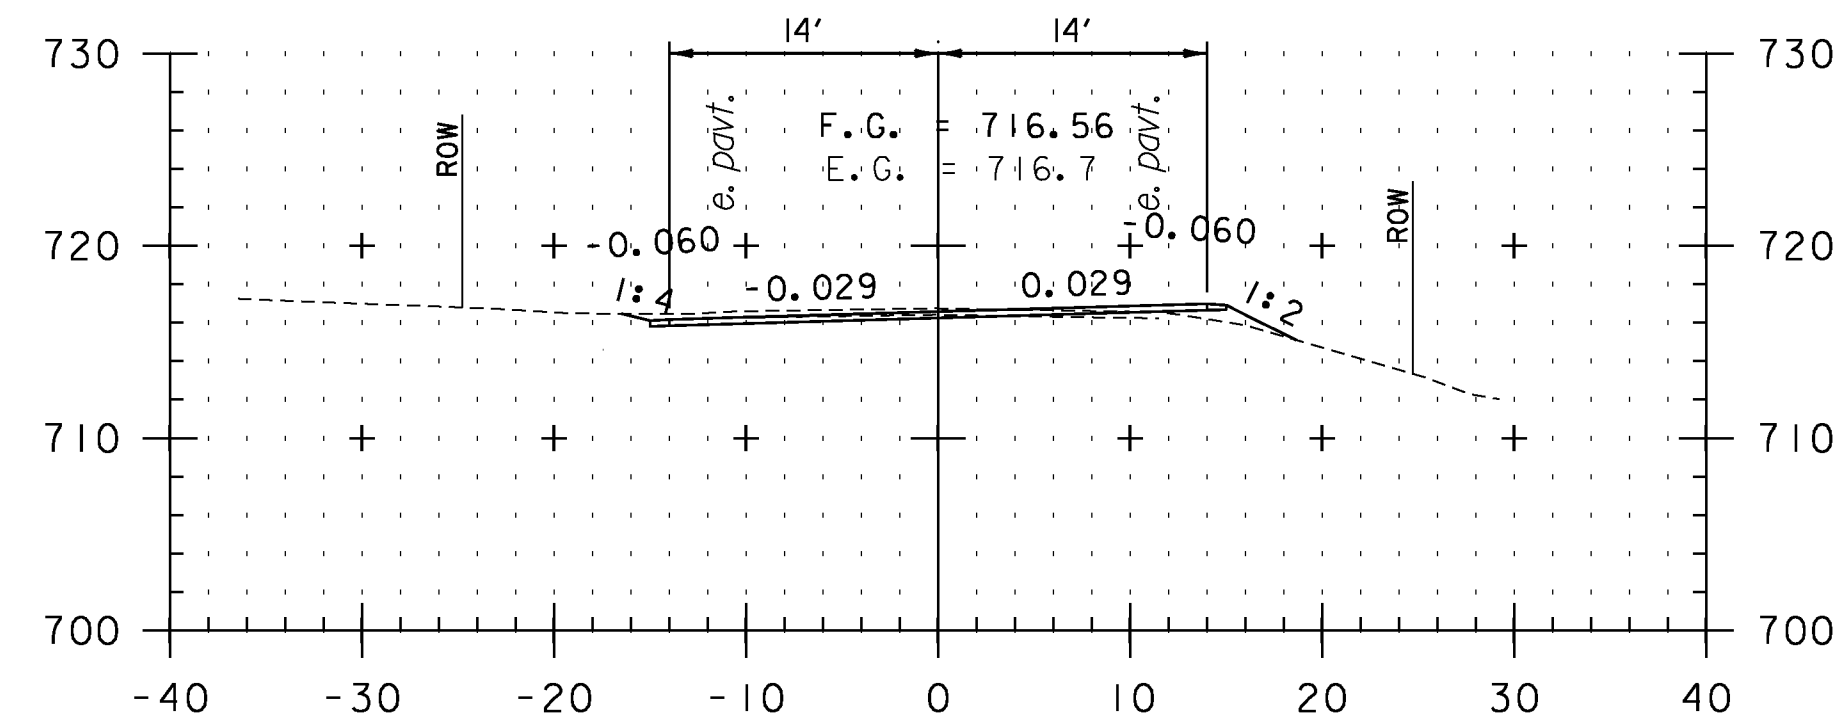

F 122+00

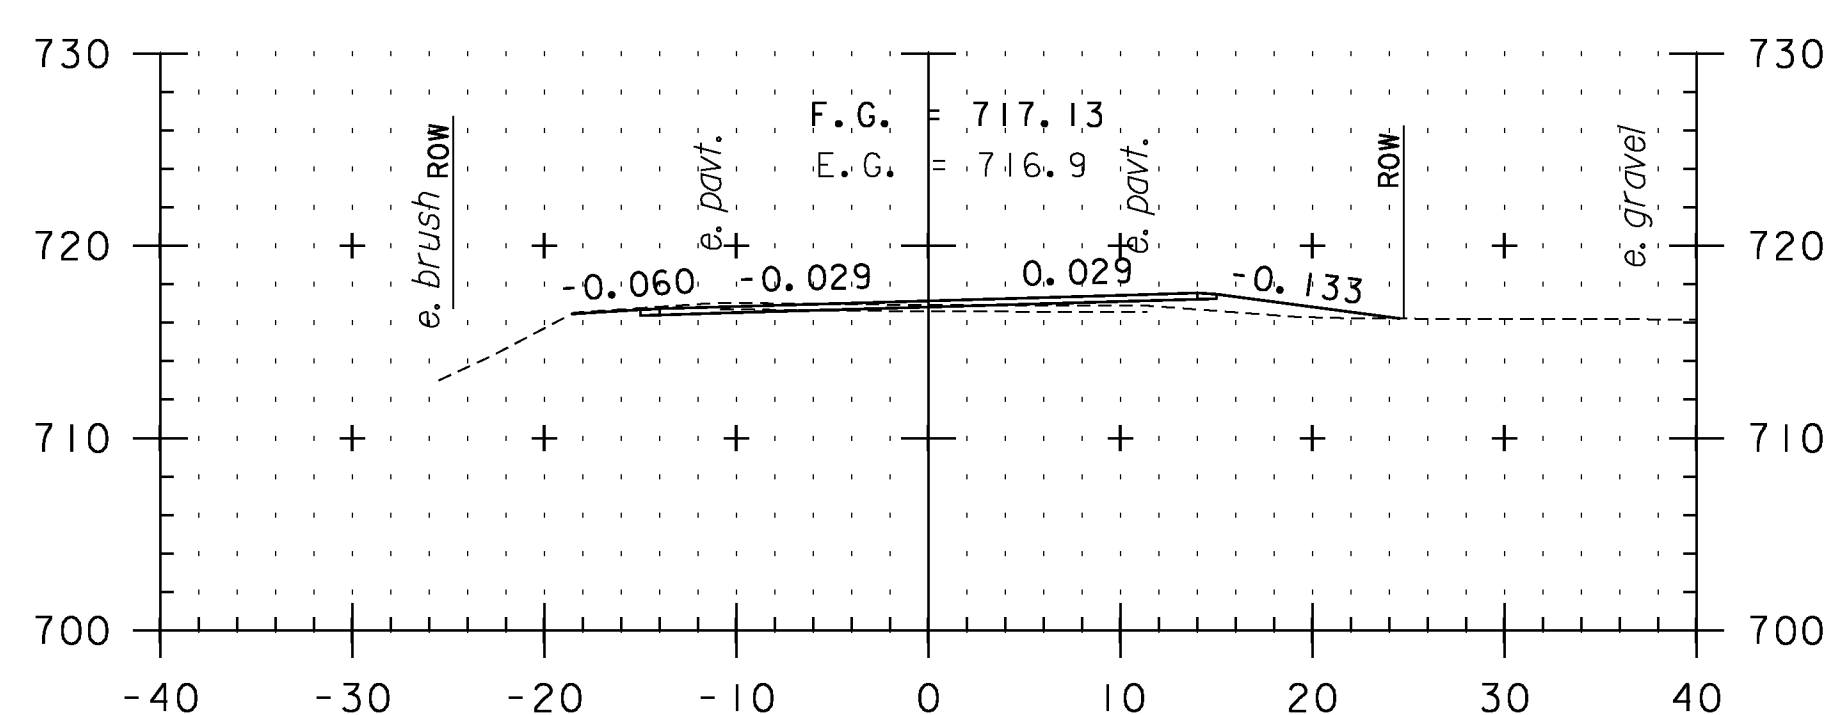


F 123+50

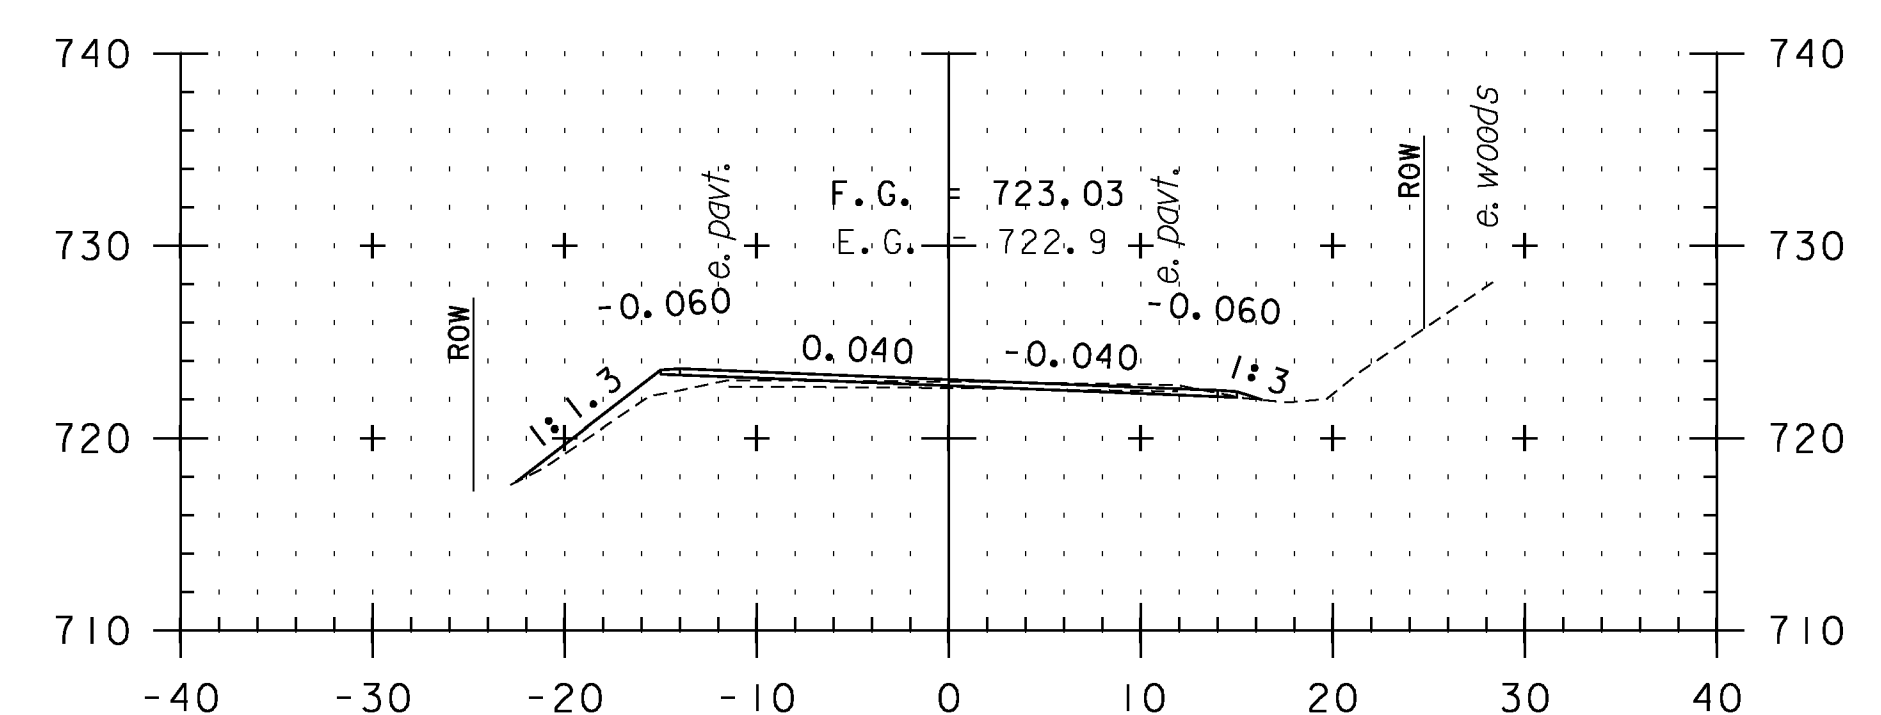

F 125+00

CROSS SECTION SHEET 81

STA. F122+00 TO STA. F126+00

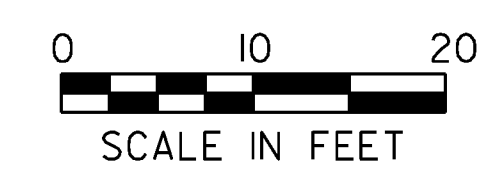

PROJECT NAME: VERSHIRE-THETFORD	PLOT DATE: 1/29/2013
PROJECT NUMBER: STP 2911(I)	DRAWN BY: SNG
FILE NAME: pl0c224.dgn	CHECKED BY: PTS
PROJECT LEADER: PTS	SHEET 189 OF 232
DESIGNED BY: NLL	
IPARM FILE NAME: IOC224_189	